

Brampton Encore - 8R - 2 - 28-2 Elev.CR SIREN

CONCRETE AND DRAIN

Inv.1,382	1 - BASEMENT: ROUGH-IN - 3PC BASEMENT ROUGH-IN
Line21682	Note:
23May17 / 29Sep17	

Exterior Colours

Inv.1,382	1 - EXTERIOR COLOUR PACKAGE #1
Line24307	Note:
23May17 / 29Sep17	

MISC.

Inv.1,382	1 - DO NOT INSTALL- SIDE DOOR- HOME TO EXTERIOR- GRADE DOES NOT PERMIT
Line21679	Note:
23May17 / 29Sep17	
Inv.1,382	1 - Purchaser has attended an appointment at the Decor Centre & has DECLINED any additional upgrades and accepts and acknowledges that there will be no further changes/additions/deletions to be made upon signing on May 23 2017.
Line21683	Note:
23May17 / 29Sep17	
Inv.1,382	1 - Purchasers are aware & accepts that ANY changes made to upgrades after signing this Purchasers Extra Form are subject to a minimum administration fee of \$500. PLUS a 10% holdback fee.
Line21684	Note:
23May17 / 29Sep17	
Inv.1,382	1 - BONUS PACKAGE: \$5,000.00 (INCLUDING TAXES) WORTH OF UPGRADES FROM GOLD PARK HOMES DÉCOR CENTRE IS BEING APPLIED TOWARD THE STRUCTURAL APPOINTMENT. PURCHASER HAS A REMAINING AMOUNT OF \$00 (INCLUDING TAXES) TO BE USED TOWARD THE COLOUR APPOINTMENT.
Line21686	Note:
23May17 / 29Sep17	

PLUMBING

Inv.1,382	1 - BASEMENT: ROUGH-IN - 3PC BASEMENT ROUGH-IN
Line24308	Note:
23May17 / 29Sep17	

WINDOWS - BASEMENT

Inv.1,382	3 - BASEMENT WINDOWS - UPGRADE EXISTING BASEMENT WINDOW TO 30 INCH X 24 INCH - MAY REQUIRE INSTALLATION OF WINDOW WELL
Line21681	Note:
23May17 / 29Sep17	

WINDOWS AND DOORS


Inv.1,382	1 - DO NOT INSTALL MANDOOR- GRADE DOES NOT PERMIT
Line24309	Note:
23May17 / 29Sep17	

BE2-ER.  
MAY 23 2017


# The Siren

## SEMI SERIES

Elevation A • 1,688 sq.ft.  
Elevation B • 1,677 sq.ft.  
→ Elevation C • 1,687 sq.ft.

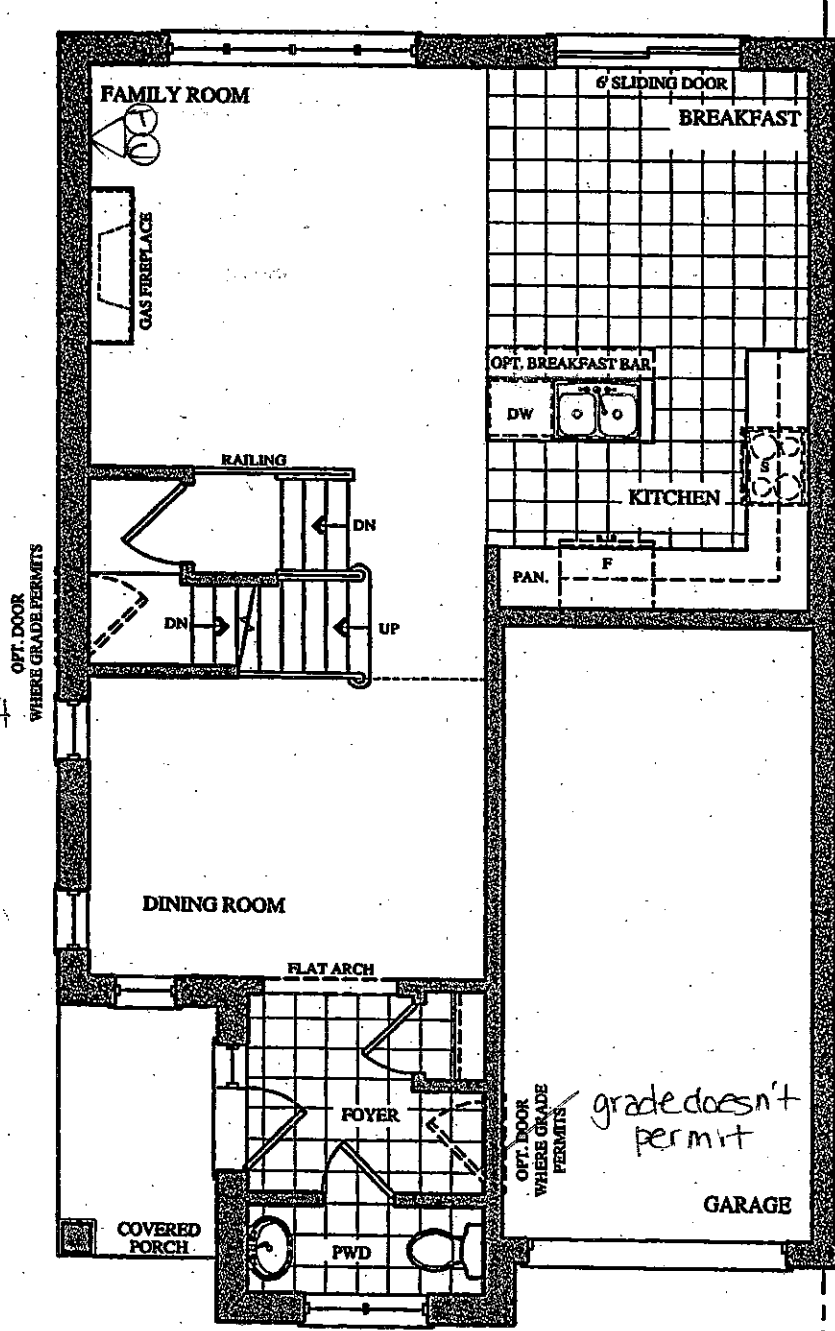

GROUND FLOOR PLAN  
ELEV. 'A' & 'B'

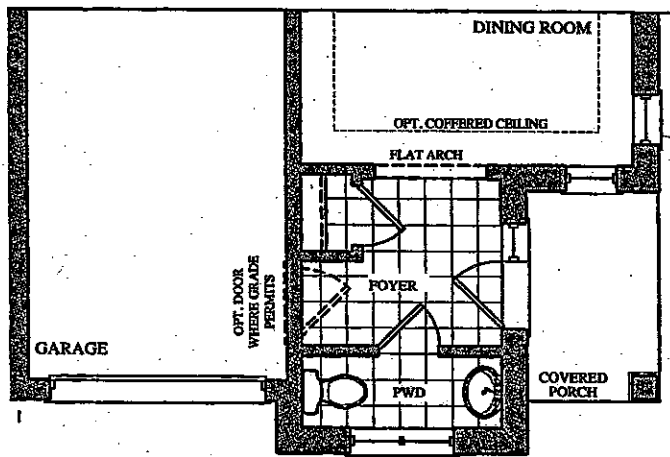


\* PART. GROUND FLOOR PLAN  
ELEV. 'C'

BE2-ER  
May 23 2017


# The Siren

## SEMI SERIES


Elevation A • 1,688 sq.ft.  
Elevation B • 1,677 sq.ft.  
✓ Elevation C • 1,687 sq.ft.

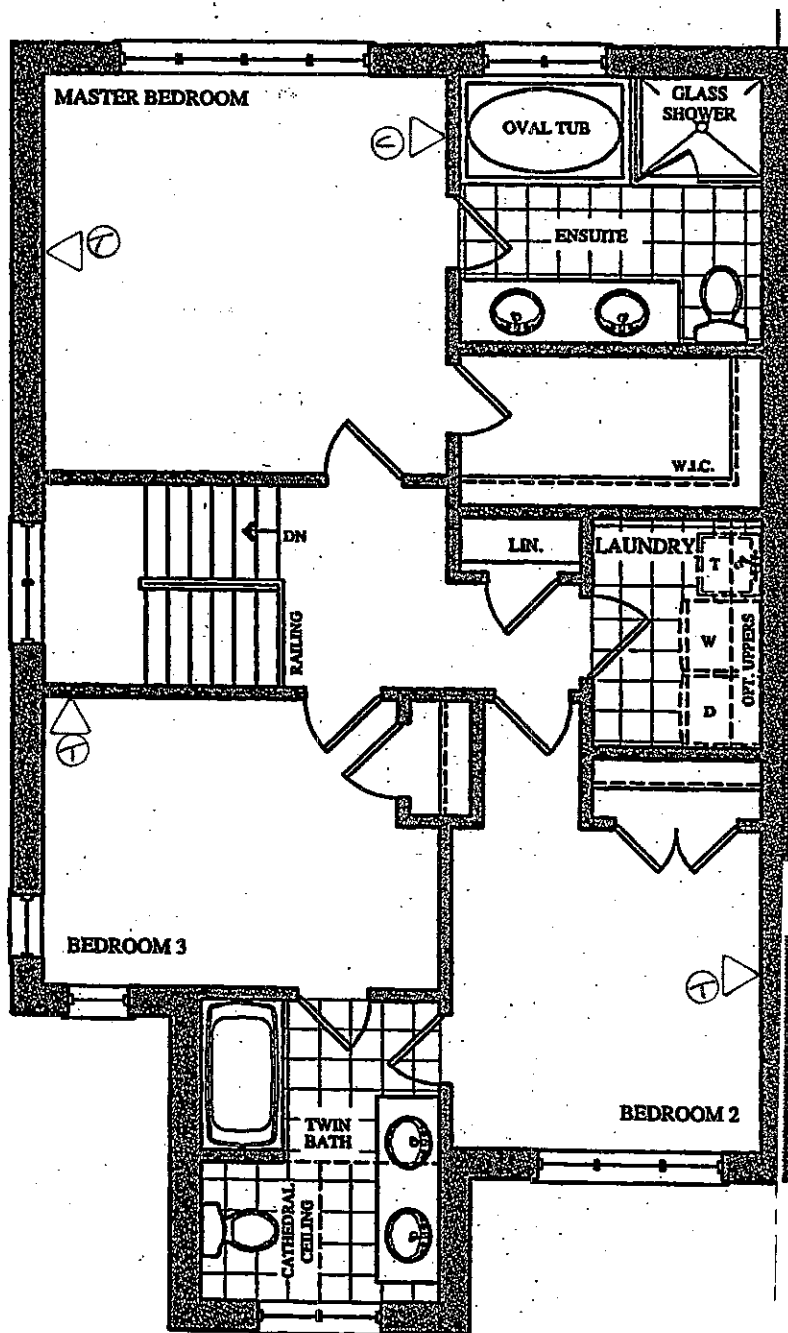

SECOND FLOOR PLAN  
ELEV. 'A'

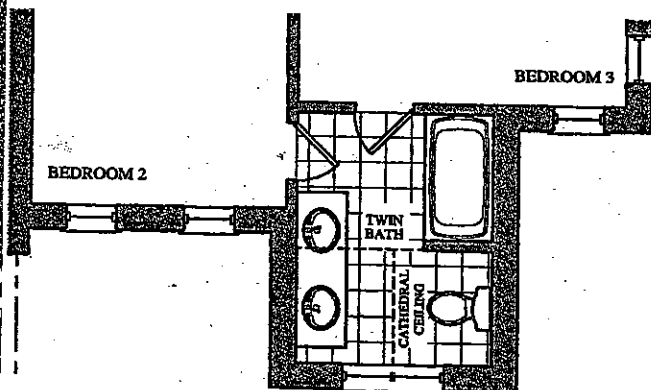

PART. SECOND FLOOR PLAN  
ELEV. 'B'

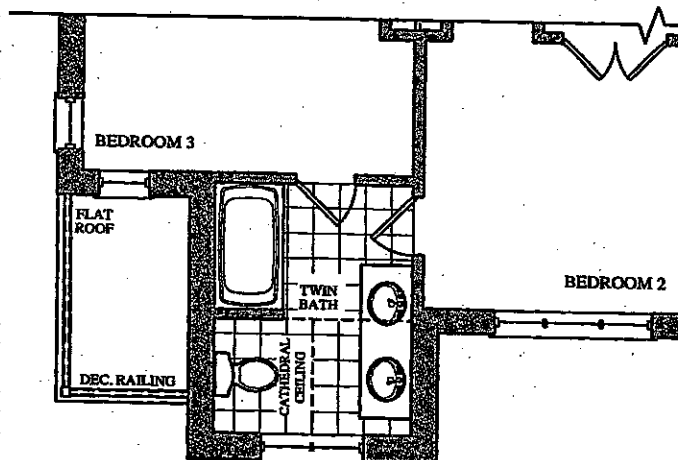

✓ PART. SECOND FLOOR PLAN  
ELEV. 'C'

# The Siren

## SEMI SERIES

Elevation A • 1,688 sq.ft.  
Elevation B • 1,677 sq.ft.  
Elevation C • 1,687 sq.ft.

BE2-8R  
MAY 23 2017

