

Brampton Encore - 9L - 2 - 28-4 Elev.A Rossini OPT4

CENTRAL VAC AND WIRING

Inv.1,340	1 - TELEPHONE AND CABLE LOCATION SKETCH
Line21202	Note:
2May17 / 28Sep17	

ELECTRICAL

Inv.1,340	1 - LIVING ROOM: INSTALL ROUGH - IN WALL OUTLET & SWITCH (WITH COVER PLATE) - DOES NOT INCLUDE FIXTURE - IN LIVING ROOM, IN ADDITION TO STANDARD SWITCH CONTROLLED RECEPTICLE. SEE SKETCH
Line21203	Note:
2May17 / 28Sep17	

Inv.1,340	1 - FAMILY ROOM: INSTALL ROUGH - IN WALL OUTLET & SWITCH (WITH COVER PLATE) - DOES NOT INCLUDE FIXTURE - IN FAMILY ROOM, ABOVE FIREPLACE, IN ADDITION TO STANDARD LIGHT. SEE SKETCH
Line21209	Note:
2May17 / 28Sep17	

FRAMING

Inv.1,340	1 - GARAGE: INSTALL MANDORR ROUGH-IN- OPTION ONLY AVAILABLE IF GRADE DOES NOT PERMIT - APPLIED BY HEAD OFFICE
Line21205	Note:
2May17 / 28Sep17	

MISC.

Inv.1,340	1 - BONUS PACKAGE: \$3322.20 (INCLUDING TAXES) WORTH OF UPGRADES FROM GOLD PARK HOMES DÉCOR CENTRE IS BEING APPLIED TOWARD THE STRUCTURAL APPOINTMENT. PURCHASER HAS A REMAINING AMOUNT OF \$1677.80 (INCLUDING TAXES) TO BE USED TOWARD THE COLOUR APPOINTMENT
Line21210	Note:
2May17 / 28Sep17	

Inv.1,340	1 - DO NOT INSTALL SIDE DOOR- HOME TO EXTERIOR- GRADE DOESN'T PERMIT
Line21204	Note:
2May17 / 28Sep17	

Inv.1,340	1 - Purchasers are aware & accepts that ANY changes made to upgrades after signing this Purchasers Extra Form are subject to a minimum administration fee of \$500. PLUS a 10% holdback fee
Line21212	Note:
2May17 / 28Sep17	

Inv.1,340	1 - Purchaser has attended a Structural appointment at the Decor Centre & has DECLINED any additional upgrades and accepts and acknowledges that there will be no further structural changes/additions/deletions to be made upon signing on May 2, 2017
Line21211	Note:
2May17 / 28Sep17	

WINDOWS - BASEMENT

Inv.1,340	2 - BASEMENT: INSTALL TWO (X2) BASEMENT WINDOWS - UPGRADE EXISTING BASEMENT WINDOW TO 30 INCH X 24 INCH - MAY REQUIRE INSTALLATION OF WINDOW WELL
Line21207	Note: NOTE: OTHER TWO WINDOWS TO REMAIN STANDARD
2May17 / 28Sep17	

WINDOWS AND DOORS



CONSTRUCTION SUMMARY

Brampton Encore - 9L - 2 - 28-4 Elev.A Rossini OPT4


Inv.1,340	1 - GARAGE: INSTALL MANDOOR ROUGH-IN- OPTION ONLY AVAILABLE IF GRADE DOES NOT PERMIT - APPLIED BY HEAD OFFICE
Line24293	Note:
2May17 / 28Sep17	

encore

BRAMPTON

Telephone — ①


Cable — ②

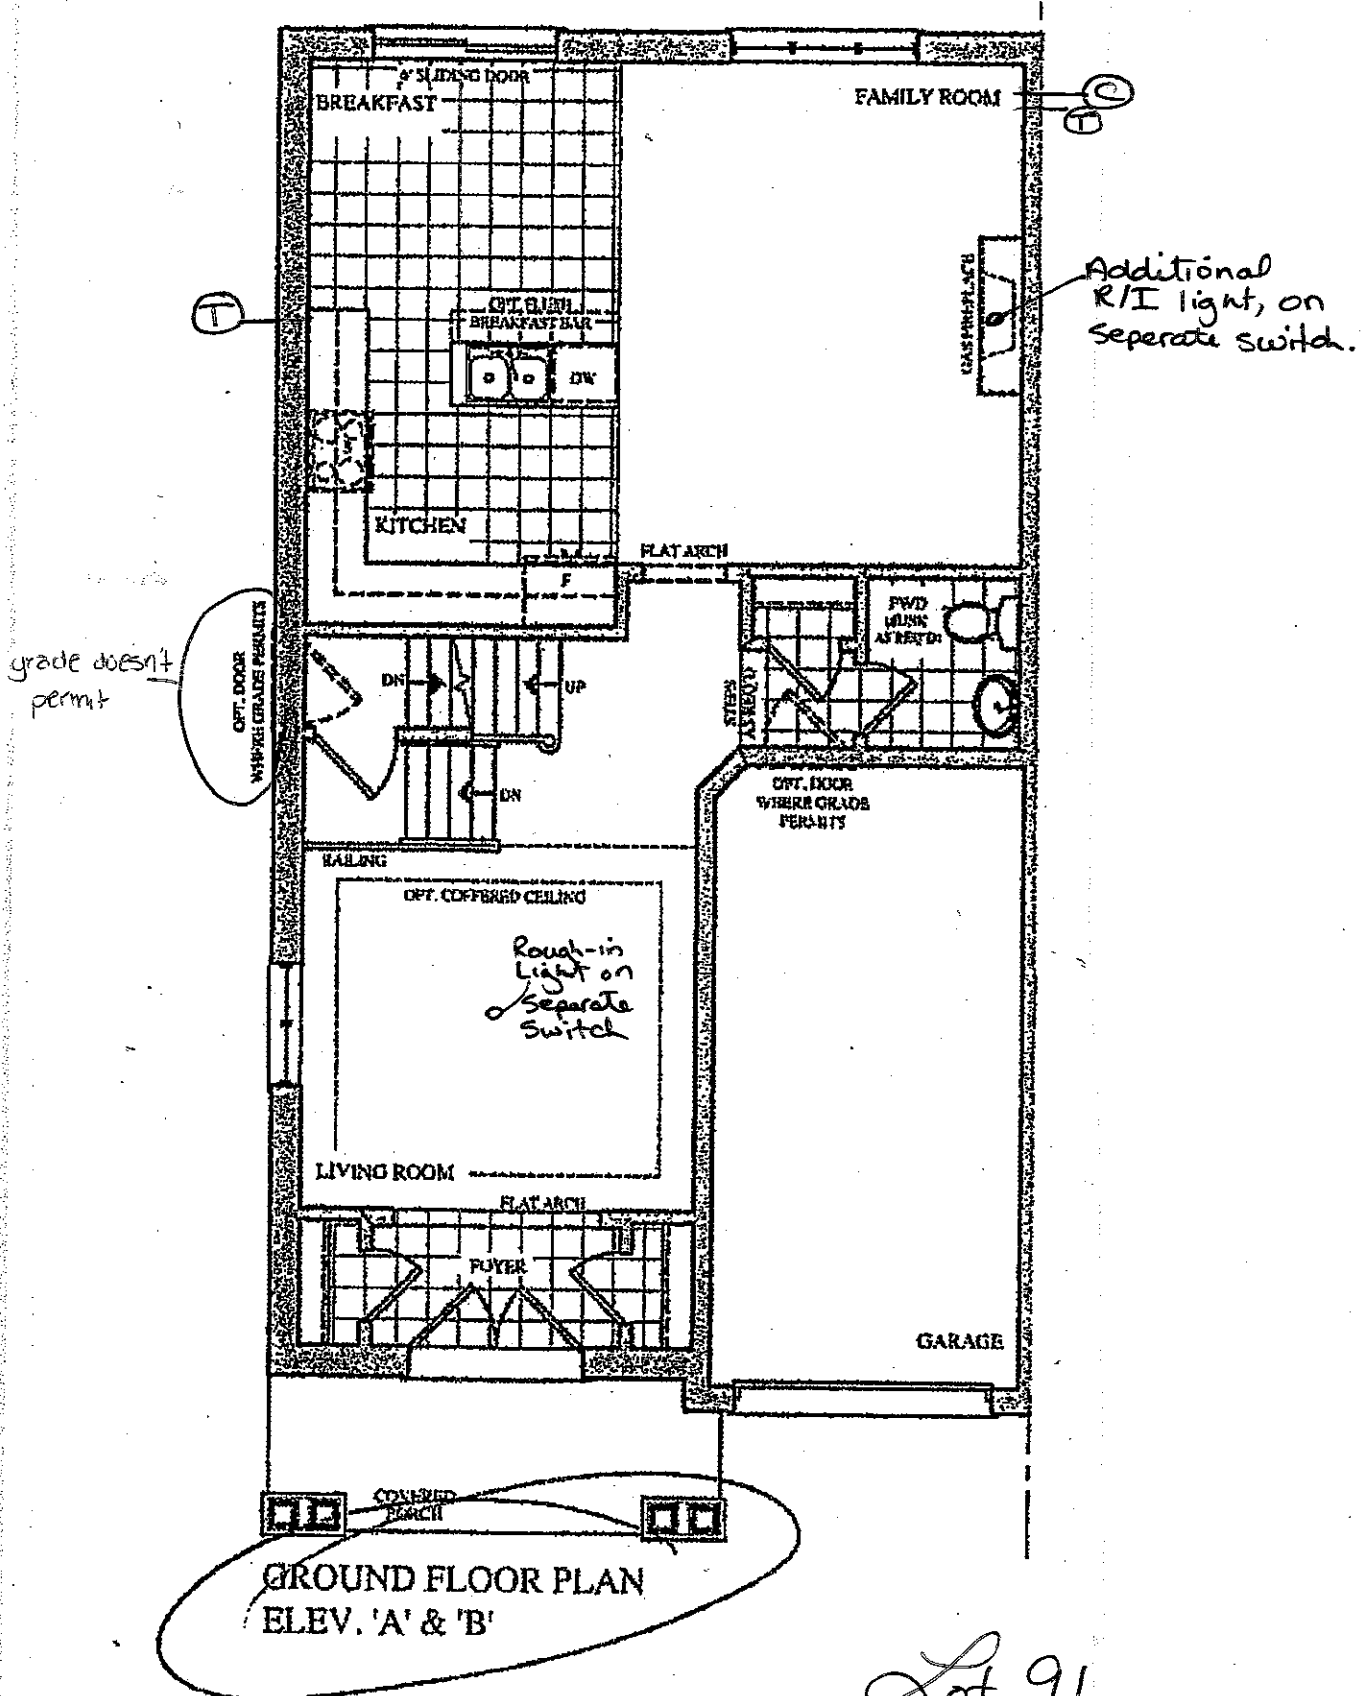


Lot 9L
May 2, 17




Telephone — (T)
 Cable — (C)

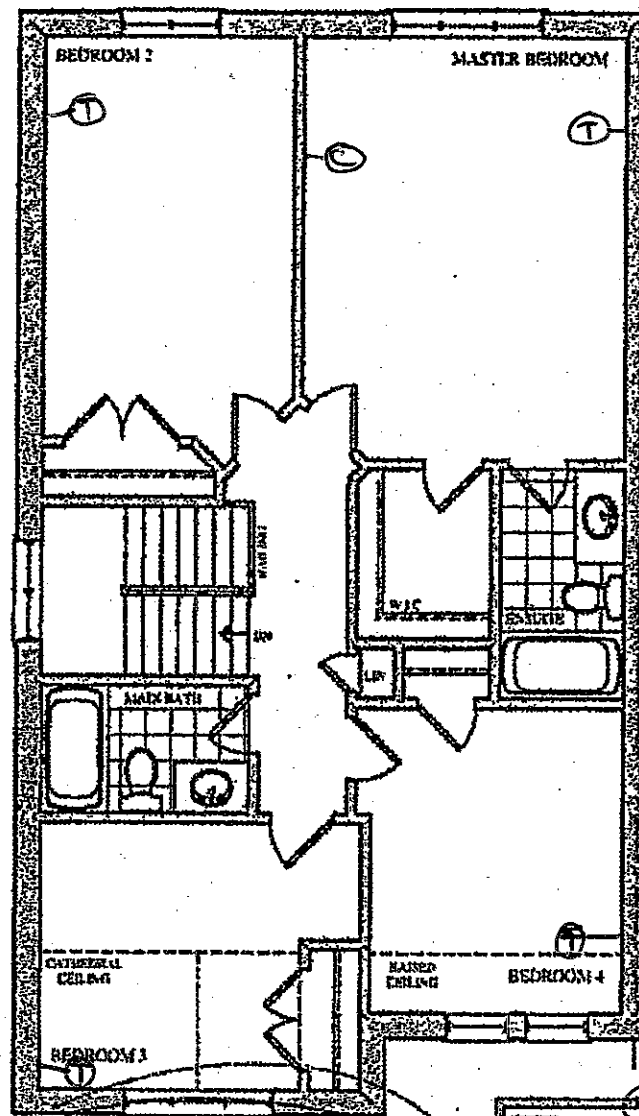

OPT. SECOND FLOOR PLAN
 ELEV. 'A'

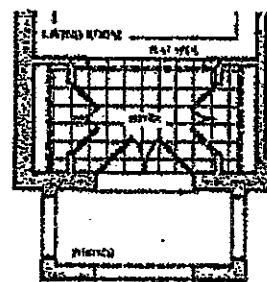

PART. GROUND FLOOR PLAN
 ELEV. 'C' & 'D'

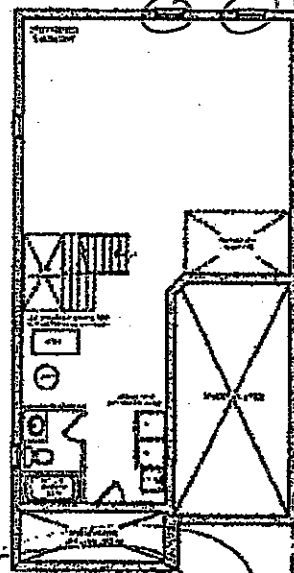

BASEMENT FLOOR PLAN
 ELEV. 'W' & 'B'


Enlarge
 Two 30" x 24"
 Windows

Lot 9L
 May 2, 17




The
Rossini
SEMI SERIES

Elevation A • 1,911 sq.ft.
Elevation B • 1,902 sq.ft.
Elevation C • 1,966 sq.ft.
Elevation D • 1,971 sq.ft.

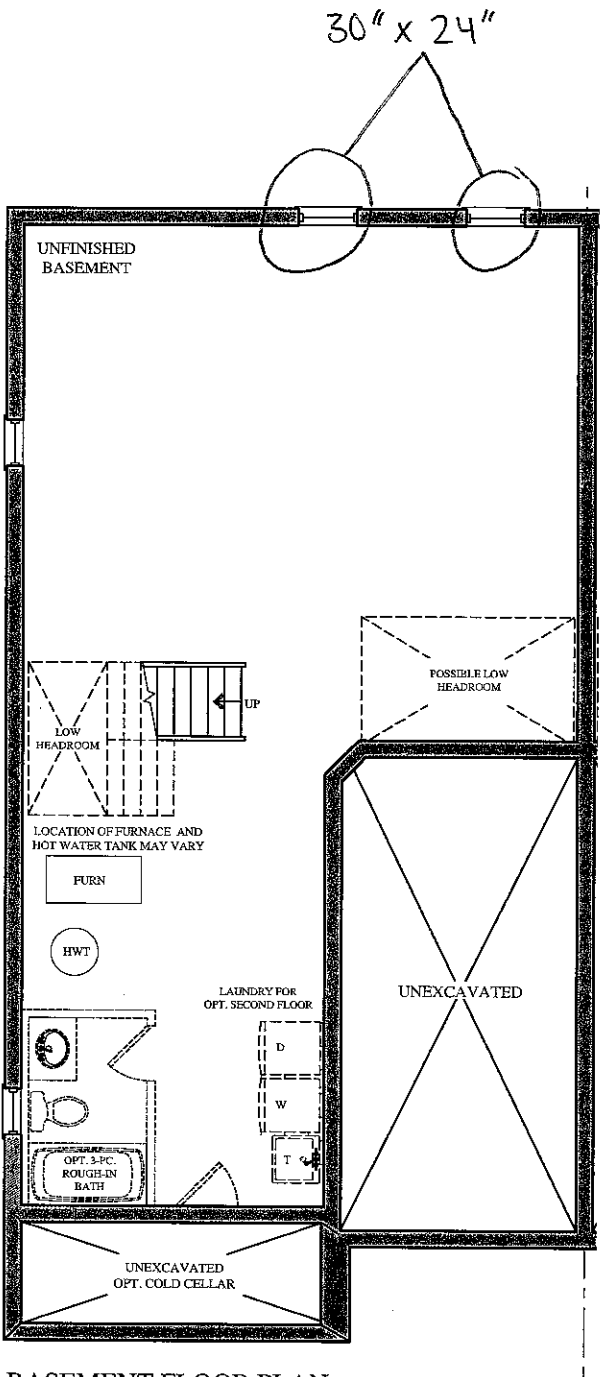

BASEMENT FLOOR PLAN
ELEV. 'A' & 'B'

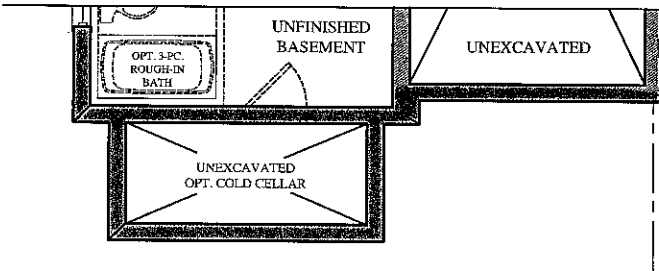

PART. BASEMENT FLOOR PLAN
ELEV. 'C' & 'D'