

CONSTRUCTION SUMMARY

Brampton Encore - 5L - 2 - 28-2 Elev.A SIREN
CENTRAL VAC AND WIRING

Inv.1,489	1 - TELEPHONE AND CABLE LOCATION SKETCH.
Line23108	Note:
10Jul17 / 27Sep17	
Inv.1,489	1 - FAMILY ROOM: INSTALL CONDUIT PIPE- FOR TELEVISION- MUST SPECIFY LOCATION AND TERMINATION POINT
Line23109	Note:
10Jul17 / 27Sep17	

CONCRETE AND DRAIN

Inv.1,489	1 - BASEMENT: INSTALL BACKFLOW PREVENTER VALVE
Line23130	Note:
10Jul17 / 27Sep17	

ELECTRICAL

Inv.1,489	1 - BASEMENT: INSTALL 200 AMP ELECTRICAL SERVICE
Line23113	Note:
10Jul17 / 27Sep17	
Inv.1,489	1 - FAMILY ROOM: INSTALL 110V WALL RECEPTACLE ON DEDICATED CIRCUIT - FOR FUTURE TV ABOVE FIREPLACE
Line23111	Note:
10Jul17 / 27Sep17	

Exterior Colours

Inv.1,489	1 - EXTERIOR COLOUR PACKAGE #6
Line24237	Note:
10Jul17 / 27Sep17	

MISC.

Inv.1,489	1 - DO NOT INSTALL MANDOOR - GARAGE TO HOUSE- GRADE DOESNT PERMIT
Line23119	Note:
10Jul17 / 27Sep17	
Inv.1,489	1 - BONUS PACKAGE: \$5,000.00 (INCLUDING TAXES) WORTH OF UPGRADES FROM GOLD PARK HOMES DÉCOR CENTRE IS BEING APPLIED TOWARD THE STRUCTURAL APPOINTMENT. PURCHASER HAS A REMAINING AMOUNT OF \$830.30 (INCLUDING TAXES) TO BE USED TOWARD THE COLOUR APPOINTMENT
Line23132	Note:
10Jul17 / 27Sep17	
Inv.1,489	1 - Purchaser has attended a Structural appointment at the Decor Centre & has DECLINED any additional upgrades and accepts and acknowledges that there will be no further structural changes/additions/deletions to be made upon signing on July 10, 2017.
Line23133	Note:
10Jul17 / 27Sep17	
Inv.1,489	1 - Purchasers are aware & accepts that ANY changes made to upgrades after signing this Purchasers Extra Form are subject to a minimum administration fee of \$500. PLUS a 10% holdback fee
Line23134	Note:
10Jul17 / 27Sep17	

PLUMBING



CONSTRUCTION SUMMARY

Brampton Encore - 5L - 2 - 28-2 Elev.A SIREN

Inv.1,489	1 - KITCHEN: INSTALL ROUGH-IN - WATERLINE FOR FRIDGE
Line23128	Note:
10Jul17 / 27Sep17	

WINDOWS - BASEMENT


Inv.1,489	3 - BASEMENT: INSTALL THREE (X3) BASEMENT WINDOWS - UPGRADE EXISTING BASEMENT WINDOW TO 30 INCH X 24 INCH - MAY REQUIRE INSTALLATION OF WINDOW WELL
Line23127	Note: PURCHASER IS AWARE THAT THE SIDE WINDOW IS EXTREMELY LIKELY TO GET THE WINDOW WELL
10Jul17 / 27Sep17	

Telephone — (T)
 Cable — (C)
 Electrical — (E)

The Siren

SEMI SERIES


Elevation A • 1,688 sq.ft.
 Elevation B • 1,677 sq.ft.
 Elevation C • 1,687 sq.ft.

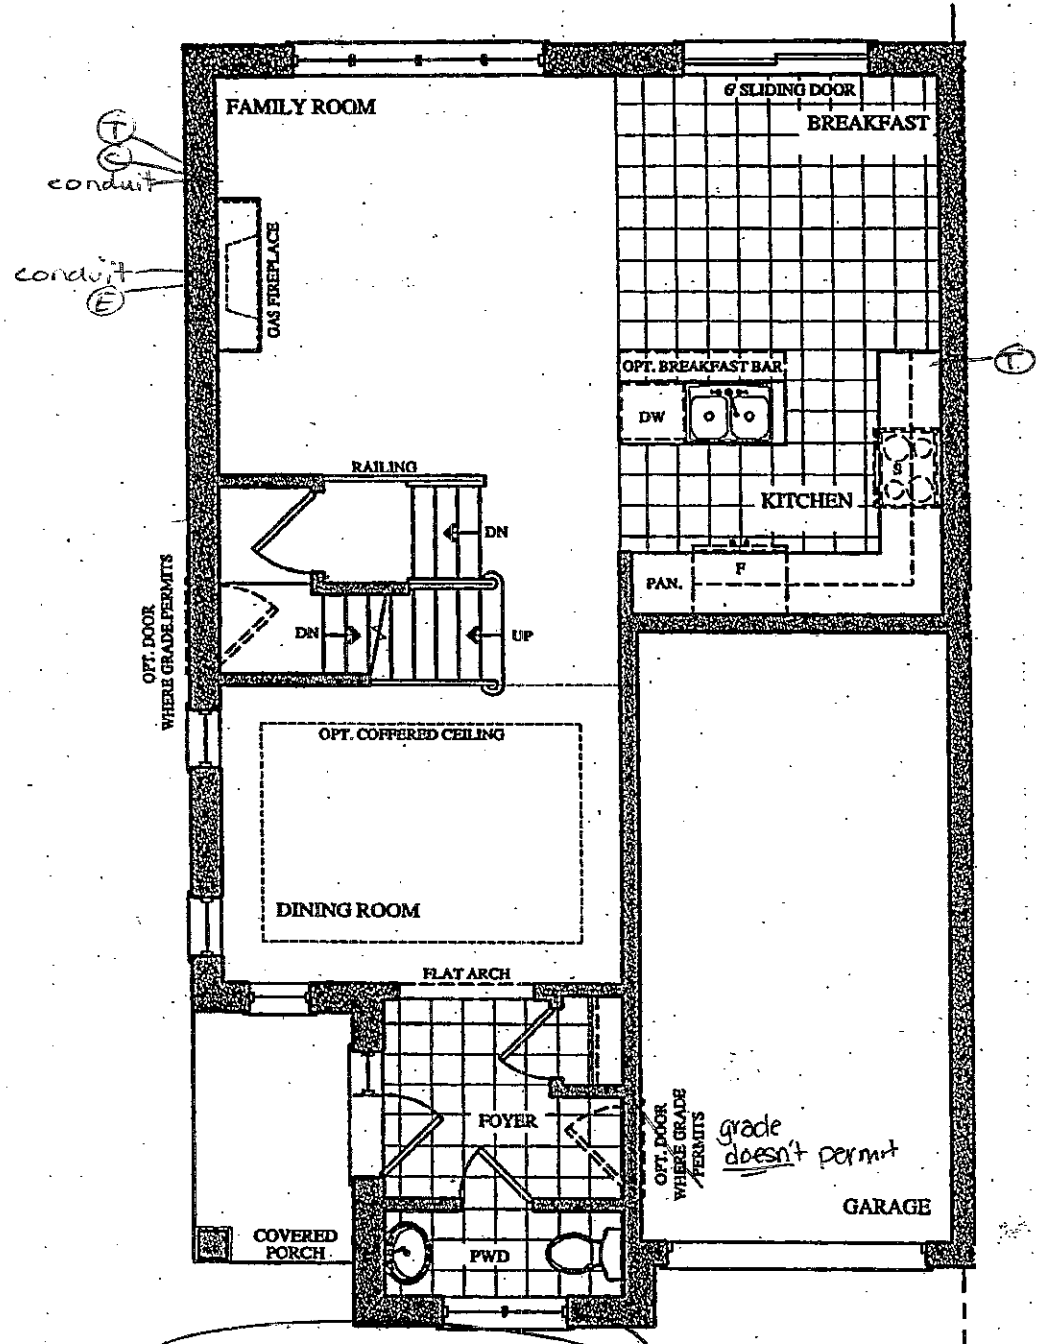

GROUND FLOOR PLAN
 ELEV. 'A' & 'B'

Lot 5L
 July 10, 17

[Handwritten signature]

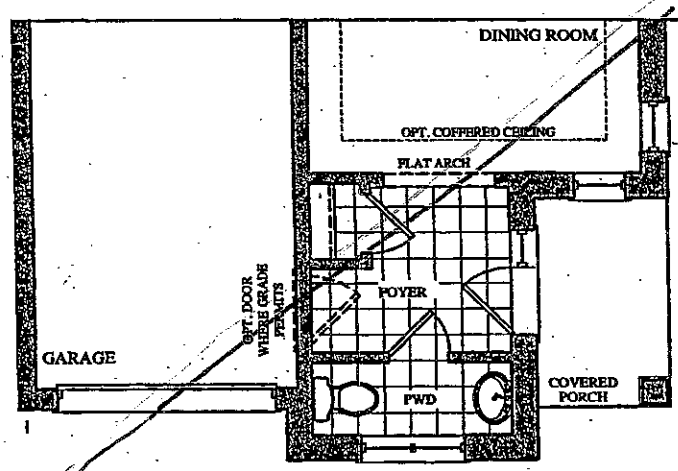


PART. GROUND FLOOR PLAN
 ELEV. 'C'

Telephone — (T)
 Cable — (C)


The Siren

SEMI SERIES

Elevation A • 1,688 sq.ft.
 Elevation B • 1,677 sq.ft.
 Elevation C • 1,687 sq.ft.

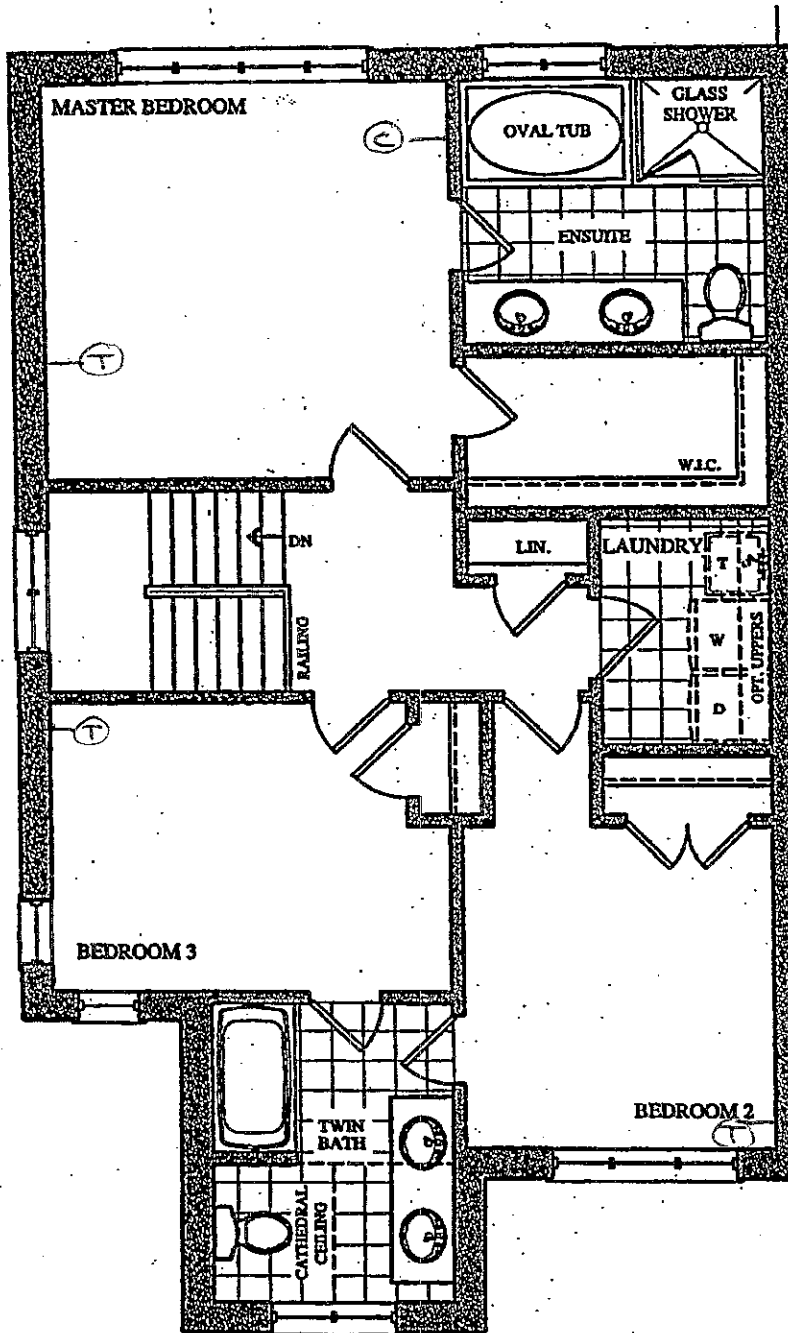


SECOND FLOOR PLAN
 ELEV. 'A'

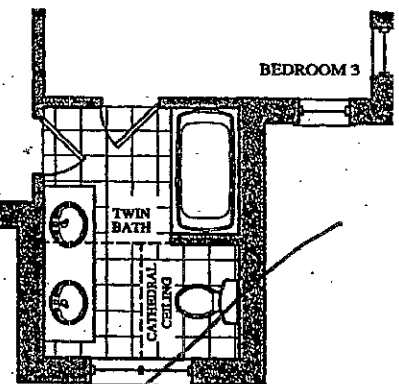

PART. SECOND FLOOR PLAN
 ELEV. 'B'


Lot SL
 July 10, 17

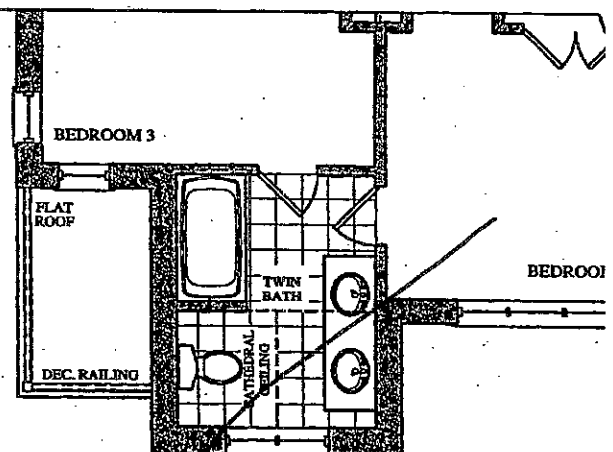

PART. SECOND FLOOR PLAN
 ELEV. 'C'

The
Siren
SEMI SERIES

Elevation A • 1,688 sq.ft.
Elevation B • 1,677 sq.ft.
Elevation C • 1,687 sq.ft.

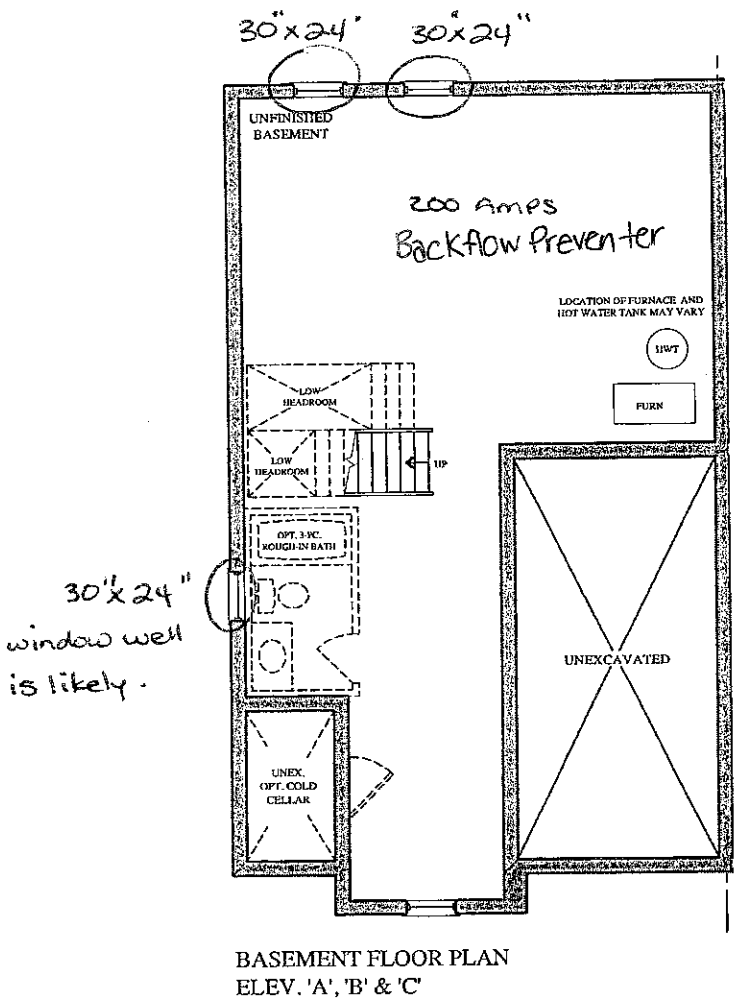

Prices, figures, illustrations, sizes, features and finishes are subject to change without notice. Areas and dimensions are approximate and actual usable floor space may vary from the stated area. Layout may be reverse of the unit purchased. E. & O.E.

GOLDPARK
WORTH MORE™

Lot 5L
July 10, 17

