

Brampton Encore - 13R - 2 - 28-3 Elev.D Bruckner

Exterior Colours

Inv.1,452	1 - EXTERIOR COLOUR PACKAGE # 4
Line24233	Note:
22Jun17 / 27Sep17	

FRAMING

Inv.1,589	3 - TALLER MAIN FLOOR ARCHES
Line24234	Note:
27Sep17 / 27Sep17	

INTERIOR TRIM AND DOORS

Inv.1,452	3 - MAIN FLOOR: EXTENDED HEIGHT ARCHWAY (PRICE PER DOORWAY) -96" ARCHWAYS
Line22728	Note:
22Jun17 / 27Sep17	
Inv.1,589	1 - MISSED ARCH ON PE:1452
Line24235	Note:
27Sep17 / 27Sep17	

MISC.

Inv.1,452	1 - Purchaser has attended an appointment at the Decor Centre & has DECLINED any additional upgrades and accepts and acknowledges that there will be no further changes/additions/deletions to be made upon signing on June 22 2017.
Line22729	Note:
22Jun17 / 27Sep17	
Inv.1,452	1 - Purchasers are aware & accepts that ANY changes made to upgrades after signing this Purchasers Extra Form are subject to a minimum administration fee of \$500. PLUS a 10% holdback fee.
Line22730	Note:
22Jun17 / 27Sep17	
Inv.1,452	1 - BONUS PACKAGE: \$5,000.00 (INCLUDING TAXES) WORTH OF UPGRADES FROM GOLD PARK HOMES DÉCOR CENTRE IS BEING APPLIED TOWARD THE STRUCTURAL APPOINTMENT. PURCHASER HAS A REMAINING AMOUNT OF \$3666.60 (INCLUDING TAXES) TO BE USED TOWARD THE COLOUR APPOINTMENT.
Line22731	Note:
22Jun17 / 27Sep17	
Inv.1,589	1 - BONUS PACKAGE: (\$3666.60) REMAINING LESS THIS NEW INVOICE \$330.00. PURCHASER HAS A NEW AMOUNT REMAINING OF \$3336.60
Line24236	Note:
27Sep17 / 27Sep17	

WINDOWS - BASEMENT

Inv.1,452	2 - BASEMENT WINDOWS - UPGRADE EXISTING BASEMENT WINDOW TO 30 INCH X 24 INCH - MAY REQUIRE INSTALLATION OF WINDOW WELL
Line22726	Note:
22Jun17 / 27Sep17	

WINDOWS AND DOORS

Inv.1,452	1 - INSTALL MANDOOR- GARAGE TO HOUSE
Line24232	Note:
22Jun17 / 27Sep17	


The Bruckner SEMI SERIES

Elevation A • 1,766 sq.ft.

Elevation B • 1,787 sq.ft.

Elevation C • 1,795 sq.ft.

→ Elevation D • 1,782 sq.ft.

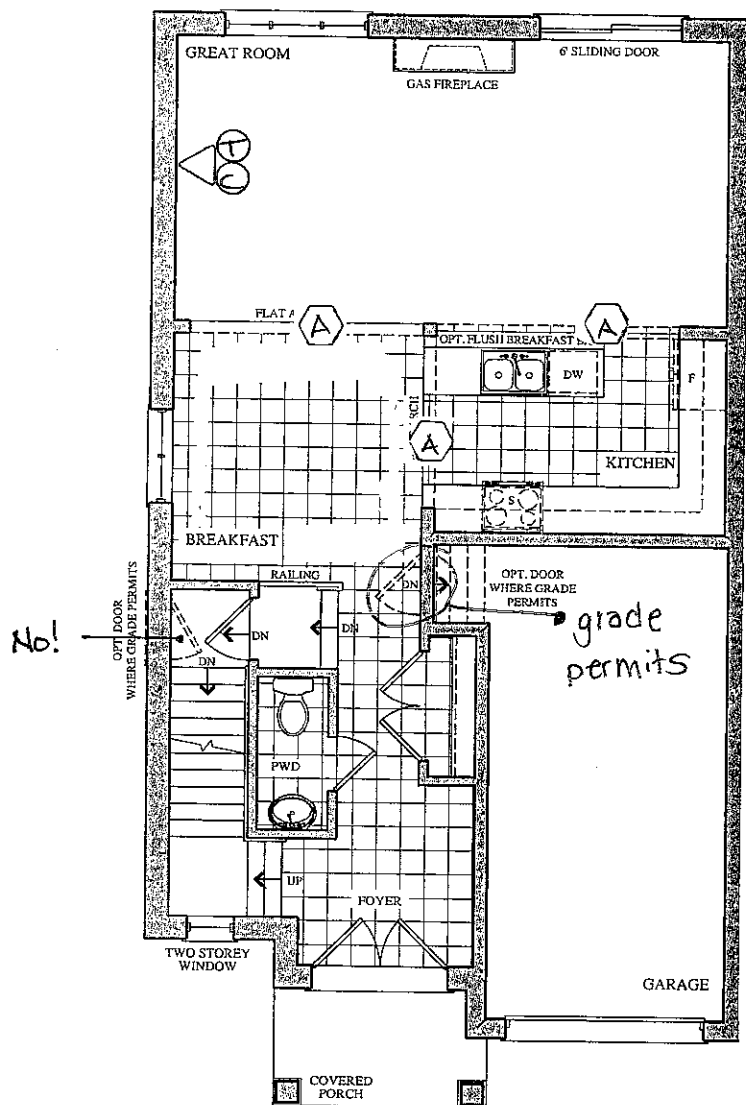

GROUND FLOOR PLAN
ELEV. 'A' & 'B'


No PHONE
in kitchen!

LEGEND

⬆️ PHONE

⬆️ CABLE

⬆️ 96" Area

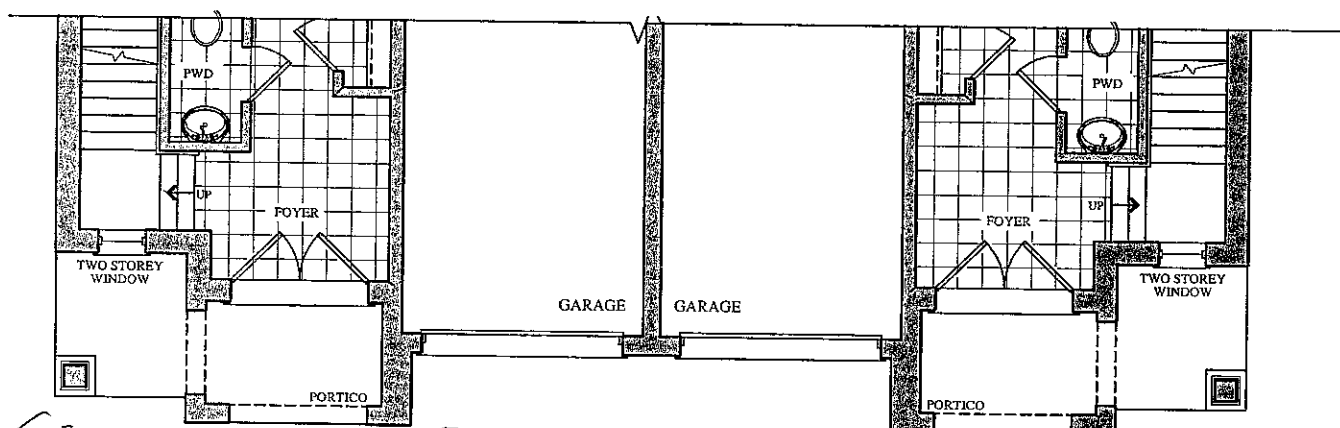


PART. GROUND FLOOR PLAN
ELEV. 'C' & 'D'


BEZ-13R
JUNE 22 2017 BP

The
Bruckner
SEMI SERIES


Elevation A • 1,766 sq.ft.
Elevation B • 1,787 sq.ft.
Elevation C • 1,795 sq.ft.
→ Elevation D • 1,782 sq.ft.

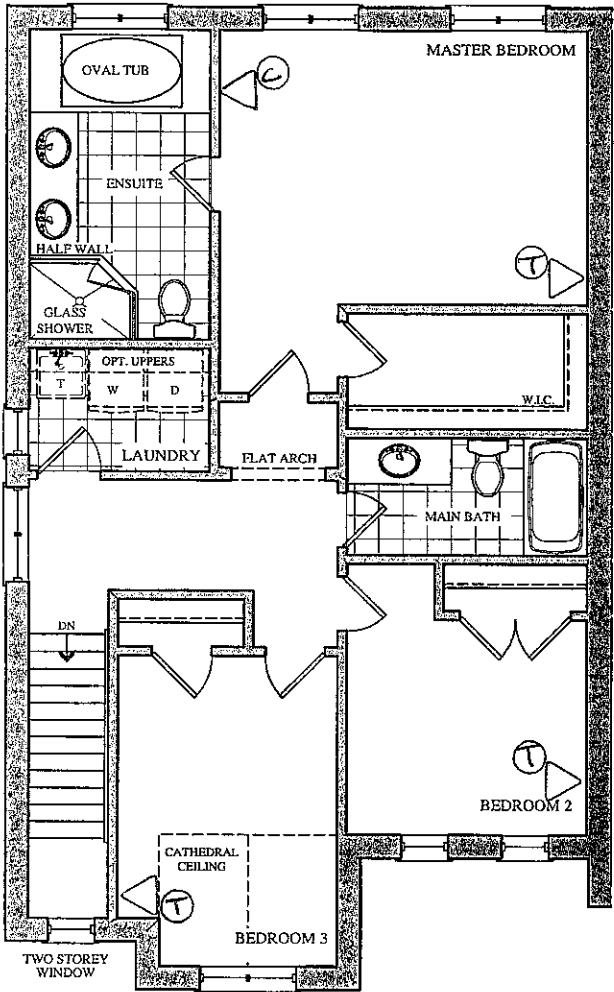


~~SECOND FLOOR PLAN
ELEV. 'A'~~

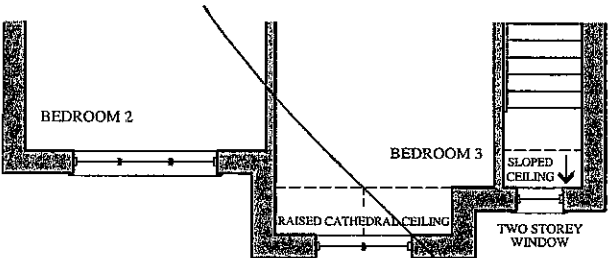

~~PART. SECOND FLOOR PLAN
ELEV. 'B'~~

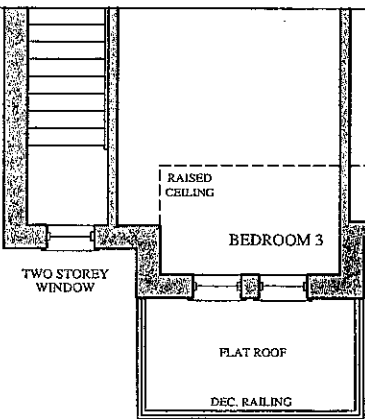

PART. SECOND FLOOR PLAN
ELEV. 'C'

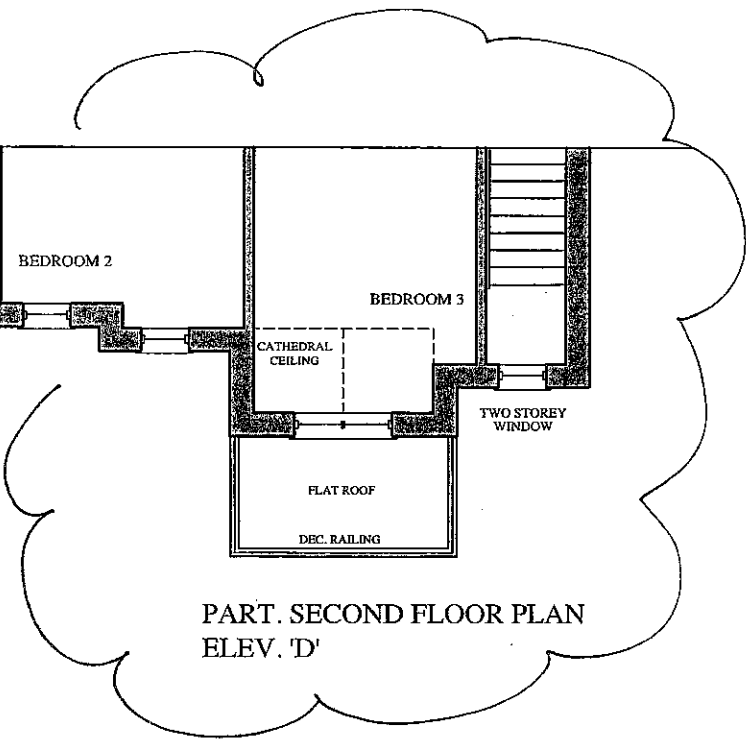


PART. SECOND FLOOR PLAN
ELEV. 'D'


BE2-13R (BP)
JUNE 22 2017

The Bruckner SEMI SERIES

Elevation A • 1,766 sq.ft.
Elevation B • 1,787 sq.ft.
Elevation C • 1,795 sq.ft.
Elevation D • 1,782 sq.ft.

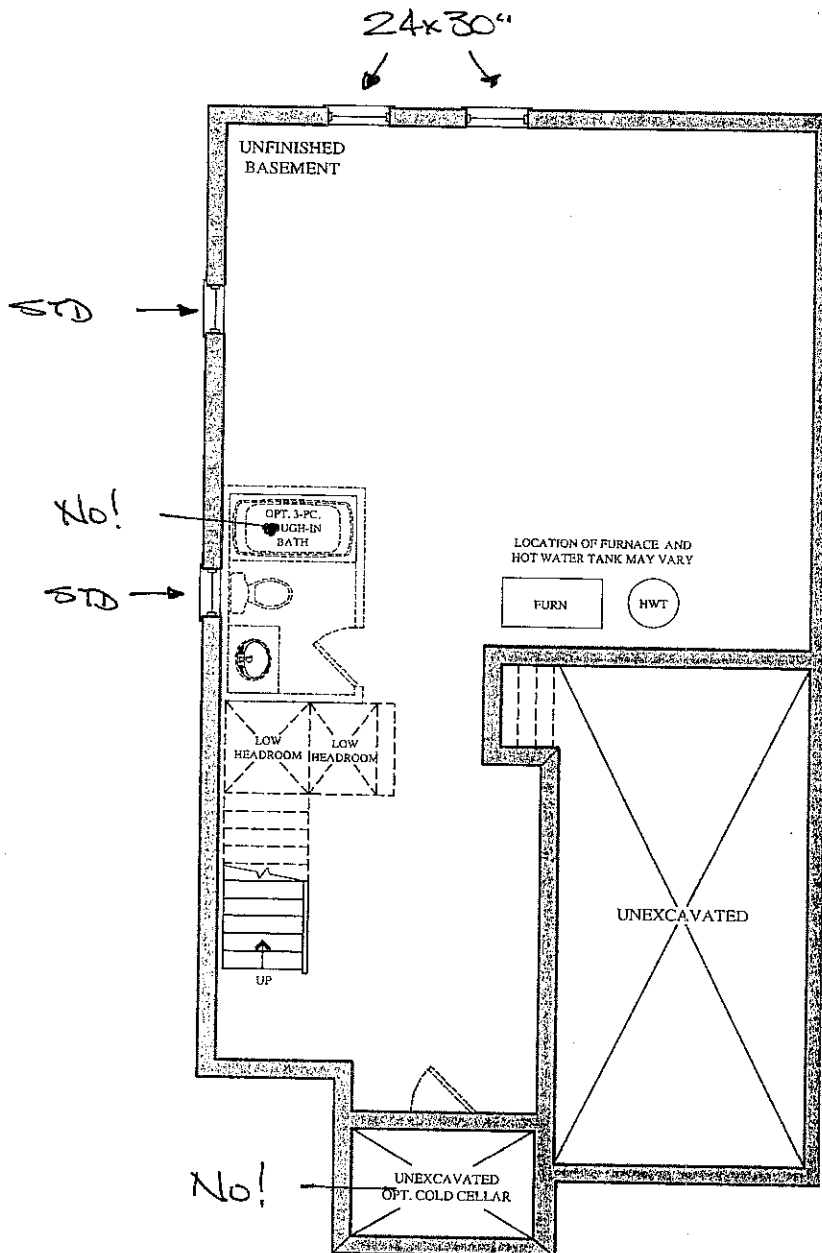

BASEMENT FLOOR PLAN
ELEV. 'A' & 'B'

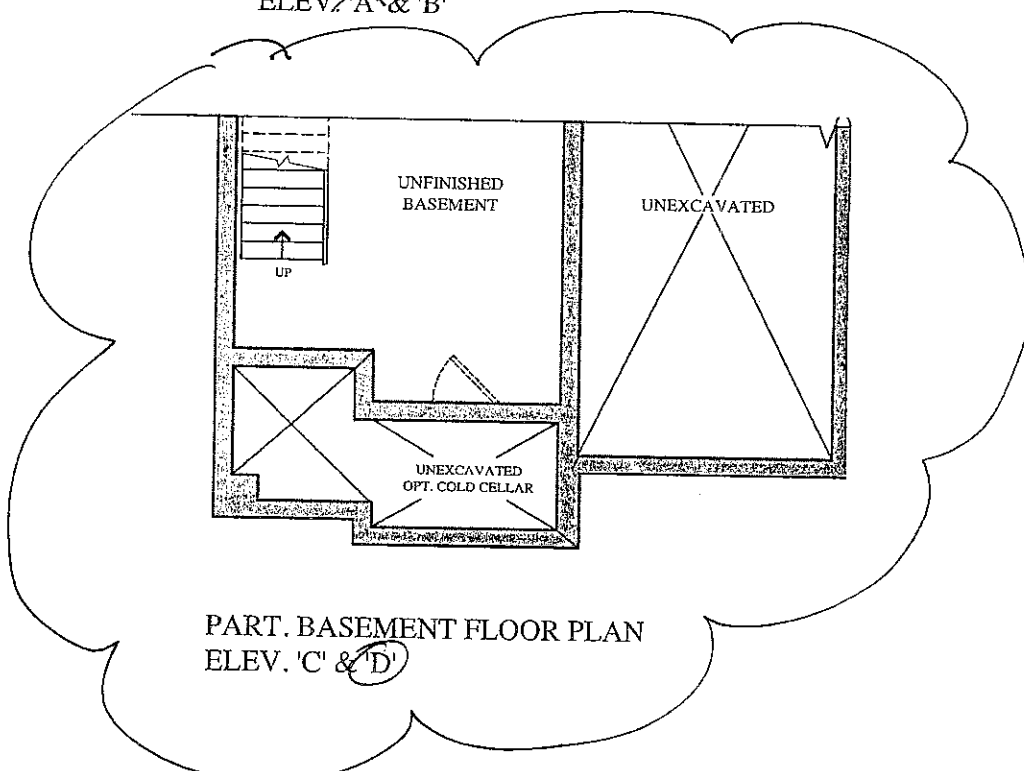

PART. BASEMENT FLOOR PLAN
ELEV. 'C' & 'D'