

Brampton Encore - 12R - 2 - 28-2 Elev.CR Siren

Exterior Colours

Inv.1,473	1 - EXTERIOR COLOUR PACKAGE 2
Line24280	Note:
4Jul17 / 3Oct17	

FRAMING

Inv.1,473	1 - MAIN FLOOR: EXTENDED HEIGHT ARCHWAY (PRICE PER DOORWAY) -96"
Line24281	Note:
4Jul17 / 3Oct17	

GARAGE DOORS

Inv.1,473	1 - GARAGE DOOR OPENER *BELT DRIVE* - WITH 1 REMOTE- PRICE IS PER DOOR
Line22965	Note:
4Jul17 / 3Oct17	

INTERIOR TRIM AND DOORS

Inv.1,473	1 - MAIN FLOOR: EXTENDED HEIGHT ARCHWAY (PRICE PER DOORWAY) -96"
Line22966	Note:
4Jul17 / 3Oct17	

MISC.

Inv.1,473	1 - DO NOT INSTALL- GRADE DOESN'T PERMIT SIDE DOOR- HOME TO EXTERIOR-
Line22963	Note:
4Jul17 / 3Oct17	
Inv.1,473	1 - Purchaser has attended an appointment at the Decor Centre & has DECLINED any additional upgrades and accepts and acknowledges that there will be no further changes/additions/deletions to be made upon signing on July 4 2017.
Line22967	Note:
4Jul17 / 3Oct17	
Inv.1,473	1 - Purchasers are aware & accepts that ANY changes made to upgrades after signing this Purchasers Extra Form are subject to a minimum administration fee of \$500. PLUS a 10% holdback fee.
Line22968	Note:
4Jul17 / 3Oct17	
Inv.1,473	1 - BONUS PACKAGE: \$10,000.00 (INCLUDING TAXES) WORTH OF UPGRADES FROM GOLD PARK HOMES DÉCOR CENTRE IS BEING APPLIED TOWARD THE STRUCTURAL APPOINTMENT. PURCHASER HAS A REMAINING AMOUNT OF \$5446.10 (INCLUDING TAXES) TO BE USED TOWARD THE COLOUR APPOINTMENT.
Line22970	Note:
4Jul17 / 3Oct17	

WINDOWS - BASEMENT

Inv.1,473	2 - BASEMENT WINDOWS - UPGRADE EXISTING BASEMENT WINDOW TO 30 INCH X 24 INCH - MAY REQUIRE INSTALLATION OF WINDOW WELL
Line22964	Note:
4Jul17 / 3Oct17	

BE2-12R
JULY 4 2017

B.k. K.K.

The Siren

SEMI SERIES

Elevation A • 1,688 sq.ft.
Elevation B • 1,677 sq.ft.
→ Elevation C • 1,687 sq.ft.


No ABUSE in Kitchen!

LEGEND


△ 96" ARCH

△ PHONE

△ CABLE

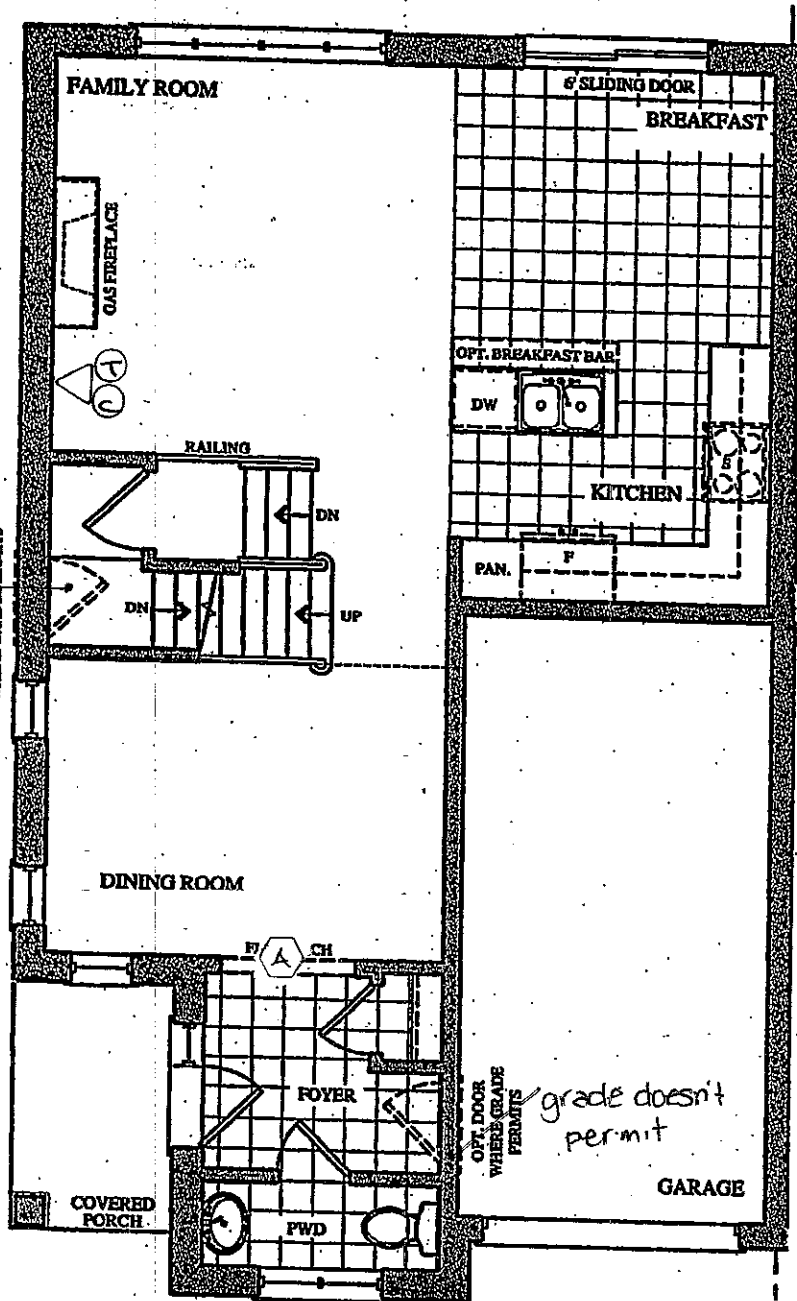

GROUND FLOOR PLAN
ELEV. 'A' & 'B'

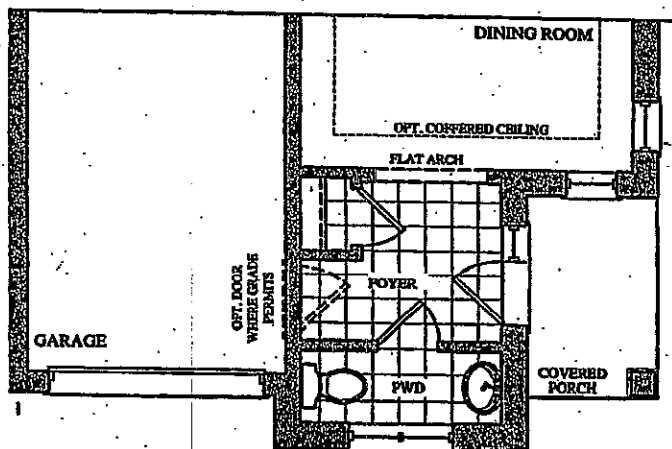


PART. GROUND FLOOR PLAN
ELEV. 'C'

BE2-12R
 July 4 2017 (B.K.) 148


The Siren

SEMI SERIES


Elevation A • 1,688 sq.ft.
 Elevation B • 1,677 sq.ft.
 Elevation C • 1,687 sq.ft.

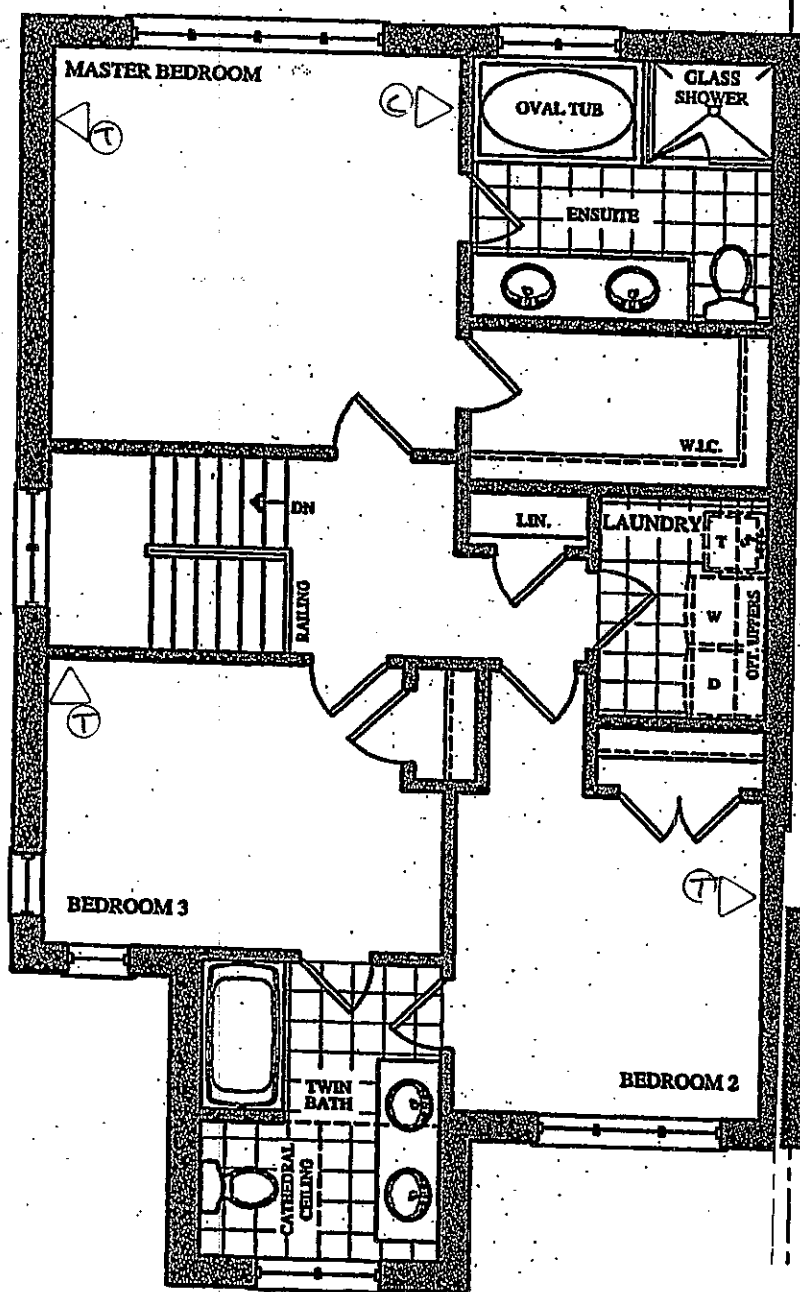

SECOND FLOOR PLAN
 ELEV. 'A'

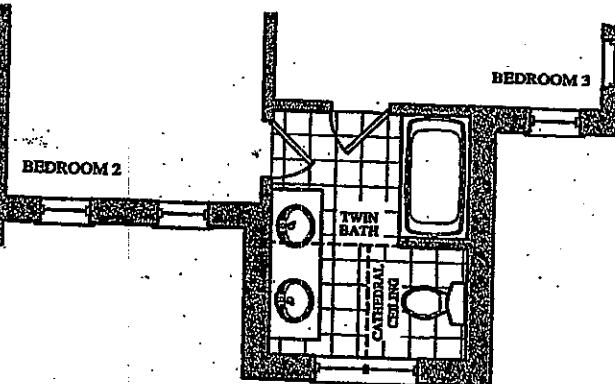

PART. SECOND FLOOR PLAN
 ELEV. 'B'

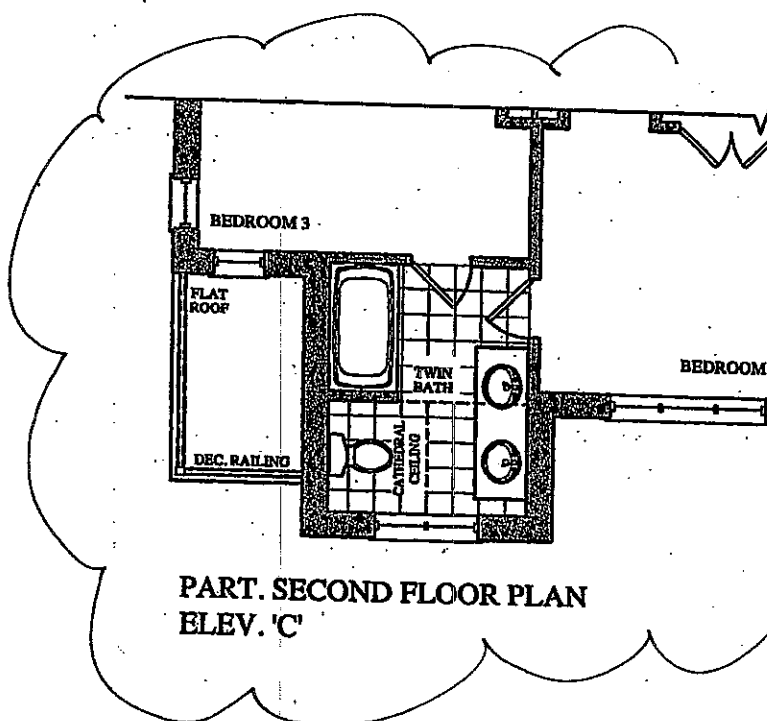

PART. SECOND FLOOR PLAN
 ELEV. 'C'

BE2-12R
July 4 2017

(Bk) (145)

The Siren

SEMI SERIES

Elevation A • 1,688 sq.ft.
Elevation B • 1,677 sq.ft.
→ Elevation C • 1,687 sq.ft.

