

Brampton Encore - 22R - 2 - 28-2 Elev.B SIREN
CENTRAL VAC AND WIRING

Inv.1,528	1 - TELEPHONE AND CABLE ROUGH-IN LOCATIONS
Line23581	Note:
27Jul17 / 2Oct17	

ELECTRICAL

Inv.1,528	1 - BASEMENT: INSTALL 200 AMP ELECTRICAL SERVICE
Line23582	Note:
27Jul17 / 2Oct17	

Exterior Colours

Inv.1,528	1 - EXTERIOR COLOUR PACKAGE 9
Line24322	Note:
27Jul17 / 2Oct17	

FRAMING

Inv.1,528	1 - GARAGE: INSTALL ROUGH-IN FOR FUTURE MANDOOR - GARAGE TO HOUSE- AS PER PLAN AND GRADE PERMITTING
Line23585	Note:
27Jul17 / 2Oct17	

MISC.

Inv.1,528	1 - Purchasers are aware & accepts that ANY changes made to upgrades after signing this Purchasers Extra Form are subject to a minimum administration fee of \$500. PLUS a 10% holdback fee.
Line23588	Note:
27Jul17 / 2Oct17	

Inv.1,528	1 - REFUND- EXTERIOR: INSTALL SIDE DOOR- HOME TO EXTERIOR- GRADE DOESN'T PERMIT
Line23584	Note:
27Jul17 / 2Oct17	

Inv.1,528	1 - BONUS PACKAGE: \$5,000.00 (INCLUDING TAXES) WORTH OF UPGRADES FROM GOLD PARK HOMES DÉCOR CENTRE IS BEING APPLIED TOWARD THE STRUCTURAL APPOINTMENT. PURCHASER HAS A REMAINING AMOUNT OF \$00 (INCLUDING TAXES) TO BE USED TOWARD THE COLOUR APPOINTMENT.
Line23586	Note:
27Jul17 / 2Oct17	

Inv.1,528	1 - Purchaser has attended a Structural appointment at the Decor Centre & has DECLINED any additional upgrades and accepts and acknowledges that there will be no further structural changes/additions/deletions to be made upon signing on July 27, 2017
Line23587	Note:
27Jul17 / 2Oct17	

WINDOWS - BASEMENT

Inv.1,528	4 - BASEMENT: INSTALL FOUR (X4) BASEMENT WINDOWS - UPGRADE EXISTING BASEMENT WINDOW TO 30 INCH X 24 INCH - MAY REQUIRE INSTALLATION OF WINDOW WELL
Line23583	Note: PURCHASER IS AWARE THAT THE SIDE OF THE HOUSE WILL GET A WINDOW WELL
27Jul17 / 2Oct17	

WINDOWS AND DOORS


Inv.1,528	1 - DO NOT SUPPLY MANDOOR- GRADE DOESN'T PERMIT
Line24321	Note:
27Jul17 / 2Oct17	

Telephone — (T)
 Cable — (C)


The Siren

SEMI SERIES

Elevation A • 1,688 sq.ft.
 Elevation B • 1,677 sq.ft.
 Elevation C • 1,687 sq.ft.

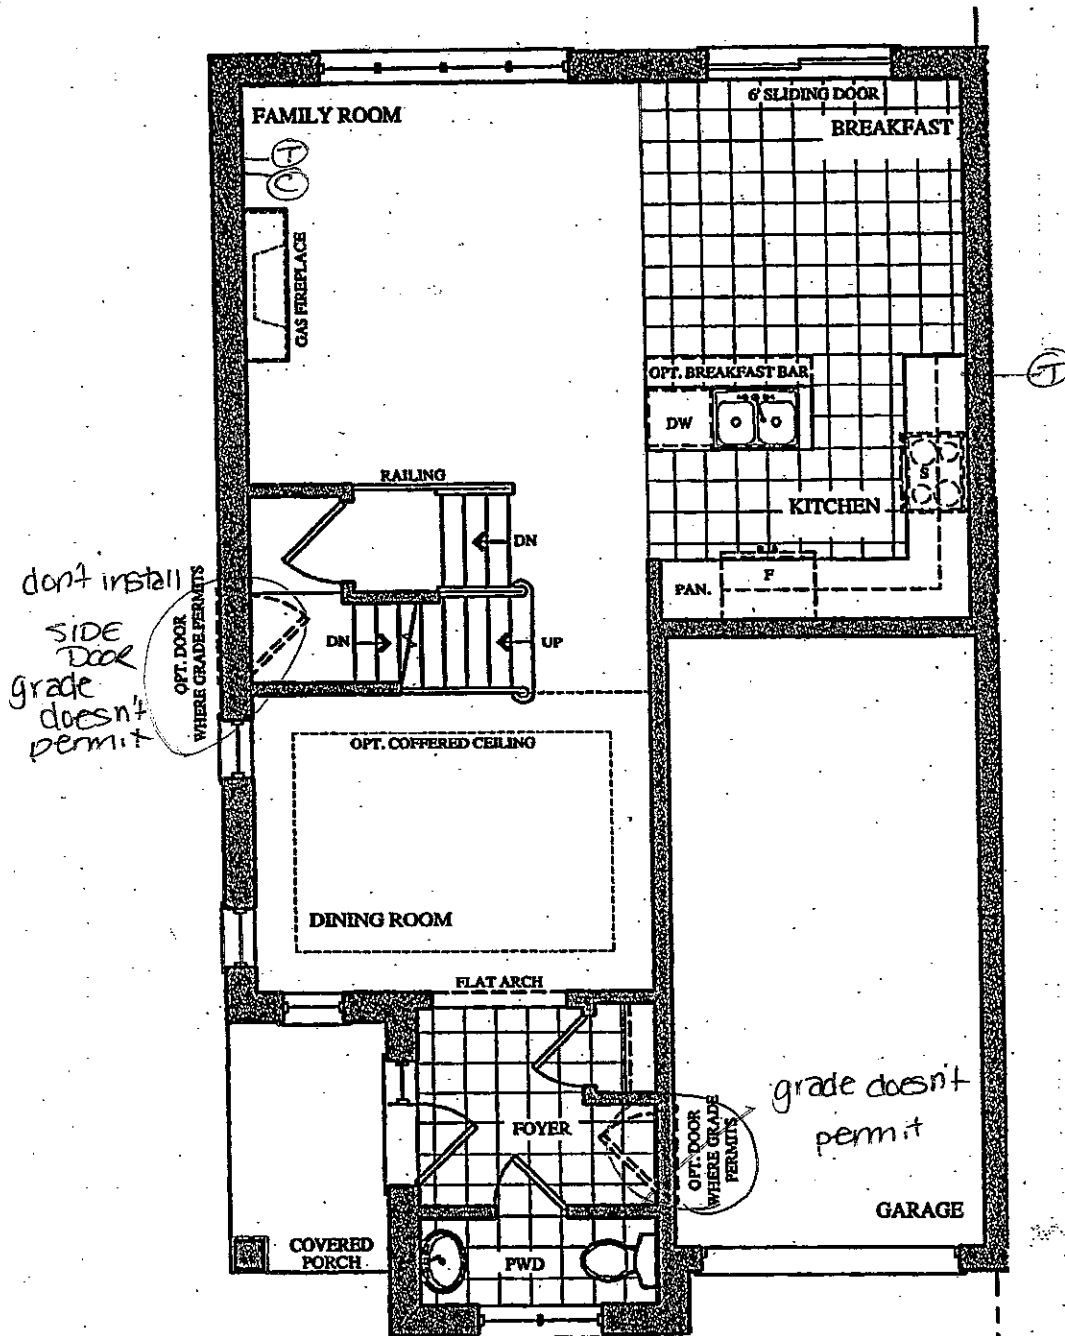

GROUND FLOOR PLAN
 ELEV. 'A' & 'B'

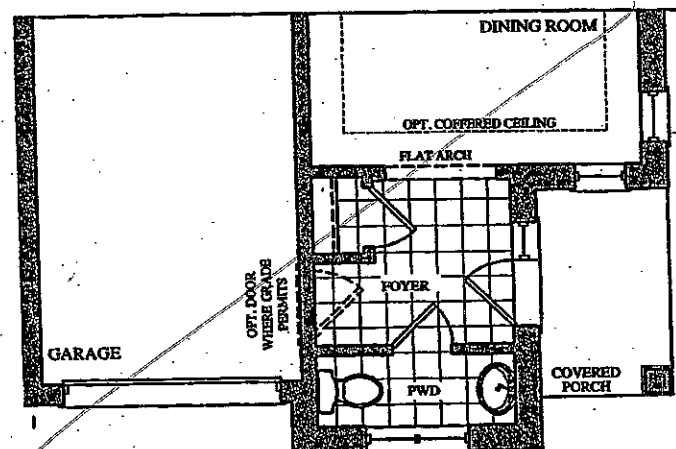

PART. GROUND FLOOR PLAN
 ELEV. 'C'

Lot 22 R
 July 27, 17

(Handwritten initials and signature)

Telephone — (T)

Cable — (C)


The Siren

SEMI SERIES


Elevation A • 1,688 sq.ft.

Elevation B • 1,677 sq.ft.


Elevation C • 1,687 sq.ft.

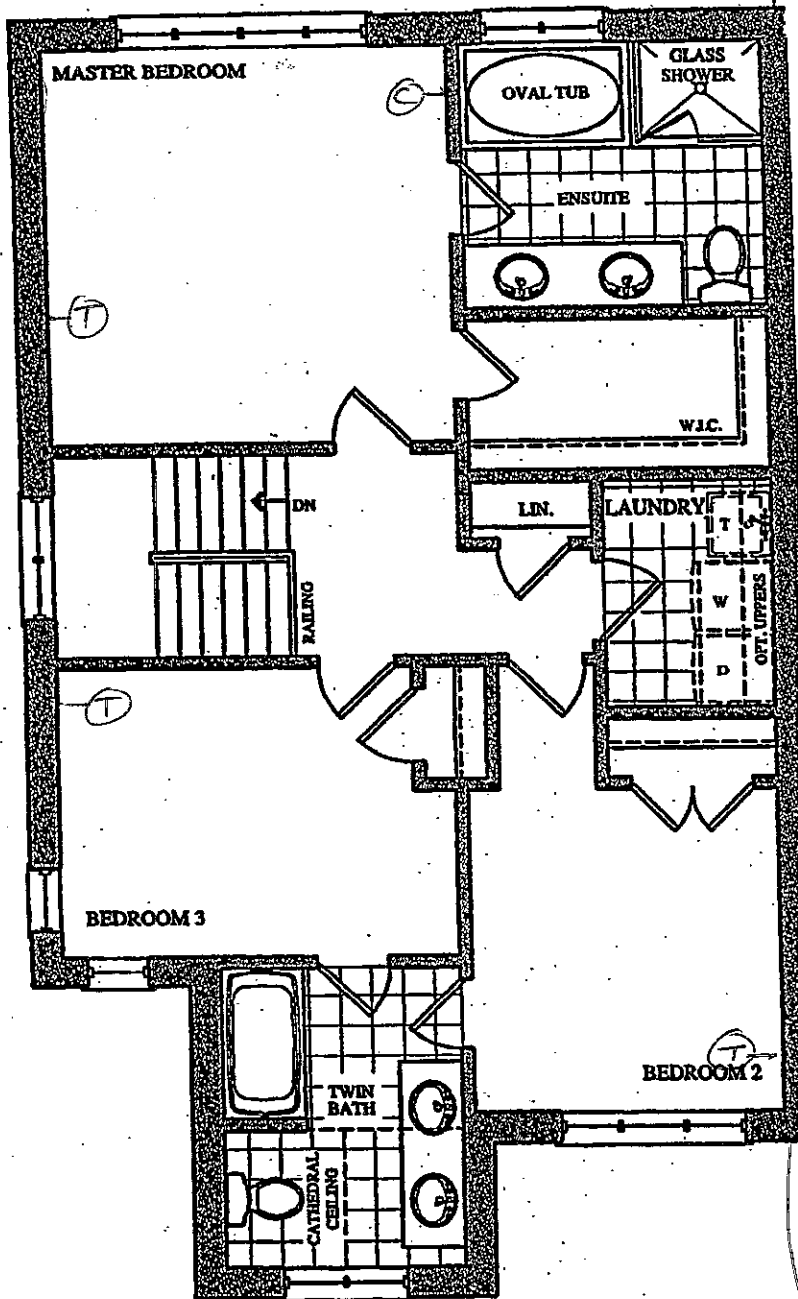

SECOND FLOOR PLAN
ELEV. 'A'

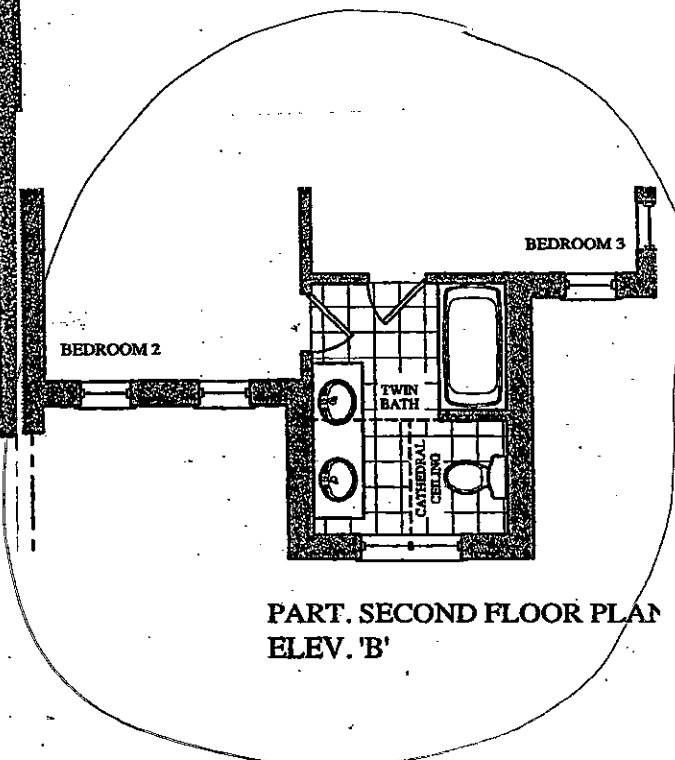

PART. SECOND FLOOR PLAN
ELEV. 'B'

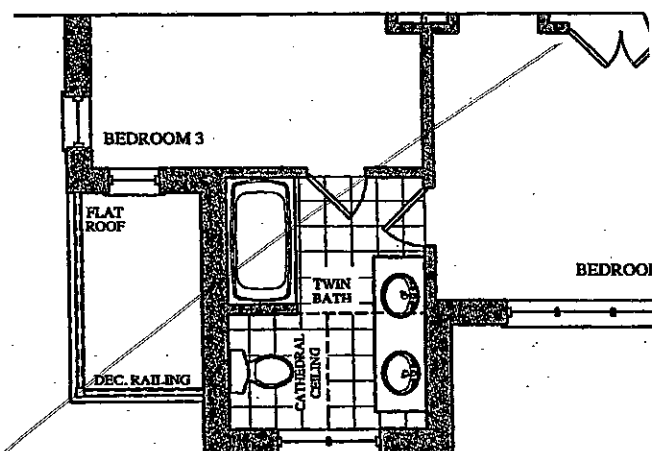

PART. SECOND FLOOR PLAN
ELEV. 'C'


Lot 22R
July 27, 17



BSMNT WINDOWS
4 x 30" x 24"

The
Siren
SEMI SERIES

Elevation A • 1,688 sq.ft.
Elevation B • 1,677 sq.ft.
Elevation C • 1,687 sq.ft.

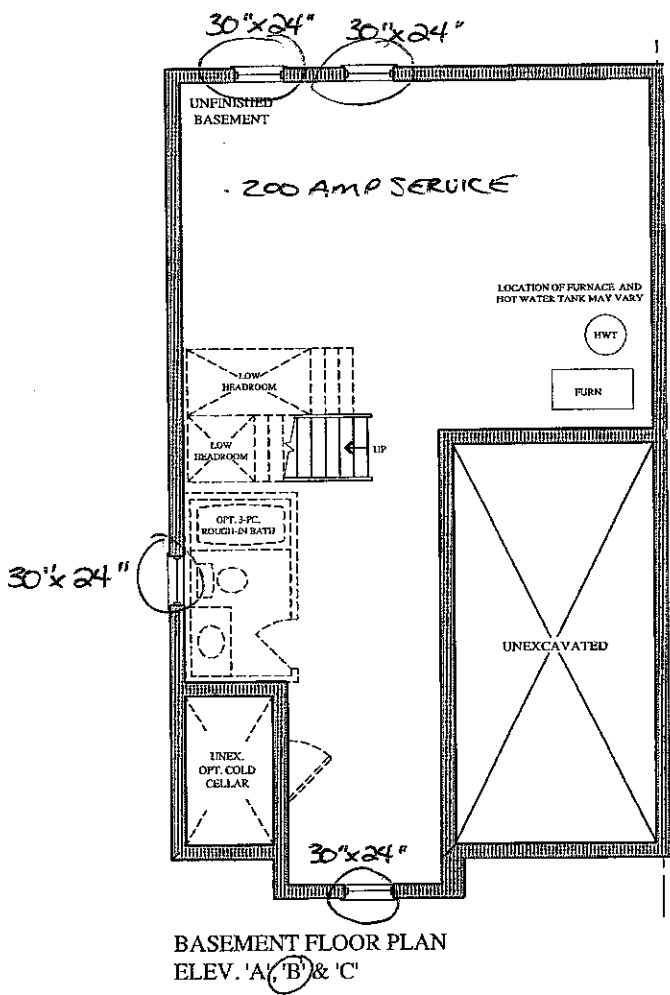

Prices, figures, illustrations, sizes, features and finishes are subject to change without notice. Areas and dimensions are approximate and actual usable floor space may vary from the stated area. Layout may be reverse of the unit purchased. E. & O.E.

GOLDPARK
WORTH MORE™

Lot 22L
July 27, 17