

Brampton Encore - 21R - 2 - 28-8 Elev.B BEETHOVEN
CENTRAL VAC AND WIRING

Inv.1,365	1 - FAMILY ROOM: CONDUIT PIPE- FOR TELEVISION- LOCATE APPROX. 66" A.F.F., TERMINATING BESIDE CABLE OUTLET. SEE PLAN FOR LOCATION.
Line21465	Note:
16May17 / 20Oct17	

ELECTRICAL

Inv.1,365	1 - FAMILY ROOM: 110V WALL RECEPTACLE ON NORMAL CIRCUIT- LOCATE APPROX. 66" A.F.F. ABOVE FIREPLACE FOR FUTURE TV
Line21464	Note:
16May17 / 20Oct17	

Inv.1,365	1 - KITCHEN: MOVE STANDARD CEILING LIGHT TO ABOVE ISLAND
Line21468	Note:
16May17 / 20Oct17	

Inv.1,365	1 - KITCHEN: ROUGH - IN CEILING OUTLET ON SAME SWITCH - DOES NOT INCLUDE FIXTURE - LOCATE ABOVE ISLAND, USE SAME SWITCH AS STANDARD LIGHT. SEE PLAN FOR LOCATION.
Line21469	Note:
16May17 / 20Oct17	

Inv.1,365	1 - GARAGE: RECEPTACLE FOR FUTURE GARAGE OPENER.
Line21474	Note:
16May17 / 20Oct17	

Inv.1,365	1 - INSTALL MANDOOR- GARAGE TO HOUSE. GRADE PERMITS
Line24315	Note:
16May17 / 20Oct17	

Inv.1,365	1 - KITCHEN: GAS LINE ROUGH - GROUND FLOOR + 110V REQUIRED ELECTRICAL
Line24316	Note:
16May17 / 20Oct17	

Exterior Colours

Inv.1,365	1 - EXTERIOR COLOUR PACKAGE 4
Line24313	Note:
16May17 / 20Oct17	

FRAMING

Inv.1,365	1 - KITCHEN: UPGRADE VENTING FOR STOVE TO 8" PIPE EXTERIOR WALL
Line24317	Note:
16May17 / 20Oct17	

HVAC

Inv.1,365	1 - KITCHEN: GAS LINE ROUGH - GROUND FLOOR + 110V REQUIRED ELECTRICAL
Line21466	Note:
16May17 / 20Oct17	

Inv.1,365	1 - KITCHEN: UPGRADE VENTING FOR STOVE TO 8" PIPE EXTERIOR WALL
Line21467	Note:
16May17 / 20Oct17	

MISC.

Brampton Encore - 21R - 2 - 28-8 Elev.B BEETHOVEN

Inv.1,365	1 - Purchaser has attended an appointment at the Decor Centre & has DECLINED any additional upgrades and accepts and acknowledges that there will be no further changes/additions/deletions to be made upon signing on May 16 2017.
Line21470	Note:
16May17 / 2Oct17	
Inv.1,365	1 - Purchasers are aware & accepts that ANY changes made to upgrades after signing this Purchasers Extra Form are subject to a minimum administration fee of \$500. PLUS a 10% holdback fee.
Line21471	Note:
16May17 / 2Oct17	
Inv.1,365	1 - BONUS PACKAGE: \$5,000.00 (INCLUDING TAXES) WORTH OF UPGRADES FROM GOLD PARK HOMES DÉCOR CENTRE IS BEING APPLIED TOWARD THE STRUCTURAL APPOINTMENT. PURCHASER HAS A REMAINING AMOUNT OF \$2593.10 (INCLUDING TAXES) TO BE USED TOWARD THE COLOUR APPOINTMENT
Line21472	Note:
16May17 / 2Oct17	

WINDOWS AND DOORS


Inv.1,365	1 - INSTALL MANDOOR- GARAGE TO HOUSE. GRADE PERMITS
Line24314	Note:
16May17 / 2Oct17	

BEZ-21R
May 16 2017



No phone in kitchen!

8" DUCT
+ GAS
LINE

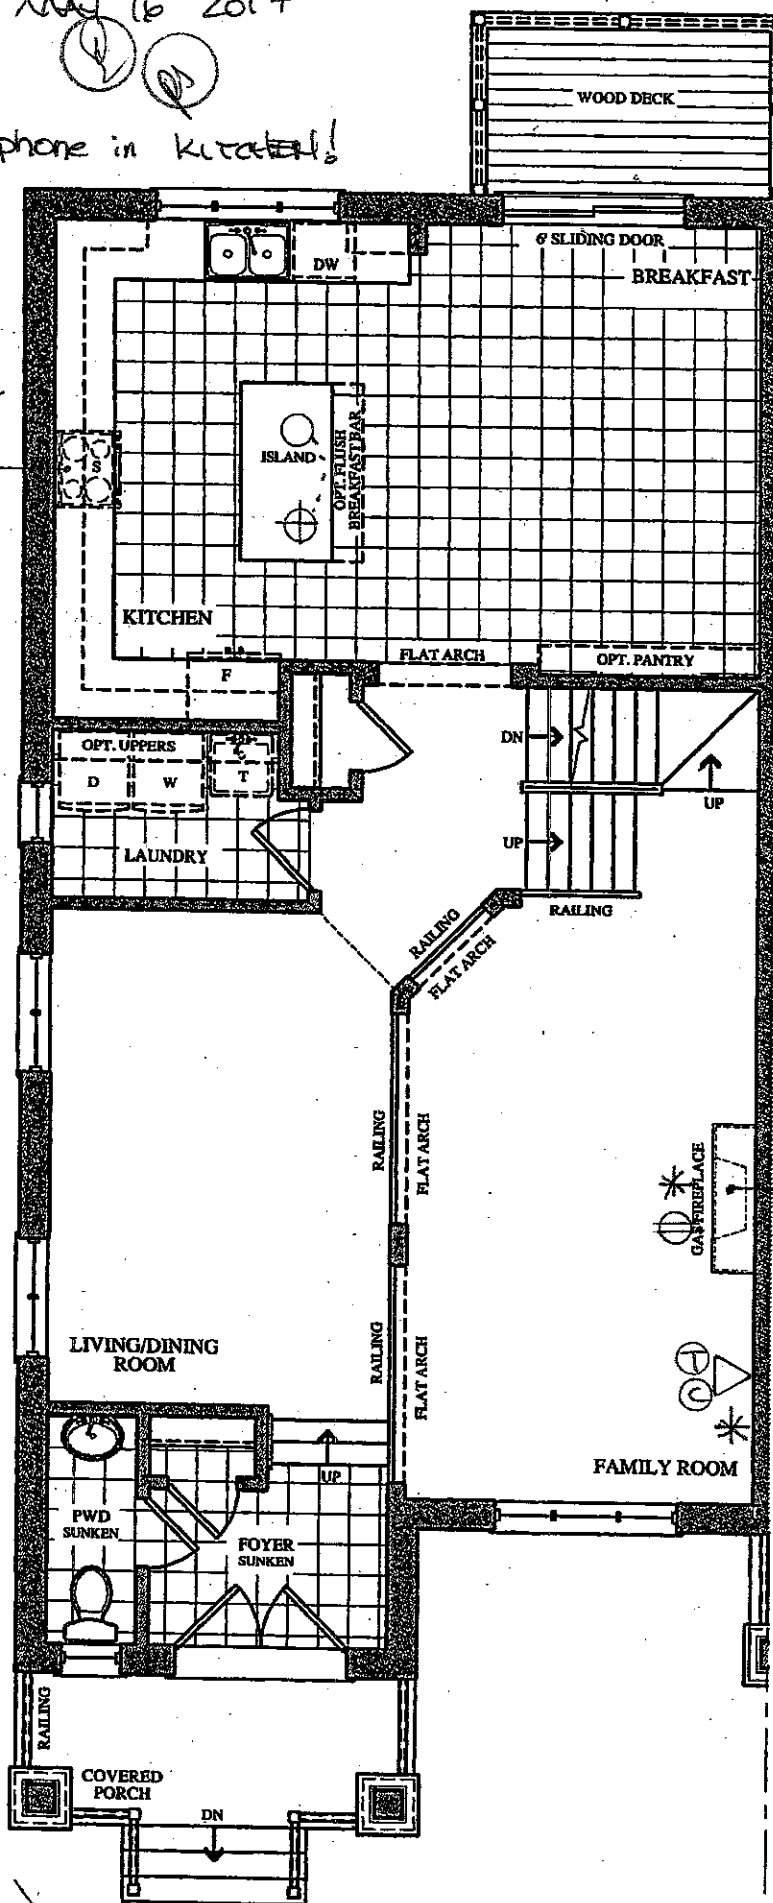


~~GROUND FLOOR PLAN
ELEV. 'A'~~


The Beethoven

SEMI SERIES

- Elevation A • 2,372 sq.ft.
- Elevation B • 2,372 sq.ft.
- Elevation G • 2,372 sq.ft.
- Elevation D • 2,372 sq.ft.

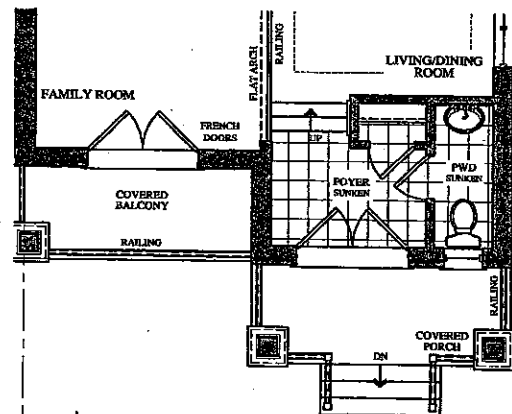

PART. GROUND FLOOR PLAN
ELEV. 'B'

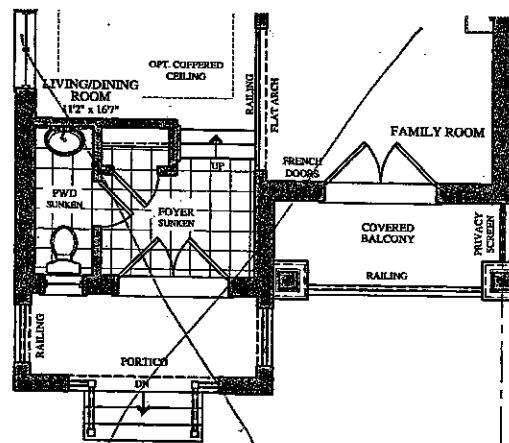

PART. GROUND FLOOR PLAN
ELEV. 'C' & 'D'

BEZ-21R


MAY 16 2017




The Beethoven

SEMI SERIES


- Elevation A • 2,372 sq.ft.
- * Elevation B • 2,372 sq.ft.
- Elevation C • 2,372 sq.ft.
- Elevation D • 2,372 sq.ft.

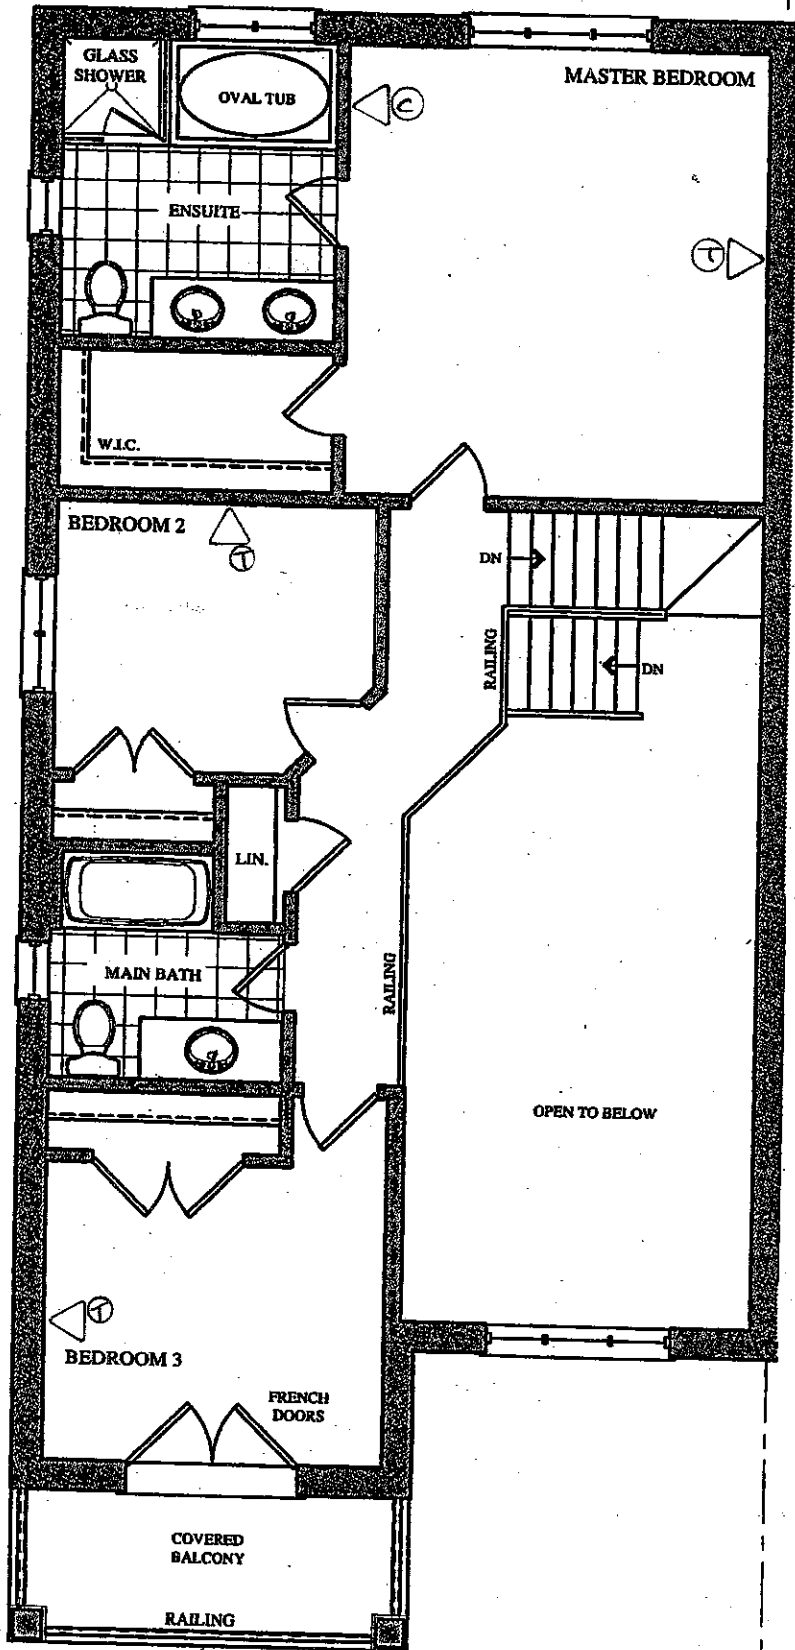

~~SECOND FLOOR PLAN
ELEV. 'A'~~

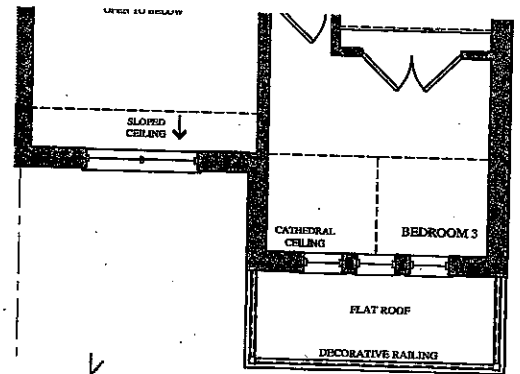

PART. SECOND FLOOR PLAN
ELEV. 'B'

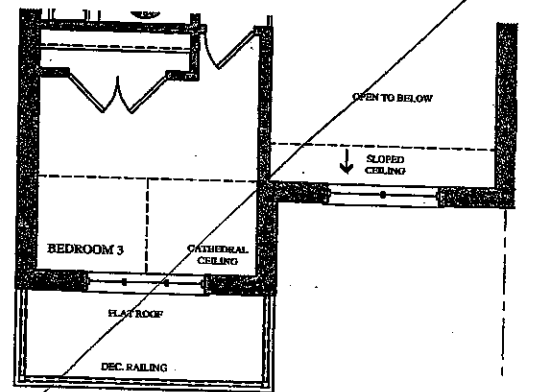

PART. SECOND FLOOR PLAN
ELEV. 'C' & 'D'


BE2-21R
MAY 16 2017



The Beethoven

SEMI SERIES

~~Elevation A • 2,372 sq.ft.~~
~~* Elevation B • 2,372 sq.ft.~~
~~Elevation C • 2,372 sq.ft.~~
~~Elevation D • 2,372 sq.ft.~~

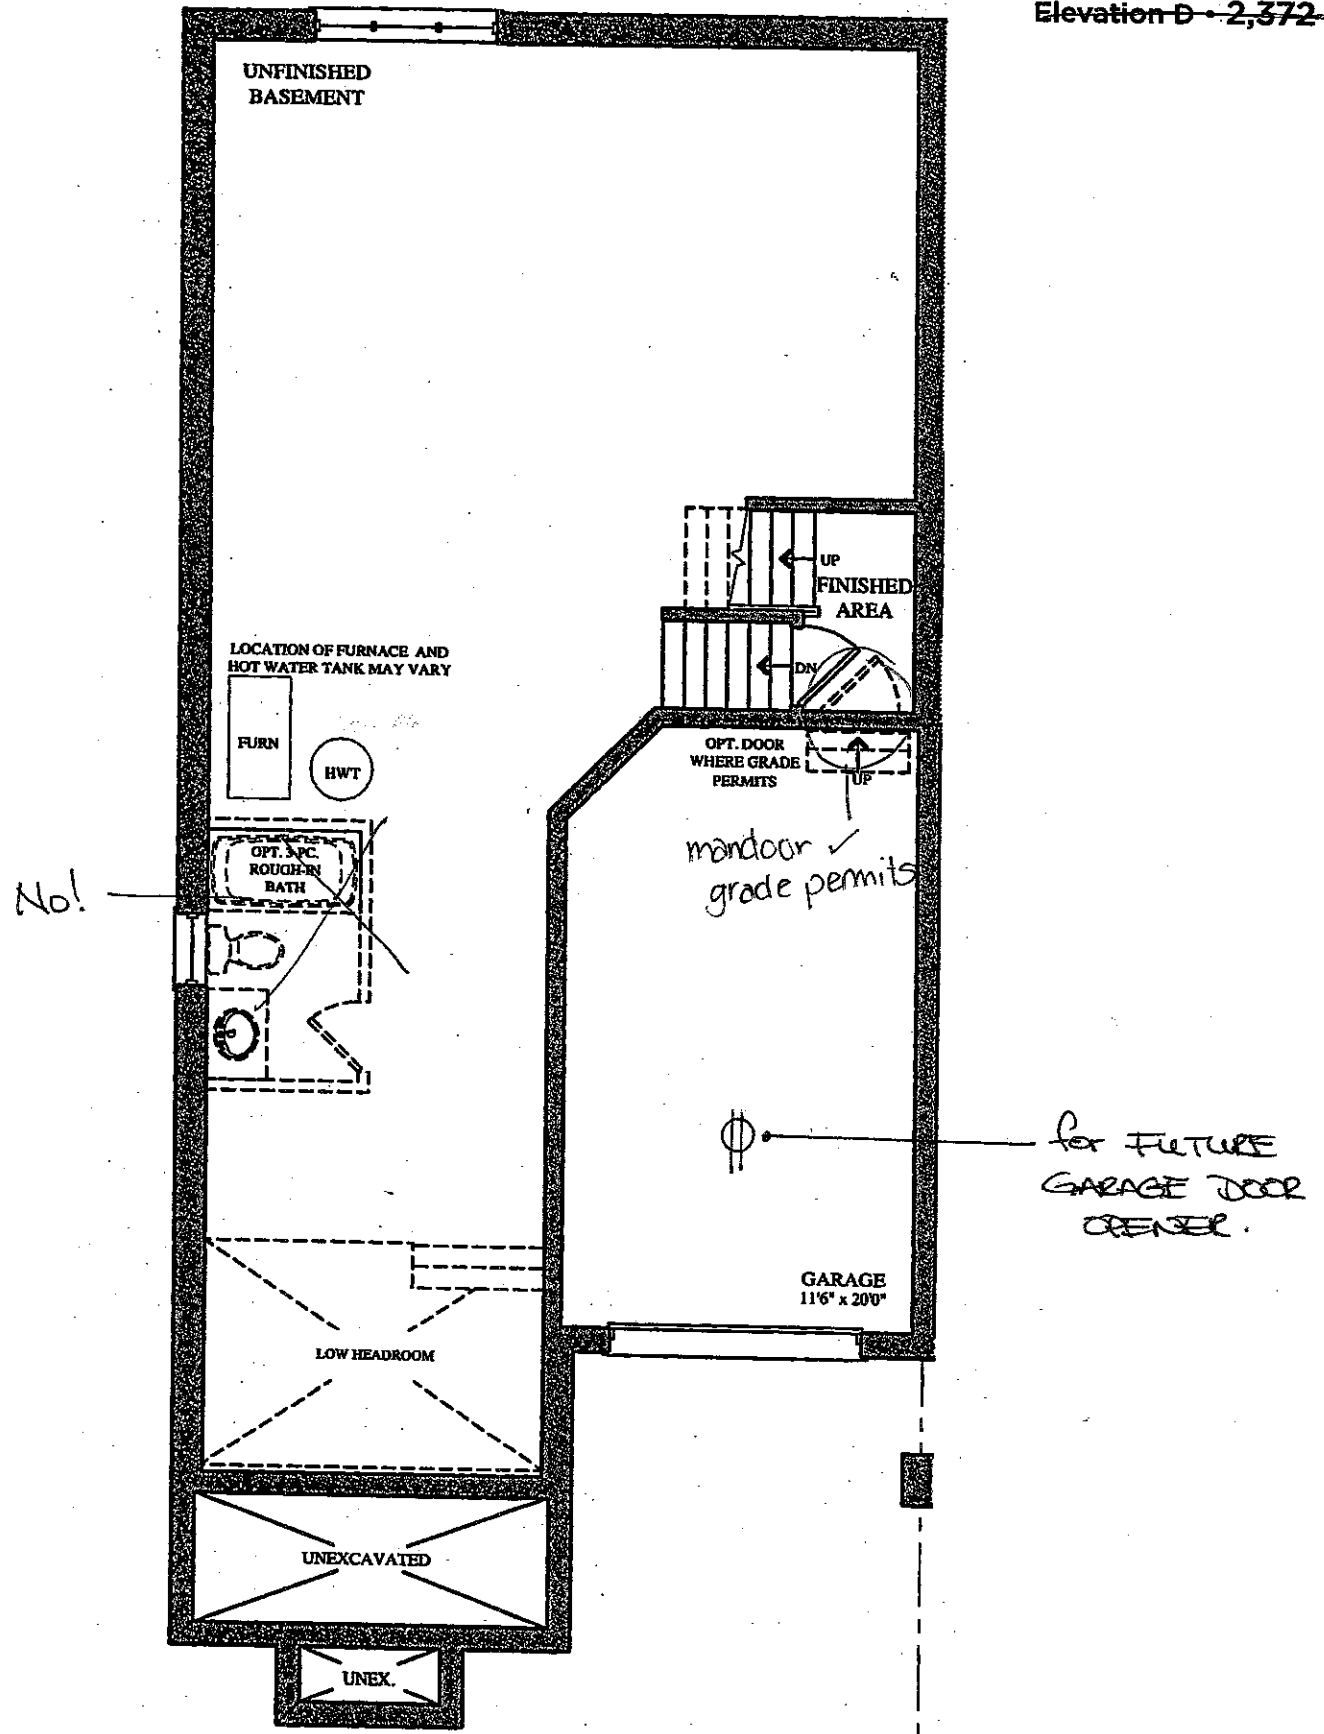

BASEMENT FLOOR PLAN
ELEV. 'A' (B) 'C' & 'D'