

Brampton Encore - 26L - 2 - 28-2 Elev.A SIREN

Exterior Colours

Inv.1,434	1 - EXTERIOR COLOUR PACKAGE 6
Line24355	Note:
13Jun17 / 30Oct17	

FRAMING

Inv.1,434	1 - FRAME FOR MANDOOR- GARAGE TO HOUSE- GRADE PERMITS
Line24357	Note:
13Jun17 / 30Oct17	

INTERIOR TRIM AND DOORS

Inv.1,434	1 - MAIN FLOOR: EXTENDED HEIGHT ARCHWAY (PRICE PER DOORWAY) -96"
Line22490	Note:
13Jun17 / 30Oct17	

MISC.

Inv.1,434	1 - REFUND- SIDE DOOR- HOME TO EXTERIOR- AS PER PLAN-GRADE DOESN'T PERMIT
Line22488	Note:
13Jun17 / 30Oct17	
Inv.1,434	1 - Purchaser has attended an appointment at the Decor Centre & has DECLINED any additional upgrades and accepts and acknowledges that there will be no further changes/additions/deletions to be made upon signing on June 13 2017.
Line22491	Note:
13Jun17 / 30Oct17	
Inv.1,434	1 - Purchasers are aware & accepts that ANY changes made to upgrades after signing this Purchasers Extra Form are subject to a minimum administration fee of \$500. PLUS a 10% holdback fee.
Line22492	Note:
13Jun17 / 30Oct17	
Inv.1,434	1 - BONUS PACKAGE: \$5,000.00 (INCLUDING TAXES) WORTH OF UPGRADES FROM GOLD PARK HOMES DÉCOR CENTRE IS BEING APPLIED TOWARD THE STRUCTURAL APPOINTMENT. PURCHASER HAS A REMAINING AMOUNT OF \$00 (INCLUDING TAXES) TO BE USED TOWARD THE COLOUR APPOINTMENT.
Line22493	Note:
13Jun17 / 30Oct17	

PLUMBING

Inv.1,434	1 - BASEMENT: ROUGH-IN - 3PC BASEMENT ROUGH-IN
Line22489	Note:
13Jun17 / 30Oct17	

WINDOWS AND DOORS

Inv.1,434	1 - SUPPLY MANDOOR- GARAGE TO HOUSE- GRADE PERMITS
Line24356	Note:
13Jun17 / 30Oct17	

BEZ-26L


JUNE 13 2017

(AK) (K)

The Siren

SEMI SERIES

→ Elevation A • 1,688 sq.ft.
Elevation B • 1,677 sq.ft.
Elevation C • 1,687 sq.ft.

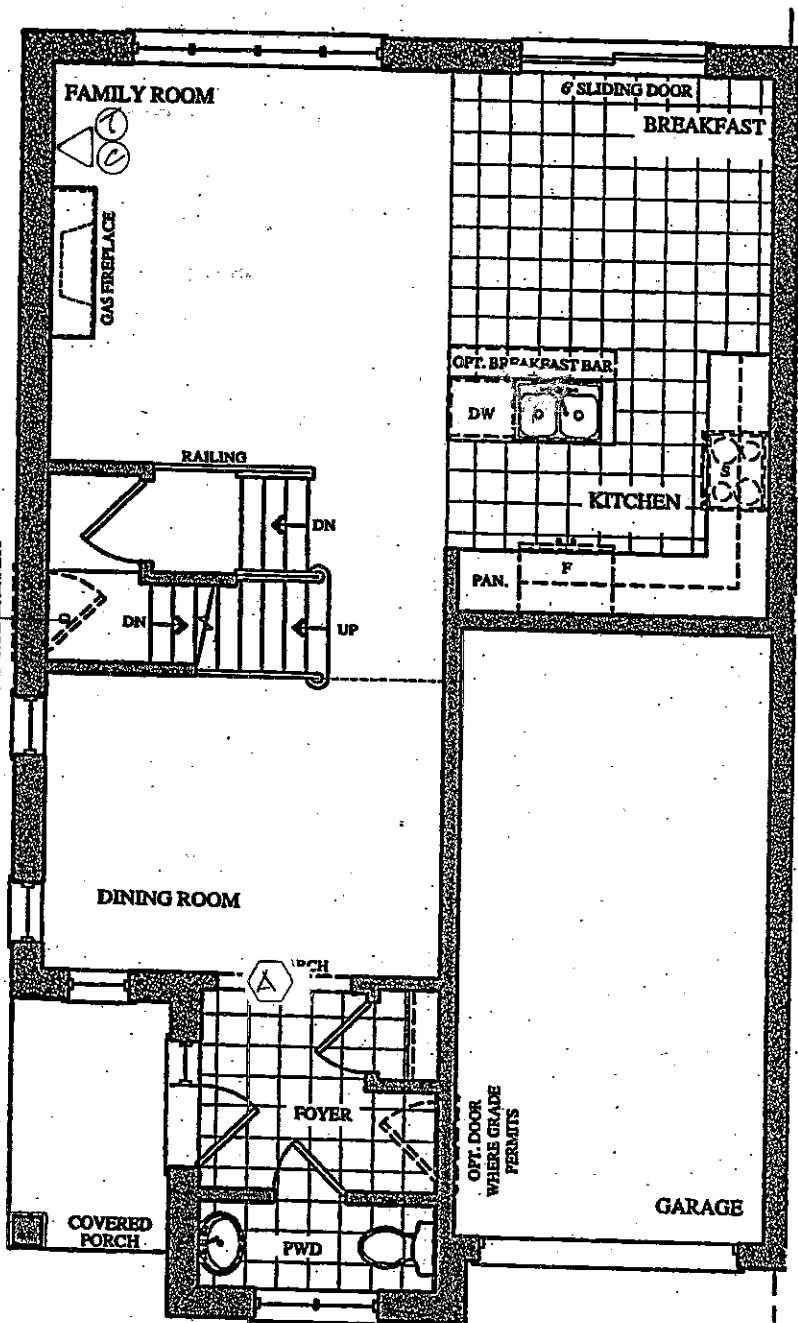


GROUND FLOOR PLAN
ELEV. (A) & 'B'

LEGEND.

△ (T) PHONE

△ (E) CABLE

△ (A) 96" ARCH.

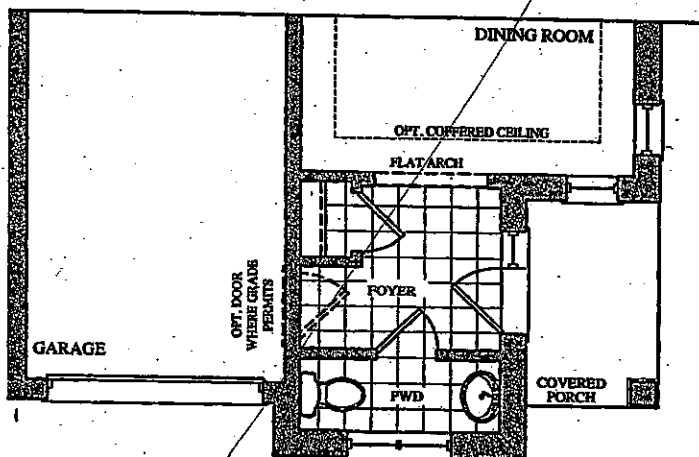


PART. GROUND FLOOR PLAN
ELEV. 'C'


BE2-26L
JUNE 13 2017 (AK) (2)

The Siren SEMI SERIES


Elevation A • 1,688 sq.ft.
Elevation B • 1,677 sq.ft.
Elevation C • 1,687 sq.ft.

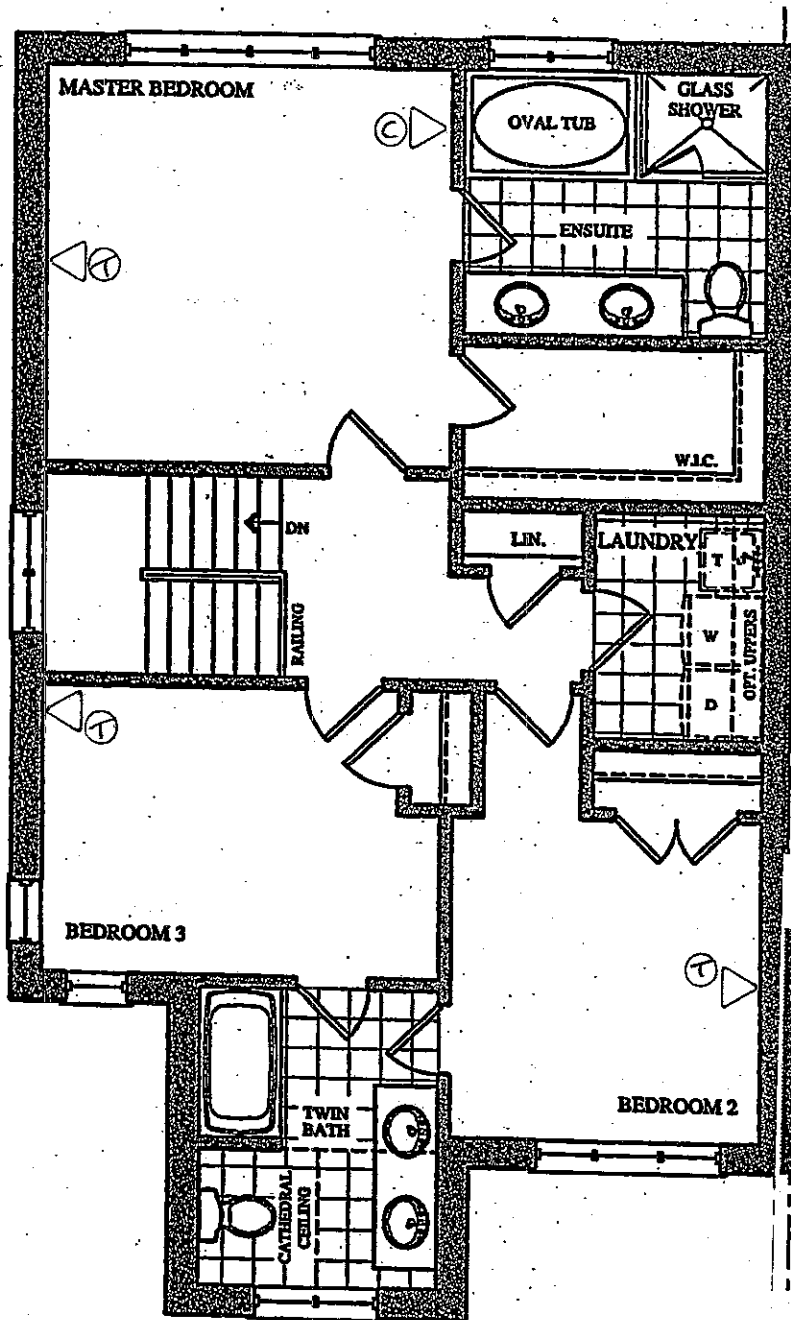

SECOND FLOOR PLAN
ELEV. 'A'

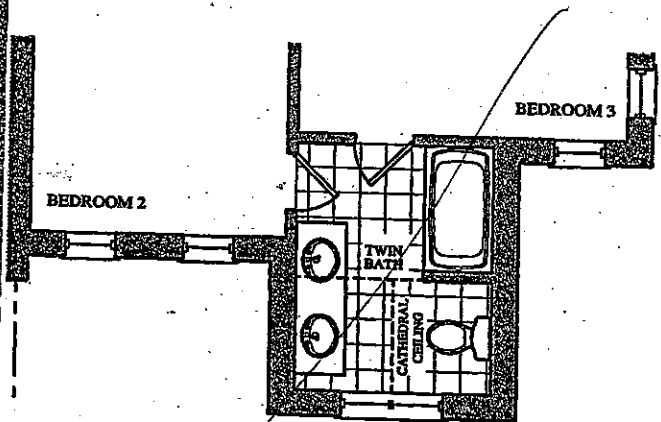

PART. SECOND FLOOR PLAN
ELEV. 'B'

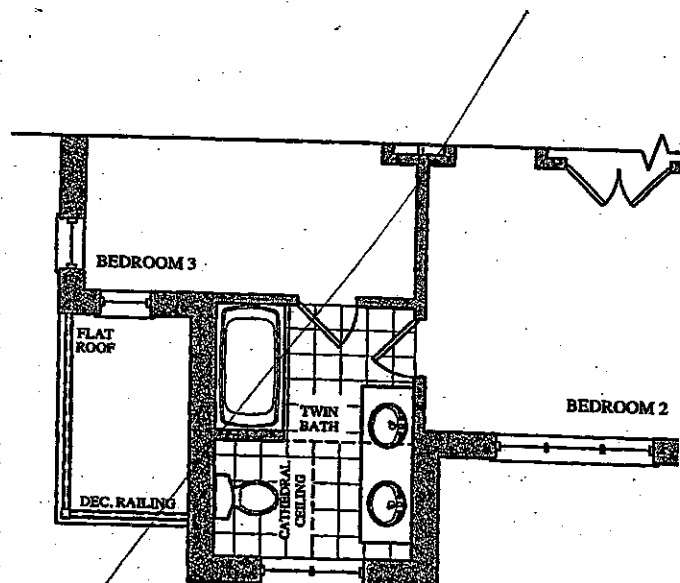

PART. SECOND FLOOR PLAN
ELEV. 'C'

BEZ-26L

JUNE 13 2017

AK




The Siren

SEMI SERIES

→ Elevation A • 1,688 sq.ft.

Elevation B • 1,677 sq.ft.

Elevation C • 1,687 sq.ft.

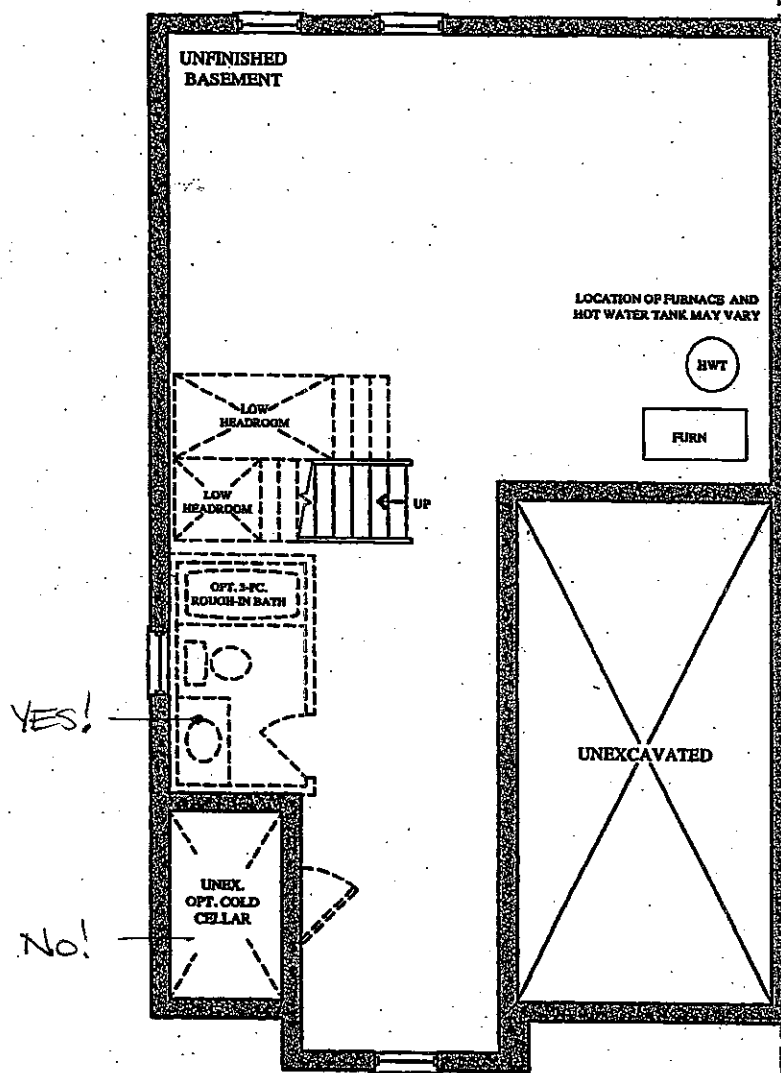

BASEMENT FLOOR PLAN
ELEV. 'A', 'B' & 'C'