

Brampton Encore - 24L - 2 - 28-7 Elev.C Wagner

CENTRAL VAC AND WIRING

Inv.1,493	1 - TELEPHONE AND CABLE LOCATION SKETCH
Line23145	Note:
10Jul17 / 3Oct17	
Inv.1,493	1 - CENTRAL VACUUM- COMPLETE UNIT:
	NILFISK CENTRAL VACUUM SE 150
Line23298	Note:
10Jul17 / 3Oct17	

ELECTRICAL

Inv.1,493	1 - FORMAL ROOM: INSTALL ROUGH - IN CEILING OUTLET & SWITCH (WITH COVER PLATE) - DOES NOT INCLUDE FIXTURE - MUST SPECIFY LOCATION
Line23146	Note:
10Jul17 / 3Oct17	

Exterior Colours

Inv.1,493	1 - EXTERIOR COLOUR PACKAGE #7
Line24351	Note:
10Jul17 / 3Oct17	

GARAGE DOORS

Inv.1,493	1 - GARAGE: INSTALL GARAGE DOOR OPENER -BELT DRIVE- WITH 1 REMOTE- PRICE IS PER DOOR
Line23295	Note:
10Jul17 / 3Oct17	
Inv.1,493	1 - GARAGE: INSTALL DIGITAL ENTRY KEYPAD
Line23297	Note:
10Jul17 / 3Oct17	

HVAC

Inv.1,493	1 - AIR CONDITIONER- 2.5 TONS
Line23299	Note:
10Jul17 / 3Oct17	

MISC.

Inv.1,493	1 - BONUS PACKAGE: \$5000.00 (INCLUDING TAXES) WORTH OF UPGRADES FROM GOLD PARK HOMES DÉCOR CENTRE IS BEING APPLIED TOWARD THE STRUCTURAL APPOINTMENT. PURCHASER HAS A REMAINING AMOUNT OF \$0.00 (INCLUDING TAXES) TO BE USED TOWARD THE COLOUR APPOINTMENT
Line23149	Note:
10Jul17 / 3Oct17	
Inv.1,493	1 - Purchaser has attended a Structural appointment at the Decor Centre & has DECLINED any additional upgrades and accepts and acknowledges that there will be no further structural changes/additions/deletions to be made upon signing on July 10, 2017
Line23150	Note:
10Jul17 / 3Oct17	
Inv.1,493	1 - Purchasers are aware & accepts that ANY changes made to upgrades after signing this Purchasers Extra Form are subject to a minimum administration fee of \$500. PLUS a 10% holdback fee.
Line23151	Note:
10Jul17 / 3Oct17	

PLUMBING

Brampton Encore - 24L - 2 - 28-7 Elev.C Wagner

Inv.1,493	1 - KITCHEN: INSTALL ROUGH-IN - WATERLINE FOR FRIDGE
Line23148	Note:
10Jul17 / 3Oct17	


WINDOWS - BASEMENT

Inv.1,493	4 - BASEMENT: INSTALL FOUR (X4) BASEMENT WINDOWS - UPGRADE EXISTING BASEMENT WINDOW TO 30 INCH X 24 INCH - MAY REQUIRE INSTALLATION OF WINDOW WELL
Line23147	Note: PURCHASER IS AWARE THAT THEY WILL GET WINDOW WELLS ON THE SIDE WINDOWS
10Jul17 / 3Oct17	


Telephone — (T)
 Cable — (C)
 Electrical — (E)

The Wagner SEMI SERIES

Elevation A • 2,127 sq.ft.
 Elevation B • 2,117 sq.ft.
 Elevation C • 2,127 sq.ft.
 Elevation D • 2,127 sq.ft.

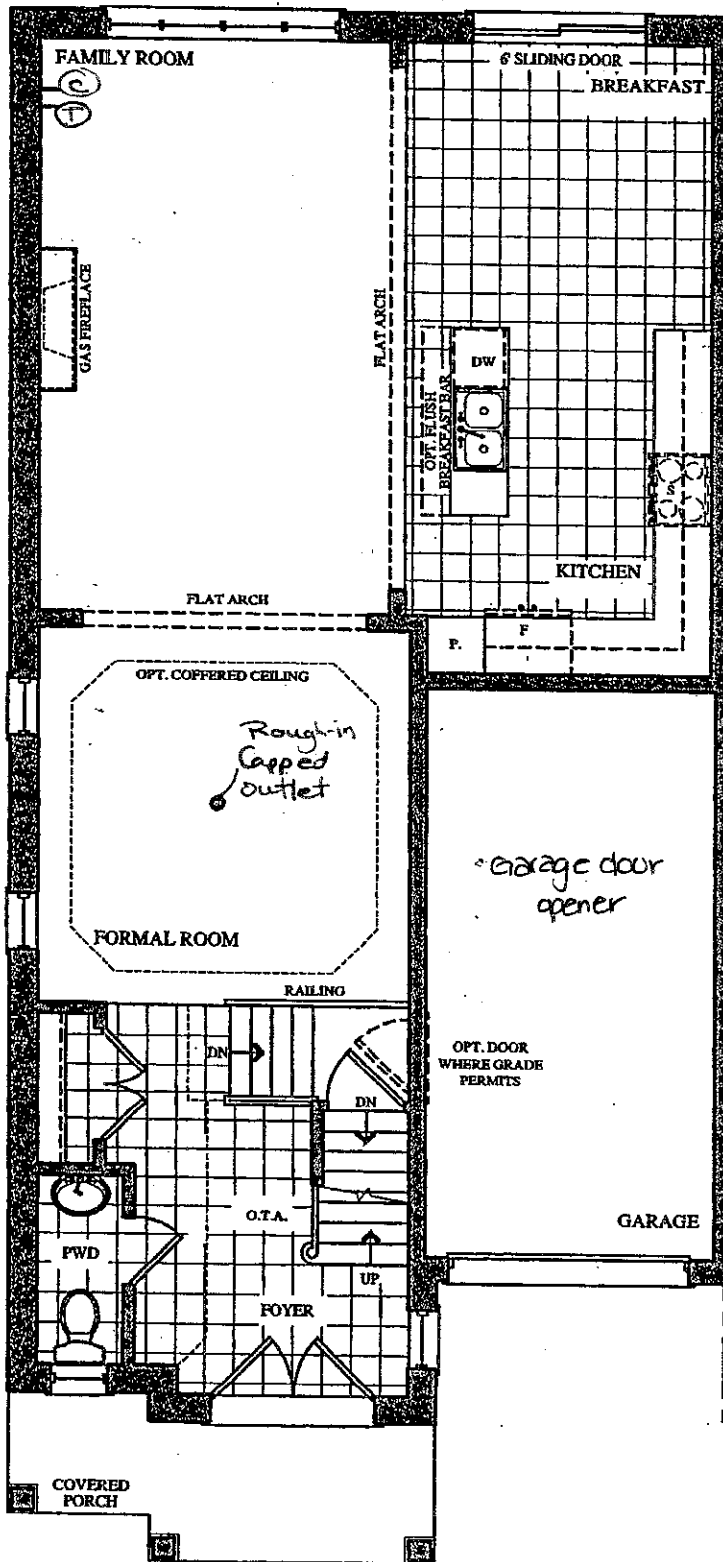

GROUND FLOOR PLAN
 ELEV. 'A' & 'B'

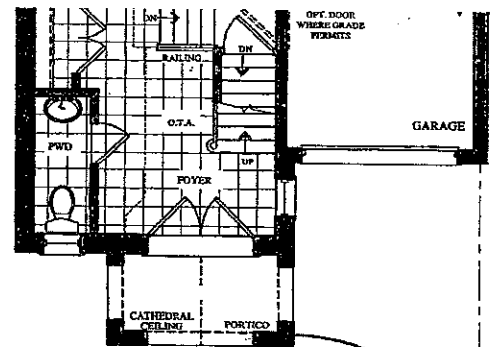

PART. GROUND FLOOR PLAN
 ELEV. 'C' & 'D'


Lot 24L
 July 10, 17

(KD) (MD)


Telephone — (T)
 Cable — (C)

The Wagner SEMI SERIES


Elevation A • 2,127 sq.ft.
 Elevation B • 2,117 sq.ft.
 Elevation C • 2,127 sq.ft.
 Elevation D • 2,127 sq.ft.

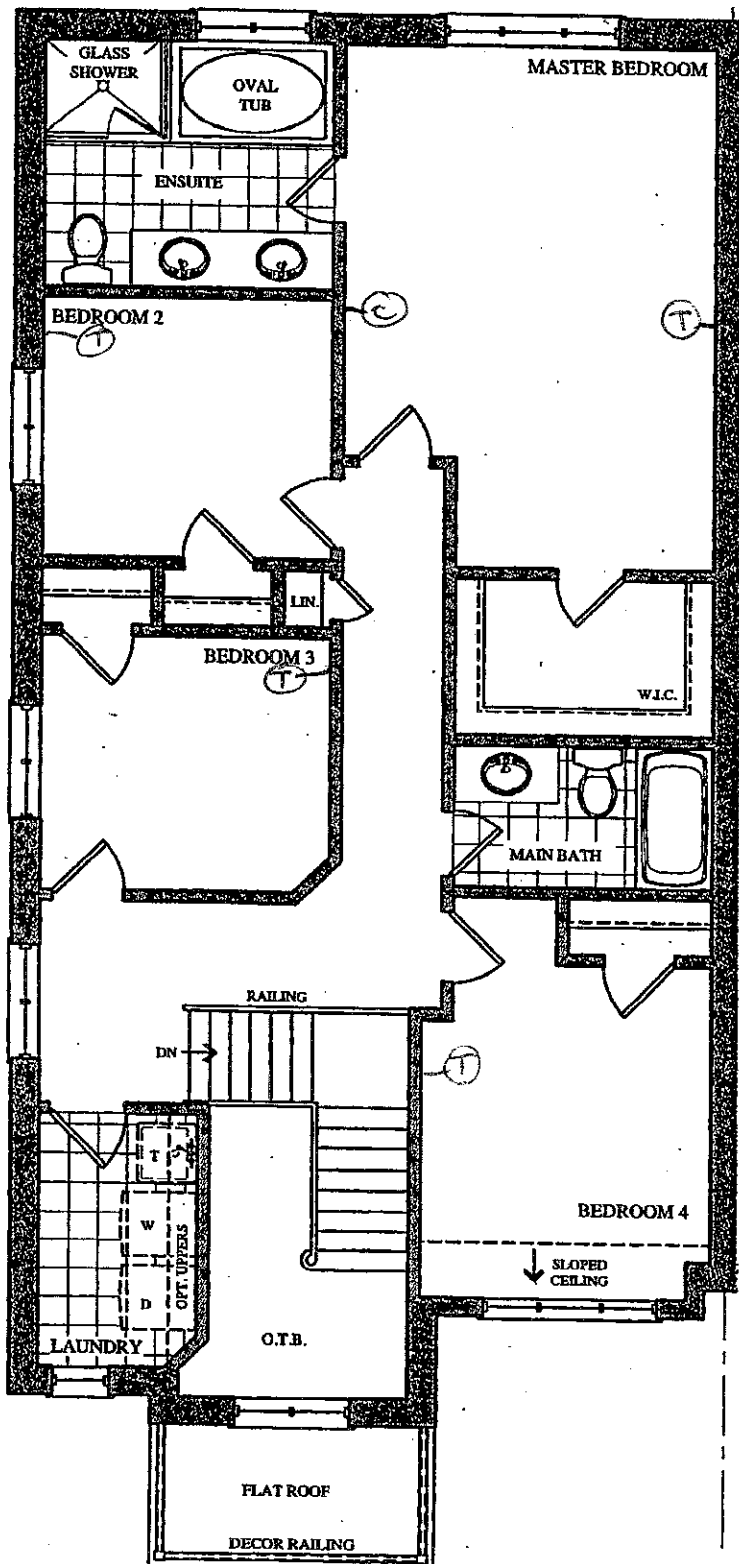


SECOND FLOOR PLAN
ELEV. 'A'

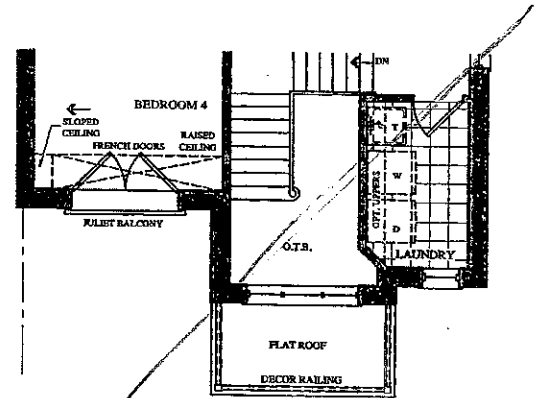

PART. SECOND FLOOR PLAN
ELEV. 'B'

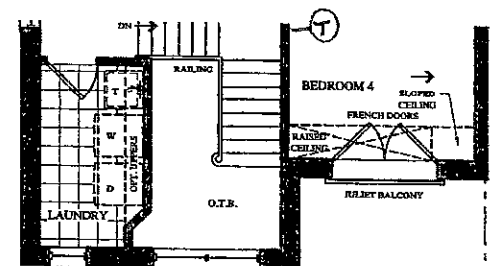

PART. SECOND FLOOR PLAN
ELEV. 'C'

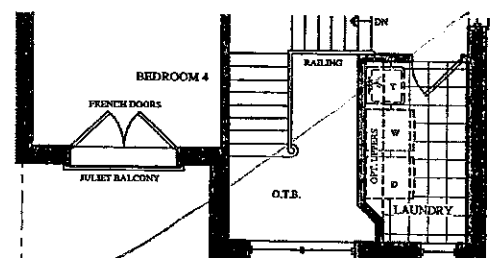

PART. SECOND FLOOR PLAN
ELEV. 'D'


Lot 24 L
 July 10, 17

(KD) (MD)

The Wagner SEMI SERIES

Elevation A • 2,127 sq.ft.
 Elevation B • 2,117 sq.ft.
 Elevation C • 2,127 sq.ft.
 Elevation D • 2,127 sq.ft.


BSMNT WINDOWS
 4 x 30" x 24"

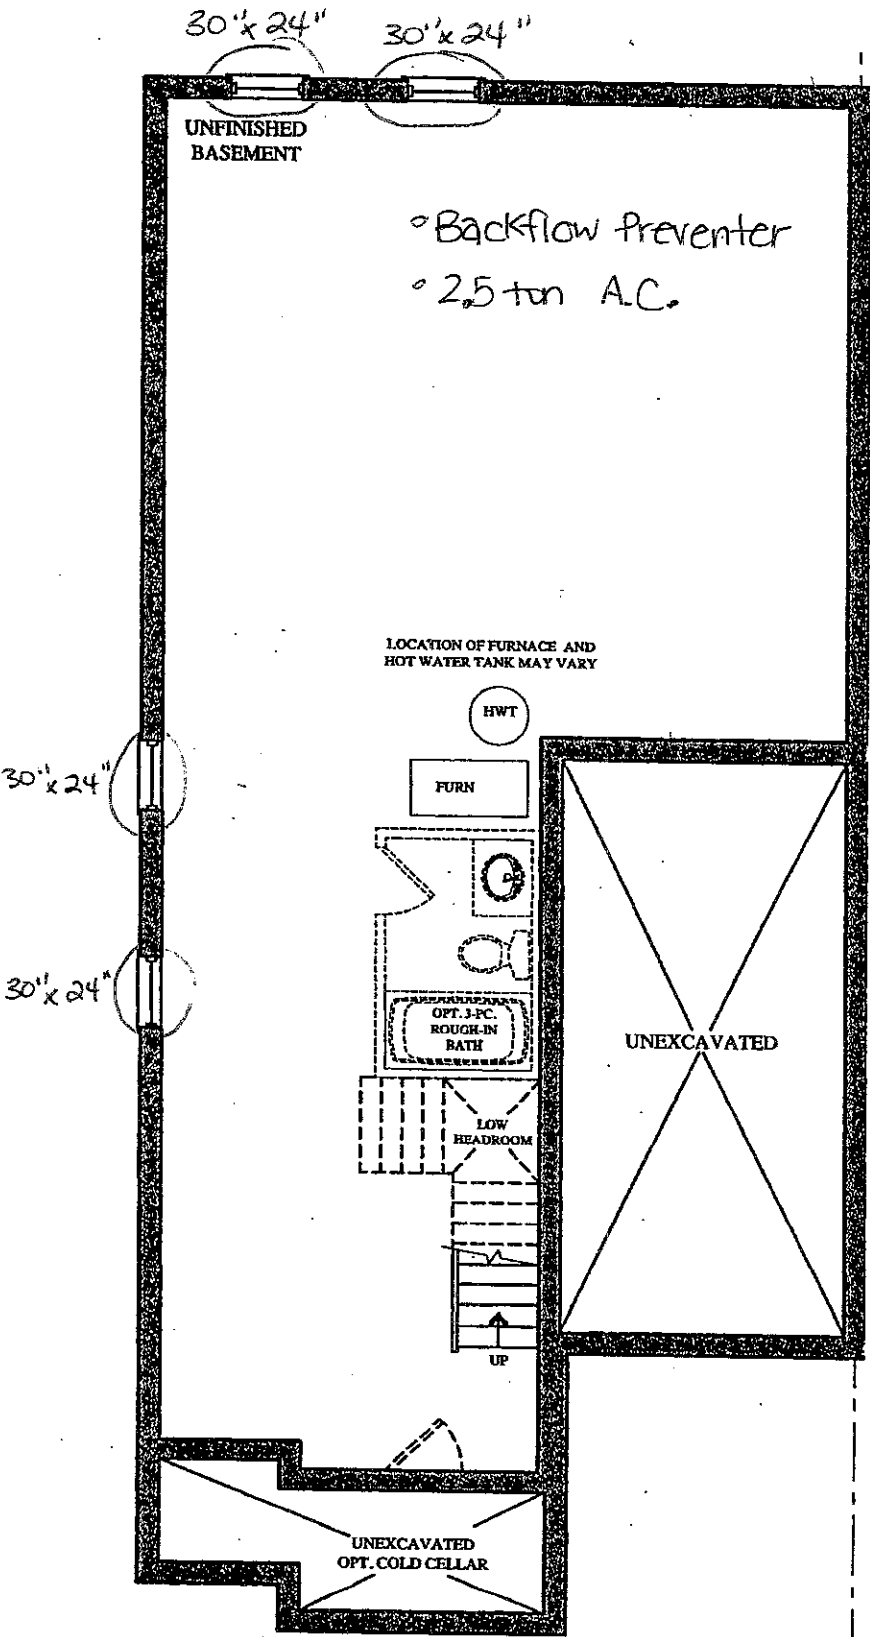

BASEMENT FLOOR PLAN
 ELEV. 'A' & 'B'

Lot 24L
 July 10, 17

LD MD

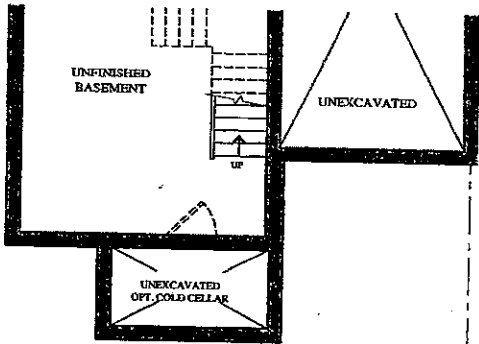

PART. BASEMENT FLOOR PLAN
 ELEV. 'C' & 'D'