

Brampton Encore - 20R - 2 - 28-4 Elev.B ROSSINI

CENTRAL VAC AND WIRING

Inv.1,468	1 - FAMILY ROOM; CONDUIT PIPE- FOR TELEVISION- LOCATE APPROX. 66" A.F.F. ABOVE FIREPLACE, TERMINATING BY CABLE OUTLET SEE PLAN FOR LOCATION
Line22889	Note:
29Jun17 / 3Oct17	
Inv.1,468	1 - MASTER BEDROOM: ROUGH-IN FOR EXTRA SECURITY KEY PAD
Line22888	Note: SEE PLAN FOR LOCATION
29Jun17 / 3Oct17	
Inv.1,468	1 - FAMILY ROOM / MASTER BEDROOM / BEDROOM 2 / BEDROOM 3 CAT 6 WIRING - UPGRADE AN OUTLET TO CAT 6- SEE PLAN FOR LOCATION
Line22890	Note: PACKAGE OF 4 FOR PRICE OF 3
29Jun17 / 3Oct17	

CONCRETE AND DRAIN

Inv.1,468	1 - ROUGH-IN - 3PC BASEMENT ROUGH-IN
Line22896	Note:
29Jun17 / 3Oct17	
Inv.1,468	1 - BACK-FLOW PREVENTER VALVE
Line22902	Note:
29Jun17 / 3Oct17	

ELECTRICAL

Inv.1,468	1 - FAMILY ROOM: 110V WALL RECEPTACLE ON NORMAL CIRCUIT- 66" A.F.F. ABOVE FIREPLACE
Line22891	Note:
29Jun17 / 3Oct17	
Inv.1,468	1 - KITCHEN: RELOCATE STANDARD CEILING LIGHT TO ABOVE ISLAND, SEE PLAN FOR LOCATION
Line22892	Note:
29Jun17 / 3Oct17	
Inv.1,468	1 - KITCHEN: ROUGH - IN CEILING OUTLET ON SAME SWITCH - DOES NOT INCLUDE FIXTURE - LOCATE ABOVE ISLAND, USE SAME SWITCH AS STANDARD LIGHT
Line22893	Note:
29Jun17 / 3Oct17	
Inv.1,468	1 - 200 AMP ELECTRICAL SERVICE
Line22895	Note:
29Jun17 / 3Oct17	
Inv.1,471	2 - KITCHEN: ROTATE ISLAND 90*. SEE PLAN FOR LOCATION
Line22929	Note:
4Jul17 / 3Oct17	

Exterior Colours

Inv.1,468	1 - EXTERIOR COLOUR PACKAGE 6
Line24339	Note:
29Jun17 / 3Oct17	

FRAMING

Inv.1,468	1 - MAIN FLOOR: EXTENDED HEIGHT ARCHWAY (PRICE PER DOORWAY) -96"
Line24338	Note:
29Jun17 / 3Oct17	

Brampton Encore - 20R - 2 - 28-4 Elev.B ROSSINI

Inv.1,468	1 - KITCHEN: UPGRADE VENTING FOR STOVE TO 8" PIPE EXTERIOR WALL
Line24337	Note:
29Jun17 / 30Oct17	

HVAC

Inv.1,468	1 - KITCHEN: UPGRADE VENTING FOR STOVE TO 8" PIPE EXTERIOR WALL
Line22894	Note:
29Jun17 / 30Oct17	

INTERIOR TRIM AND DOORS

Inv.1,468	2 - MAIN FLOOR: EXTENDED HEIGHT ARCHWAY (PRICE PER DOORWAY) -96"
Line22900	Note:
29Jun17 / 30Oct17	

MISC.

Inv.1,468	1 - DO NOT INSTALL SIDE DOOR- HOME TO EXTERIOR- AS PER PLAN AND GRADE DOESN'T PERMIT
Line22897	Note:
29Jun17 / 30Oct17	

Inv.1,468	1 - Purchaser has attended an appointment at the Decor Centre & has DECLINED any additional upgrades and accepts and acknowledges that there will be no further changes/additions/deletions to be made upon signing on June 29 2017.
Line22903	Note:
29Jun17 / 30Oct17	

Inv.1,468	1 - Purchasers are aware & accepts that ANY changes made to upgrades after signing this Purchasers Extra Form are subject to a minimum administration fee of \$500. PLUS a 10% holdback fee.
Line22904	Note:
29Jun17 / 30Oct17	

Inv.1,468	1 - BONUS PACKAGE: \$5,000.00 (INCLUDING TAXES) WORTH OF UPGRADES FROM GOLD PARK HOMES DÉCOR CENTRE IS BEING APPLIED TOWARD THE STRUCTURAL APPOINTMENT. PURCHASER HAS A REMAINING AMOUNT OF \$00 (INCLUDING TAXES) TO BE USED TOWARD THE COLOUR APPOINTMENT.
Line22905	Note:
29Jun17 / 30Oct17	

PLUMBING

Inv.1,468	1 - KITCHEN: ROUGH-IN - WATERLINE FOR FRIDGE
Line22901	Note:
29Jun17 / 30Oct17	

WINDOWS - BASEMENT


Inv.1,468	2 - BASEMENT WINDOWS - UPGRADE EXISTING BASEMENT WINDOW TO 30 INCH X 24 INCH - MAY REQUIRE INSTALLATION OF WINDOW WELL
Line22898	Note:
29Jun17 / 30Oct17	
Inv.1,468	2 - BASEMENT WINDOWS - UPGRADE EXISTING BASEMENT WINDOW TO 30 INCH X 16 INCH
Line22899	Note:
29Jun17 / 30Oct17	


BE2-20R
JUNE 29 2017

BE2-2R
JULY 4 2017

The Rossini SEMI SERIES

Elevation A • 1,911 sq.ft.
Elevation B • 1,902 sq.ft.
Elevation C • 1,966 sq.ft.
Elevation D • 1,971 sq.ft.







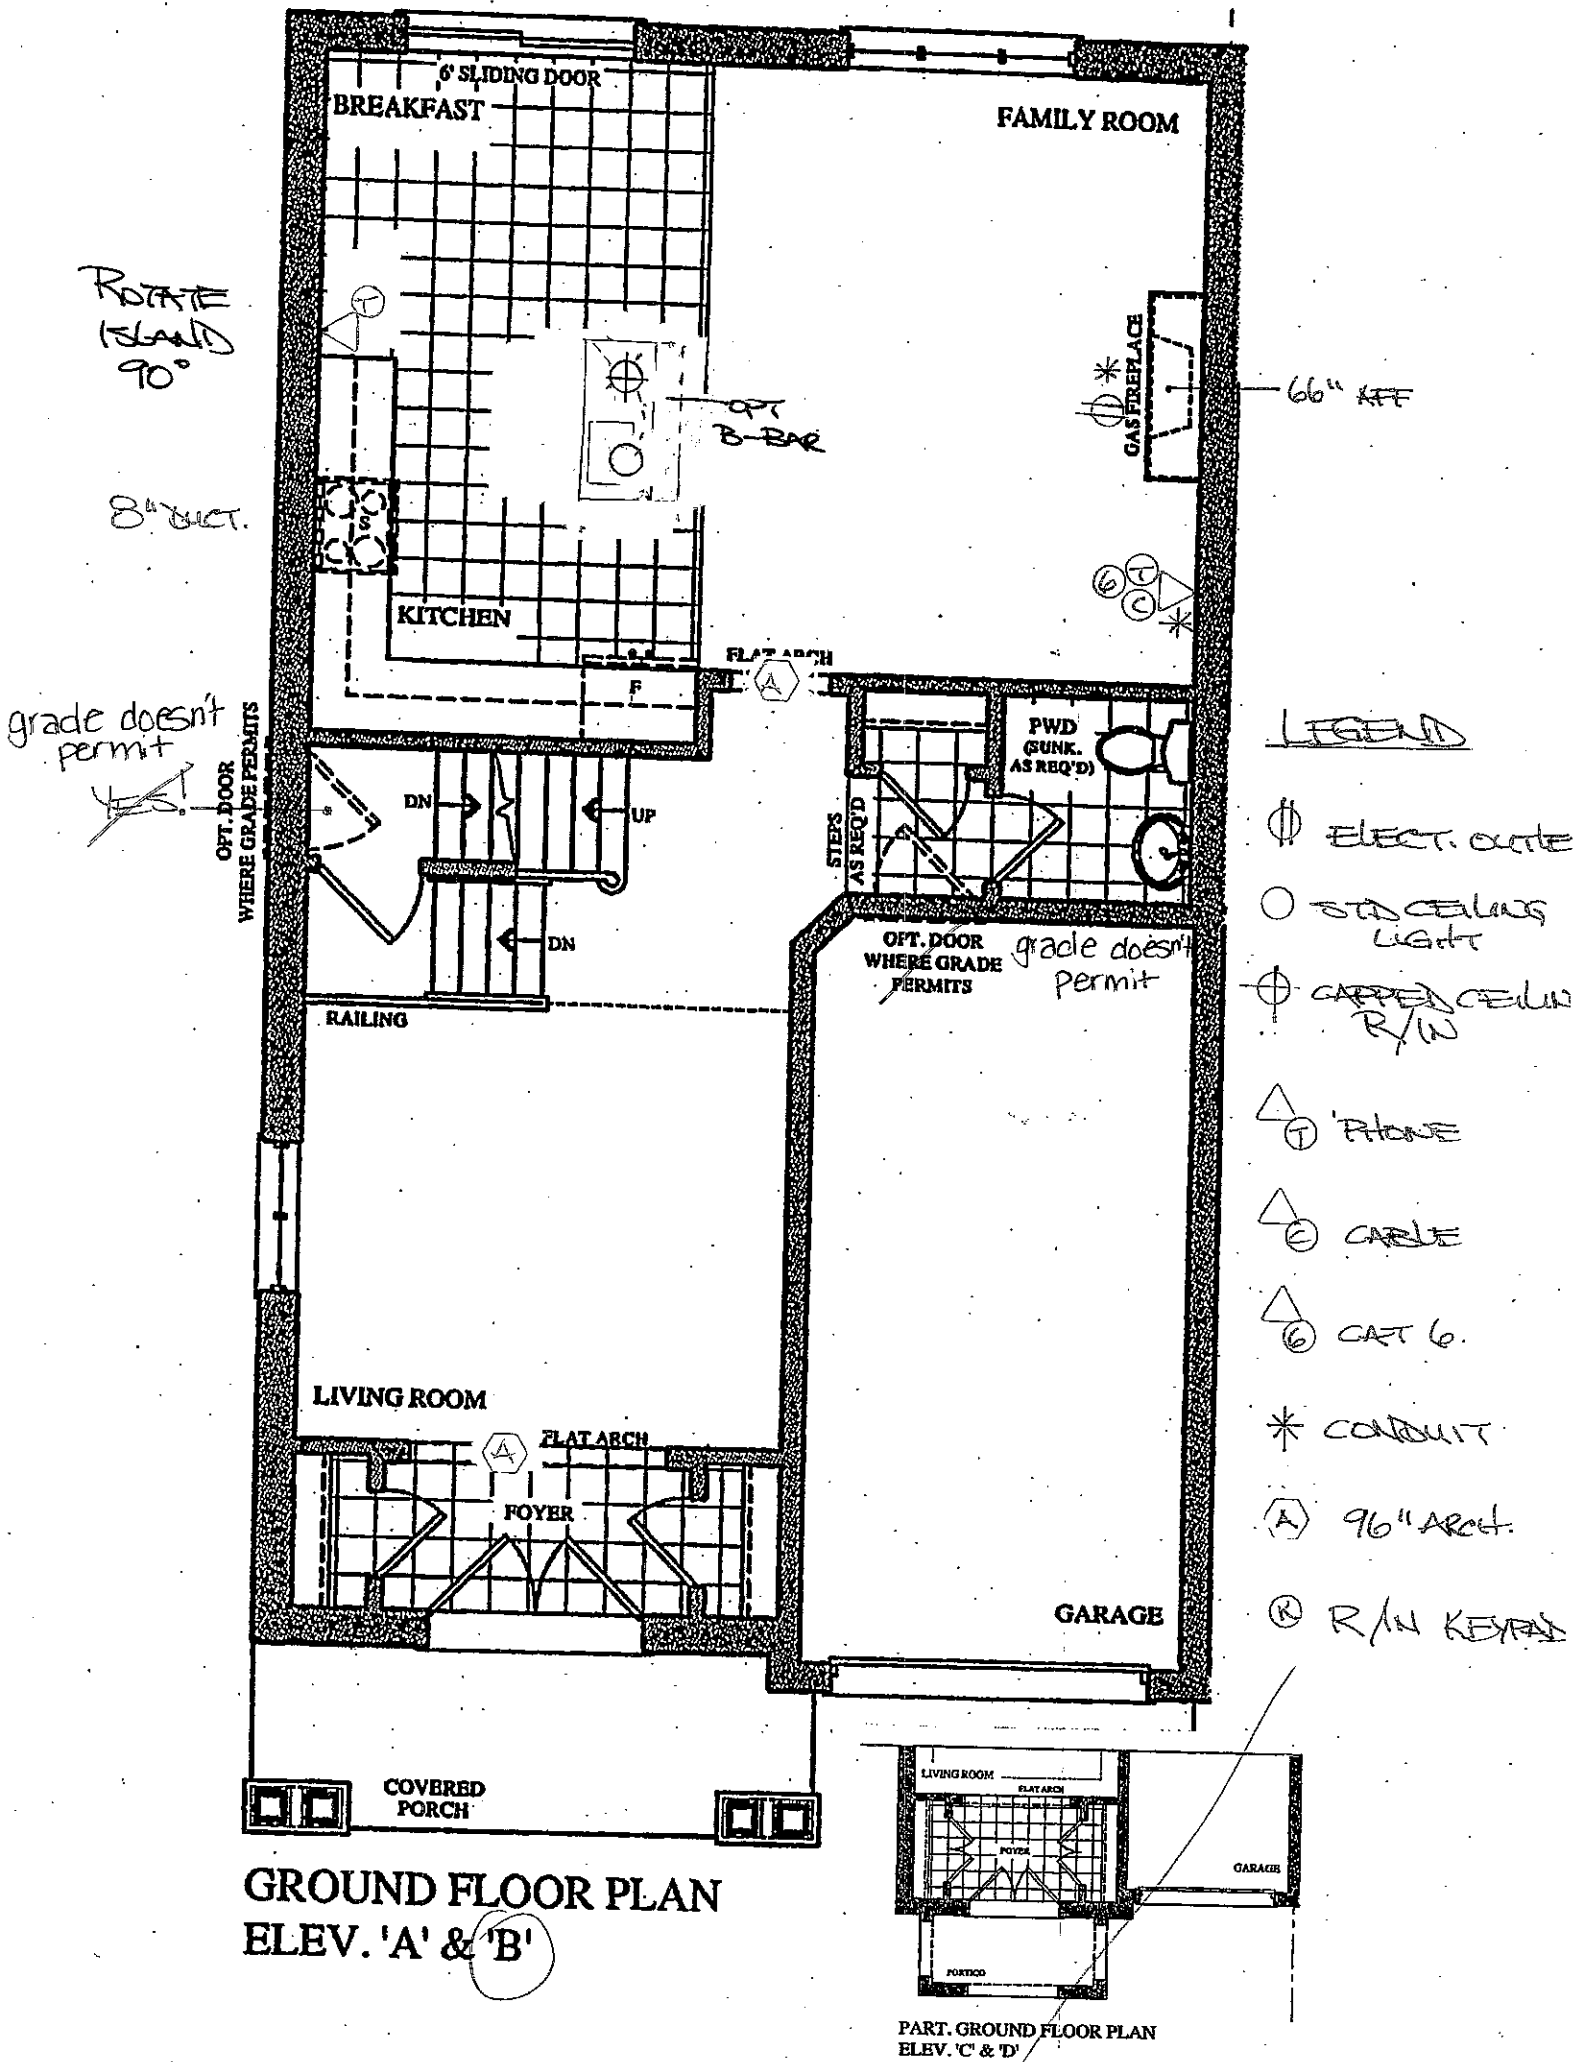


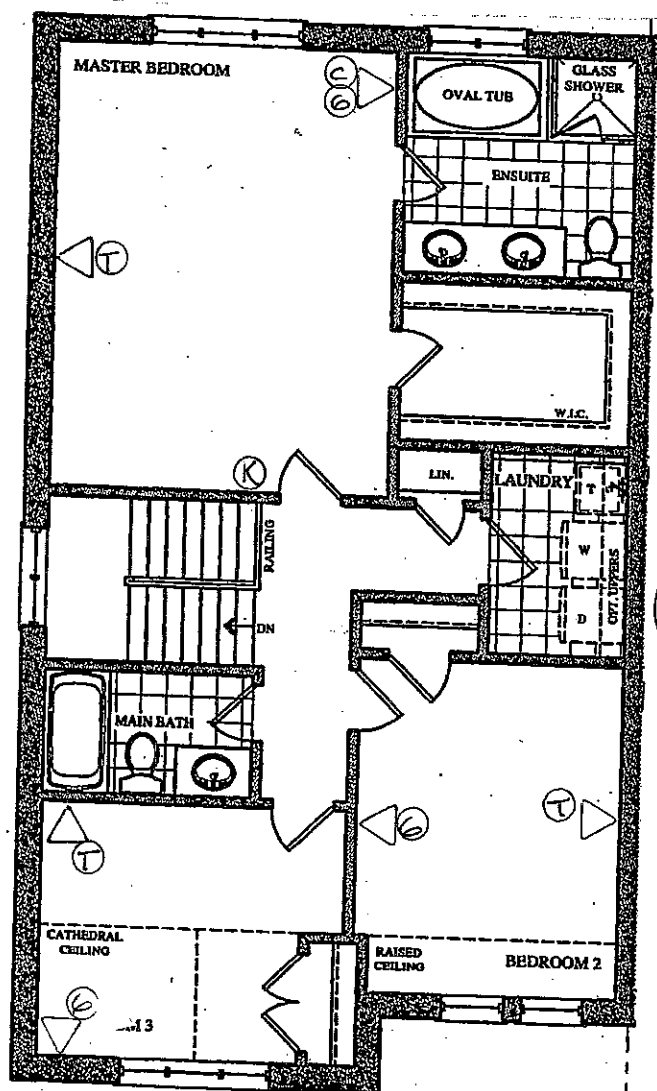

BEZ-202

AK AL


Elevation A • 1,911 sq.ft.
Elevation B • 1,902 sq.ft.
Elevation C • 1,966 sq.ft.
Elevation D • 1,971 sq.ft.

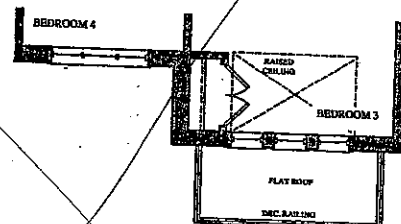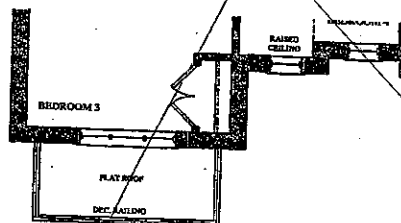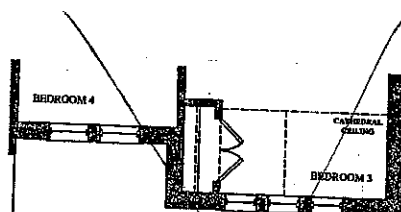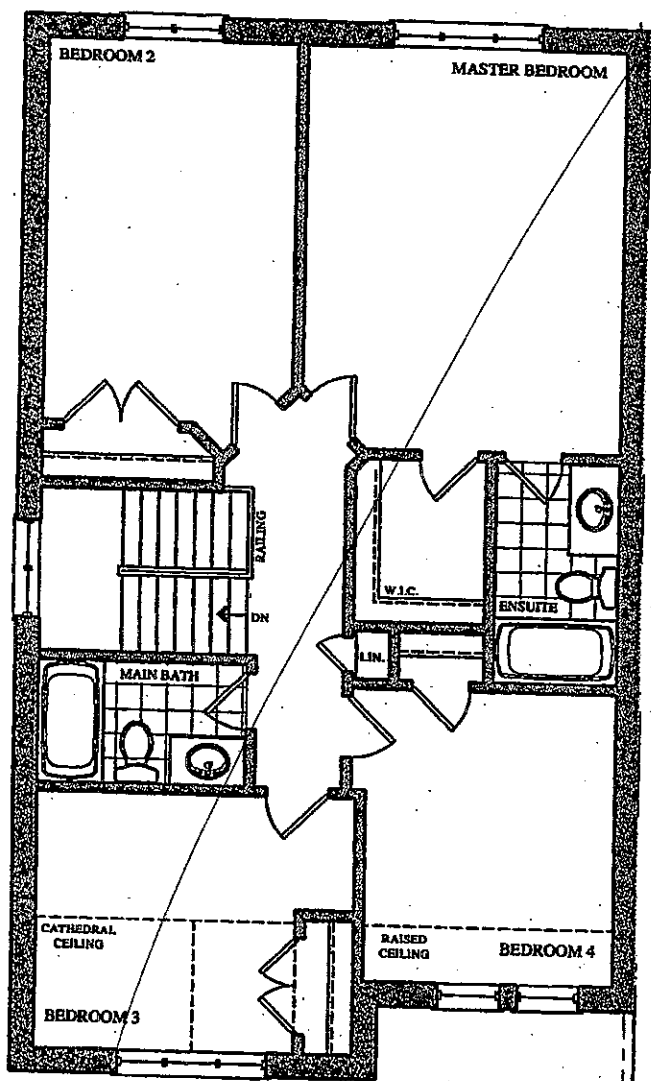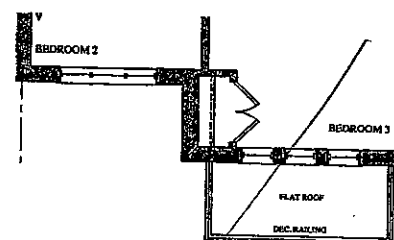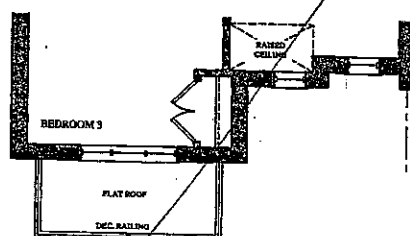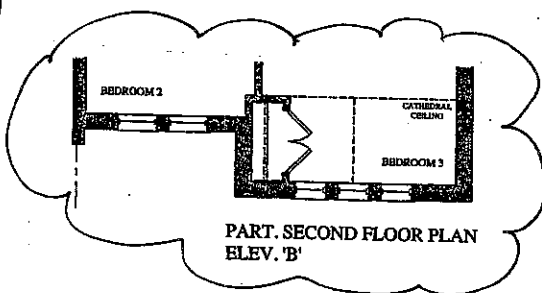


BE2-20R (A1) (A1)
JUNE 29 2017

ROSSINI SEMI SERIES

Elevation A • 1,911 sq.ft.
→ Elevation B • 1,902 sq.ft.
Elevation C • 1,966 sq.ft.
Elevation D • 1,971 sq.ft.

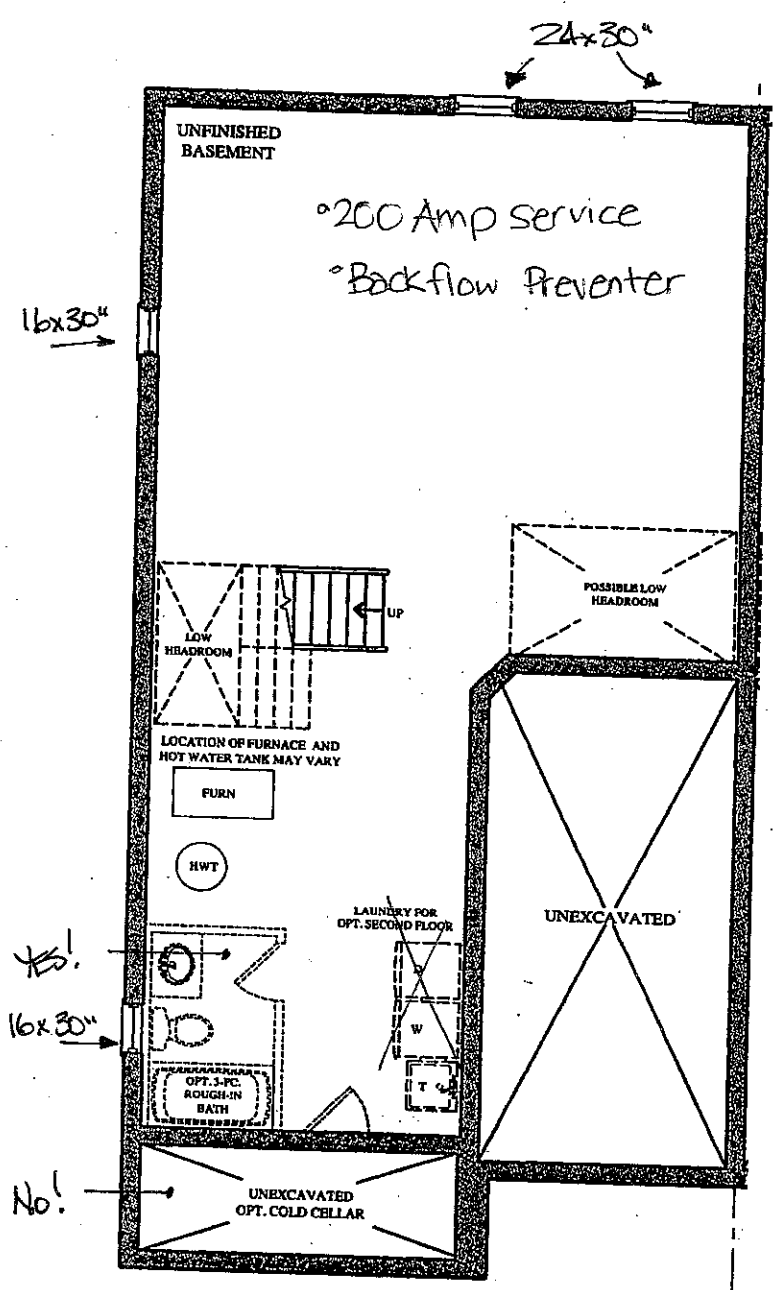

BASEMENT FLOOR PLAN
ELEV. 'A' & 'B'

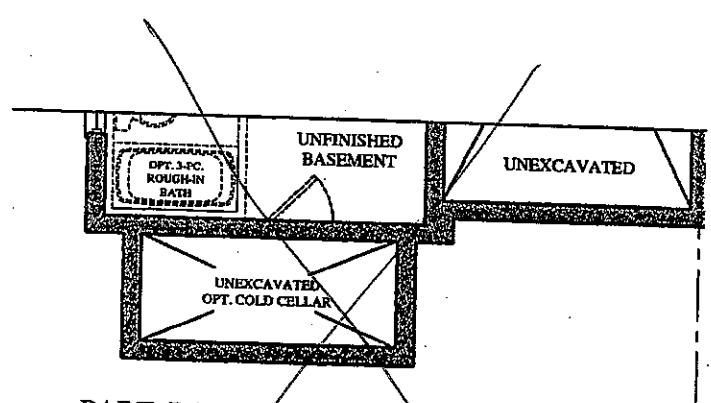

PART. BASEMENT FLOOR PLAN
ELEV. 'C' & 'D'