

Brampton Encore - 27L - 2 - 28-6 Elev.A Berlio OPT 4

CONCRETE AND DRAIN

Inv.1,472	1 - BASEMENT: ROUGH-IN - 3PC BASEMENT ROUGH-IN
Line22957	Note:
4Jul17 / 4Oct17	

ELECTRICAL

Inv.1,472	1 - KITCHEN: ROUGH - IN CEILING OUTLET ON SAME SWITCH - DOES NOT INCLUDE FIXTURE - LOCATE ABOVE ISLAND, USE SAME SWITCH AS STANDARD LIGHT. SEE PLAN FOR LOCATION.
Line22955	Note:
4Jul17 / 4Oct17	

Inv.1,472	1 - KITCHEN: RELOCATE STANDARD CEILING LIGHT TO ABOVE ISLAND. SEE PLAN FOR LOCATON
Line22954	Note:
4Jul17 / 4Oct17	

Exterior Colours

Inv.1,472	1 - EXTERIOR COLOUR PACKAGE 9
Line24368	Note:
4Jul17 / 4Oct17	

FORMING

Inv.1,472	1 - SIDE DOOR- HOME TO EXTERIOR- AS PER PLAN AND GRADE PERMITTING
Line22956	Note:
4Jul17 / 4Oct17	

MISC.

Inv.1,472	1 - Purchaser has attended an appointment at the Decor Centre & has DECLINED any additional upgrades and accepts and acknowledges that there will be no further changes/additions/deletions to be made upon signing on July 4 2017.
Line22959	Note:
4Jul17 / 4Oct17	

Inv.1,472	1 - Purchasers are aware & accepts that ANY changes made to upgrades after signing this Purchasers Extra Form are subject to a minimum administration fee of \$500. PLUS a 10% holdback fee.
Line22960	Note:
4Jul17 / 4Oct17	

Inv.1,472	1 - BONUS PACKAGE: \$5,000.00 (INCLUDING TAXES) WORTH OF UPGRADES FROM GOLD PARK HOMES DÉCOR CENTRE IS BEING APPLIED TOWARD THE STRUCTURAL APPOINTMENT. PURCHASER HAS A REMAINING AMOUNT OF \$00 (INCLUDING TAXES) TO BE USED TOWARD THE COLOUR APPOINTMENT.
Line22961	Note:
4Jul17 / 4Oct17	

WINDOWS - BASEMENT

Inv.1,472	2 - BASEMENT WINDOWS - UPGRADE EXISTING BASEMENT WINDOW TO 30 INCH X 24 INCH - MAY REQUIRE INSTALLATION OF WINDOW WELL
Line22958	Note:
4Jul17 / 4Oct17	

WINDOWS AND DOORS

Inv.1,472	1 - SIDE DOOR- HOME TO EXTERIOR- AS PER PLAN AND GRADE PERMITTING
Line24366	Note:
4Jul17 / 4Oct17	

Brampton Encore - 27L - 2 - 28-6 Elev.A Berlio OPT 4

Inv.1,472	1 - DO NOT SUPPLY MANDOOR- GRADE DOESN'T PERMIT
Line24367	Note:
4Jul17 / 4Oct17	

BE2-27L
July 4 2017


A/B

The Berlio


SEMI SERIES

- Elevation A • 2,047 sq.ft.
- Elevation B • 2,037 sq.ft.
- Elevation C • 2,037 sq.ft.
- Elevation D • 2,047 sq.ft.

No PHONE in Kitchen.

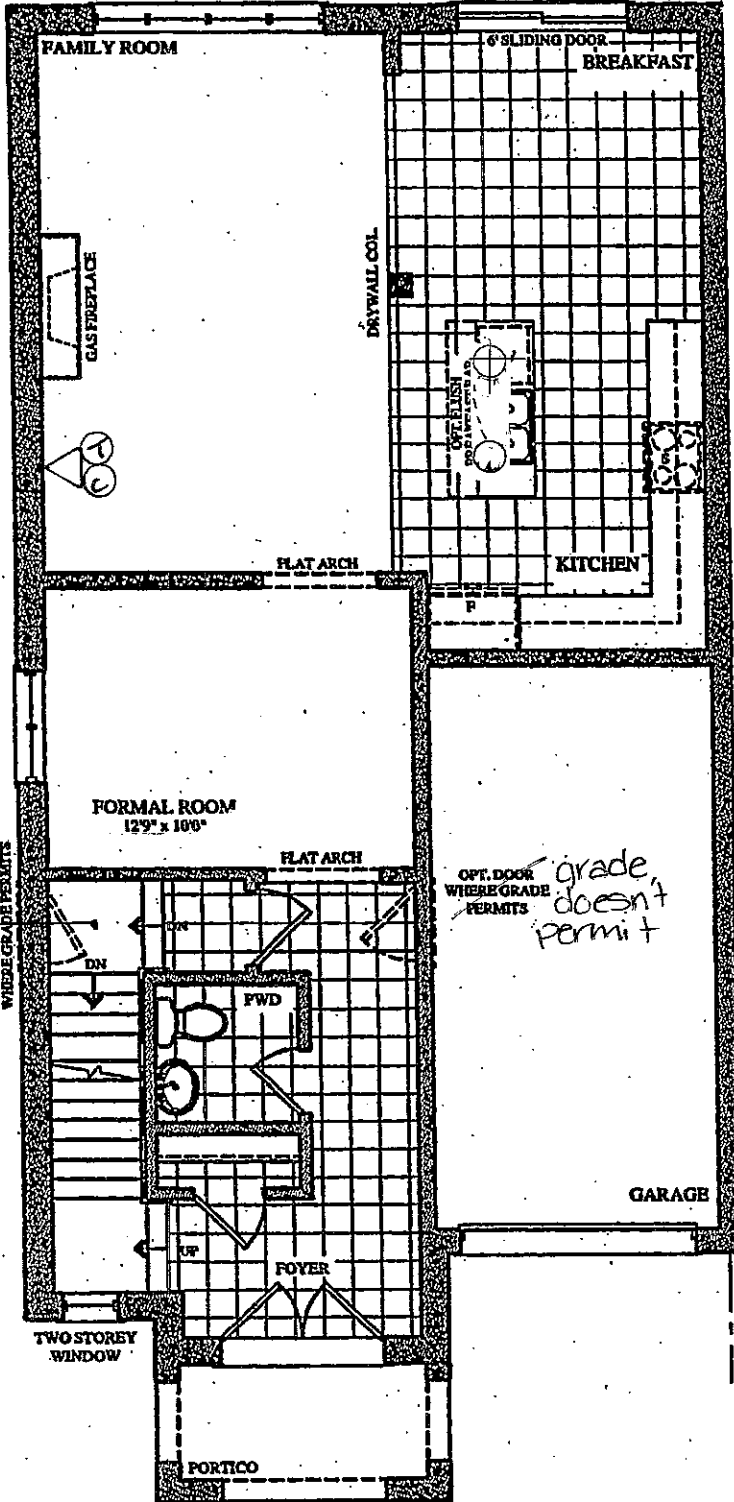

GROUND FLOOR PLAN
ELEV. 'A' & 'B'








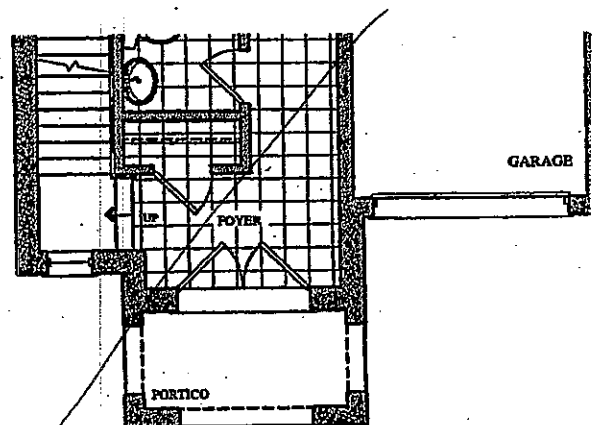


PART. GROUND FLOOR PLAN
ELEV. 'C' & 'D'

The Berlio

SEMI SERIES

→ Elevation A • 2,047 sq.ft.
Elevation B • 2,037 sq.ft.
Elevation C • 2,037 sq.ft.
Elevation D • 2,047 sq.ft.

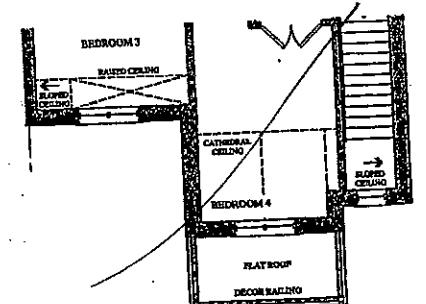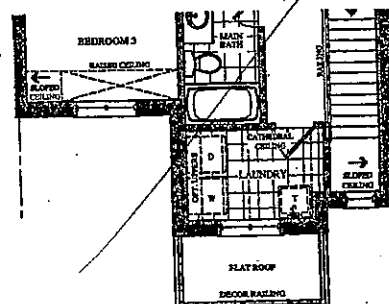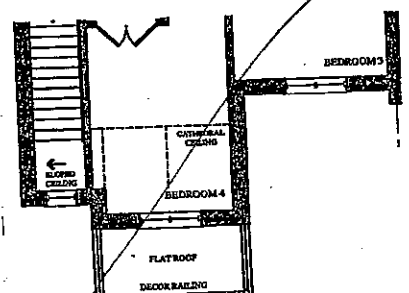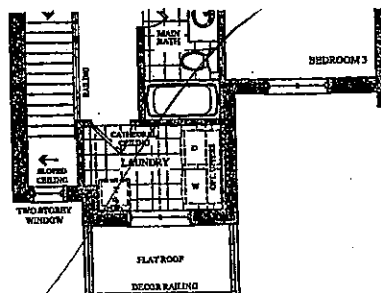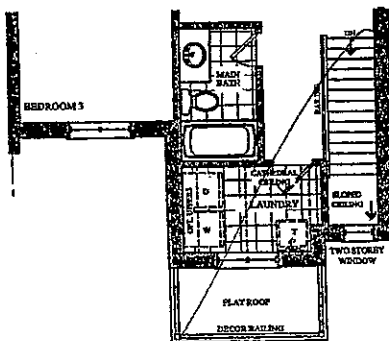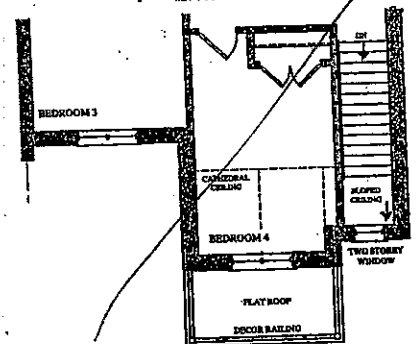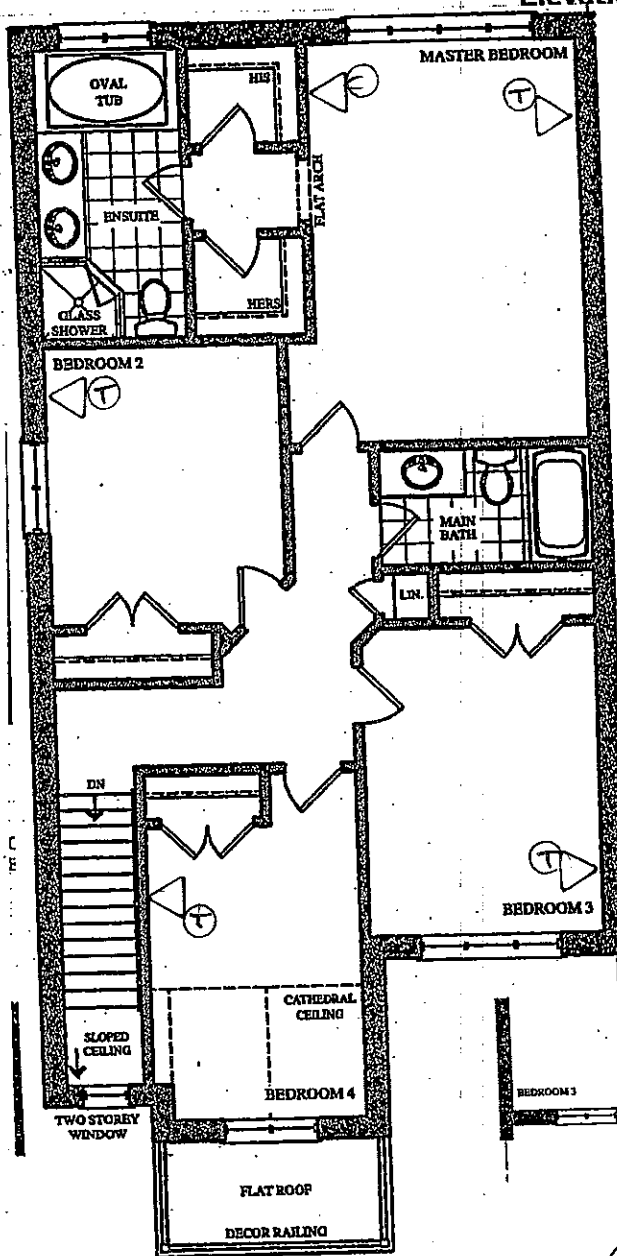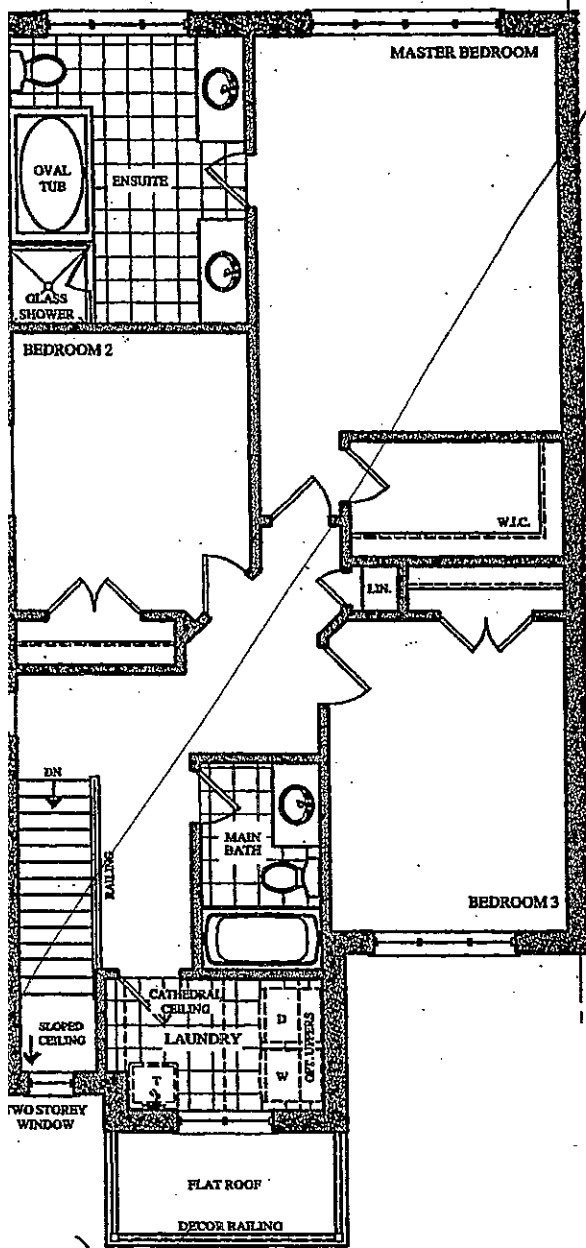


BE2-27L
July 4 2017

A'160

The
Berlio
SEMI SERIES

- Elevation A • 2,047 sq.ft.
- Elevation B • 2,037 sq.ft.
- Elevation C • 2,037 sq.ft.
- Elevation D • 2,047 sq.ft.

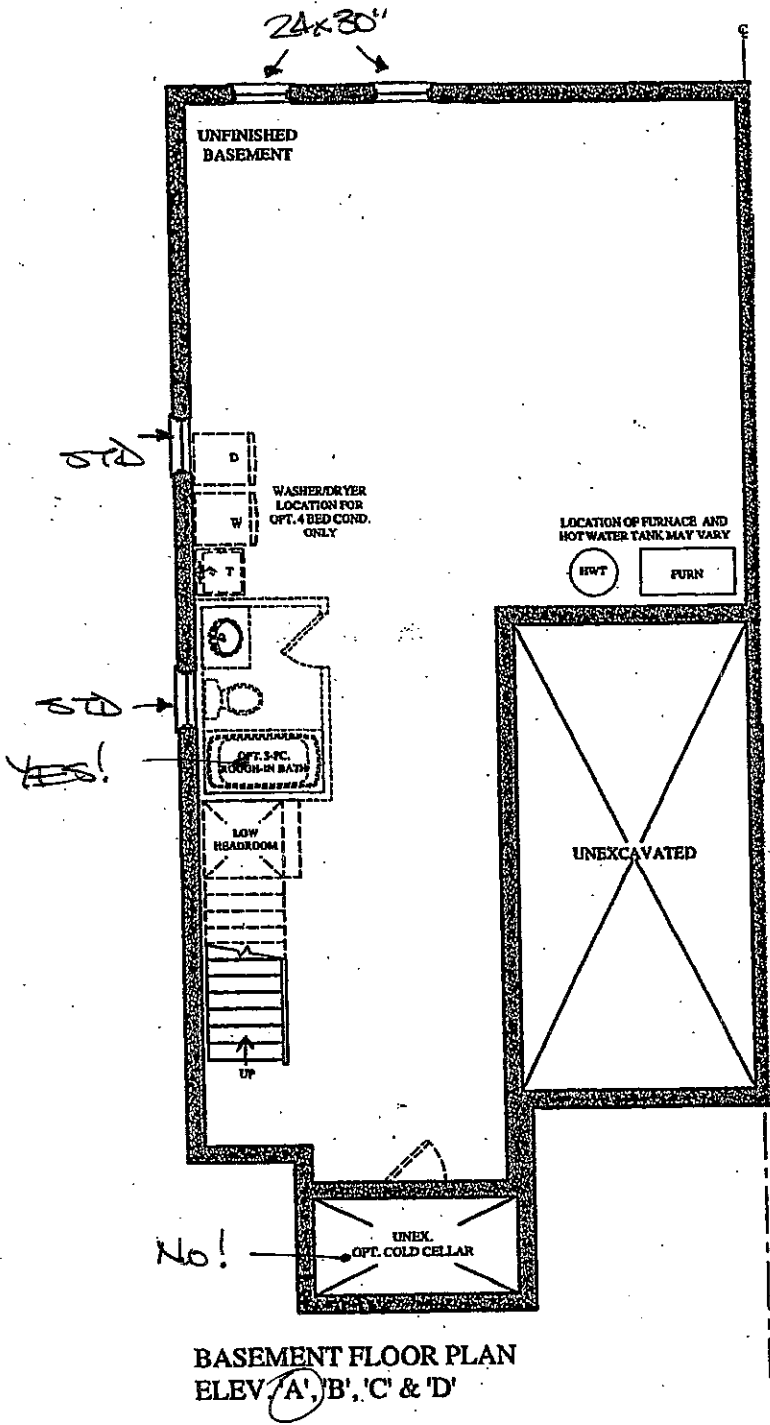

Prices, figures, illustrations, sizes, features and finishes are subject to change without notice. Areas and dimensions are approximate and actual usable floor space may vary from the stated area. Layout may be reverse of the unit purchased. E. & O.E.

GOLDPARK
WORTH MOR