

Brampton Encore - 18R - 2 - 28-6 Elev.B Berlio OPT4

Exterior Colours

Inv.1,440	1 - EXTERIOR COLOUR PACKAGE 6
Line24396	Note:
15Jun17 / 6Oct17	

MISC.

Inv.1,440	1 - BONUS PACKAGE: \$0.00 (INCLUDING TAXES) WORTH OF UPGRADES FROM GOLD PARK HOMES DÉCOR CENTRE IS BEING APPLIED TOWARD THE STRUCTURAL APPOINTMENT. PURCHASER HAS A REMAINING AMOUNT OF \$5,000.00 (INCLUDING TAXES) TO BE USED TOWARD THE COLOUR APPOINTMENT
Line22597	Note:
15Jun17 / 6Oct17	

Inv.1,440	1 - THRU OUT: NO STRUCTURAL CHANGES
Line22596	Note:
15Jun17 / 6Oct17	


WINDOWS AND DOORS

Inv.1,440	1 - DO NOT SUPPLY MANDOOR- GRADE DOESN'T PERMIT
Line24397	Note:
15Jun17 / 6Oct17	

Elevation A • 2,04
Elevation B • 2,03
Elevation C • 2,04
Elevation D • 2,04


Barlo B

BE2-182
June 15 2017

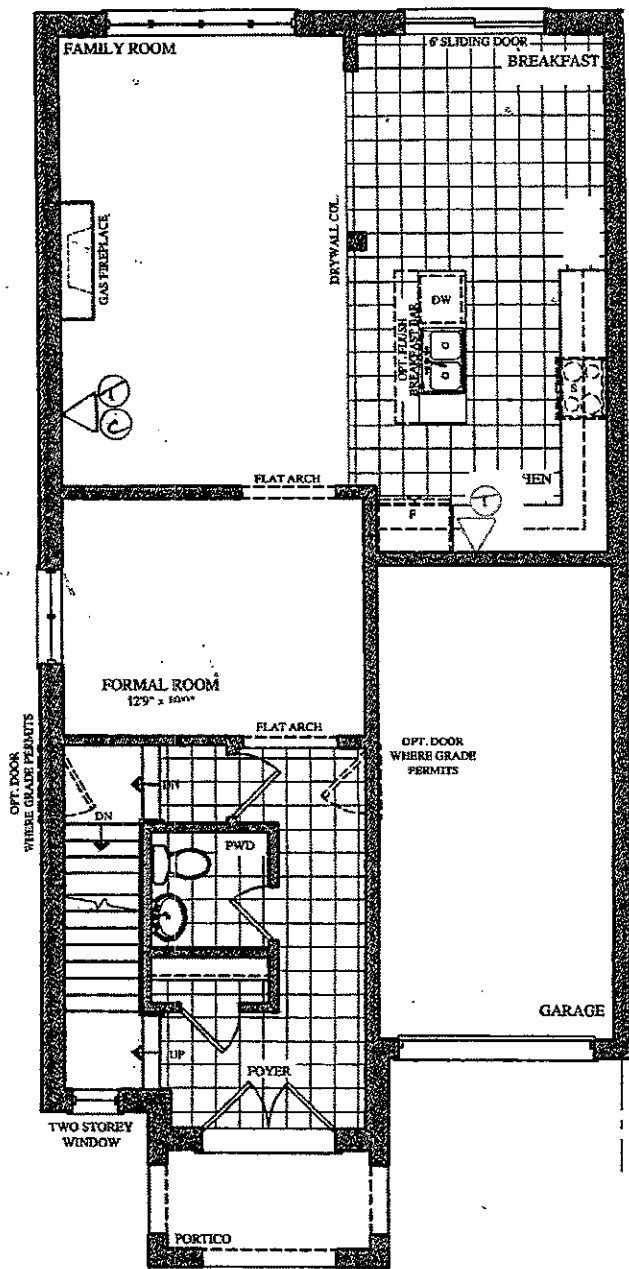

GROUND FLOOR PLAN
ELEV. 'A' & 'B'

LEGEND
① PHONE
② CABLE








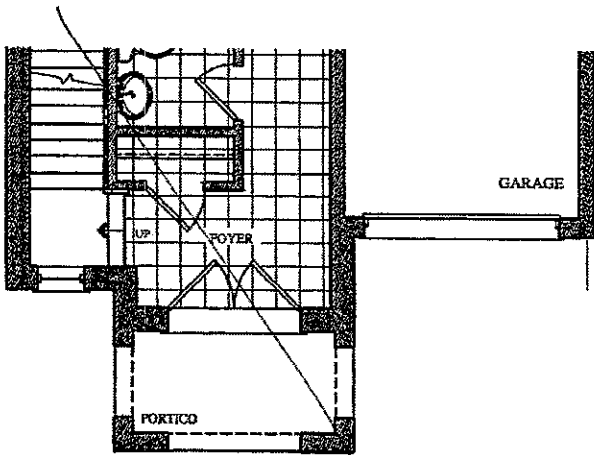


PART. GROUND FLOOR PLAN
ELEV. 'C' & 'D'

BE2-182
JUNE 15 2017

The Berlic SEMI SERIES

Elevation A • 2,047 sq.f
Elevation B • 2,037 sq.f
Elevation C • 2,037 sq.f
Elevation D • 2,047 sq.f

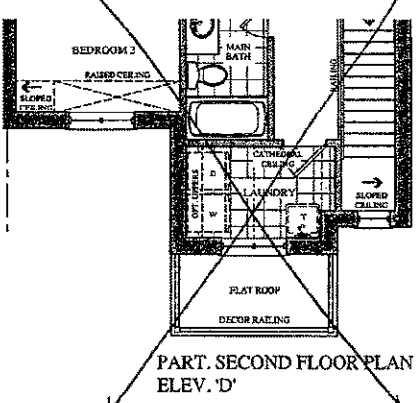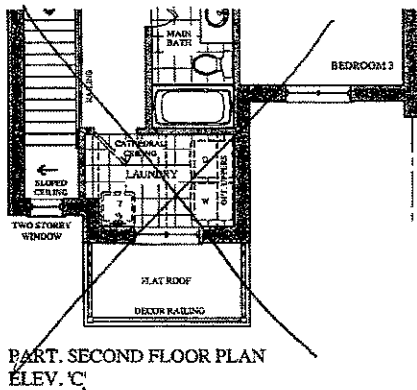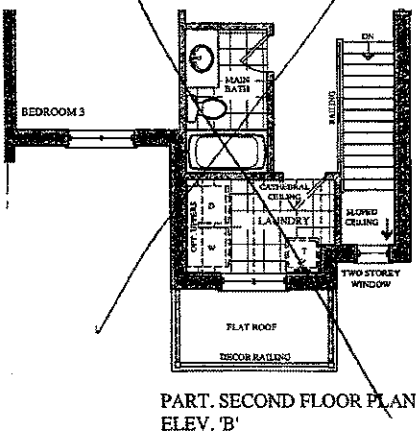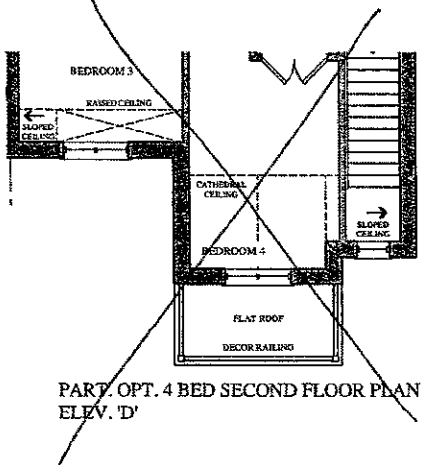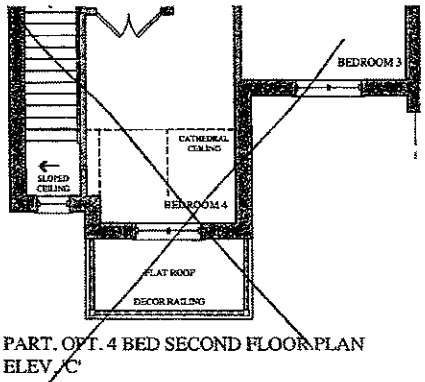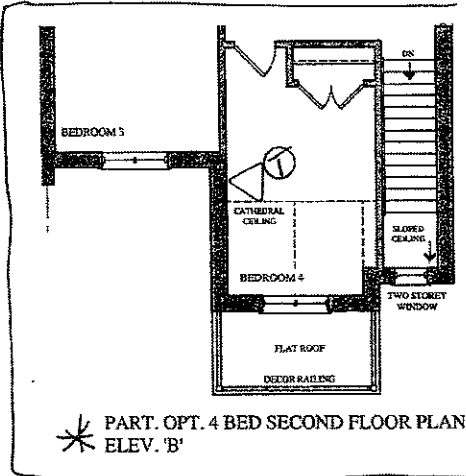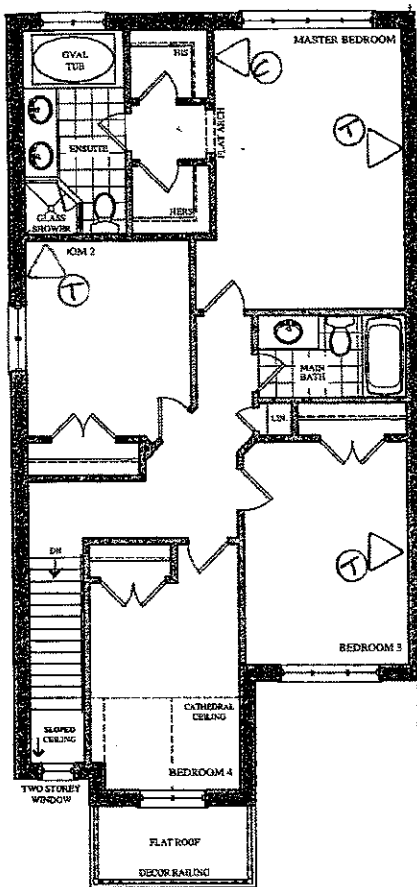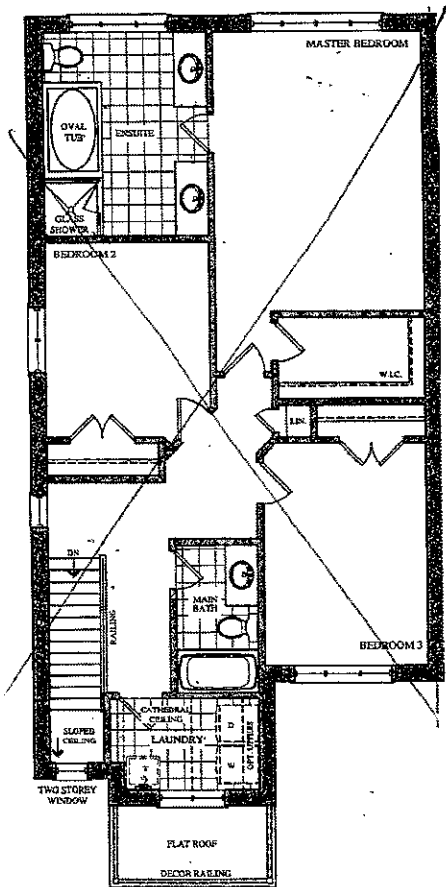

Prices, figures, illustrations, sizes, features and finishes are subject to change without notice. Areas and dimensions are approximate and actual usable floor space may vary from the stated area. Layout may be reverse of the unit purchased. E. & O.E.

GOLDPAR
WORTH

