

Kleinburg Glen - 28 - 2 - 42-3 Elev.B CARLTON

CONCRETE AND DRAIN

Inv.1,621	1 - BACKFLOW PREVENTER VALVE
Line24459	Note:
19Oct17 / 19Oct17	

DRYWALL

Inv.1,621	1 - MAIN FLOOR CEILING 10FT, 8FT TALLER INTERIOR DOORS, TALLER FLAT ARCHES, REAR AND FRONT WINDOWS WITH TRANSOM, TALLER KITCHEN CABINETS WITH CROWN AND FURRING PANEL, ADDED STAIRS AND PICKETS
Line24452	Note:
19Oct17 / 19Oct17	

Inv.1,621	1 - SMOOTH CEILINGS - (2 - Story Design) 2ND FLOOR
Line24458	Note:
19Oct17 / 19Oct17	

ELECTRICAL

Inv.1,621	1 - KITCHEN- FUTURE WALL OVEN- 220V Wall Recepticle on dedicated circuit
Line24461	Note:
19Oct17 / 19Oct17	

Inv.1,621	1 - Under Cabinet Valance Lighting - DOES NOT INCLUDE VALANCE
Line24462	Note:
19Oct17 / 19Oct17	

Inv.1,621	1 - KITCHEN- FOR FUTURE PENDANT LIGHT- Rough in light on existing switch- Capped (doesn't include fixture)
Line24463	Note:
19Oct17 / 19Oct17	

Inv.1,621	1 - KITCHEN- FOR FUTURE PENDANT LIGHT- Rough in light on separate switch- Capped (doesn't include fixture)
Line24464	Note:
19Oct17 / 19Oct17	

Exterior Colours

Inv.1,621	1 - EXTERIOR COLOUR PACKAGE 8
Line24457	Note:
19Oct17 / 19Oct17	

FRAMING

Inv.1,621	1 - MAIN FLOOR CEILING 10FT, 8FT TALLER INTERIOR DOORS, TALLER FLAT ARCHES, REAR AND FRONT WINDOWS WITH TRANSOM, TALLER KITCHEN CABINETS WITH CROWN AND FURRING PANEL, ADDED STAIRS AND PICKETS
Line24451	Note:
19Oct17 / 19Oct17	

HVAC

Inv.1,621	1 - GAS LINE ROUGH - MAIN FLOOR - (2 STOREY MODELS) FOR GAS STOVE- INCLUDES 110V PLUG ON SEPARATE CIRCUIT
Line24460	Note:
19Oct17 / 19Oct17	

INTERIOR TRIM AND DOORS

Kleinburg Glen - 28 - 2 - 42-3 Elev.B CARLTON

Inv.1,621	1 - MAIN FLOOR CEILING 10FT, 8FT TALLER INTERIOR DOORS, TALLER FLAT ARCHES, REAR AND FRONT WINDOWS WITH TRANSOM, TALLER KITCHEN CABINETS WITH CROWN AND FURRING PANEL, ADDED STAIRS AND PICKETS
Line24454	Note:
19Oct17 / 19Oct17	

KITCHEN AND BATH CABINETRY



Inv.1,621	1 - MAIN FLOOR CEILING 10FT, 8FT TALLER INTERIOR DOORS, TALLER FLAT ARCHES, REAR AND FRONT WINDOWS WITH TRANSOM, TALLER KITCHEN CABINETS WITH CROWN AND FURRING PANEL, ADDED STAIRS AND PICKETS
Line24453	Note:
19Oct17 / 19Oct17	

WINDOWS AND DOORS


Inv.1,621	4 - 4 UPGRADED BASEMENT WINDOWS 16" X 30"
Line24450	Note:
19Oct17 / 19Oct17	
Inv.1,621	1 - MAIN FLOOR CEILING 10FT, 8FT TALLER INTERIOR DOORS, TALLER FLAT ARCHES, REAR AND FRONT WINDOWS WITH TRANSOM, TALLER KITCHEN CABINETS WITH CROWN AND FURRING PANEL, ADDED STAIRS AND PICKETS
Line24455	Note:
19Oct17 / 19Oct17	
Inv.1,621	1 - MANDOOR- GRADE PERMITS
Line24456	Note:
19Oct17 / 19Oct17	

Elevation A • 3,354 sq.ft.


Elevation B • 3,361 sq.ft.

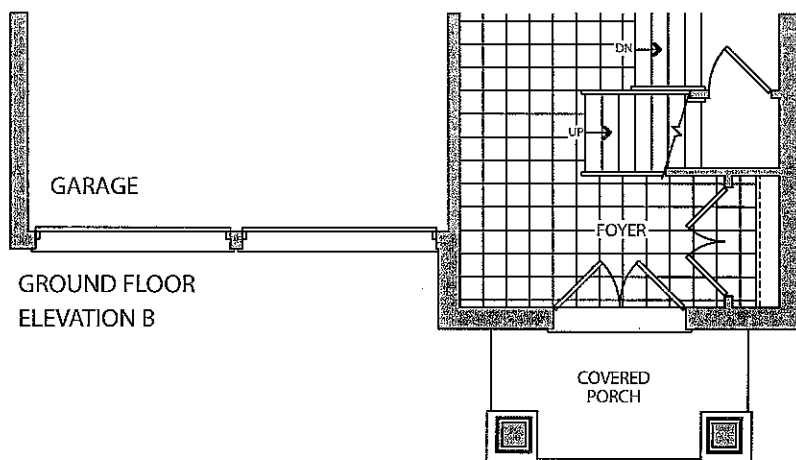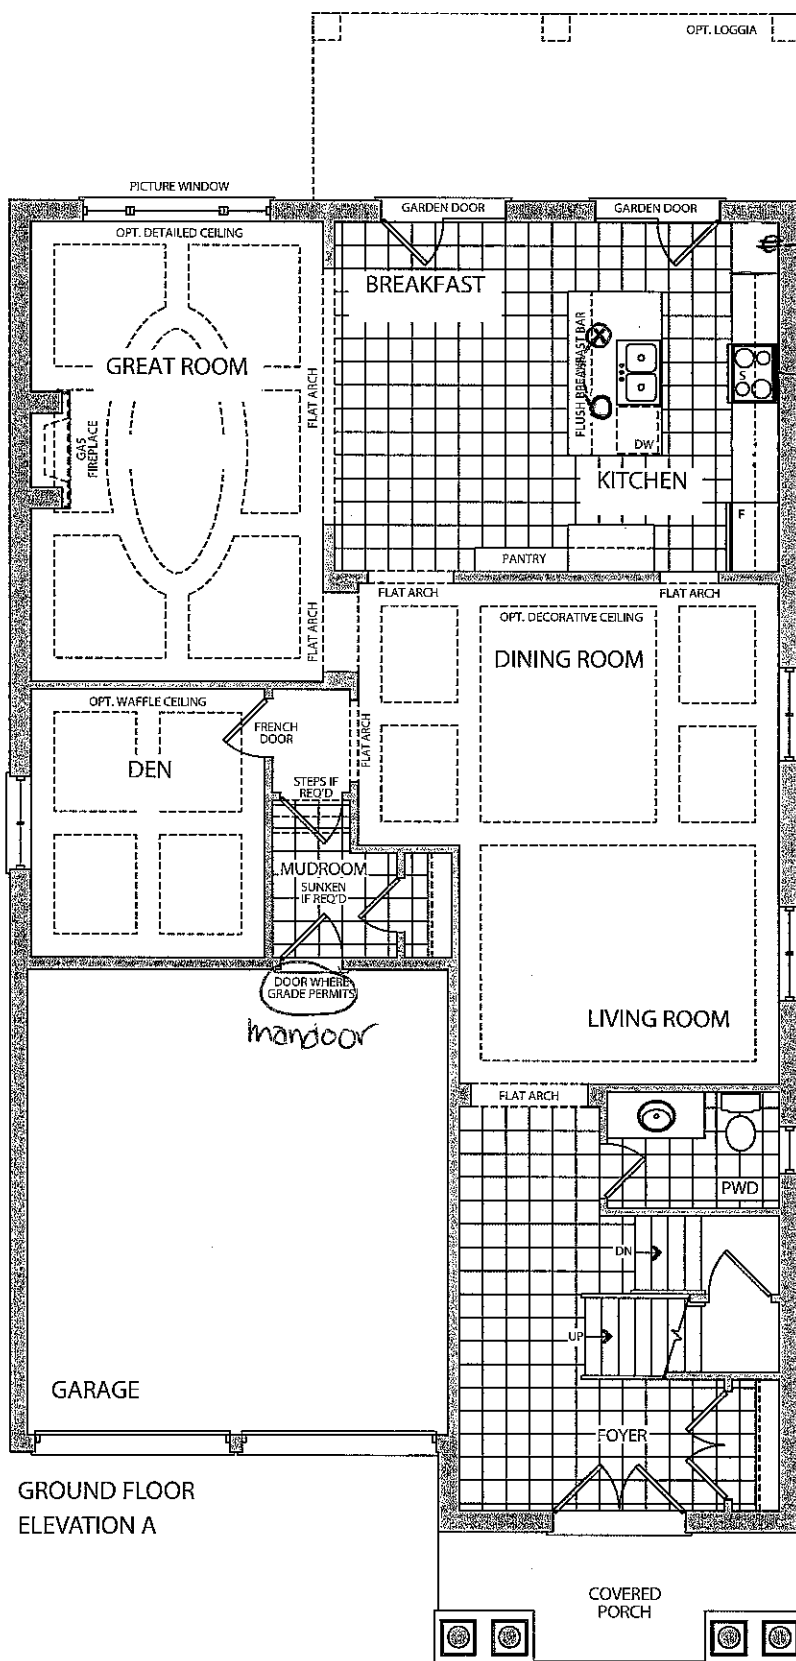

-smooth ceilings

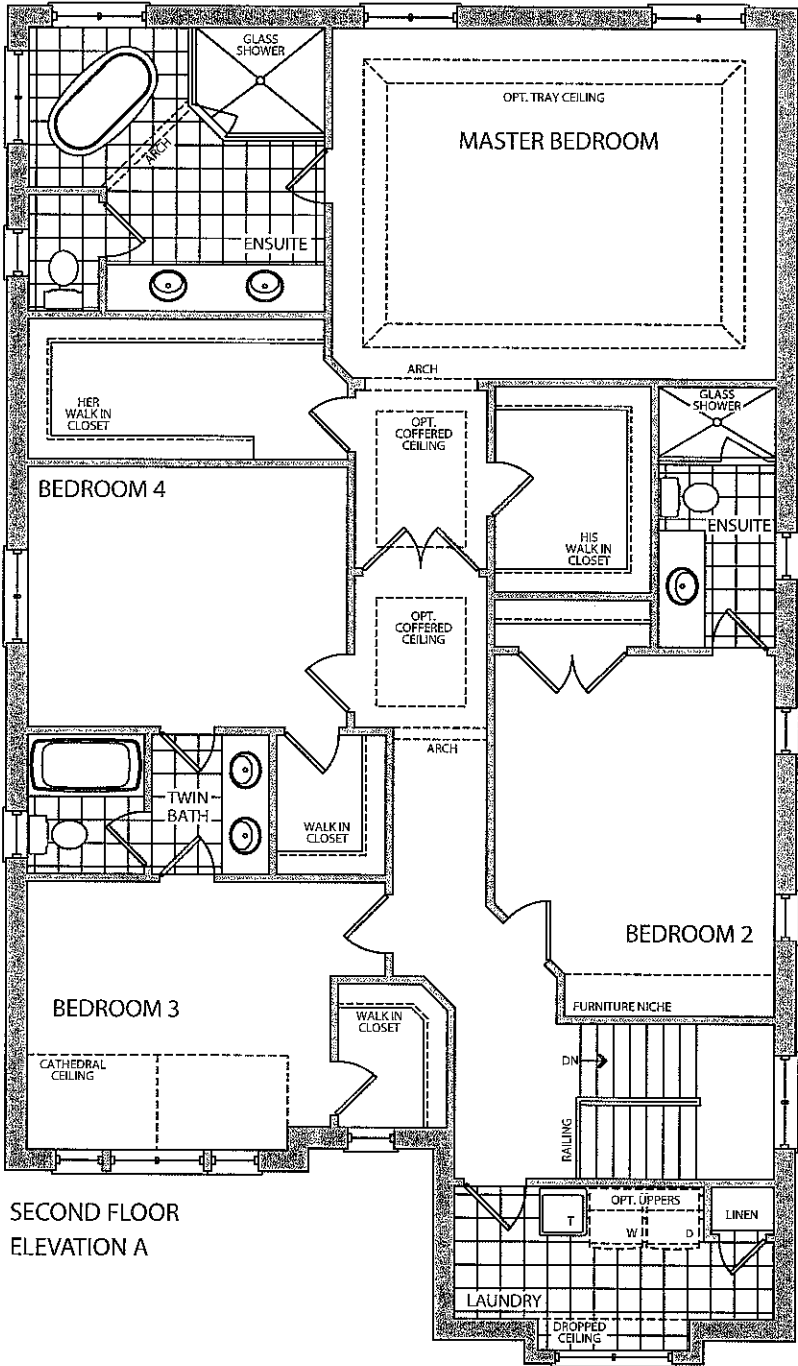


SECOND FLOOR
ELEVATION A

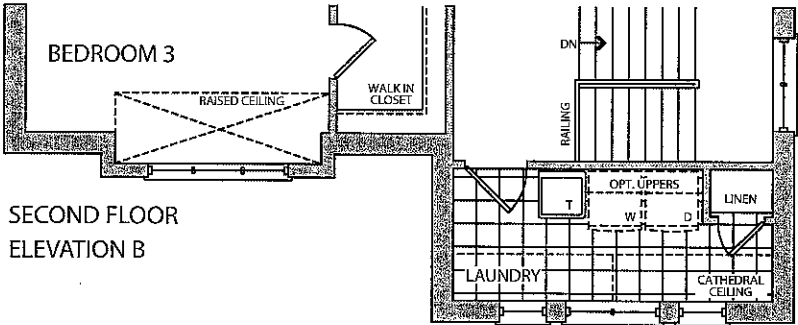


SECOND FLOOR
ELEVATION B

Elevation A • 3,354 sq.ft.
Elevation B • 3,361 sq.ft.

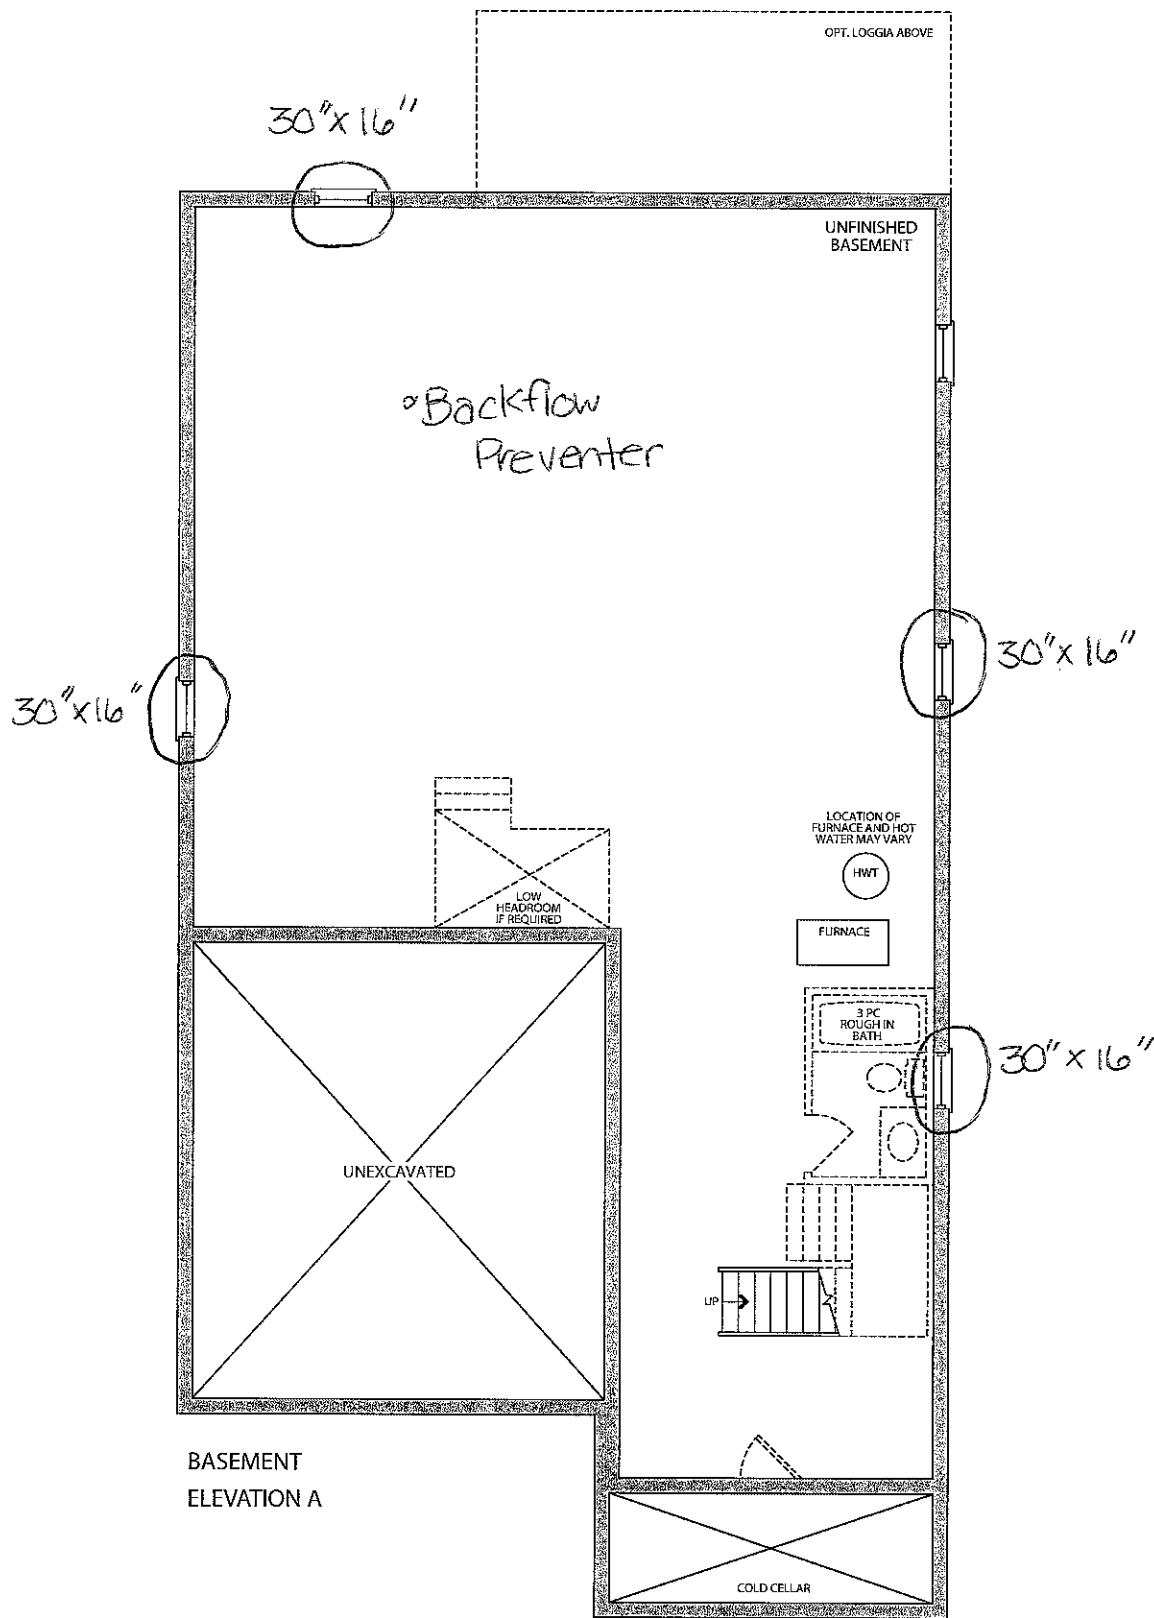

BASEMENT
ELEVATION A

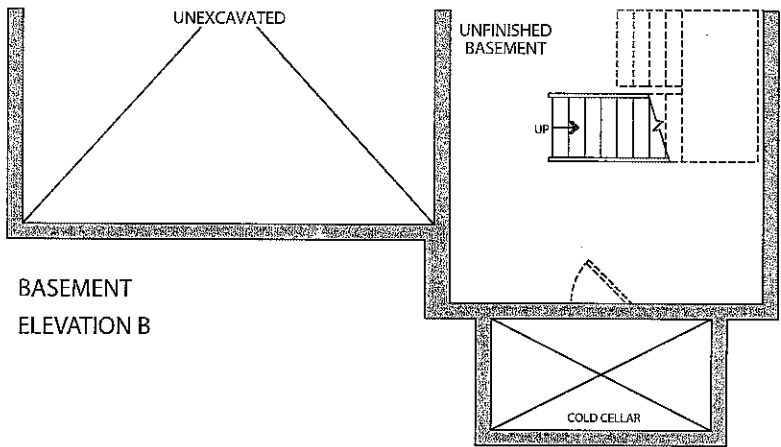

BASEMENT
ELEVATION B

Prices, figures, illustrations, sizes, features and finishes are subject to change without notice. E.&O.E. Areas and dimensions are approximate and actual usable floor space may vary from the stated area. Layout may be reverse of the unit purchased. E. & O.E.