

Kleinburg Glen - BLOCK 51 - 2 - Unknown

CONCRETE AND DRAIN

Inv.1,623	1 - BACKFLOW PREVENTER VALVE
Line24505	Note:
25Oct17 / 25Oct17	

DRYWALL

Inv.1,623	1 - MAIN FLOOR CEILING 10FT, 8FT TALLER INTERIOR DOORS, TALLER FLAT ARCHES, REAR AND FRONT WINDOWS WITH TRANSOM, TALLER KITCHEN CABINETS WITH CROWN AND FURRING PANEL, ADDED STAIRS AND PICKETS
Line24496	Note:
25Oct17 / 25Oct17	

Inv.1,623	1 - SMOOTH CEILINGS 2ND FLOOR
Line24508	Note:
25Oct17 / 25Oct17	

ELECTRICAL

Inv.1,623	1 - GAS LINE ROUGH - MAIN FLOOR - (2 STOREY MODELS) FOR GAS STOVE- INCLUDES 110V PLUG ON SEPARATE CIRCUIT
Line24502	Note:
25Oct17 / 25Oct17	

Inv.1,623	1 - KITCHEN- FUTURE WALL OVEN- 220V WALL RECEPTICLE ON DEDICATED CIRCUIT
Line24503	Note:
25Oct17 / 25Oct17	

Inv.1,623	1 - UNDER CABINET VALANCE LIGHTING- DOES NOT INCLUDE VALANCE
Line24504	Note:
25Oct17 / 25Oct17	

Inv.1,623	1 - KITCHEN- FOR FUTURE PENDANT LIGHT- Rough-in light on existing switch- Capped (doesn't include fixture)
Line24509	Note:
25Oct17 / 25Oct17	

Inv.1,623	1 - KITCHEN- FOR FUTURE PENDANT LIGHT- Rough-in light on a seperate switch- Capped (doesn't incude fixture)
Line24510	Note:
25Oct17 / 25Oct17	

Exterior Colours

Inv.1,623	1 - EXTERIOR COLOUR PACKAGE #9
Line24494	Note:
25Oct17 / 25Oct17	

FRAMING

Inv.1,623	1 - MAIN FLOOR CEILING 10FT, 8FT TALLER INTERIOR DOORS, TALLER FLAT ARCHES, REAR AND FRONT WINDOWS WITH TRANSOM, TALLER KITCHEN CABINETS WITH CROWN AND FURRING PANEL, ADDED STAIRS AND PICKETS
Line24495	Note:
25Oct17 / 25Oct17	

HVAC

Inv.1,623	1 - GAS LINE ROUGH - MAIN FLOOR - (2 STOREY MODELS) FOR GAS STOVE- INCLUDES 110V PLUG ON SEPARATE CIRCUIT
Line24501	Note:
25Oct17 / 25Oct17	

Kleinburg Glen - BLOCK 51 - 2 - Unknown

INTERIOR TRIM AND DOORS

Inv.1,623	1 - MAIN FLOOR CEILING 10FT, 8FT TALLER INTERIOR DOORS, TALLER FLAT ARCHES, REAR AND FRONT WINDOWS WITH TRANSOM, TALLER KITCHEN CABINETS WITH CROWN AND FURRING PANEL, ADDED STAIRS AND PICKETS
Line24497	Note:
25Oct17 / 25Oct17	

KITCHEN AND BATH CABINETRY

Inv.1,623	1 - MAIN FLOOR CEILING 10FT, 8FT TALLER INTERIOR DOORS, TALLER FLAT ARCHES, REAR AND FRONT WINDOWS WITH TRANSOM, TALLER KITCHEN CABINETS WITH CROWN AND FURRING PANEL, ADDED STAIRS AND PICKETS
Line24498	Note:
25Oct17 / 25Oct17	

STAIRS AND RAILINGS

Inv.1,623	1 - MAIN FLOOR CEILING 10FT, 8FT TALLER INTERIOR DOORS, TALLER FLAT ARCHES, REAR AND FRONT WINDOWS WITH TRANSOM, TALLER KITCHEN CABINETS WITH CROWN AND FURRING PANEL, ADDED STAIRS AND PICKETS
Line24499	Note:
25Oct17 / 25Oct17	

WINDOWS - BASEMENT

Inv.1,623	4 - BASEMENT WINDOWS - UPGRADE EXISTING BASEMENT WINDOW TO 30 INCH X 16 INCH
Line24506	Note:
25Oct17 / 25Oct17	

WINDOWS AND DOORS



Inv.1,623	1 - MAIN FLOOR CEILING 10FT, 8FT TALLER INTERIOR DOORS, TALLER FLAT ARCHES, REAR AND FRONT WINDOWS WITH TRANSOM, TALLER KITCHEN CABINETS WITH CROWN AND FURRING PANEL, ADDED STAIRS AND PICKETS
Line24500	Note:
25Oct17 / 25Oct17	
Inv.1,623	1 - INSTALL MANDOOR-GARAGE TO HOUSE- GRADE PERMITS
Line24507	Note:
25Oct17 / 25Oct17	

Elevation A • 3,354 sq.ft.

Elevation B • 3,361 sq.ft.


- 10' main floor
- taller archways
- taller doors
- Kitchen crown + furring panel

⊗ - capped with switch
○ - capped

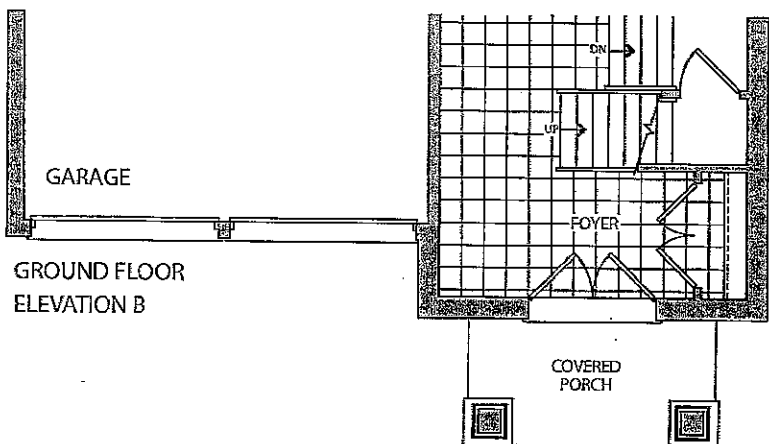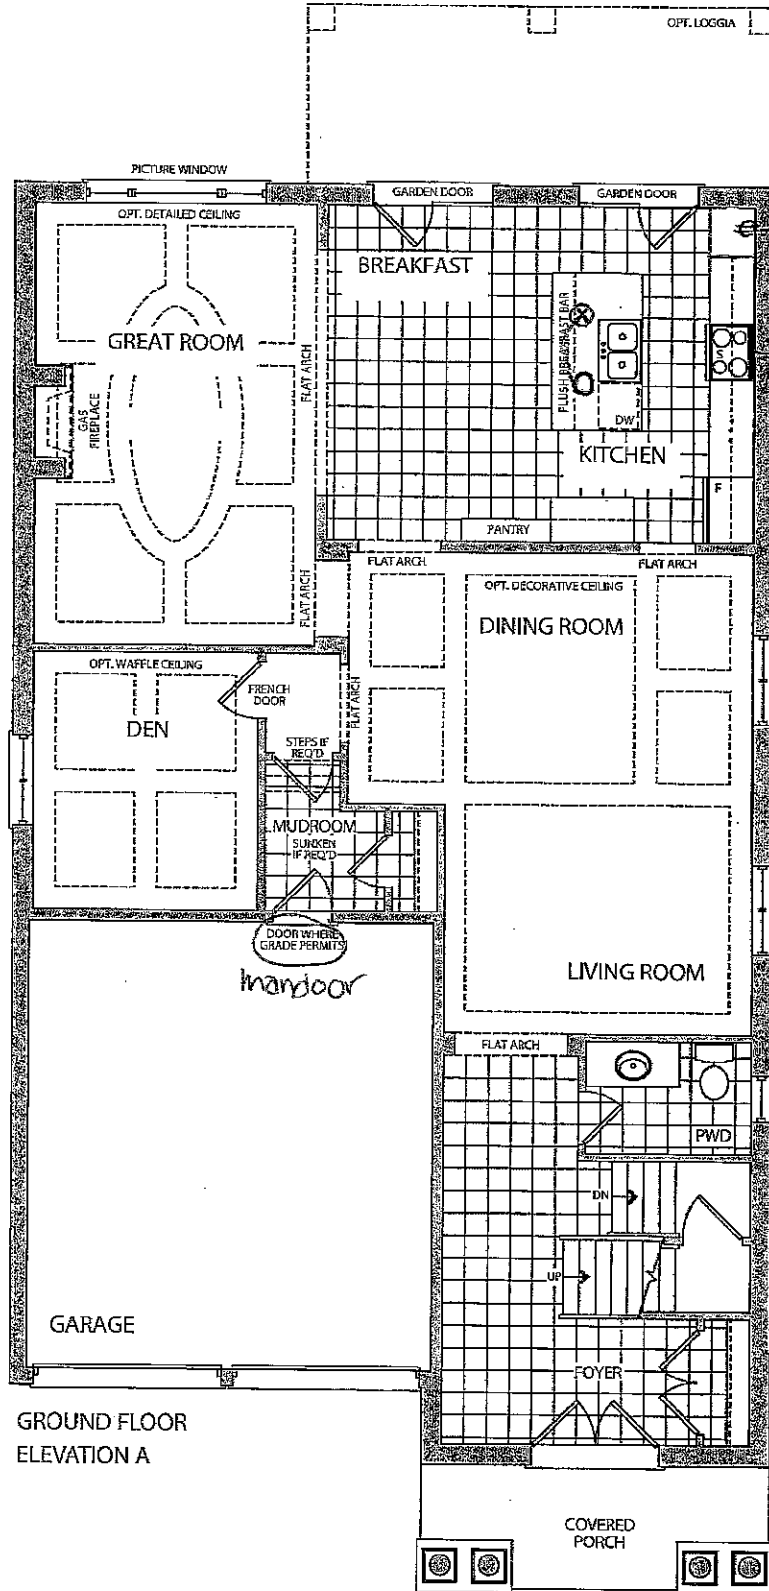


Prices, figures, illustrations, sizes, features and finishes are subject to change without notice. E.&O.E. Areas and dimensions are approximate and actual usable floor space may vary from the stated area. Layout may be reverse of the unit purchased. E. & O.E.

-smooth ceilings

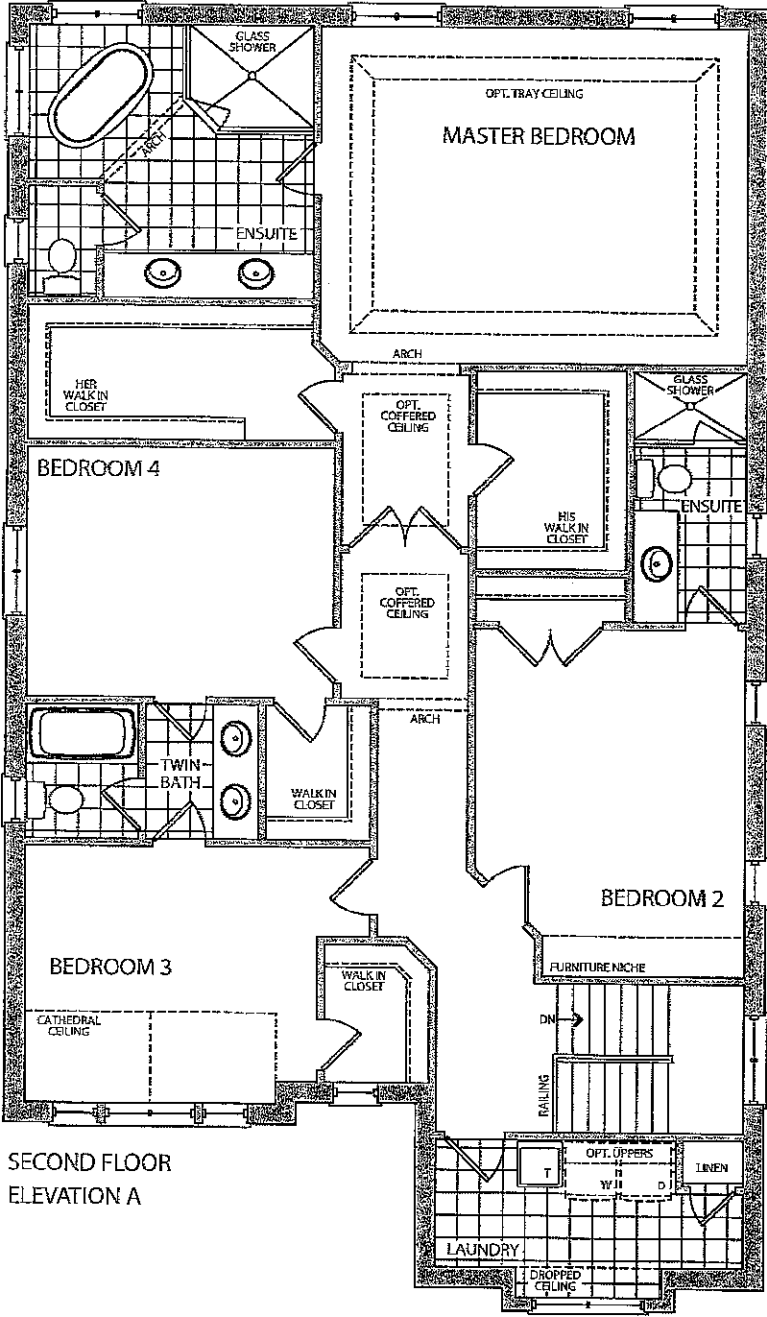


SECOND FLOOR
ELEVATION A

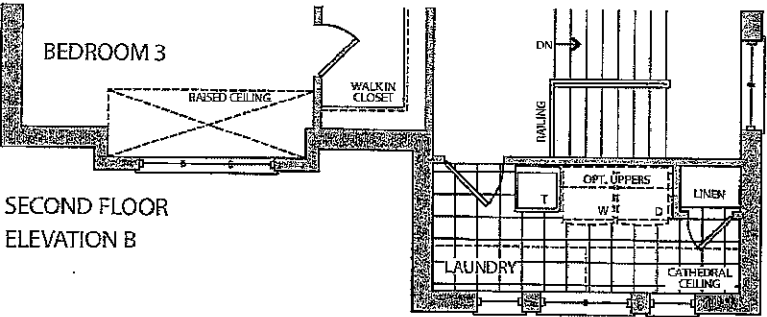


SECOND FLOOR
ELEVATION B

Elevation A • 3,354 sq.ft.

Elevation B • 3,361 sq.ft.

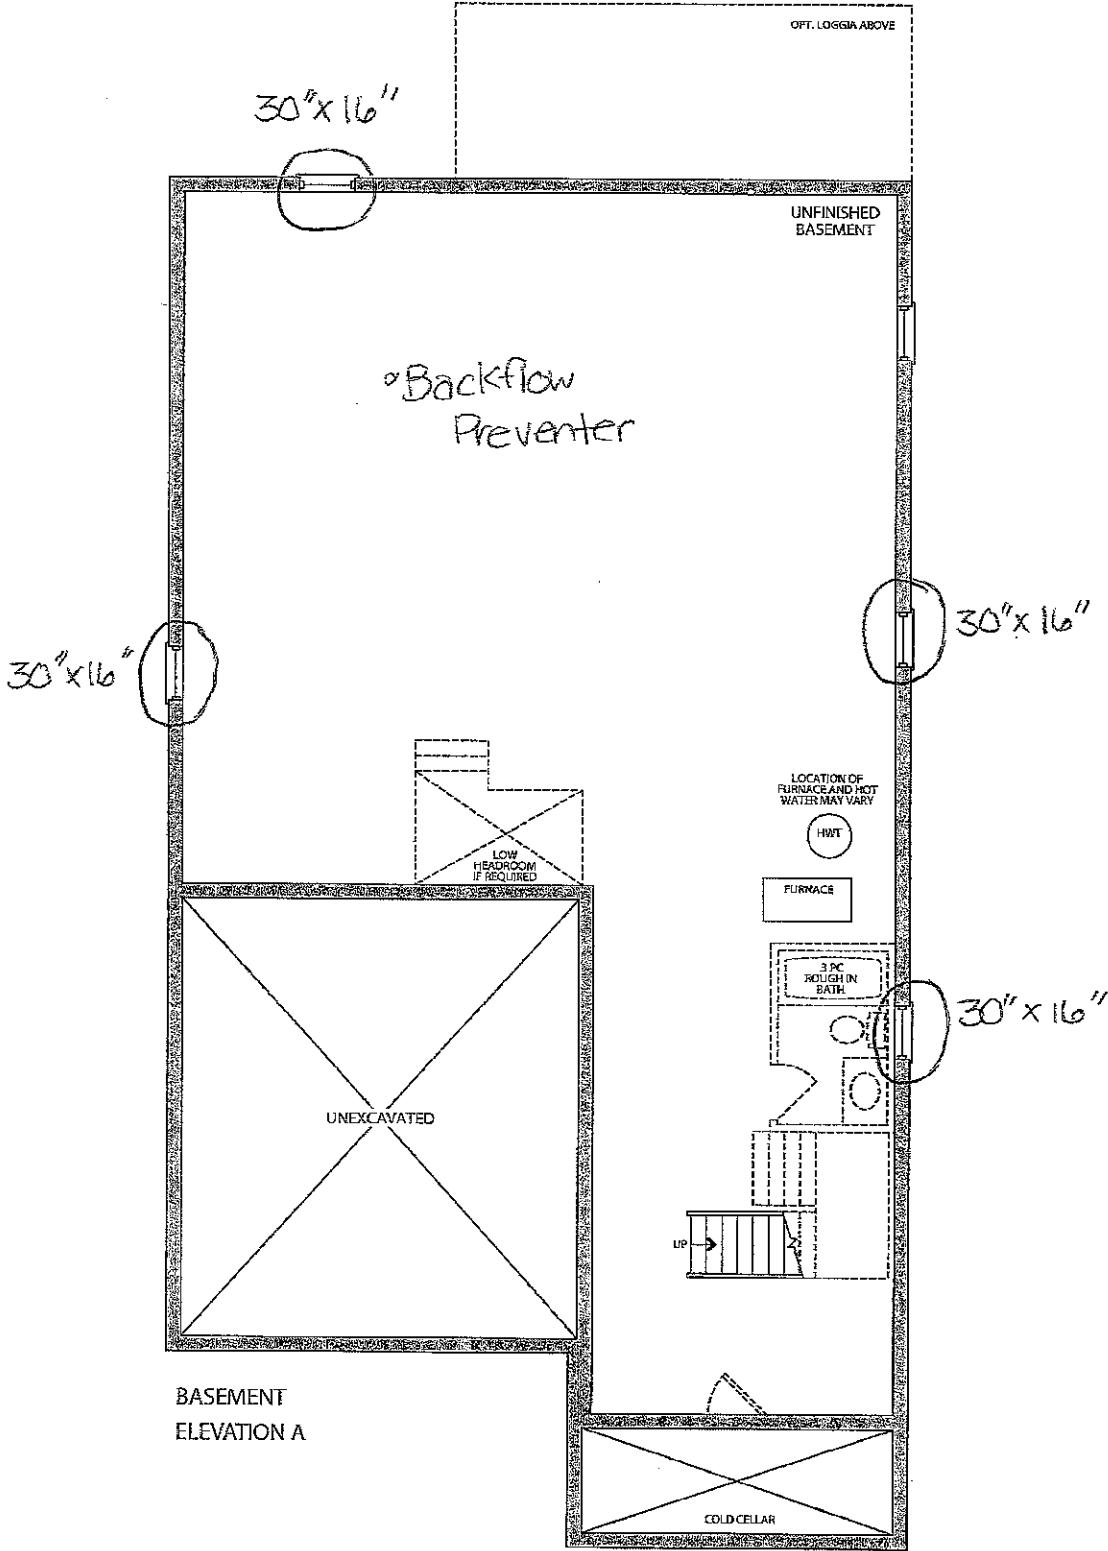

BASEMENT
ELEVATION A

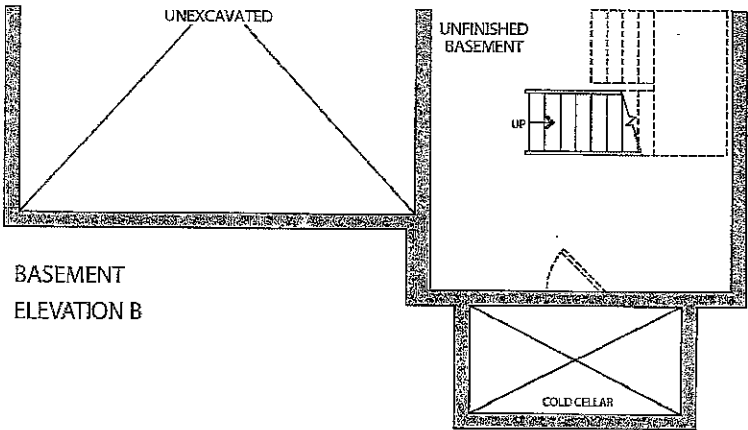

BASEMENT
ELEVATION B

Prices, figures, illustrations, sizes, features and finishes are subject to change without notice. E.&O.E. Areas and dimensions are approximate and actual usable floor space may vary from the stated area. Layout may be reverse of the unit purchased. E. & O.E.