

ADDITION: LOT 6L Kleinburg


PROJECT- Kleinburg Glen

SFA5- Optional 4th Bedroom


INSERT: Carpet- T15 in 4th Bedroom

DATE ISSUED: 10/25/17

ISSUED BY: Stacey Carlete

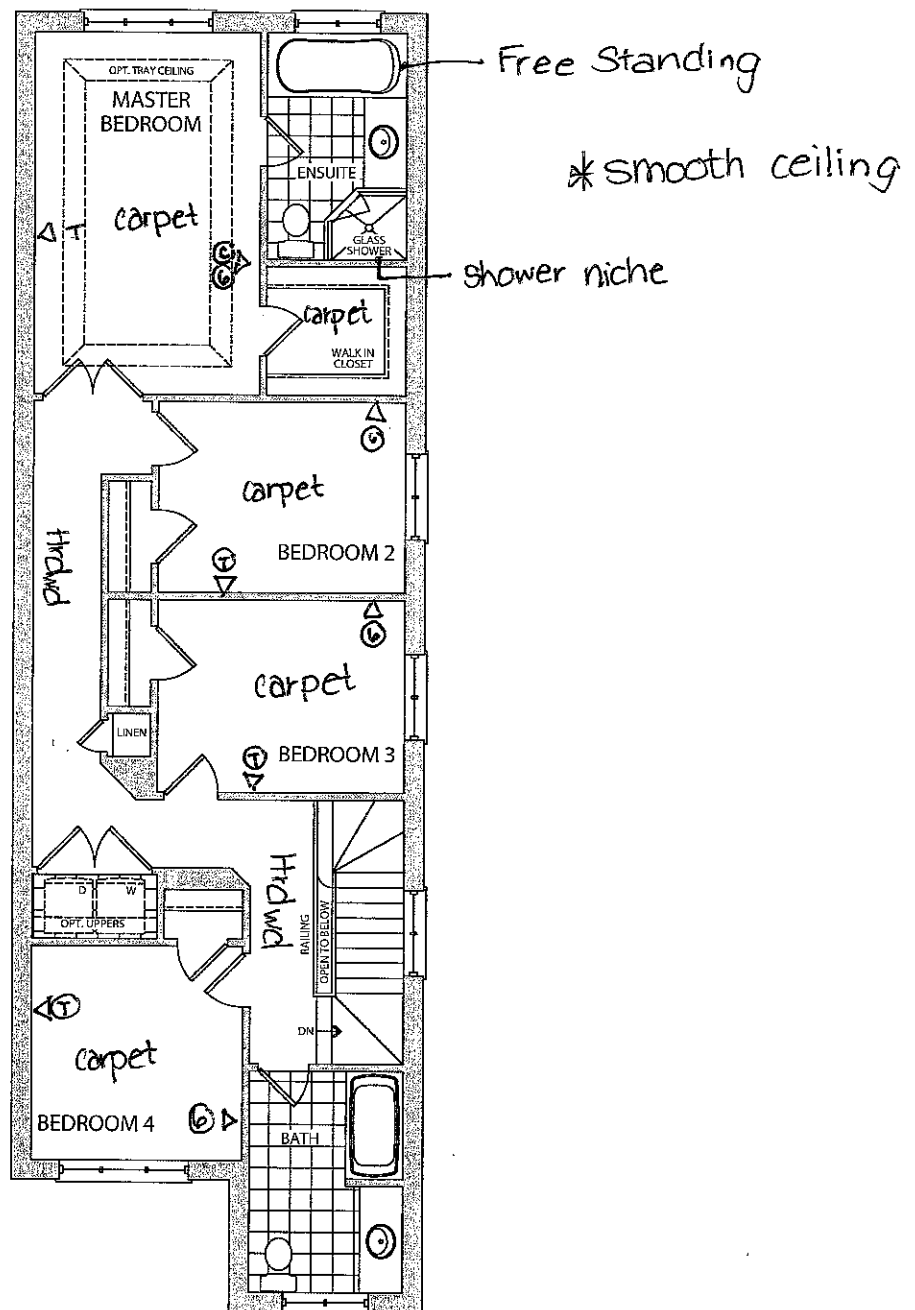

OPT. SECOND FLOOR
ELEVATION A

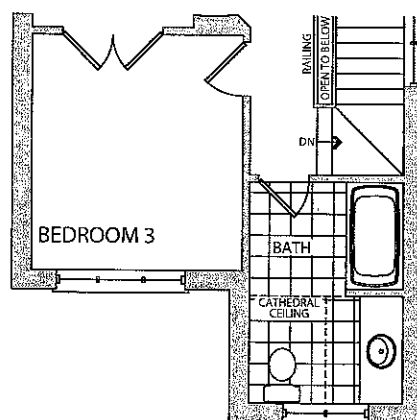

OPT. SECOND FLOOR
ELEVATION B