

Brampton Encore - 12L - 2 - 28-2 Elev.CL Siren

CENTRAL VAC AND WIRING

Inv.1,519	1 - FAMILY ROOM: CONDUIT PIPE- FOR TELEVISION- LOCATE ABOVE FIREPLACE APPROX. 66" A.F.F., TERMINATING BY CABLE OUTLET.
Line23484	Note:
24Jul17 / 10Oct17	

ELECTRICAL

Inv.1,519	1 - FAMILY ROOM: 110V WALL RECEPTACLE ON NORMAL CIRCUIT- LOCATE ABOVE FIREPLACE, APPROX. 66" A.F.F.
Line23483	Note:
24Jul17 / 10Oct17	
Inv.1,519	1 - KITCHEN: RELOCATE STANDARD CEILING LIGHT TO ABOVE ISLAND. SEE PLAN FOR LOCATION.
Line23485	Note:
24Jul17 / 10Oct17	
Inv.1,519	1 - KITCHEN: ROUGH - IN CEILING OUTLET ON SAME SWITCH - DOES NOT INCLUDE FIXTURE - LOCATE ABOVE ISLAND, SEE PLAN FOR LOCATION.
Line23486	Note:
24Jul17 / 10Oct17	
Inv.1,519	1 - KITCHEN: 110V WALL RECEPTACLE ON DEDICATED CIRCUIT - FOR MICROWAVE - MICROWAVE AND CABINETRY CUSTOMIZATION NOT INCLUDED
Line23487	Note:
24Jul17 / 10Oct17	
Inv.1,519	1 - 200 AMP ELECTRICAL SERVICE
Line23488	Note: ***ONLY INSTALL *IF SIDE ENTRANCE DOOR* IS ALLOWED***
24Jul17 / 10Oct17	

Exterior Colours

Inv.1,519	1 - EXTERIOR COLOUR PACKAGE #2
Line24422	Note:
24Jul17 / 10Oct17	

FRAMING

Inv.1,519	1 - KITCHEN: UPGRADE VENTING FOR STOVE TO 8" PIPE INTERIOR WALL - ACCOMODATED TO FIT STANDARD RANGE HOOD
Line24282	Note:
24Jul17 / 10Oct17	
Inv.1,519	1 - MAIN FLOOR: STANDARD ARCH EXTENDED HEIGHT 96" (PRICE PER DOOR) MAIN FLOOR 3 STOREY MODELS - INCLUDE FRAMING NOTE
Line24423	Note:
24Jul17 / 10Oct17	

GARAGE DOORS

Inv.1,519	1 - GARAGE DOOR OPENER *CHAIN DRIVE* - WITH 1 REMOTE- PRICE IS PER DOOR
Line23496	Note:
24Jul17 / 10Oct17	

HVAC

Inv.1,519	1 - KITCHEN: UPGRADE VENTING FOR STOVE TO 8" PIPE INTERIOR WALL - ACCOMODATED TO FIT STANDARD RANGE HOOD
Line23492	Note:
24Jul17 / 10Oct17	

Brampton Encore - 12L - 2 - 28-2 Elev.CL Siren

INTERIOR TRIM AND DOORS

Inv.1,519	1 - MAIN FLOOR: STANDARD ARCH EXTENDED HEIGHT 96" (PRICE PER DOOR) MAIN FLOOR 3 STOREY MODELS - INCLUDE FRAMING NOTE
Line23495	Note:
24Jul17 / 10Oct17	

MISC.

Inv.1,519	1 - DO NOT INSTALL- GRADE DOESN'T PERMIT- SIDE DOOR- HOME TO EXTERIOR
Line23489	Note:
24Jul17 / 10Oct17	

Inv.1,519	1 - Purchaser has attended an appointment at the Decor Centre & has DECLINED any additional upgrades and accepts and acknowledges that there will be no further changes/additions/deletions to be made upon signing on July 24 2017.
Line23497	Note:
24Jul17 / 10Oct17	

Inv.1,519	1 - Purchasers are aware & accepts that ANY changes made to upgrades after signing this Purchasers Extra Form are subject to a minimum administration fee of \$500. PLUS a 10% holdback fee.
Line23498	Note:
24Jul17 / 10Oct17	

Inv.1,519	1 - BONUS PACKAGE: \$10,000.00 (INCLUDING TAXES) WORTH OF UPGRADES FROM GOLD PARK HOMES DÉCOR CENTRE IS BEING APPLIED TOWARD THE STRUCTURAL APPOINTMENT. PURCHASER HAS A REMAINING AMOUNT OF \$2790.60 (INCLUDING TAXES) TO BE USED TOWARD THE COLOUR APPOINTMENT.
Line23499	Note:
24Jul17 / 10Oct17	

WINDOWS - BASEMENT


Inv.1,519	2 - BASEMENT WINDOWS - UPGRADE EXISTING BASEMENT WINDOW TO 30 INCH X 24 INCH - MAY REQUIRE INSTALLATION OF WINDOW WELL
Line23490	Note:
24Jul17 / 10Oct17	

FE2-12L
July 24 2017


The Siren

SEMI SERIES

Elevation A • 1,688 sq.ft.
Elevation B • 1,677 sq.ft.
Elevation C • 1,687 sq.ft.

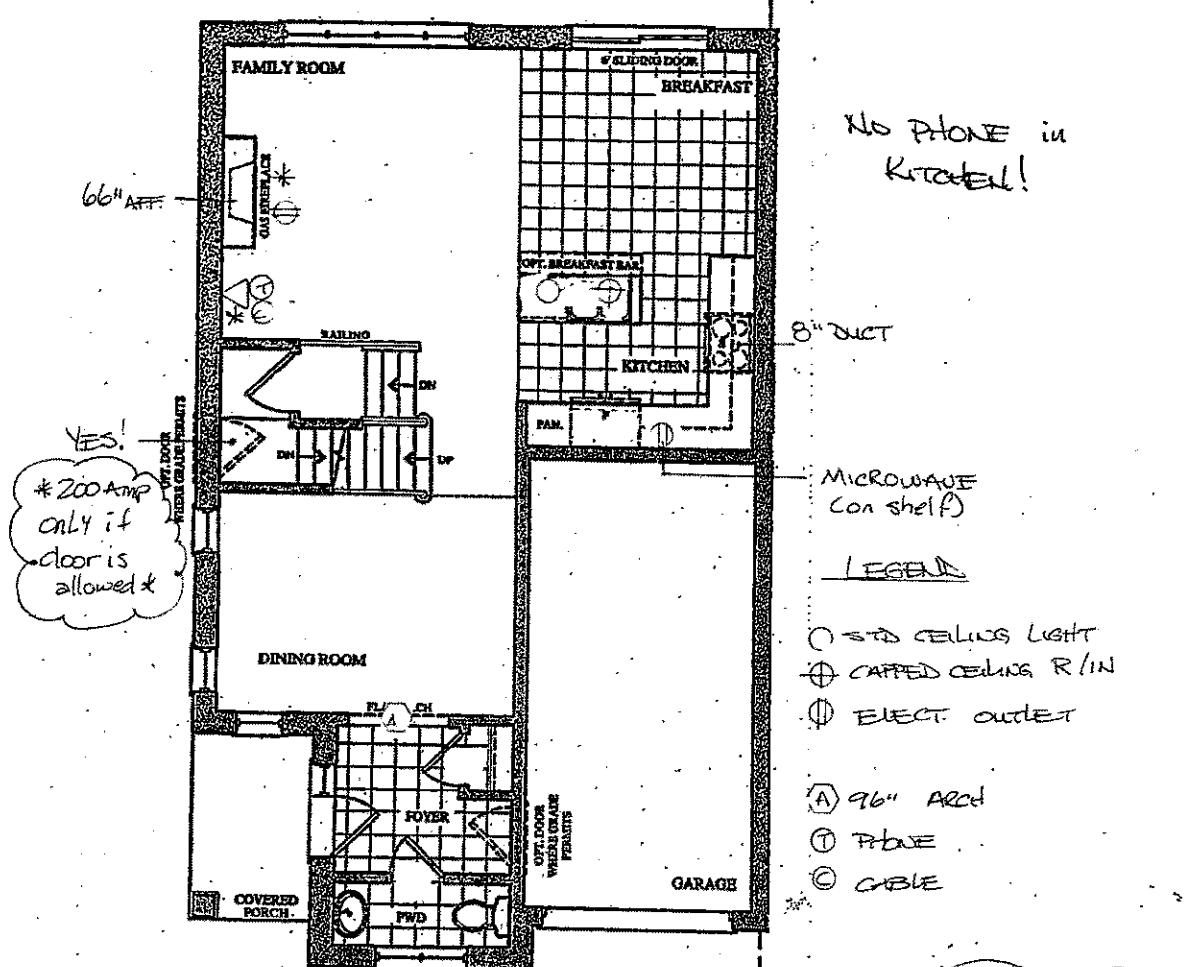

GROUND FLOOR PLAN
ELEV. 'A' & 'B'

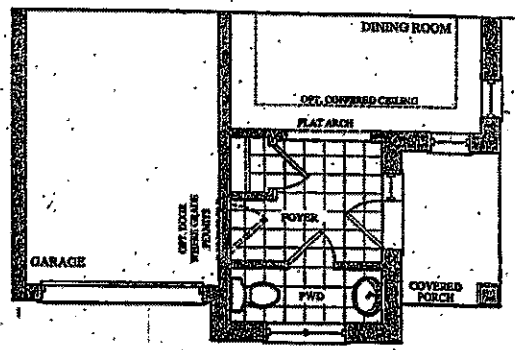

PART. GROUND FLOOR PLAN
ELEV. 'C'


BEZ-12L
July 24 2017



The Siren

SEMI SERIES

Elevation A • 1,688 sq.ft.
Elevation B • 1,677 sq.ft.
→ Elevation C • 1,687 sq.ft.

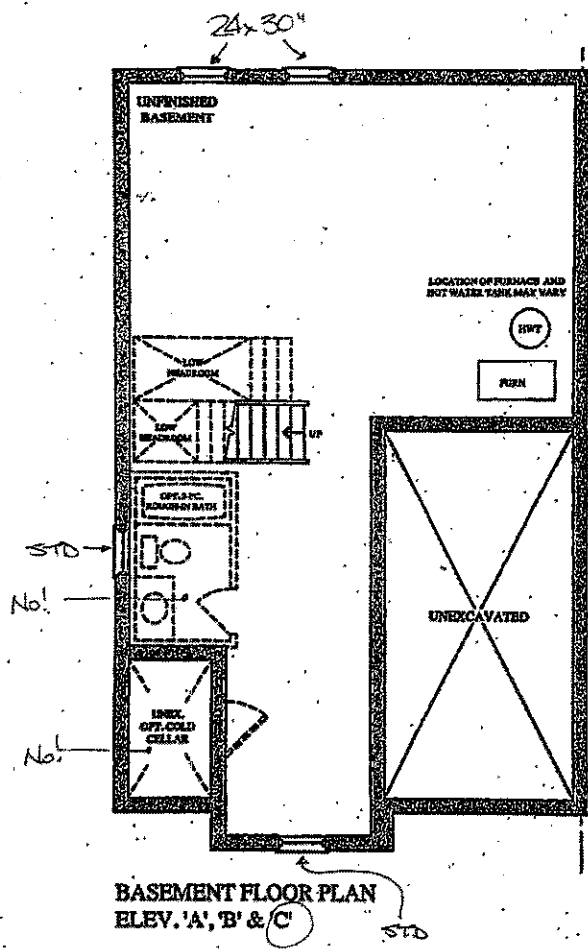


BEZ-12L
July 24 2007 (D.S.)


The Siren

SEMI SERIES


Elevation A • 1,688 sq.ft.
Elevation B • 1,677 sq.ft.
→ Elevation C • 1,687 sq.ft.

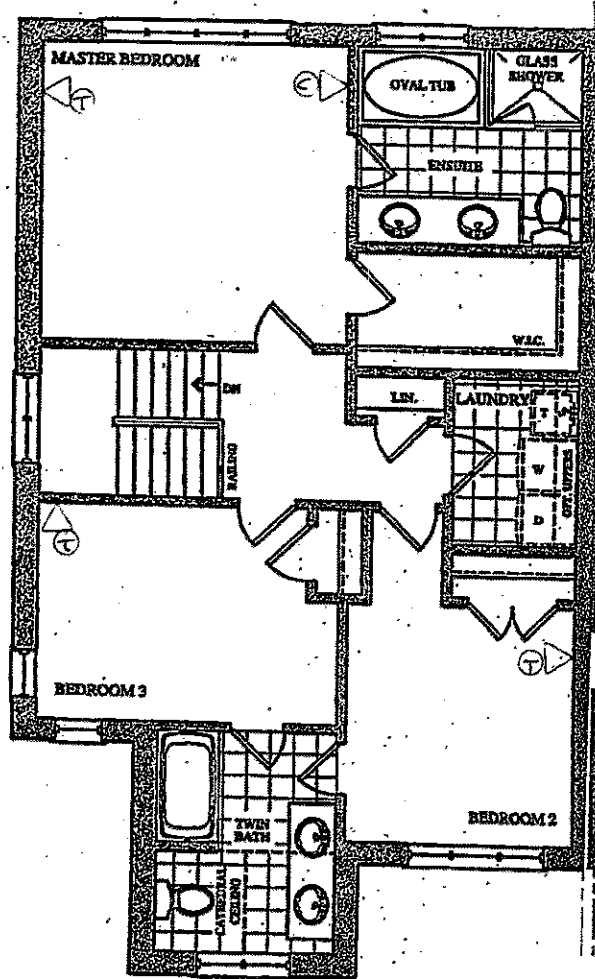

SECOND FLOOR PLAN
ELEV. 'A'

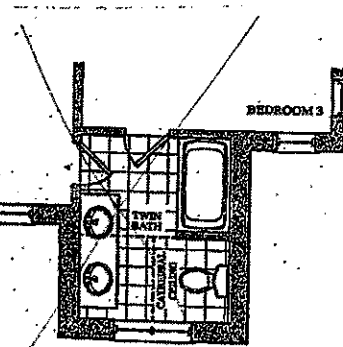

PART. SECOND FLOOR PLAN
ELEV. 'B'

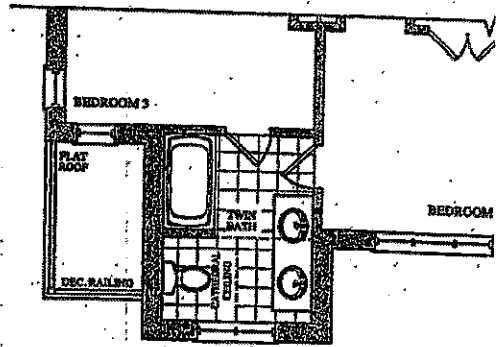

PART. SECOND FLOOR PLAN
ELEV. 'C'