

Brampton Encore - 23R - 2 - 28-2 Elev.CR SIREN

CONCRETE AND DRAIN

Inv.1,458	1 - ROUGH-IN - 3PC BASEMENT ROUGH-IN
Line22797	Note:
26Jun17 / 30Oct17	

Exterior Colours

Inv.1,458	1 - EXTERIOR COLOUR PACKAGE #1
Line24556	Note:
26Jun17 / 30Oct17	

FRAMING

Inv.1,458	1 - MAIN FLOOR: EXTENDED HEIGHT ARCHWAY (PRICE PER DOORWAY) -96"
Line24555	Note:
26Jun17 / 30Oct17	

Inv.1,458	1 - MAIN FLOOR: STANDARD DOOR EXTENDED HEIGHT 96" (PRICE PER DOOR)- GROUND FLOOR 2 STOREY MODELS
Line24554	Note:
26Jun17 / 30Oct17	

INTERIOR TRIM AND DOORS

Inv.1,458	3 - MAIN FLOOR: STANDARD DOOR EXTENDED HEIGHT 96" (PRICE PER DOOR)- GROUND FLOOR 2 STOREY MODELS
Line22803	Note:
26Jun17 / 30Oct17	

Inv.1,458	1 - MAIN FLOOR: EXTENDED HEIGHT ARCHWAY (PRICE PER DOORWAY) -96"
Line22804	Note:
26Jun17 / 30Oct17	

MISC.

Inv.1,458	1 - DO NOT INSTALL SIDE DOOR- HOME TO EXTERIOR- AS PER PLAN AND GRADE PERMITTING- GRADE DOESN'T PERMIT
Line22798	Note:
26Jun17 / 30Oct17	

Inv.1,458	1 - Purchaser has attended an appointment at the Decor Centre & has DECLINED any additional upgrades and accepts and acknowledges that there will be no further changes/additions/deletions to be made upon signing on June 26 2017.
Line22805	Note:
26Jun17 / 30Oct17	

Inv.1,458	1 - Purchasers are aware & accepts that ANY changes made to upgrades after signing this Purchasers Extra Form are subject to a minimum administration fee of \$500. PLUS a 10% holdback fee.
Line22806	Note:
26Jun17 / 30Oct17	

Inv.1,458	1 - BONUS PACKAGE: \$10,000.00 (INCLUDING TAXES) WORTH OF UPGRADES FROM GOLD PARK HOMES DÉCOR CENTRE IS BEING APPLIED TOWARD THE STRUCTURAL APPOINTMENT. PURCHASER HAS A REMAINING AMOUNT OF \$2338.60 (INCLUDING TAXES) TO BE USED TOWARD THE COLOUR APPOINTMENT.
Line22807	Note:
26Jun17 / 30Oct17	

WINDOWS - BASEMENT

Brampton Encore - 23R - 2 - 28-2 Elev.CR SIREN

Inv.1,458	2 - BASEMENT WINDOWS - UPGRADE EXISTING BASEMENT WINDOW TO 30 INCH X 16 INCH
Line22800	Note:
26Jun17 / 30Oct17	
Inv.1,458	2 - BASEMENT WINDOWS - UPGRADE EXISTING BASEMENT WINDOW TO 30 INCH X 24 INCH - MAY REQUIRE INSTALLATION OF WINDOW WELL
Line22799	Note:
26Jun17 / 30Oct17	

BE2-232
JUNE 26 2017

(9) (1)


The Siren

SEMI SERIES

Elevation A • 1,688 sq.ft.

Elevation B • 1,677 sq.ft.

Elevation C • 1,687 sq.ft.

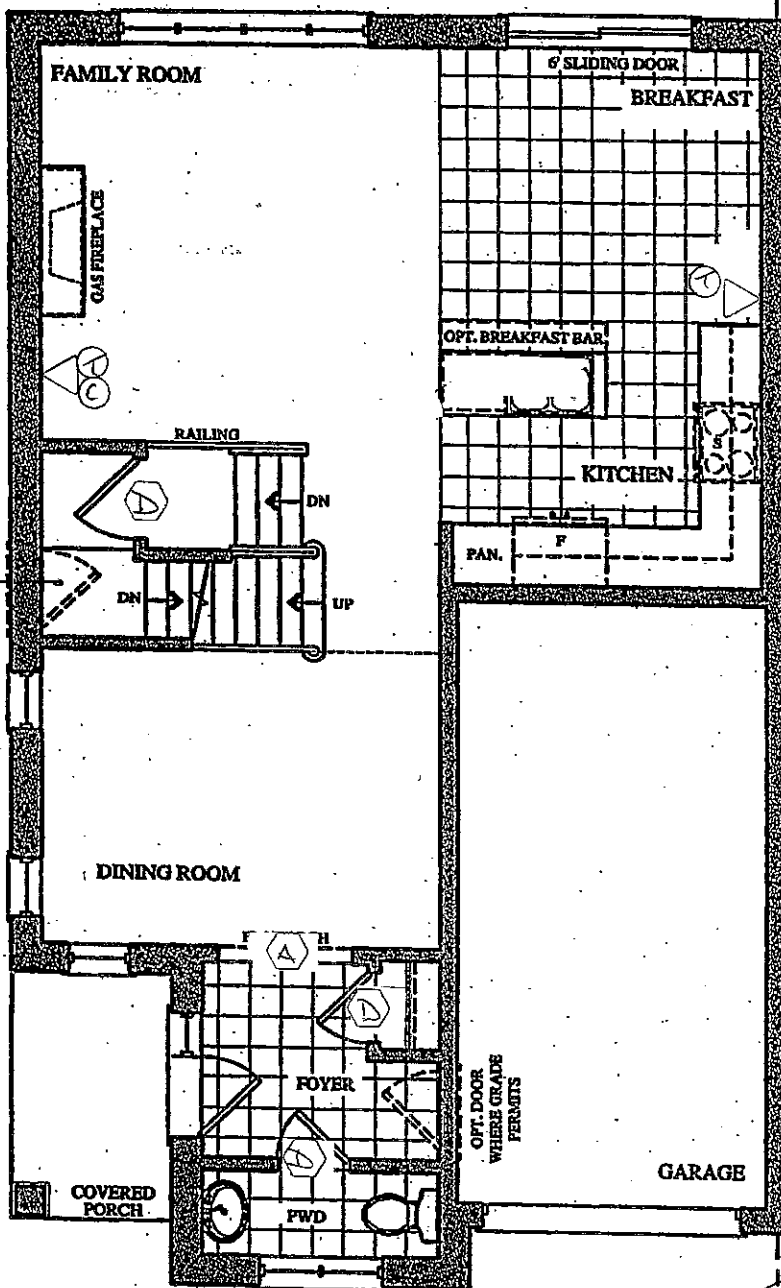

LEGEND


⬡ 96" Door

⬢ 96" Arch

⬠ PHONE

⬡ CABLE

GROUND FLOOR PLAN
ELEV. 'A' & 'B'

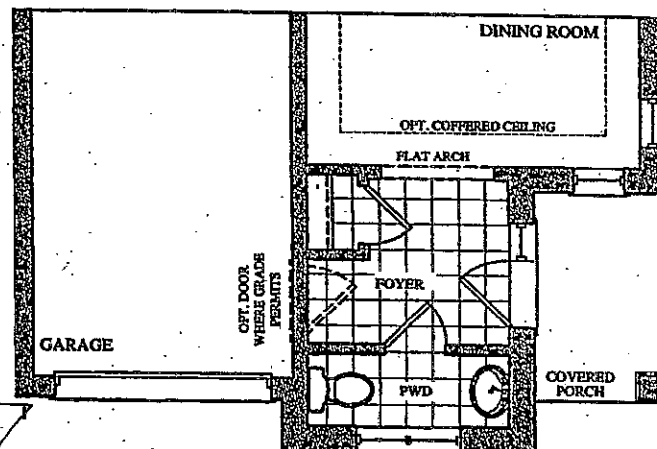

PART. GROUND FLOOR PLAN
ELEV. 'C'

BEZ-23R

JUNE 26 2017




The Siren

SEMI SERIES

Elevation A • 1,688 sq.ft.

Elevation B • 1,677 sq.ft.

→ Elevation C • 1,687 sq.ft.

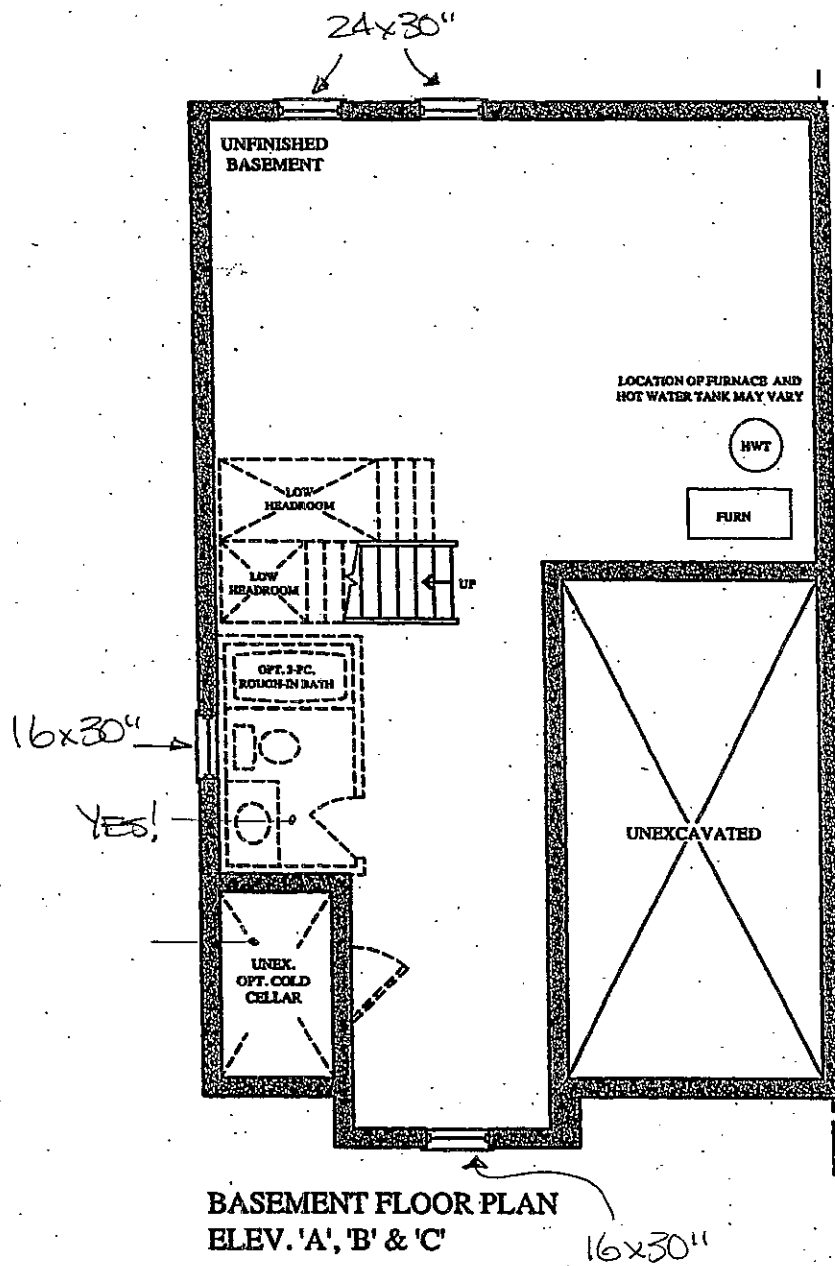

BEZ-232

JUNE 26 2017




The Siren

SEMI SERIES


Elevation A • 1,688 sq.ft.

Elevation B • 1,677 sq.ft.


Elevation C • 1,687 sq.ft.

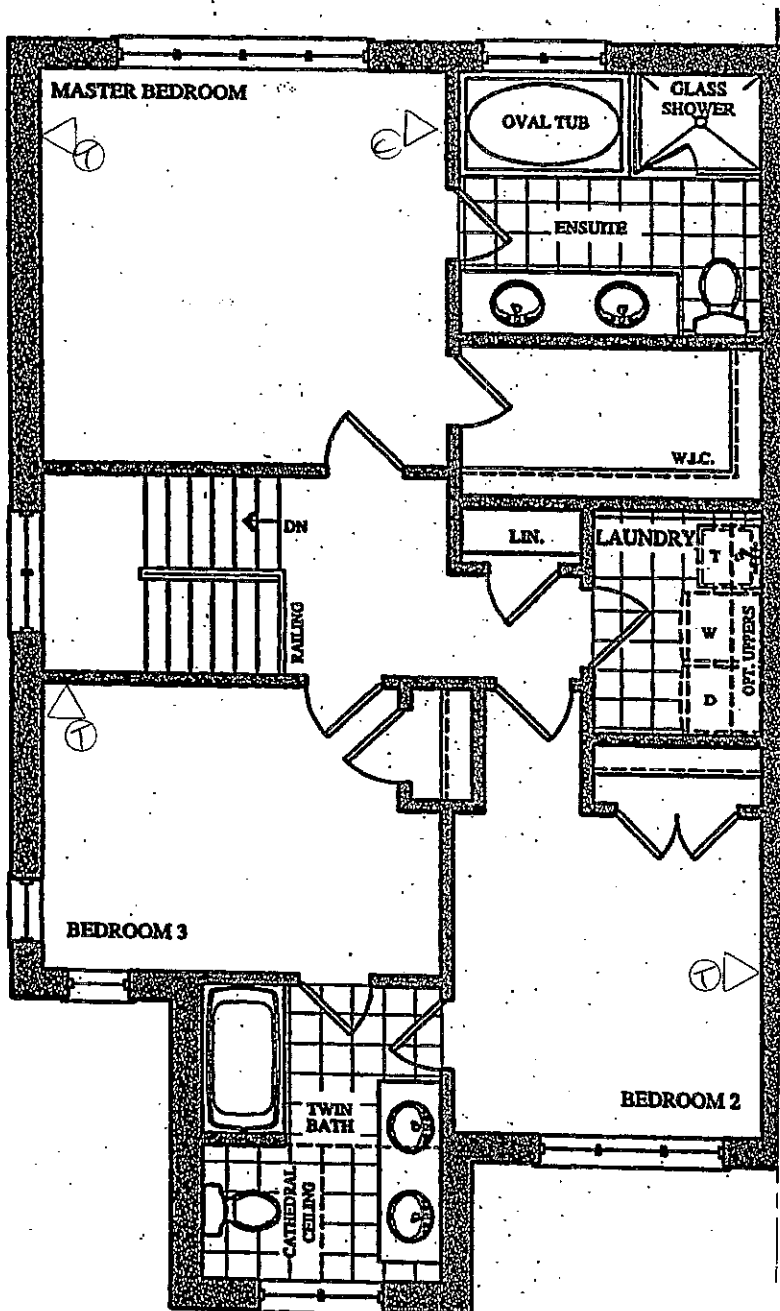

SECOND FLOOR PLAN
ELEV. 'A'

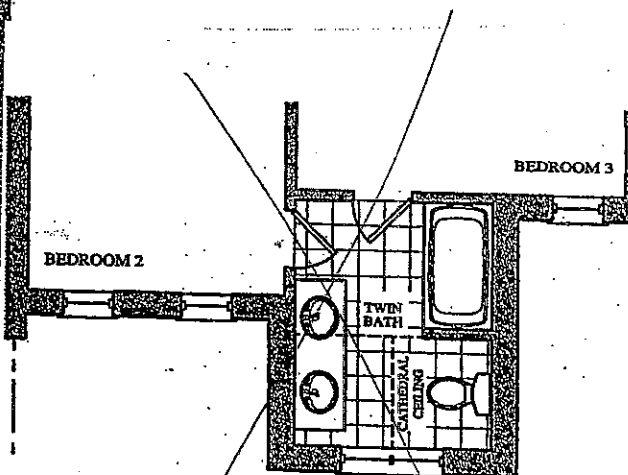

PART. SECOND FLOOR PLA
ELEV. 'B'

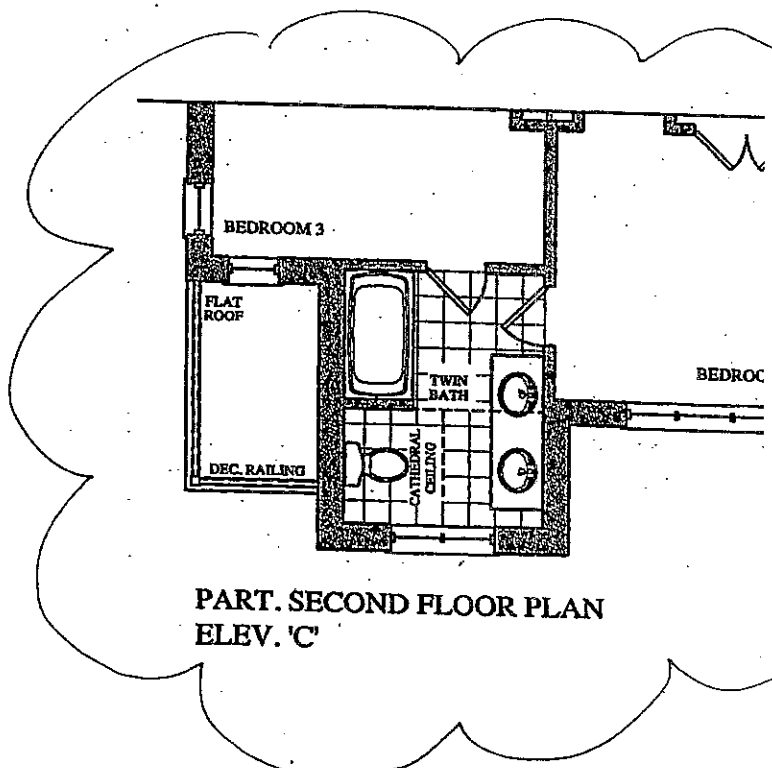

PART. SECOND FLOOR PLAN
ELEV. 'C'