

Brampton Encore - 153 - 2 - 38-4 Elev.A VIVALDI

CENTRAL VAC AND WIRING

Inv.1,501	1 - FAMILY ROOM: INSTALL CONDUIT PIPE- FOR TELEVISION- MUST SPECIFY LOCATION AND TERMINATION POINT
Line23243	Note:
12Jul17 / 30Oct17	
Inv.1,501	1 - TELEPHONE AND CABLE ROUGH-IN LOCATIONS
Line23242	Note:
12Jul17 / 30Oct17	

CONCRETE AND DRAIN

Inv.1,501	1 - BASEMENT: INSTALL ROUGH-IN - 3PC BASEMENT ROUGH-IN
Line23247	Note:
12Jul17 / 30Oct17	

ELECTRICAL

Inv.1,501	1 - FAMILY ROOM: INSTALL 110V WALL RECEPTACLE ON DEDICATED CIRCUIT - ABOVE FIREPLACE FOR FUTURE TV
Line23244	Note:
12Jul17 / 30Oct17	
Inv.1,501	1 - GARAGE: INSTALL 110V WALL RECEPTACLE ON NORMAL CIRCUIT-ON GARAGE CEILING FOR FUTURE GARAGE DOOR OPENER.
Line23245	Note: IN ADDITION TO THE STANDARD RECEPTICLE
12Jul17 / 30Oct17	
Inv.1,501	1 - BASEMENT: INSTALL 200 AMP ELECTRICAL SERVICE
Line23246	Note:
12Jul17 / 30Oct17	

Exterior Colours

Inv.1,501	1 - EXTERIOR COLOUR PACKAGE # 3
Line24549	Note:
12Jul17 / 30Oct17	

FORMING

Inv.1,501	1 - EXTERIOR: INSTALL SIDE DOOR- HOME TO EXTERIOR- AS PER PLAN AND GRADE PERMITTING
Line23248	Note:
12Jul17 / 30Oct17	

FRAMING

Inv.1,501	1 - GARAGE: INSTALL MANDOOR - GARAGE TO HOUSE- AS PER PLAN AND GRADE PERMITTING
Line23249	Note:
12Jul17 / 30Oct17	

MISC.

Inv.1,501	1 - BONUS PACKAGE: \$8215.00 (INCLUDING TAXES) WORTH OF UPGRADES FROM GOLD PARK HOMES DÉCOR CENTRE IS BEING APPLIED TOWARD THE STRUCTURAL APPOINTMENT. PURCHASER HAS A REMAINING AMOUNT OF \$1785.00 (INCLUDING TAXES) TO BE USED TOWARD THE COLOUR APPOINTMENT
Line23252	Note:
12Jul17 / 30Oct17	

Brampton Encore - 153 - 2 - 38-4 Elev.A VIVALDI

Inv.1,501	1 - Purchaser has attended a Structural appointment at the Decor Centre & has DECLINED any additional upgrades and accepts and acknowledges that there will be no further structural changes/additions/deletions to be made upon signing on July 12, 2017.
Line23253	Note:
12Jul17 / 30Oct17	
Inv.1,501	1 - Purchasers are aware & accepts that ANY changes made to upgrades after signing this Purchasers Extra Form are subject to a minimum administration fee of \$500. PLUS a 10% holdback fee
Line23254	Note:
12Jul17 / 30Oct17	

PLUMBING



Inv.1,501	1 - BASEMENT: INSTALL ROUGH-IN - 3PC BASEMENT ROUGH-IN
Line24546	Note:
12Jul17 / 30Oct17	

WINDOWS - BASEMENT

Inv.1,501	4 - BASEMENT: INSTALL FOUR (X4) BASEMENT WINDOWS - UPGRADE EXISTING BASEMENT WINDOW TO 30 INCH X 24 INCH - MAY REQUIRE INSTALLATION OF WINDOW WELL
Line23250	Note:
12Jul17 / 30Oct17	

WINDOWS AND DOORS

Inv.1,501	1 - EXTERIOR: INSTALL SIDE DOOR- HOME TO EXTERIOR- AS PER PLAN AND GRADE PERMITTING
Line24547	Note:
12Jul17 / 30Oct17	
Inv.1,501	1 - GARAGE: INSTALL MANDOOR - GARAGE TO HOUSE- AS PER PLAN AND GRADE PERMITTING
Line24548	Note:
12Jul17 / 30Oct17	

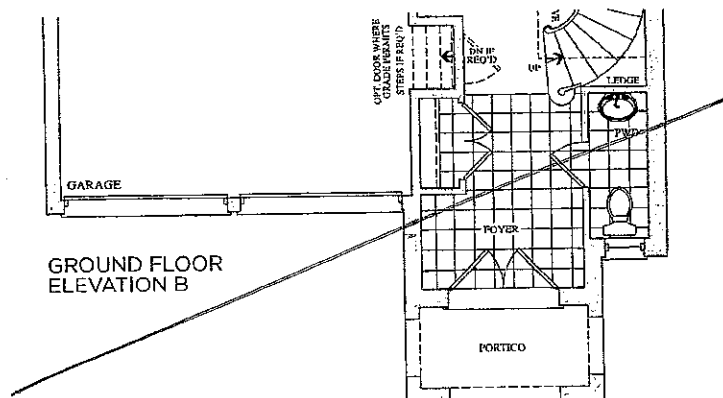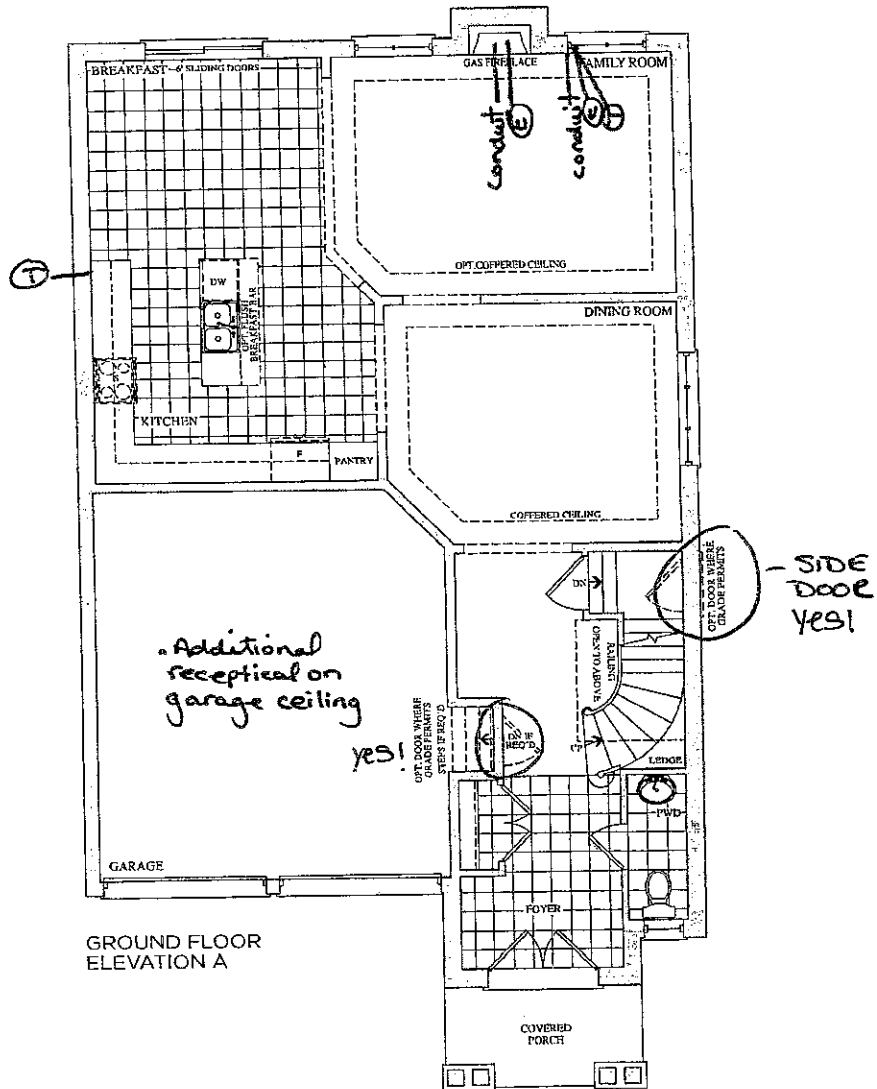

Prices, figures, illustrations, sizes, features and finishes are subject to change without notice. L&O.L. Areas and dimensions are approximate and actual usable floor space may vary from the stated area. Layout may be reverse of the unit purchased. E. & O.E.

GOLDPARK
HOMES



Lot 153
July 12, 17

(G.B.)

Telephone — (T)
Cable — (C)

The
Vivaldi
38' SERIES

Elevation A • 2,518 sq.ft. | Elevation B • 2,518 sq.ft.

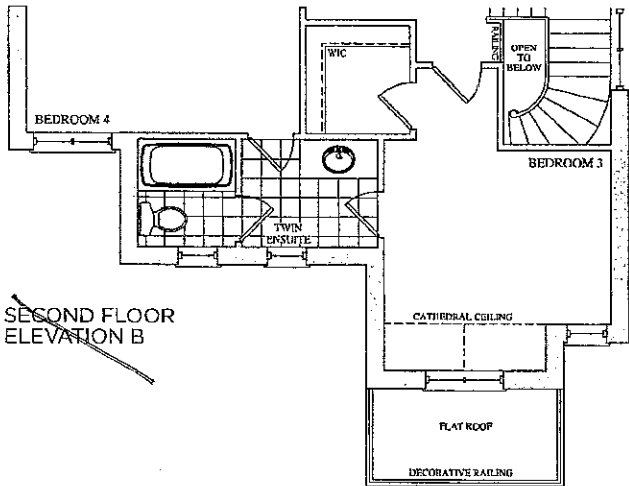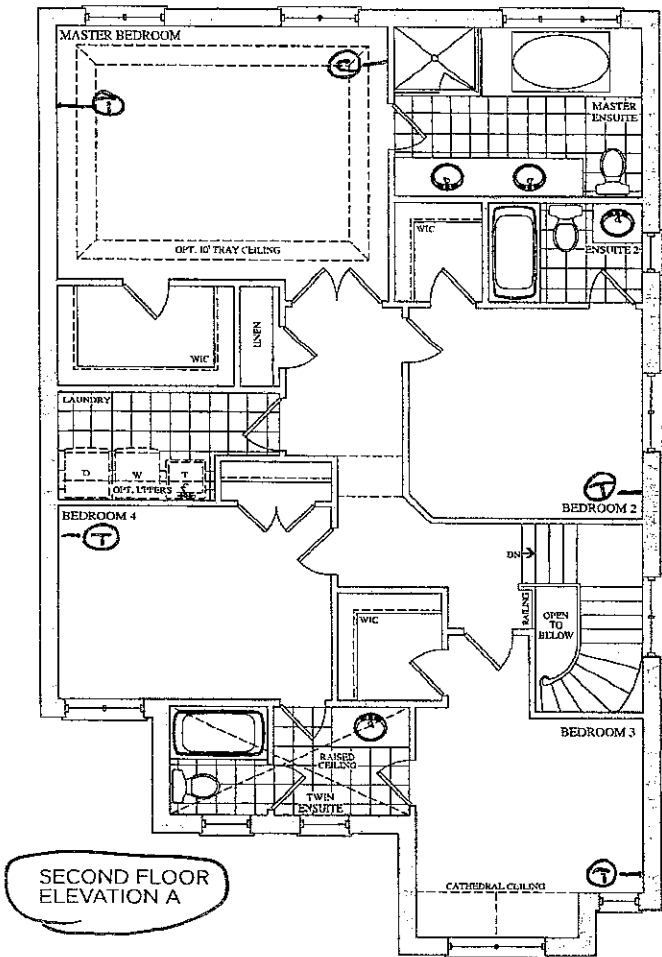

Prices, figures, illustrations, sizes, features and finishes are subject to change without notice. E.&O.E. Areas and dimensions are approximate and actual usable floor space may vary from the stated area. Layout may be reverse of the unit purchased. E. & O.E.

COLDPARK
H O M E S


Lot 153

July 12, 17

(G.B.)

BSMNT WINDOWS

4 x 30" x 24"

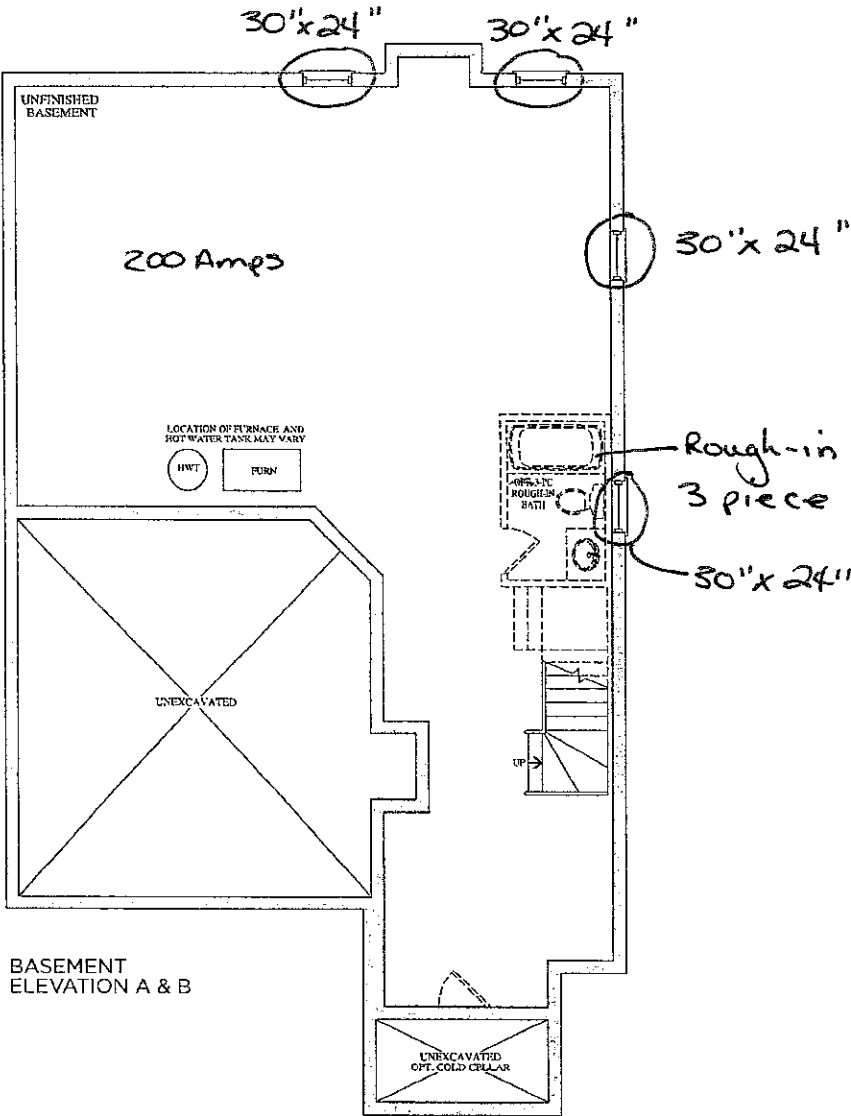

Prices, figures, illustrations, sizes, features and finishes are subject to change without notice. E.&O.E. Areas and dimensions are approximate and actual usable floor space may vary from the stated area. Layout may be reverse of the unit purchased. E. & O.E.

GOLDPARK
HOMES

Lot 153
July 12, 17

67B