

**Brampton Encore - 51R - 2 - 28-2 Elev.C SIREN**  
**CENTRAL VAC AND WIRING**

Inv.1,534	1 - TELEPHONE AND CABLE ROUGH-IN LOCATIONS
Line23635	Note:
30Jul17 / 31Oct17	

**CONCRETE AND DRAIN**

Inv.1,534	1 - BASEMENT: INSTALL ROUGH-IN - 3PC BASEMENT ROUGH-IN
Line23637	Note:
30Jul17 / 31Oct17	

**DRYWALL**

Inv.1,534	1 - FAMILY ROOM: DELETE FIREPLACE.
DO NOT SUPPLY OR INSTALL FIREPLACE IN FAMILY ROOM. NO CREDIT GIVEN FOR FIREPLACE	
Line24565	Note:
30Jul17 / 31Oct17	

**Exterior Colours**

Inv.1,630	1 - EXTERIOR COLOUR PACKAGE #6
Line24568	Note:
31Oct17 / 31Oct17	

**FIREPLACE**

Inv.1,534	1 - FAMILY ROOM: DELETE FIREPLACE.
DO NOT SUPPLY OR INSTALL FIREPLACE IN FAMILY ROOM. NO CREDIT GIVEN FOR FIREPLACE	
Line23644	Note:
30Jul17 / 31Oct17	

**FORMING**

Inv.1,534	1 - EXTERIOR: INSTALL SIDE DOOR- HOME TO EXTERIOR- AS PER PLAN AND GRADE PERMITTING
Line23640	Note:
30Jul17 / 31Oct17	

**FRAMING**

Inv.1,534	1 - MAIN FLOOR: INSTALL THREE (X3) STANDARD DOOR EXTENDED HEIGHT 96" (PRICE PER DOOR)- GROUND FLOOR 2 STOREY MODELS
Line24561	Note:
30Jul17 / 31Oct17	
Inv.1,534	1 - GARAGE: INSTALL ROUGH-IN MANDOOR EXTENDED HEIGHT 96" (PRICE PER DOOR)- GROUND FLOOR 2 STOREY MODELS- GRADE DOESN'T PERMIT
Line24562	Note:
30Jul17 / 31Oct17	
Inv.1,534	1 - FAMILY ROOM: DELETE FIREPLACE.
DO NOT SUPPLY OR INSTALL FIREPLACE IN FAMILY ROOM. NO CREDIT GIVEN FOR FIREPLACE	
Line24564	Note:
30Jul17 / 31Oct17	

**HVAC**

**Brampton Encore - 51R - 2 - 28-2 Elev.C SIREN**

Inv.1,534	1 - FAMILY ROOM: DELETE FIREPLACE.
	DO NOT SUPPLY OR INSTALL FIREPLACE IN FAMILY ROOM. NO CREDIT GIVEN FOR FIREPLACE
Line24566	Note:
30Jul17 / 31Oct17	

**INTERIOR TRIM AND DOORS**

Inv.1,534	3 - MAIN FLOOR: INSTALL THREE (X3) STANDARD DOOR EXTENDED HEIGHT 96" (PRICE PER DOOR)- GROUND FLOOR 2 STOREY MODELS
Line23638	Note:
30Jul17 / 31Oct17	

**MISC.**

Inv.1,534	1 - REFUND- GARAGE: INSTALL STANDARD MANDOOR EXTENDED HEIGHT 96" (PRICE PER DOOR)- GROUND FLOOR 2 STOREY MODELS
Line23639	Note:
30Jul17 / 31Oct17	

Inv.1,534	1 - BONUS PACKAGE: \$5,000.00 (INCLUDING TAXES) WORTH OF UPGRADES FROM GOLD PARK HOMES DÉCOR CENTRE IS BEING APPLIED TOWARD THE STRUCTURAL APPOINTMENT. PURCHASER HAS A REMAINING AMOUNT OF \$00 (INCLUDING TAXES) TO BE USED TOWARD THE COLOUR APPOINTMENT
Line23641	Note:
30Jul17 / 31Oct17	

Inv.1,534	1 - Purchaser has attended a Structural appointment at the Decor Centre & has DECLINED any additional upgrades and accepts and acknowledges that there will be no further structural changes/additions/deletions to be made upon signing on July 31, 2017
Line23642	Note:
30Jul17 / 31Oct17	

Inv.1,534	1 - Purchasers are aware & accepts that ANY changes made to upgrades after signing this Purchasers Extra Form are subject to a minimum administration fee of \$500. PLUS a 10% holdback fee
Line23643	Note:
30Jul17 / 31Oct17	

**WINDOWS - BASEMENT**

Inv.1,534	3 - BASEMENT: INSTALL THREE (X3) BASEMENT WINDOWS - UPGRADE EXISTING BASEMENT WINDOW TO 30 INCH X 24 INCH - MAY REQUIRE INSTALLATION OF WINDOW WELL
Line23636	Note:
30Jul17 / 31Oct17	

**WINDOWS AND DOORS**

Inv.1,534	1 - EXTERIOR: INSTALL SIDE DOOR- HOME TO EXTERIOR- AS PER PLAN AND GRADE PERMITTING
Line24563	Note:
30Jul17 / 31Oct17	

Telephone — (T)

Cable — (C)


# The Siren

## SEMI SERIES

Elevation A • 1,688 sq.ft.


Elevation B • 1,677 sq.ft.

Elevation C • 1,687 sq.ft.

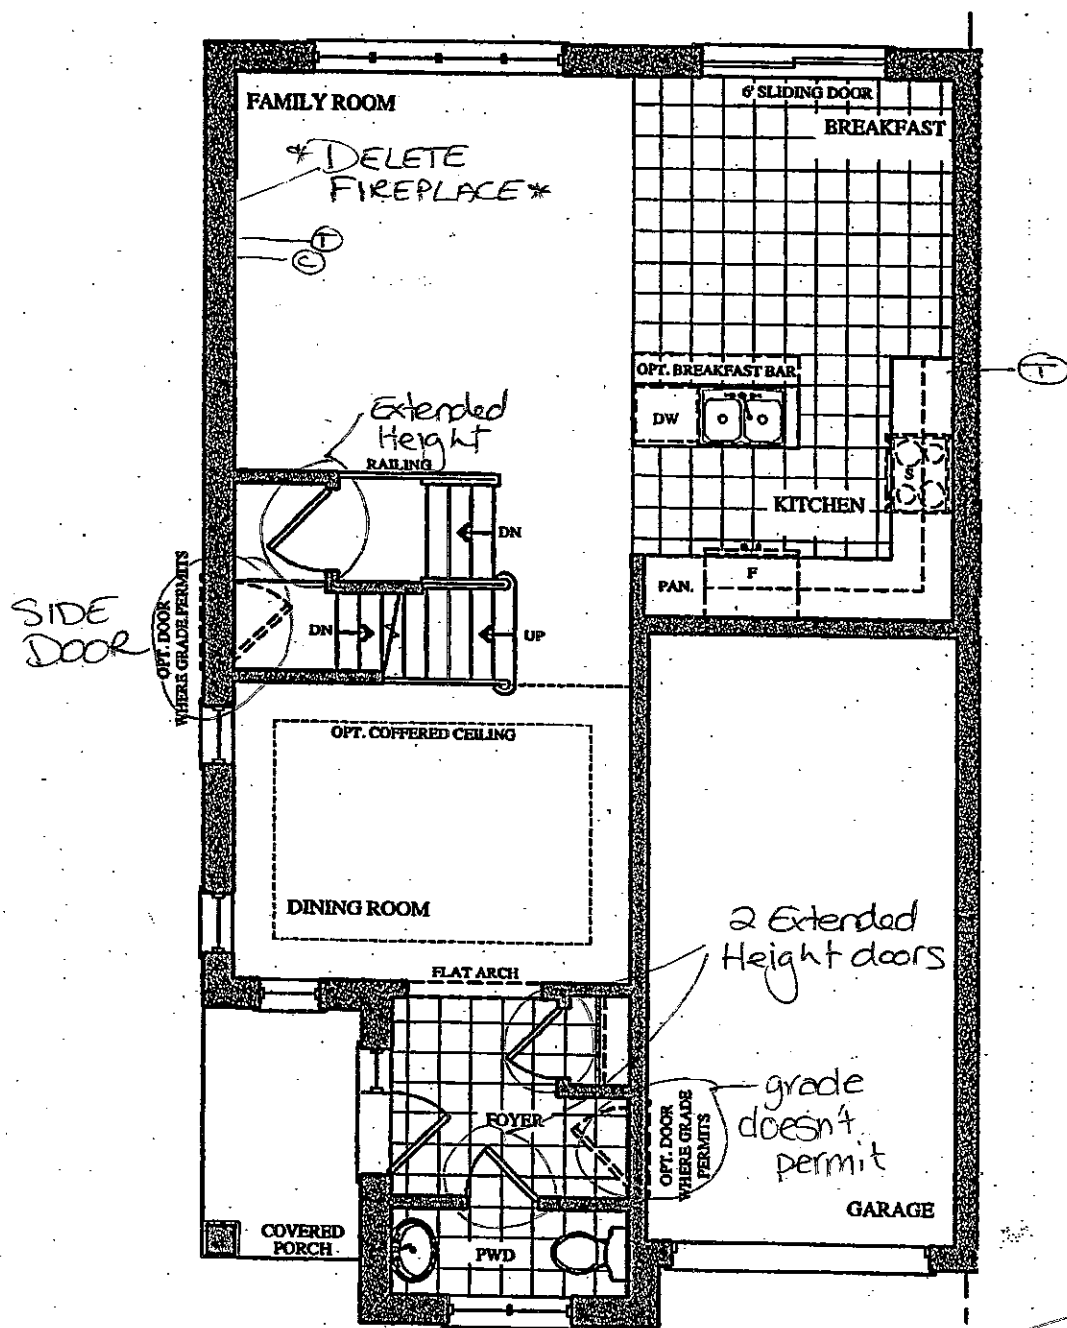

GROUND FLOOR PLAN  
ELEV. A & B

Lot 51R  
July 31, 17

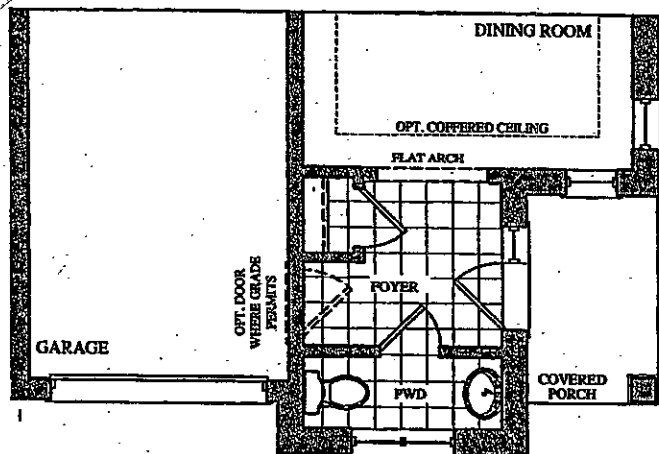


PART. GROUND FLOOR PLAN  
ELEV. C

Telephone — (T)  
 Cable — (C)


# The Siren

## SEMI SERIES

Elevation A • 1,688 sq.ft.  
 Elevation B • 1,677 sq.ft.  
 Elevation C • 1,687 sq.ft.

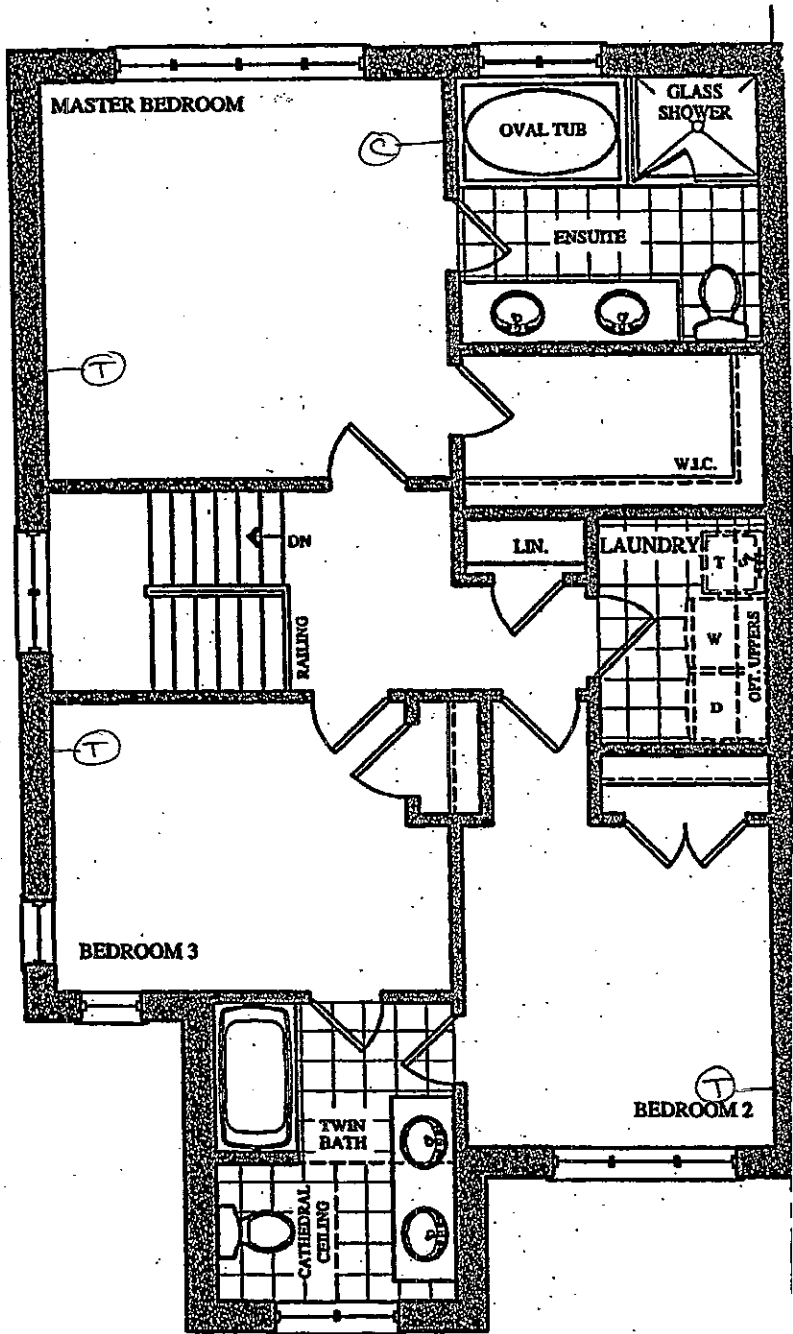


SECOND FLOOR PLAN  
 ELEV. 'A'

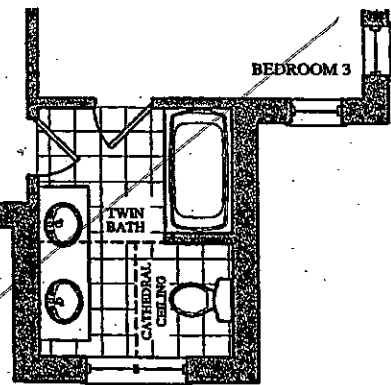

PART. SECOND FLOOR PLAN  
 ELEV. 'B'

Lot 51R  
 July 31, 17

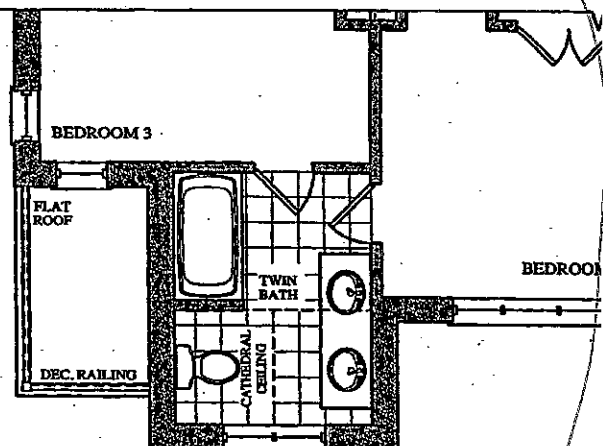


PART. SECOND FLOOR PLAN  
 ELEV. 'C'

The  
Siren  
SEMI SERIES

Elevation A • 1,688 sq.ft.  
Elevation B • 1,677 sq.ft.  
Elevation C • 1,687 sq.ft.

BSMNT WINDOWS  
3x 30"x24"

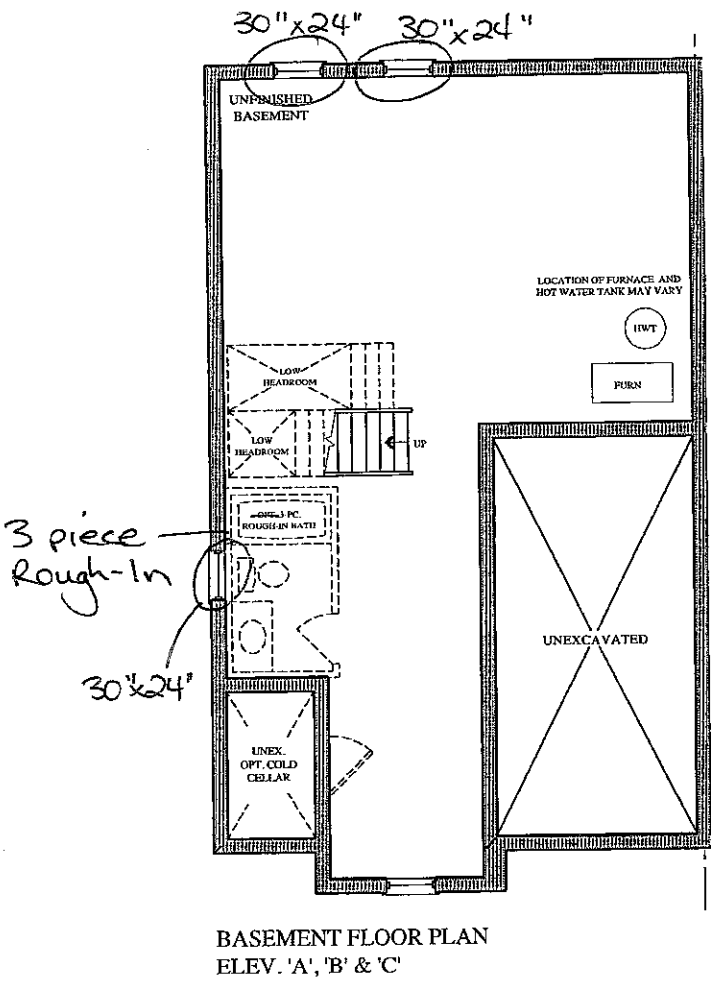

Prices, figures, illustrations, sizes, features and finishes are subject to change without notice. Areas and dimensions are approximate and actual usable floor space may vary from the stated area. Layout may be reverse of the unit purchased. E. & O.E.

GOLDPARK  
WORTH MORE™

Lot 51R

July 31, 17



Telephone — ①

Cable — ②


# The Siren

## SEMI SERIES

Elevation A • 1,688 sq.ft.

Elevation B • 1,677 sq.ft.


Elevation C • 1,687 sq.ft.

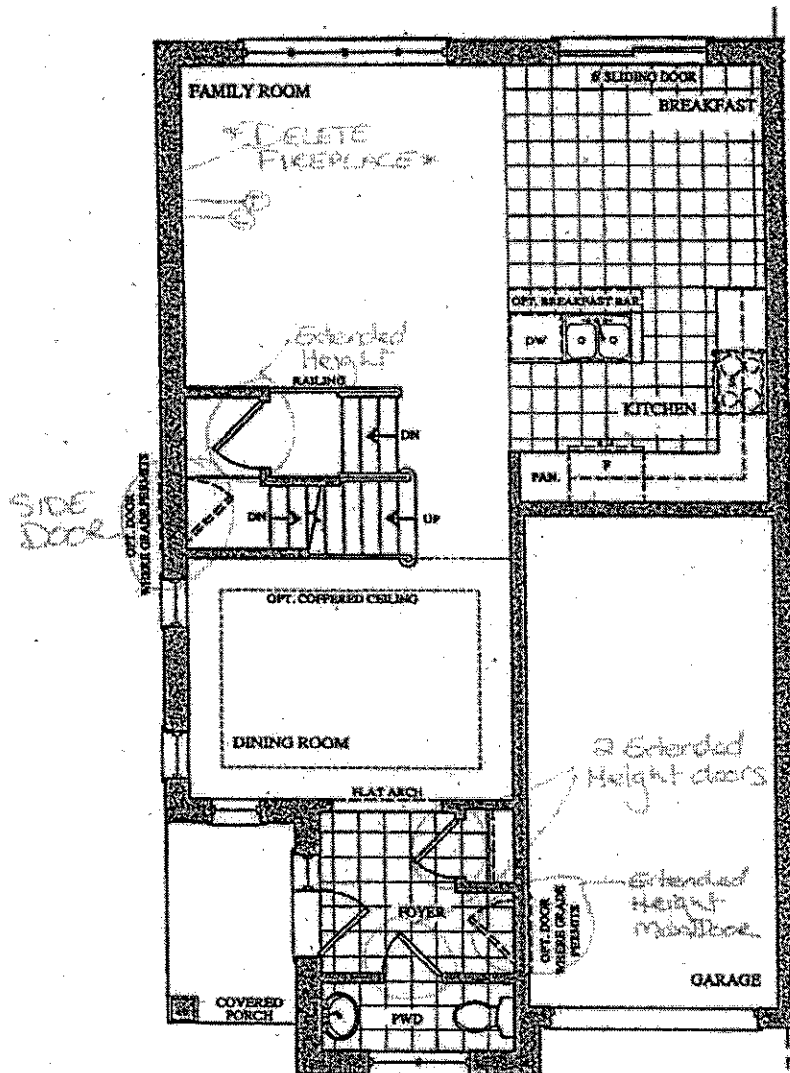

GROUND FLOOR PLAN  
ELEV. A & B

Ref SIR  
July 31, 17

fw

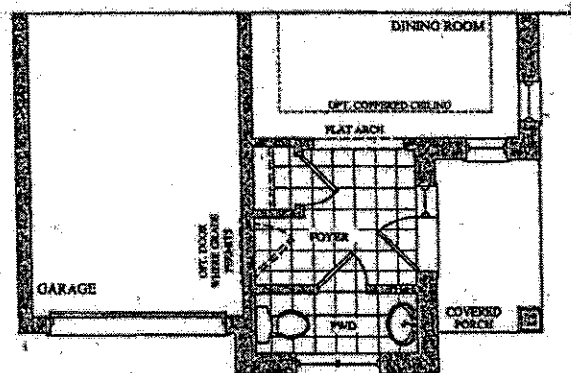


PART. GROUND FLOOR PLAN  
ELEV. C



BSMART WINDOWS  
3x 30" x 24"

The  
**Siren**  
SEMI SERIES  
Elevation A • 1,688 sq.ft.  
Elevation B • 1,677 sq.ft.  
Elevation C • 1,687 sq.ft.

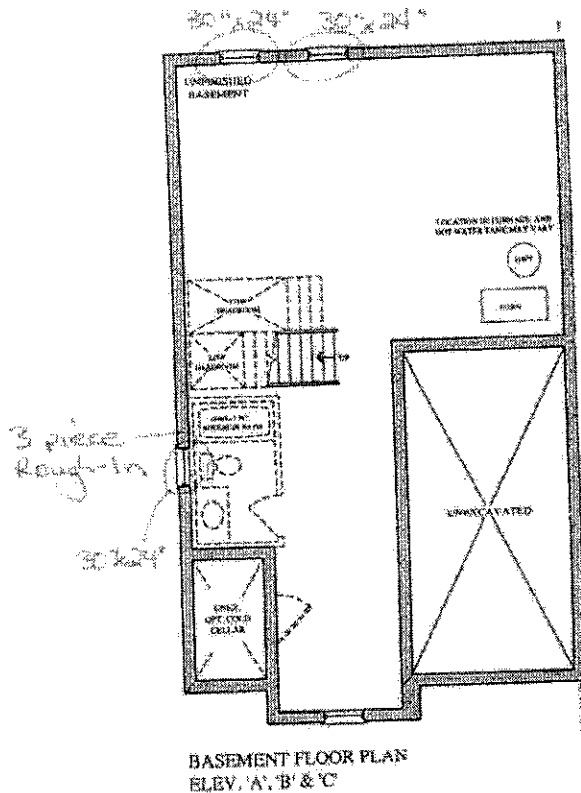

Prices, figures, illustrations, sizes, features and finishes are subject to change without notice. Areas and dimensions are approximate and actual usable floor space may vary from the stated area. Layout may be reverse of the unit purchased. E. & O.E.

**GOLDPARK**  
WORTH MORE™

Not SIR

July 31, 17

FW