

Brampton Encore - 13R - 2 - 28-3 Elev.D Bruckner

Exterior Colours

Inv.1,452	1 - EXTERIOR COLOUR PACKAGE # 4
Line24233	Note:
22Jun17 / 27Sep17	

FRAMING

Inv.1,589	3 - TALLER MAIN FLOOR ARCHES
Line24234	Note:
27Sep17 / 27Sep17	
Inv.1,618	1 - **NOTE:: FRAME MAIN FLOOR DOORS AT 96" - ADDED WITH THE ADDITION OF TALLER INTERIOR DOORS **INCLUDING GARAGE TO HOUSE DOOR**
Line24428	Note:
12Oct17 / 31Oct17	

INTERIOR TRIM AND DOORS

Inv.1,452	2 - MAIN FLOOR: EXTENDED HEIGHT ARCHWAY (PRICE PER DOORWAY) -96" ARCHWAYS
Line22728	Note:
22Jun17 / 27Sep17	
Inv.1,589	1 - MISSED ARCH ON PE:1452
Line24235	Note:
27Sep17 / 27Sep17	
Inv.1,618	4 - MAIN FLOOR: STANDARD DOOR EXTENDED HEIGHT 96" (PRICE PER DOOR)- GROUND FLOOR 2 STOREY MODELS
Line24429	Note:
12Oct17 / 31Oct17	

MISC.

Inv.1,452	1 - Purchaser has attended an appointment at the Decor Centre & has DECLINED any additional upgrades and accepts and acknowledges that there will be no further changes/additions/deletions to be made upon signing on June 22 2017.
Line22729	Note:
22Jun17 / 27Sep17	
Inv.1,452	1 - Purchasers are aware & accepts that ANY changes made to upgrades after signing this Purchasers Extra Form are subject to a minimum administration fee of \$500. PLUS a 10% holdback fee.
Line22730	Note:
22Jun17 / 27Sep17	
Inv.1,452	1 - BONUS PACKAGE: \$5,000.00 (INCLUDING TAXES) WORTH OF UPGRADES FROM GOLD PARK HOMES DÉCOR CENTRE IS BEING APPLIED TOWARD THE STRUCTURAL APPOINTMENT. PURCHASER HAS A REMAINING AMOUNT OF \$3666.60 (INCLUDING TAXES) TO BE USED TOWARD THE COLOUR APPOINTMENT.
Line22731	Note:
22Jun17 / 27Sep17	
Inv.1,589	1 - BONUS PACKAGE: (\$3666.60) REMAINING LESS THIS NEW INVOICE \$330.00. PURCHASER HAS A NEW AMOUNT REMAINING OF \$3336.60
Line24236	Note:
27Sep17 / 27Sep17	

WINDOWS - BASEMENT

Brampton Encore - 13R - 2 - 28-3 Elev.D Bruckner

Inv.1,452	2 - BASEMENT WINDOWS - UPGRADE EXISTING BASEMENT WINDOW TO 30 INCH X 24 INCH - MAY REQUIRE INSTALLATION OF WINDOW WELL
Line22726	Note:
22Jun17 / 27Sep17	
Inv.1,618	4 - BASEMENT WINDOWS: LIGHT COLOURED WINDOW FRAMES (TO MATCH REST OF HOUSE)
Line24427	Note:
12Oct17 / 31Oct17	
Inv.1,618	1 - **DELETE** ITEM 2 FROM PE #1452 'DARK COLOURED FRAME PREMIUM
Line24426	Note:
12Oct17 / 31Oct17	
Inv.1,618	1 - BASEMENT WINDOWS - UPGRADE EXISTING BASEMENT WINDOW TO 30 INCH X 24 INCH - MAY REQUIRE INSTALLATION OF WINDOW WELL
Line24431	Note:
12Oct17 / 31Oct17	

WINDOWS AND DOORS


Inv.1,452	1 - INSTALL MANDOOR- GARAGE TO HOUSE
Line24232	Note:
22Jun17 / 27Sep17	
Inv.1,618	1 - DOOR FROM HOUSE TO GARAGE: UPGRADE MANDOOR TO 96"
Line24430	Note:
12Oct17 / 31Oct17	

encore
GRAMPTON

BE2-13R
JUNE 22 2017 BP
BE2-13R
OCT. 16 2017 (BP)

The Bruckner SEMI SERIES


Elevation A • 1,766 sq.ft.
Elevation B • 1,787 sq.ft.
Elevation C • 1,795 sq.ft.
Elevation D • 1,782 sq.ft.

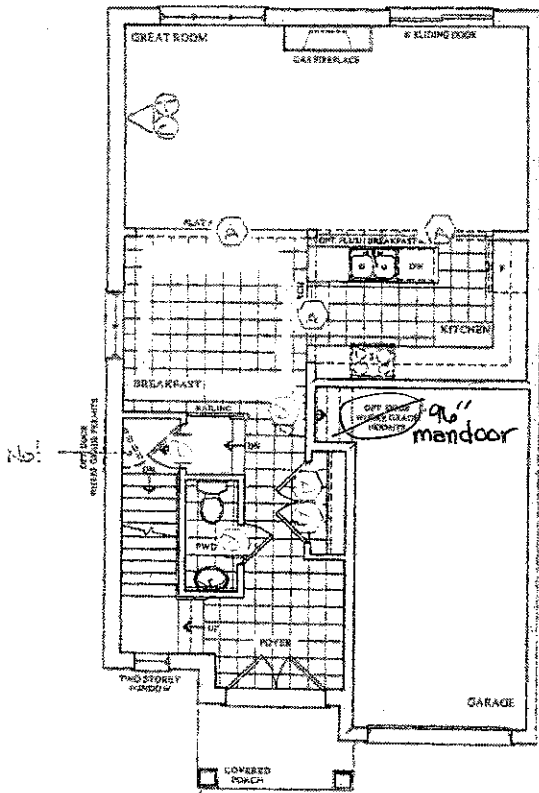

GROUND FLOOR PLAN
ELEV. A & B

No phone
in kitchen!

- LEGEND
- △ Phone
 - △ Case
 - △ 96" Arch
 - △ 96" Door

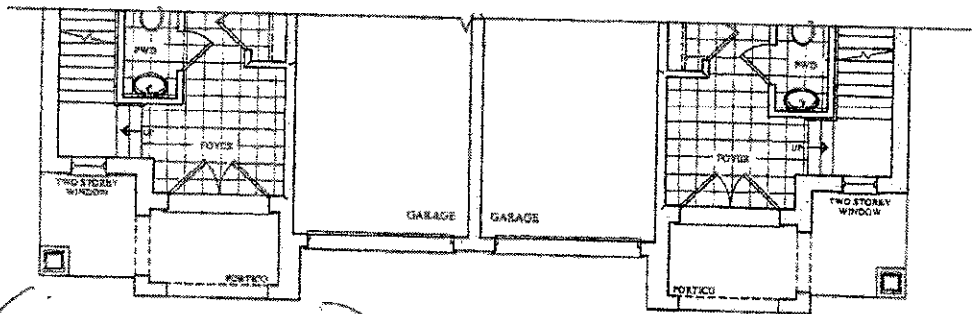

PART. GROUND FLOOR PLAN
ELEV. C & D

Prices, figures, illustrations, sizes, features and finishes are subject to change without notice. Areas and dimensions are approximate and actual usable floor space may vary from the stated area. Layout may be reverse of the unit purchased. E & D.


GOLD PARK
WORTH MORE

encore
BRAMPTON


BEZ-13R
JUNE 22 2017 BP
BEZ-13R
OCT. 16 2017 (BP)

The Bruckner SEMI SERIES


Elevation A • 1,766 sq.ft.
Elevation B • 1,787 sq.ft.
Elevation C • 1,795 sq.ft.
Elevation D • 1,782 sq.ft.

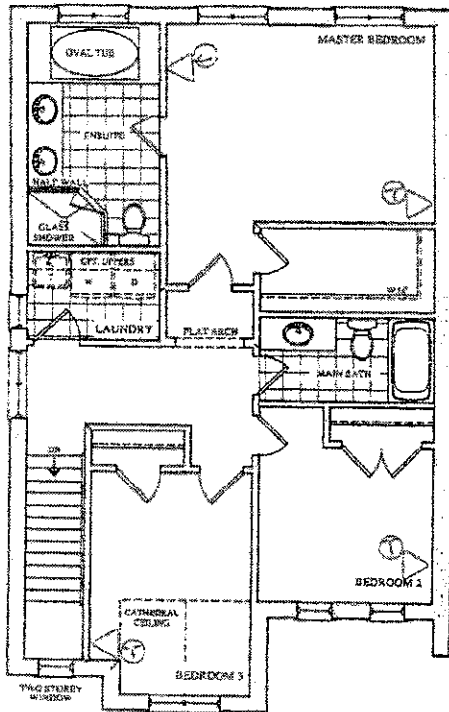


SECOND FLOOR PLAN
ELEV. 'A'

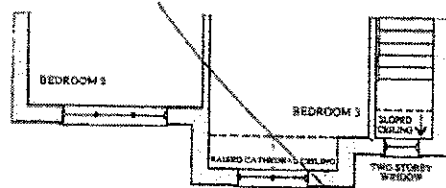

PART. SECOND FLOOR PLAN
ELEV. 'B'

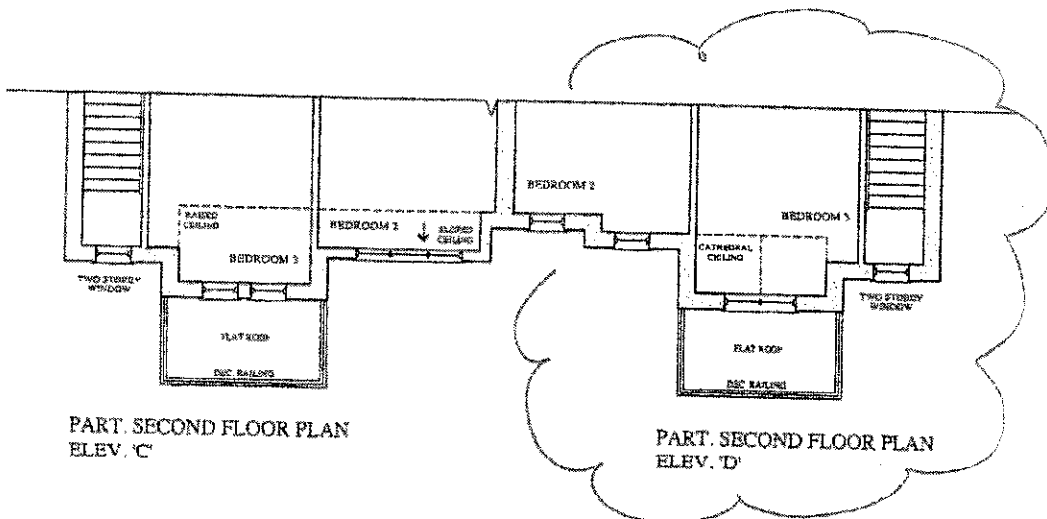

PART. SECOND FLOOR PLAN
ELEV. 'C'

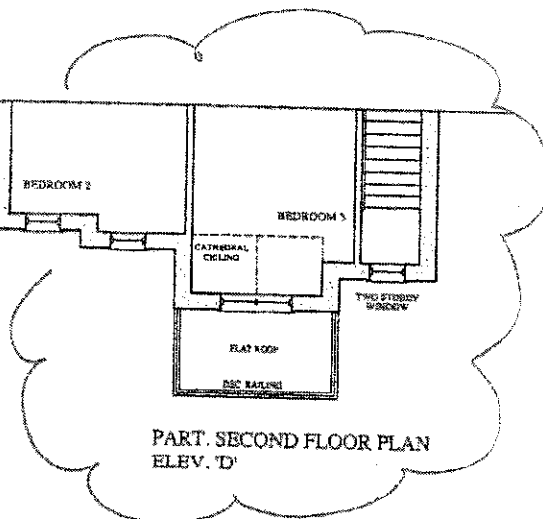

PART. SECOND FLOOR PLAN
ELEV. 'D'

Prices, figures, illustrations, sizes, features and finishes are subject to change without notice. Areas and dimensions are approximate and actual usable floor space may vary from the stated area. Layouts may be reverse of the unit purchased. E & C.E.

GOLD PARK
WORTH MORE™


encore
BRAMPTON

BE2-13R BP
JUNE 22 2017

BE2-13R BP
OCT. 16 2017


The Bruckner SEMI SERIES

Elevation A • 1,766 sq.ft.
Elevation B • 1,787 sq.ft.
Elevation C • 1,795 sq.ft.
Elevation D • 1,782 sq.ft.

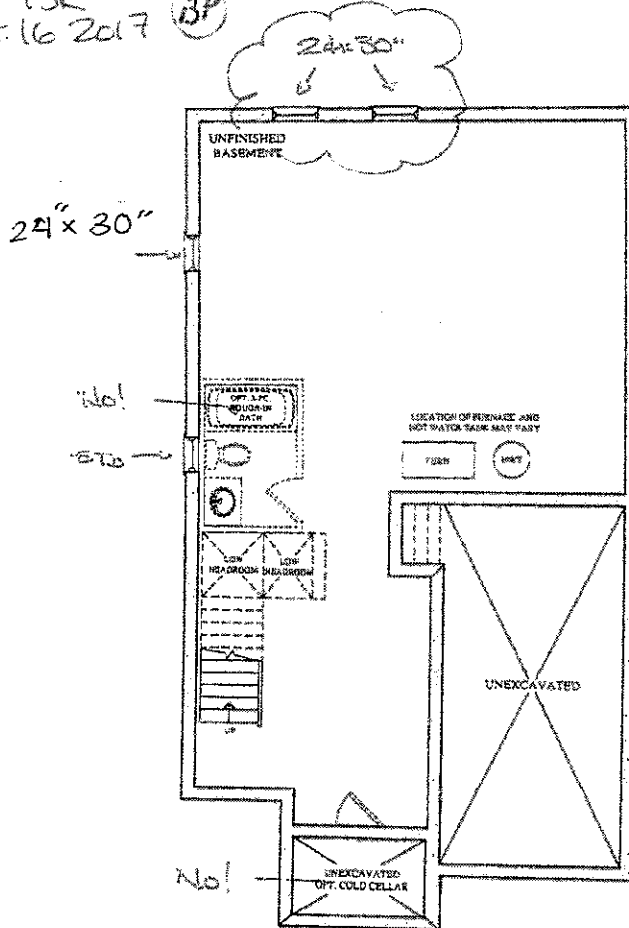

* ALL EXISTING
windows to
be coloured

BASEMENT FLOOR PLAN
ELEV. A & B

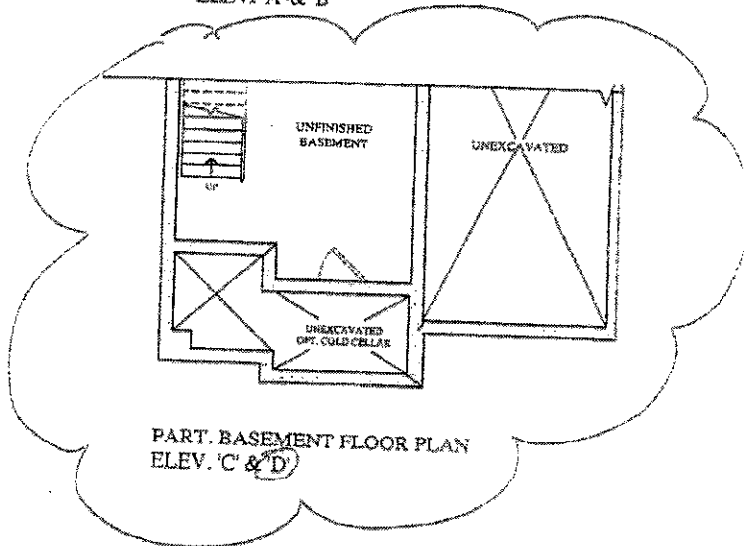

PART. BASEMENT FLOOR PLAN
ELEV. C & D

Prices, figures, illustrations, sizes, features and finishes are subject to change without notice. Areas and dimensions are approximate and actual usable floor space may vary from the stated area. Layout may be reverse of the unit purchased. E & D E

GOLD PARK
WORTH MORE™