

Brampton Encore - 4R - 2 - 28-2 Elev.CR SIREN

CENTRAL VAC AND WIRING

Inv.1,456	1 - FAMILY ROOM: CONDUIT PIPE- FOR TELEVISION- LOCATE APPROX. 66" A.F.F., TERMINATING BY CABLE
Line22773	Note:
26Jun17 / 16Nov17	

CONCRETE AND DRAIN

Inv.1,456	1 - ROUGH-IN - 3PC BASEMENT ROUGH-IN
Line22776	Note:
26Jun17 / 16Nov17	

ELECTRICAL

Inv.1,456	1 - KITCHEN: RELOCATE STANDARD CEILING LIGHT TO ABOVE ISLAND. SEE PLAN FOR LOCATION.
Line22770	Note:
26Jun17 / 16Nov17	

Inv.1,456	1 - KITCHEN: ROUGH - IN CEILING OUTLET ON SAME SWITCH - DOES NOT INCLUDE FIXTURE - LOCATE ABOVE ISLAND, USE SAME SWITCH AS STANDARD LIGHT.
Line22772	Note:
26Jun17 / 16Nov17	

Inv.1,456	1 - FAMILY ROOM: 110V WALL RECEPTACLE ON NORMAL CIRCUIT- LOCATE APPROX. 66" A.F.F. ABOVE FIREPLACE
Line22774	Note:
26Jun17 / 16Nov17	

Inv.1,456	1 - KITCHEN: GAS LINE ROUGH - 2ND FLOOR- (2-STOREY MODELS) INCLUDES 110v ELECTRICAL
Line24409	Note:
26Jun17 / 16Nov17	

Exterior Colours

Inv.1,456	1 - EXTERIOR COLOUR PACKAGE 4
Line24412	Note:
26Jun17 / 16Nov17	

FORMING

Inv.1,456	1 - SIDE DOOR- HOME TO EXTERIOR- AS PER PLAN AND GRADE PERMITTING
Line22775	Note:
26Jun17 / 16Nov17	

FRAMING

Inv.1,456	1 - KITCHEN: UPGRADE VENTING FOR STOVE TO 8" PIPE EXTERIOR WALL
Line24410	Note:
26Jun17 / 16Nov17	

HVAC

Inv.1,456	1 - KITCHEN: UPGRADE VENTING FOR STOVE TO 8" PIPE EXTERIOR WALL
Line22769	Note:
26Jun17 / 16Nov17	

MISC.

Brampton Encore - 4R - 2 - 28-2 Elev.CR SIREN

Inv.1,456	1 - Purchaser has attended an appointment at the Decor Centre & has DECLINED any additional upgrades and accepts and acknowledges that there will be no further changes/additions/deletions to be made upon signing on June 26 2017.
Line22780	Note:
26Jun17 / 16Nov17	
Inv.1,456	1 - Purchasers are aware & accepts that ANY changes made to upgrades after signing this Purchasers Extra Form are subject to a minimum administration fee of \$500. PLUS a 10% holdback fee.
Line22781	Note:
26Jun17 / 16Nov17	
Inv.1,456	1 - BONUS PACKAGE: \$5,000.00 (INCLUDING TAXES) WORTH OF UPGRADES FROM GOLD PARK HOMES DÉCOR CENTRE IS BEING APPLIED TOWARD THE STRUCTURAL APPOINTMENT. PURCHASER HAS A REMAINING AMOUNT OF \$00 (INCLUDING TAXES) TO BE USED TOWARD THE COLOUR APPOINTMENT.
Line22782	Note:
26Jun17 / 16Nov17	

WINDOWS - BASEMENT

Inv.1,456	2 - BASEMENT WINDOWS - UPGRADE EXISTING BASEMENT WINDOW TO 30 INCH X 24 INCH - MAY REQUIRE INSTALLATION OF WINDOW WELL
Line22777	Note:
26Jun17 / 16Nov17	
Inv.1,456	2 - BASEMENT WINDOWS - UPGRADE EXISTING BASEMENT WINDOW TO 30 INCH X 16 INCH
Line22778	Note:
26Jun17 / 16Nov17	

WINDOWS AND DOORS

Inv.1,456	1 - SIDE DOOR- HOME TO EXTERIOR- AS PER PLAN AND GRADE PERMITTING
Line24411	Note:
26Jun17 / 16Nov17	

Brampton Encore - 14L - 2 - Unknown

CONCRETE AND DRAIN

Inv.1,635	1 - ROUGH-IN - 3PC BASEMENT ROUGH-IN
Line24686	Note:
16Nov17 / 16Nov17	

ELECTRICAL

Inv.1,635	1 - LIVING ROOM- ROUGH - IN CEILING OUTLET ON SAME SWITCH - DOES NOT INCLUDE FIXTURE - MUST SPECIFY LOCATION
Line24681	Note:
16Nov17 / 16Nov17	

Exterior Colours

Inv.1,635	1 - EXTERIOR COLOUR PACKAGE # 8
Line24687	Note:
16Nov17 / 16Nov17	

FORMING

Inv.1,635	1 - COLD CELLAR
Line24685	Note:
16Nov17 / 16Nov17	

FRAMING

Inv.1,635	1 - MANDOOR- GARAGE TO HOUSE- GRADE PERMITTING
Line24682	Note:
16Nov17 / 16Nov17	

WINDOWS - BASEMENT

Inv.1,635	3 - UPG- 3 BASEMENT WINDOWS 30" X 16"- SEE FLOOR PLAN FOR DETAILS
Line24684	Note:
16Nov17 / 16Nov17	


WINDOWS AND DOORS

Inv.1,635	1 - MANDOOR- GARAGE TO HOUSE- GRADE PERMITTING
Line24683	Note:
16Nov17 / 16Nov17	

BEZ-4R
JUNE 26 2017


The Siren SEMI SERIES

Elevation A • 1,688 sq.ft.
Elevation B • 1,677 sq.ft.
Elevation C • 1,687 sq.ft.

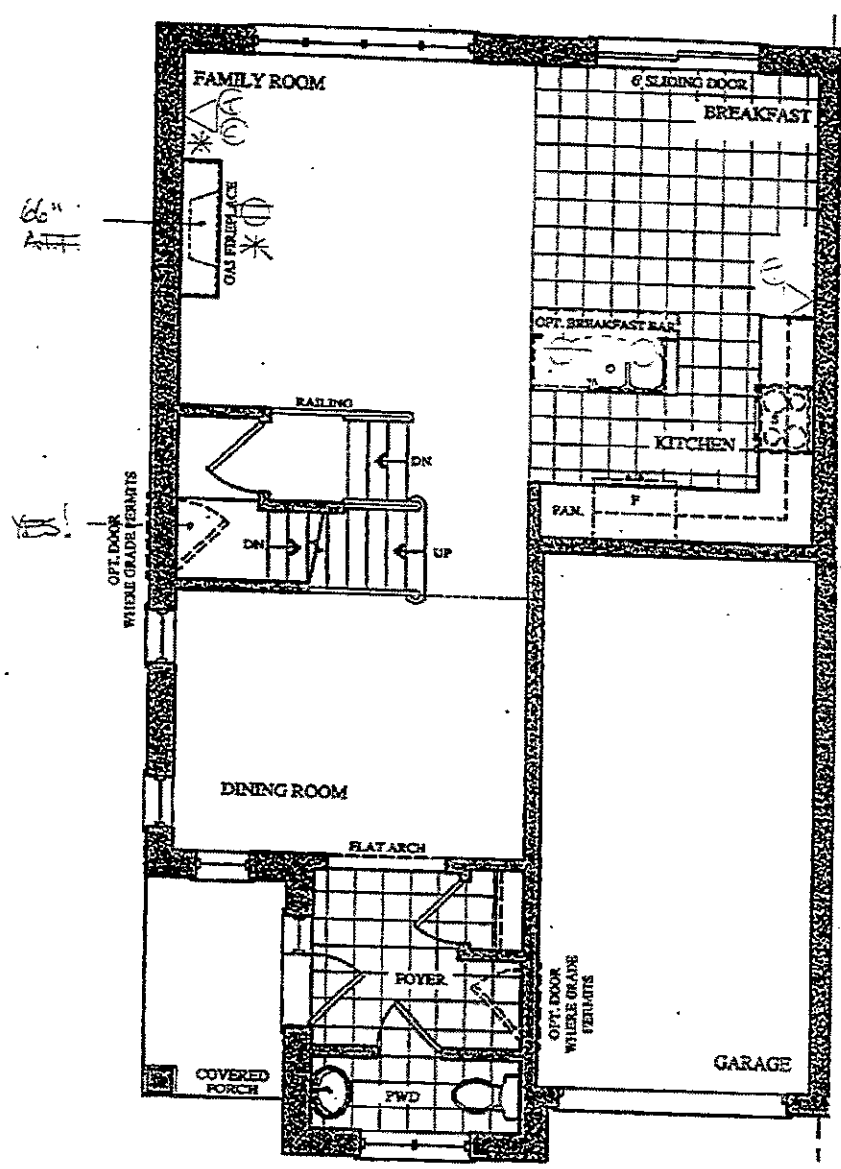

- LEGEND
- STD CEILING LIGHT
 - ⊕ CAPPED CEILING R/IN
 - ⊕ ELECTRICAL OUTLET
 - * CONDUIT
 - △ PLANE
 - ⊙ CABLE

GROUND FLOOR PLAN
ELEV. 'A' & 'B'

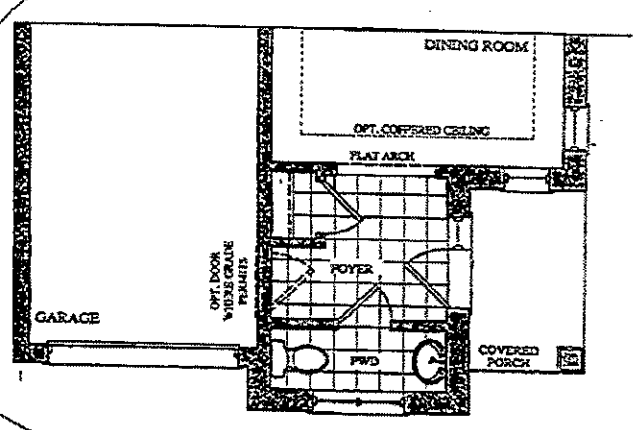


PART. GROUND FLOOR PLAN
ELEV. 'C'

BE2-4R
JUNE 26 2017


The Siren

SEMI SERIES


Elevation A • 1,688 sq.ft.
Elevation B • 1,677 sq.ft.
→ Elevation C • 1,687 sq.ft.

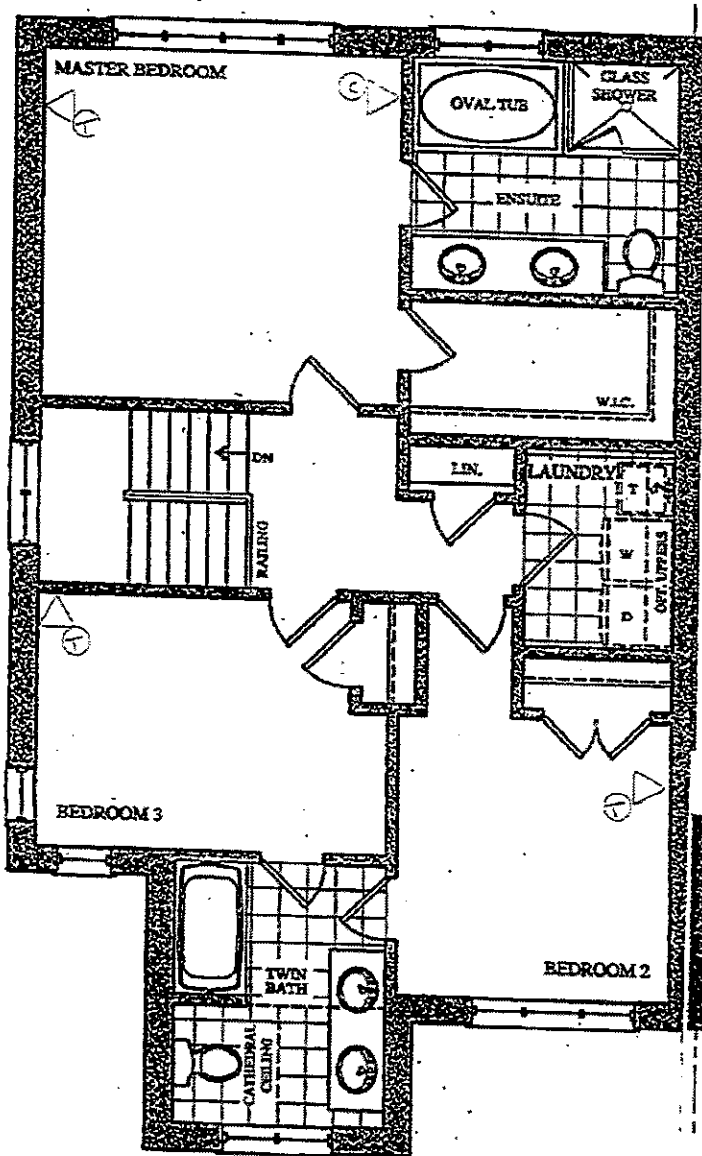

SECOND FLOOR PLAN
ELEV. 'A'

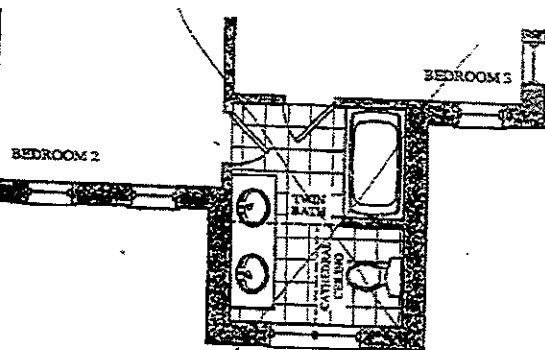

PART. SECOND FLOOR PLAN
ELEV. 'B'

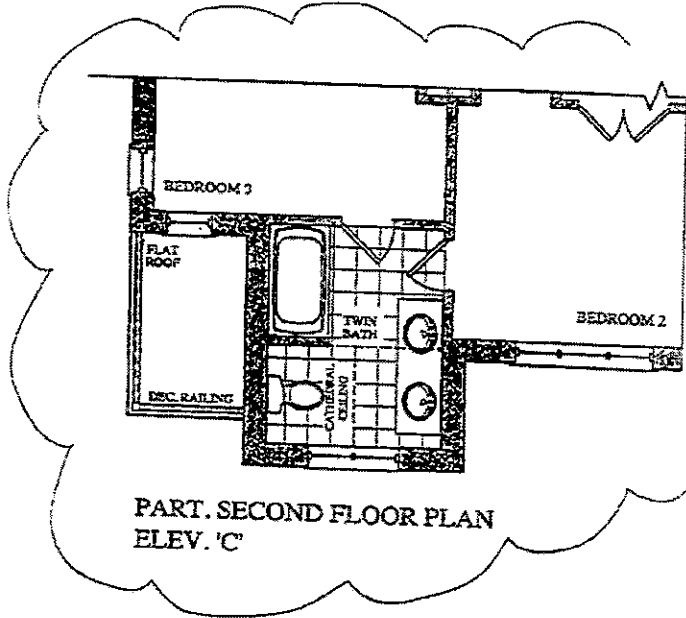

PART. SECOND FLOOR PLAN
ELEV. 'C'

BEZ-4R
JUNE 26 2017

The Siren

SEMI SERIES

Elevation A • 1,688 sq.ft.
Elevation B • 1,677 sq.ft.
→ Elevation C • 1,687 sq.ft.

