



CONSTRUCTION SUMMARY

Brampton Encore - 14L - 2 - 28-4 Elev.A Rossini OPT4

CONCRETE AND DRAIN

Inv.1,635	1 - ROUGH-IN - 3PC BASEMENT ROUGH-IN
Line24686	Note:
16Nov17 / 16Nov17	

ELECTRICAL

Inv.1,635	1 - LIVING ROOM- ROUGH - IN CEILING OUTLET ON SAME SWITCH - DOES NOT INCLUDE FIXTURE - MUST SPECIFY LOCATION
Line24681	Note:
16Nov17 / 16Nov17	

Exterior Colours

Inv.1,635	1 - EXTERIOR COLOUR PACKAGE # 8
Line24687	Note:
16Nov17 / 16Nov17	

FORMING

Inv.1,635	1 - COLD CELLAR
Line24685	Note:
16Nov17 / 16Nov17	

FRAMING

Inv.1,635	1 - MANDOOR- GARAGE TO HOUSE- GRADE PERMITTING
Line24682	Note:
16Nov17 / 16Nov17	

WINDOWS - BASEMENT



Inv.1,635	3 - UPG- 3 BASEMENT WINDOWS 30" X 16"- SEE FLOOR PLAN FOR DETAILS
Line24684	Note:
16Nov17 / 16Nov17	

WINDOWS AND DOORS

Inv.1,635	1 - MANDOOR- GARAGE TO HOUSE- GRADE PERMITTING
Line24683	Note:
16Nov17 / 16Nov17	


The Rossini SEMI SERIES

Elevation A • 1,911 sq.ft.
Elevation B • 1,902 sq.ft.
Elevation C • 1,966 sq.ft.
Elevation D • 1,971 sq.ft.

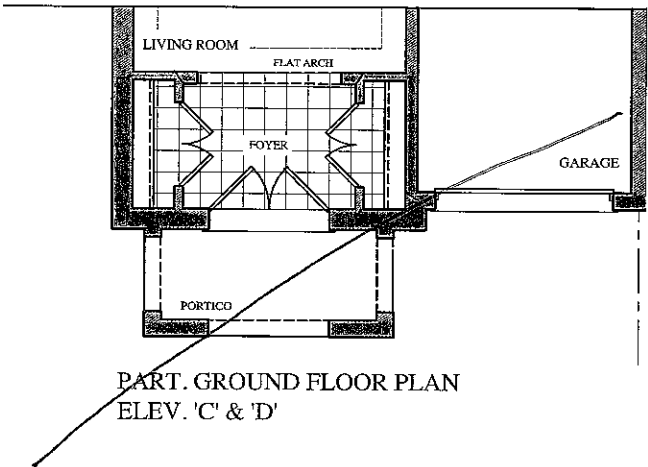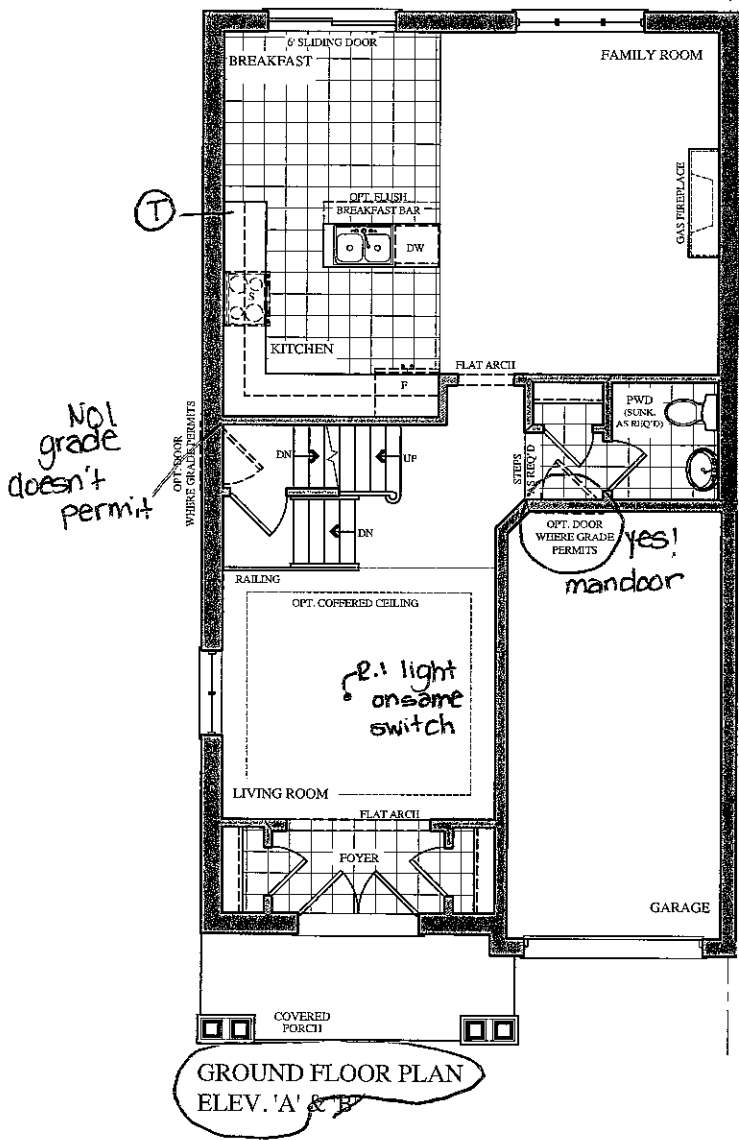


The Rossini SEMI SERIES


Elevation A • 1,911 sq.ft.
Elevation B • 1,902 sq.ft.
Elevation C • 1,966 sq.ft.
Elevation D • 1,971 sq.ft.

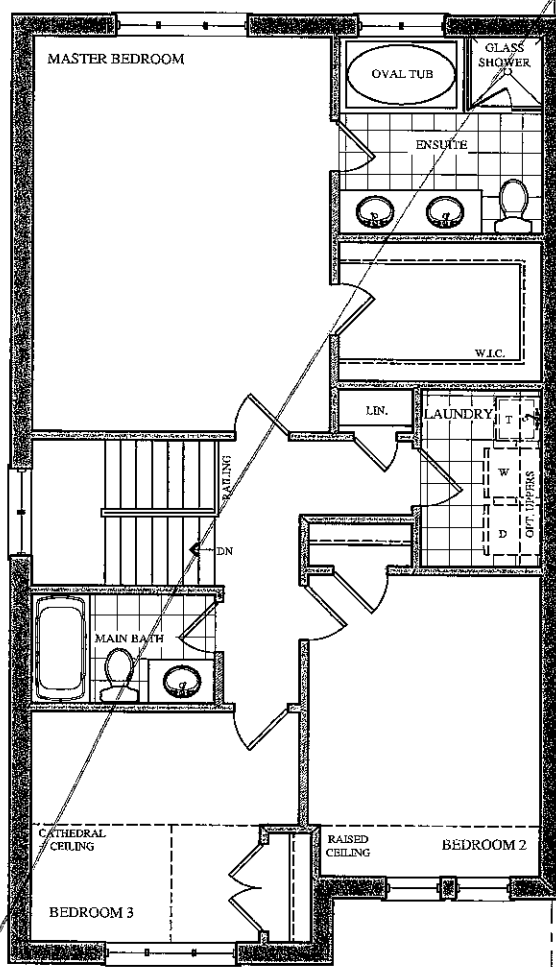


SECOND FLOOR PLAN
ELEV. 'A'

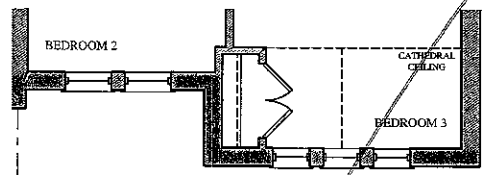


PART. SECOND FLOOR PLAN
ELEV. 'B'

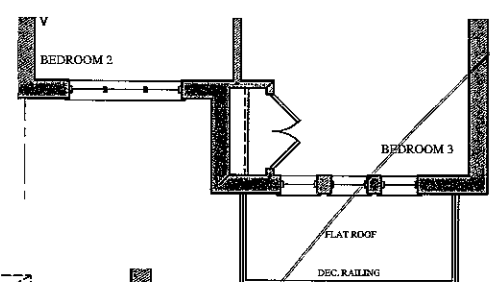


PART. SECOND FLOOR PLAN
ELEV. 'D'

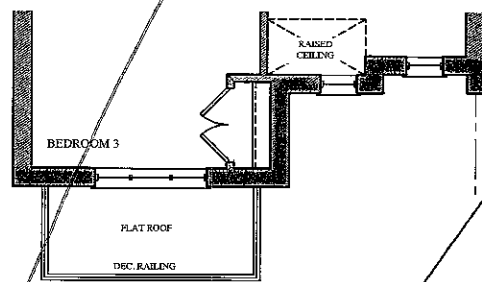


PART. SECOND FLOOR PLAN
ELEV. 'C'

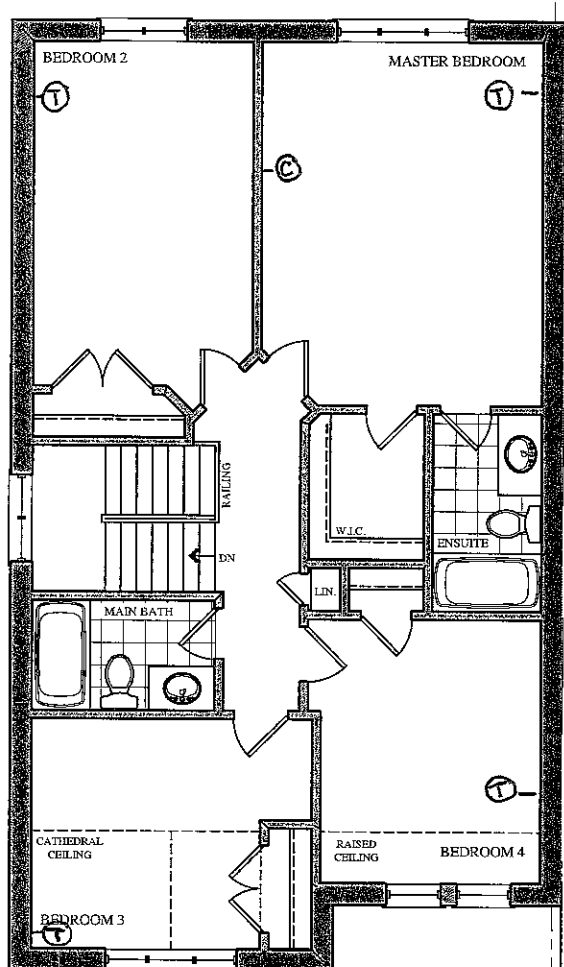


OPT. SECOND FLOOR PLAN
ELEV. 'A'

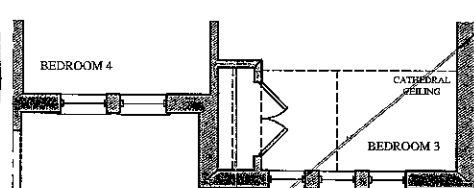

PART. OPT. SECOND FLOOR PLAN
ELEV. 'B'

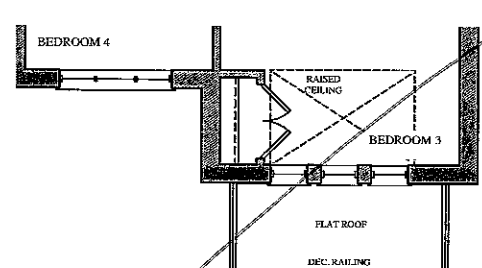

PART. OPT. SECOND FLOOR PLAN
ELEV. 'D'

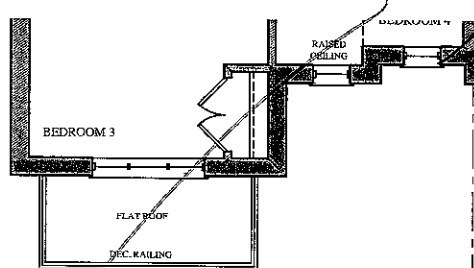

PART. OPT. SECOND FLOOR PLAN
ELEV. 'C'

Prices, figures, illustrations, sizes, features and finishes are subject to change without notice. Areas and dimensions are approximate and actual usable floor space may vary from the stated area. Layout may be reverse of the unit purchased. E. & O.E.

The
Rossini
SEMI SERIES

Elevation A • 1,911 sq.ft.
Elevation B • 1,902 sq.ft.
Elevation C • 1,966 sq.ft.
Elevation D • 1,971 sq.ft.

