



CONSTRUCTION SUMMARY

Brampton Encore - 14R - 2 - 28-4 Elev.B Rossini OPT4

CONCRETE AND DRAIN

Inv.1,636	1 - ROUGH-IN - 3PC BASEMENT ROUGH-IN
Line24688	Note:
16Nov17 / 17Nov17	

ELECTRICAL

Inv.1,636	1 - LIVING ROOM: ROUGH - IN CEILING FIXTURE ON SAME SWITCH - CAPPED-DOES NOT INCLUDE FIXTURE - LOCATION ON FLOOR PLAN
Line24692	Note:
16Nov17 / 17Nov17	

Exterior Colours

Inv.1,636	1 - EXTERIOR COLOUR PACKAGE #8
Line24695	Note:
16Nov17 / 17Nov17	

FORMING

Inv.1,636	1 - COLD CELLAR
Line24691	Note:
16Nov17 / 17Nov17	

FRAMING

Inv.1,636	1 - MAN DOOR GARAGE TO HOUSE - OPTIONAL - IF GRADE PERMITS
Line24694	Note:
16Nov17 / 17Nov17	

WINDOWS - BASEMENT



Inv.1,636	3 - BASEMENT WINDOWS - UPGRADE EXISTING BASEMENT WINDOW TO 30 INCH X 16 INCH
Line24689	Note:
16Nov17 / 17Nov17	

WINDOWS AND DOORS

Inv.1,636	1 - MAN DOOR GARAGE TO HOUSE - OPTIONAL - IF GRADE PERMITS
Line24690	Note:
16Nov17 / 17Nov17	


The
Rossini
SEMI SERIES

Elevation A • 1,911 sq.ft.
Elevation B • 1,902 sq.ft.
Elevation C • 1,966 sq.ft.
Elevation D • 1,971 sq.ft.

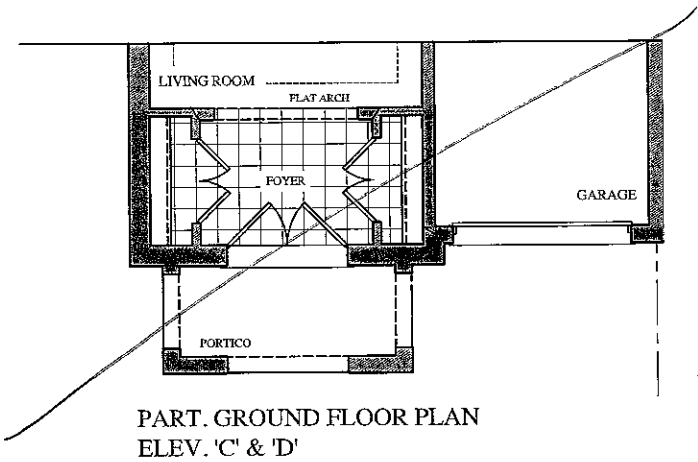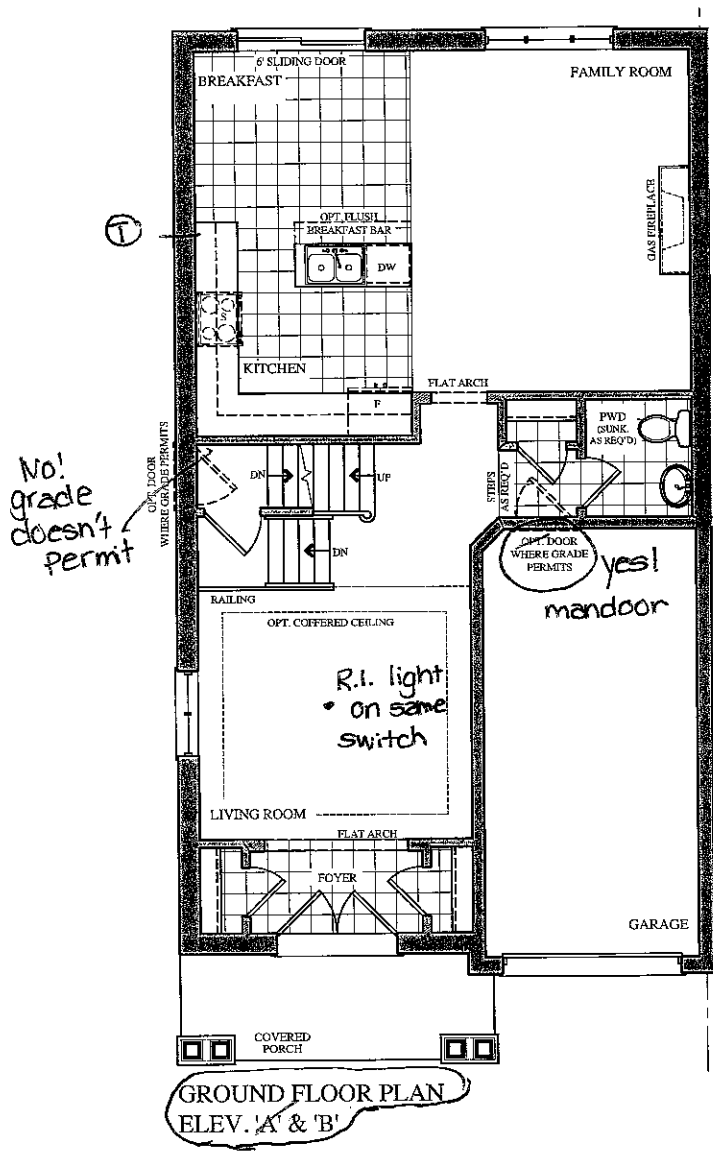


The
Rossini
SEMI SERIES


Elevation A • 1,911 sq.ft.
Elevation B • 1,902 sq.ft.
Elevation C • 1,966 sq.ft.
Elevation D • 1,971 sq.ft.

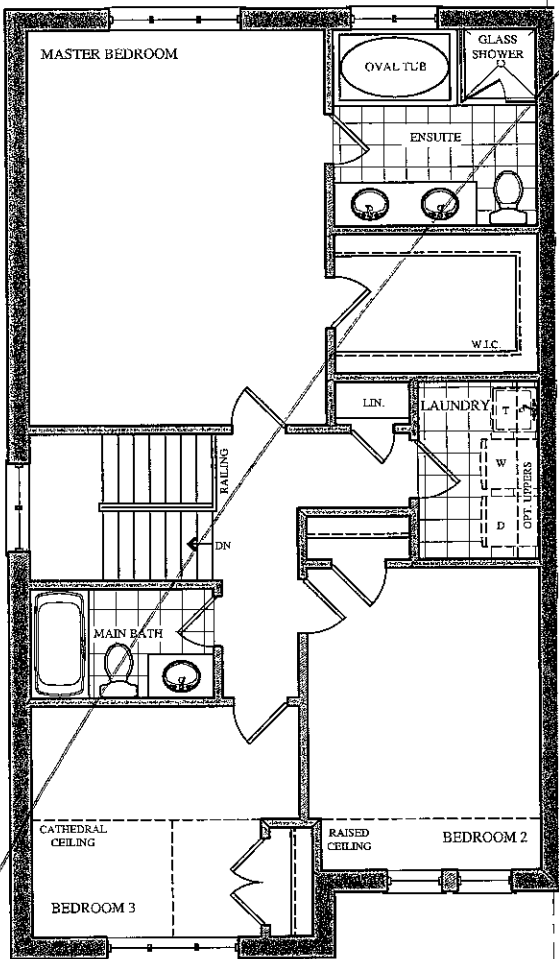


SECOND FLOOR PLAN
ELEV. 'A'

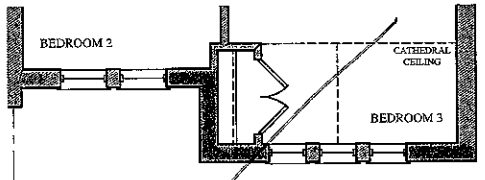


PART. SECOND FLOOR PLAN
ELEV. 'B'

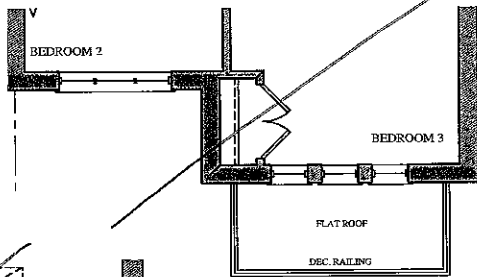


PART. SECOND FLOOR PLAN
ELEV. 'D'

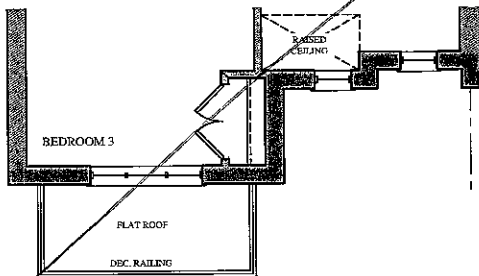


PART. SECOND FLOOR PLAN
ELEV. 'C'

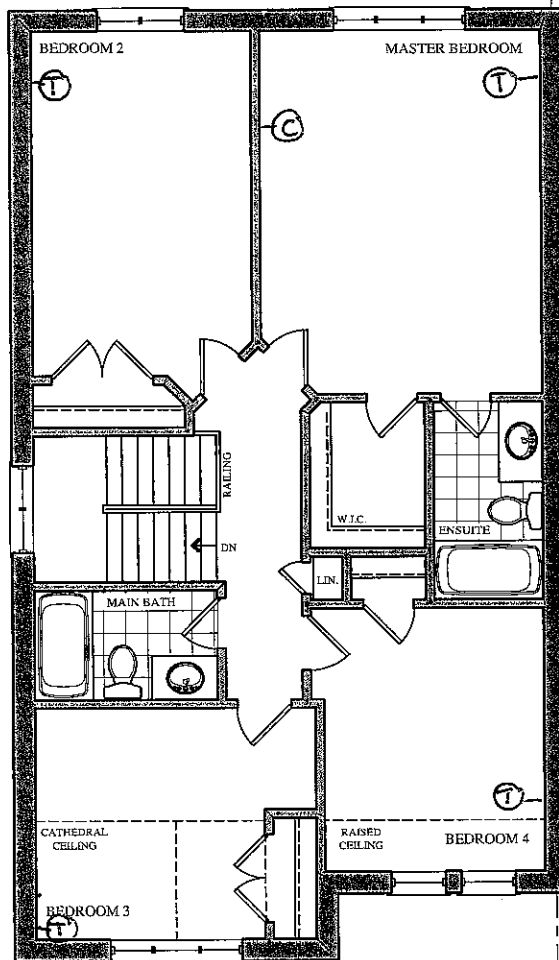


OPT. SECOND FLOOR PLAN
ELEV. 'A'

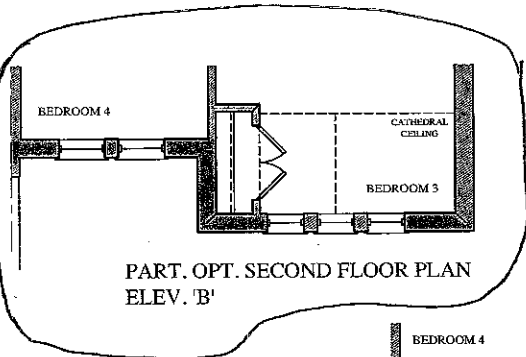

PART. OPT. SECOND FLOOR PLAN
ELEV. 'B'

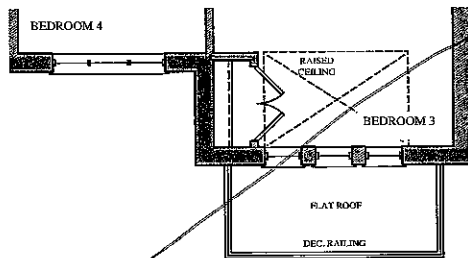

PART. OPT. SECOND FLOOR PLAN
ELEV. 'D'

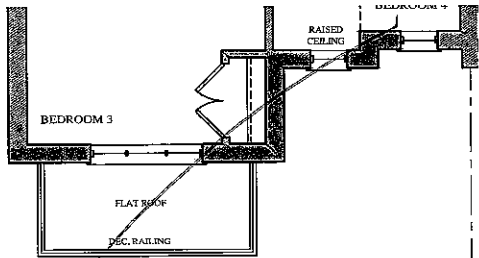

PART. OPT. SECOND FLOOR PLAN
ELEV. 'C'

The
Rossini
SEMI SERIES

Elevation A • 1,911 sq.ft.
Elevation B • 1,902 sq.ft.
Elevation C • 1,966 sq.ft.
Elevation D • 1,971 sq.ft.

