

Brampton Encore - 40L - 2 - 28-2 Elev.CL SIREN

ELECTRICAL

Inv.1,574	1 - KITCHEN: ROUGH - IN CEILING OUTLET & SWITCH (WITH COVER PLATE) - DOES NOT INCLUDE FIXTURE - LOCATE ABOVE ISLAND, SEE PLAN FOR LOCATION
Line24124	Note:
18Sep17 / 21Nov17	

Exterior Colours

Inv.1,574	1 - EXTERIOR COLOUR PACKAGE 1
Line24724	Note:
18Sep17 / 21Nov17	

FRAMING

Inv.1,574	1 - MAIN FLOOR: EXTENDED HEIGHT ARCHWAY (PRICE PER DOORWAY) -INCLUDE FRAMING NOTE 96"
Line24725	Note:
18Sep17 / 21Nov17	
Inv.1,574	1 - MAIN FLOOR; STANDARD DOOR EXTENDED HEIGHT 96" (PRICE PER DOOR)- GROUND FLOOR 2 STOREY MODELS
Line24726	Note:
18Sep17 / 21Nov17	

INTERIOR TRIM AND DOORS

Inv.1,574	1 - MAIN FLOOR: EXTENDED HEIGHT ARCHWAY (PRICE PER DOORWAY) -INCLUDE FRAMING NOTE 96"
Line24127	Note:
18Sep17 / 21Nov17	
Inv.1,574	3 - MAIN FLOOR; STANDARD DOOR EXTENDED HEIGHT 96" (PRICE PER DOOR)- GROUND FLOOR 2 STOREY MODELS
Line24128	Note:
18Sep17 / 21Nov17	

MISC.

Inv.1,574	1 - Purchaser has attended a Structural appointment at the Decor Centre & has DECLINED any additional upgrades and accepts and acknowledges that there will be no further structural changes/additions/deletions to be made upon signing on September 18, 2017.
Line24129	Note:
18Sep17 / 21Nov17	
Inv.1,574	1 - Purchasers are aware & accepts that ANY changes made to upgrades after signing this Purchasers Extra Form are subject to a minimum administration fee of \$500. PLUS a 10% holdback fee.
Line24130	Note:
18Sep17 / 21Nov17	
Inv.1,574	1 - BONUS PACKAGE: \$5,000.00 (INCLUDING TAXES) WORTH OF UPGRADES FROM GOLD PARK HOMES DÉCOR CENTRE IS BEING APPLIED TOWARD THE STRUCTURAL APPOINTMENT. PURCHASER HAS A REMAINING AMOUNT OF \$1881.20 (INCLUDING TAXES) TO BE USED TOWARD THE COLOUR APPOINTMENT.
Line24131	Note:
18Sep17 / 21Nov17	

WINDOWS - BASEMENT

Inv.1,574	2 - BASEMENT WINDOWS - UPGRADE EXISTING BASEMENT WINDOW TO 30 INCH X 24 INCH - MAY REQUIRE INSTALLATION OF WINDOW WELL
Line24125	Note:
18Sep17 / 21Nov17	

Brampton Encore - 40L - 2 - 28-2 Elev.CL SIREN

Inv.1,574	2 - BASEMENT WINDOWS - UPGRADE EXISTING BASEMENT WINDOW TO 30 INCH X 16 INCH
Line24126	Note:
18Sep17 / 21Nov17	

BEZ-40L  
 SEPT. 18 2017

# The Siren


## SEMI SERIES

Elevation A • 1,688 sq.ft.  
 Elevation B • 1,677 sq.ft.  
 → Elevation C • 1,687 sq.ft.


No ABOVE in  
 KITCHEN.

### LEGEND.

- ⊕ CAPPED CEILING R/M
- \$ SINGLE POLE SWITCH
- ⬡ 96" Arch
- ⬢ 96" Door
- △ RHOVE
- △ CABLE

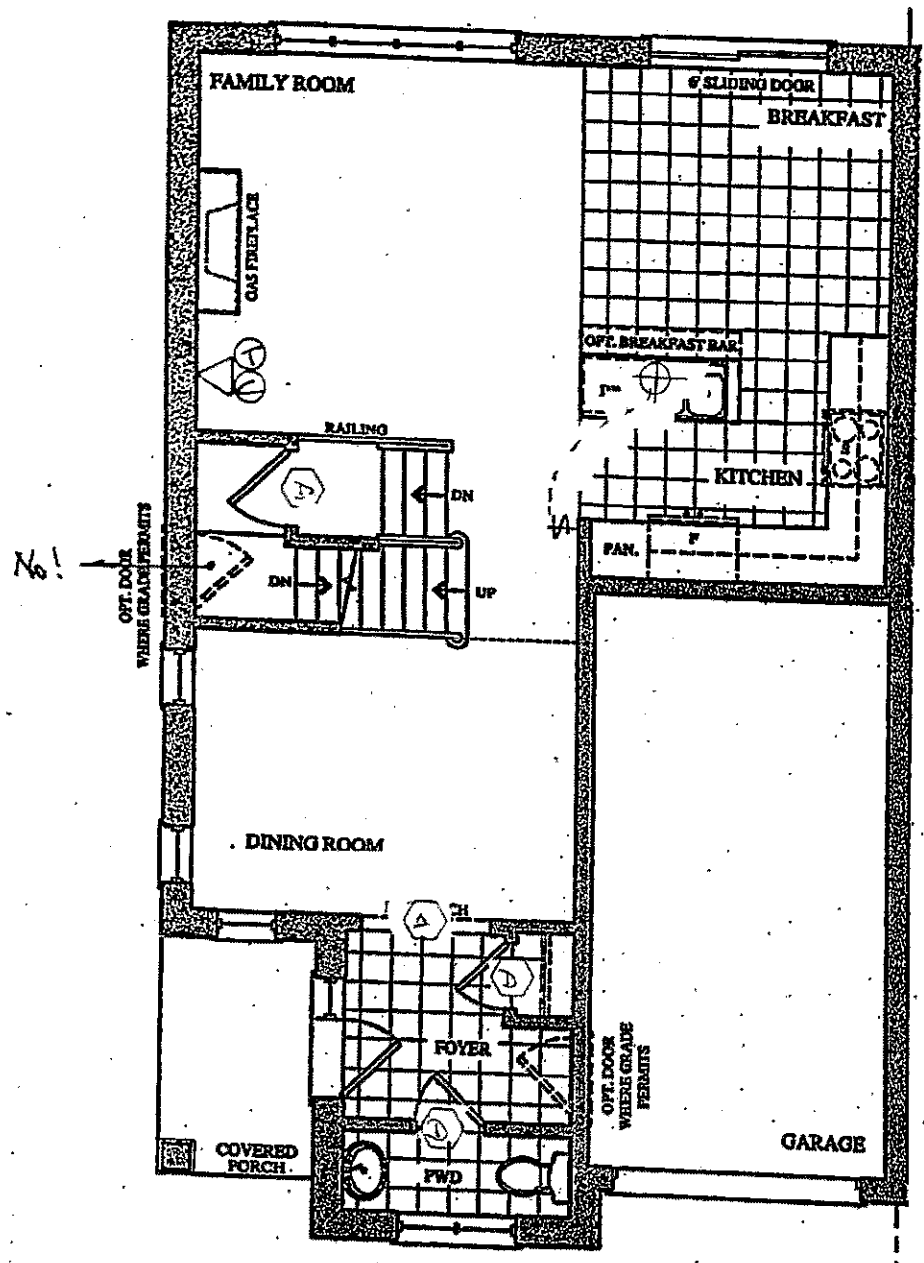

GROUND FLOOR PLAN  
 ELEV. 'A' & 'B'

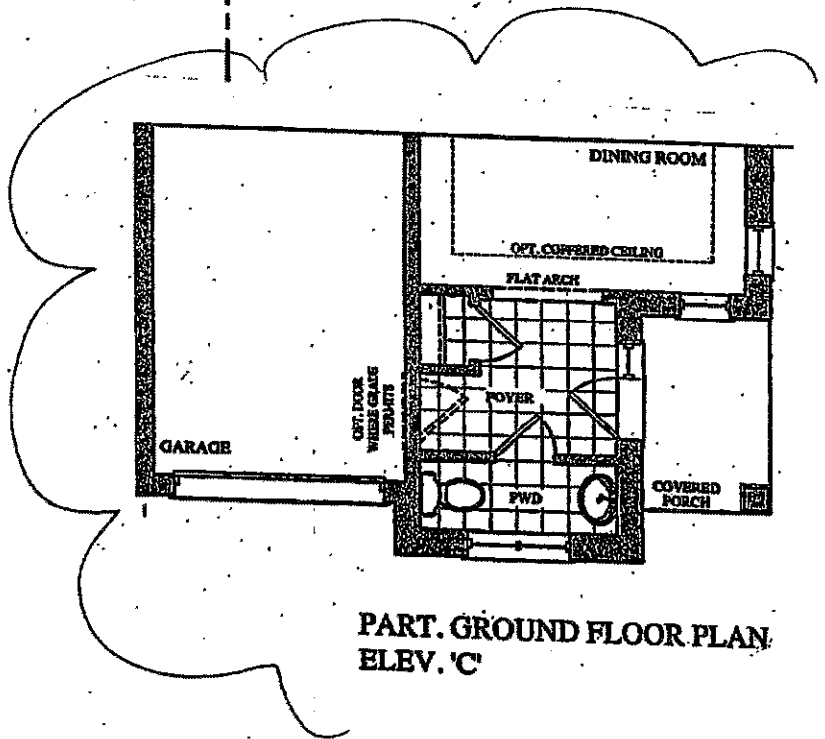


PART. GROUND FLOOR PLAN  
 ELEV. 'C'


BE2-4x  
PG SEPT 18 2017

# The Siren SEMI SERIES


Elevation A • 1,688 sq.ft.  
Elevation B • 1,677 sq.ft.  
→ Elevation C • 1,687 sq.ft.

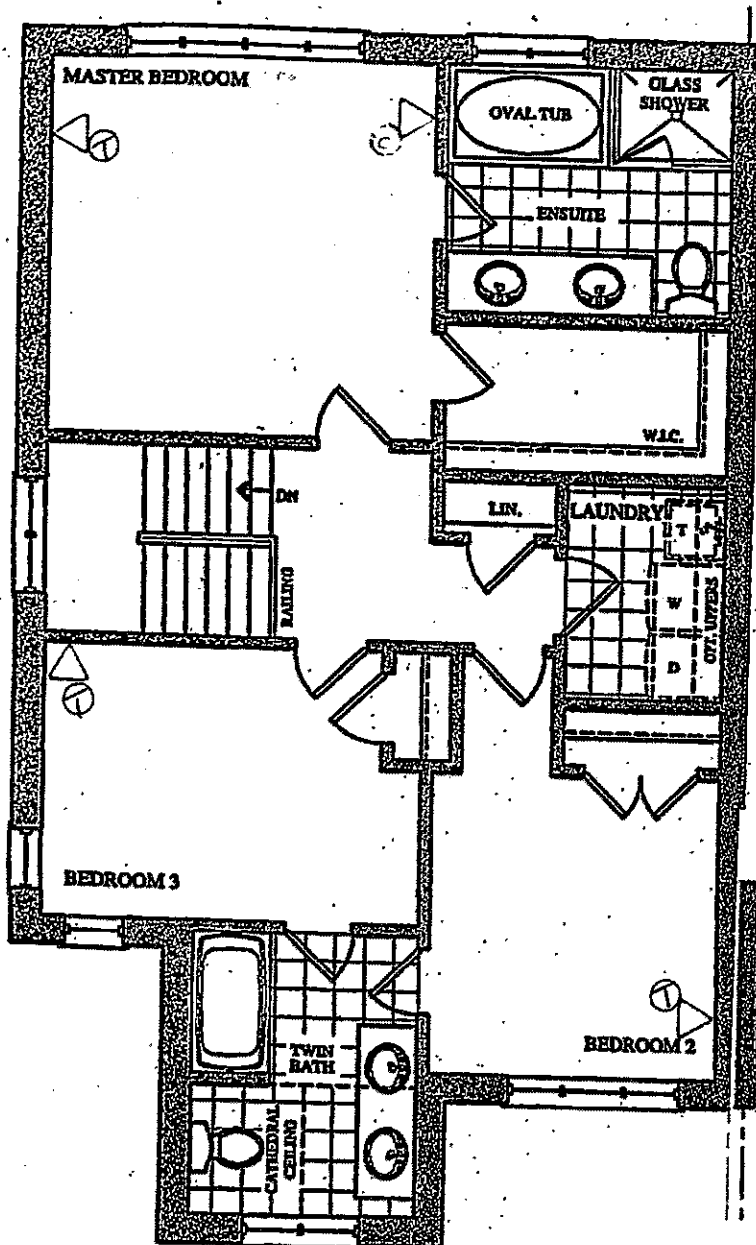

SECOND FLOOR PLAN  
ELEV. 'A'

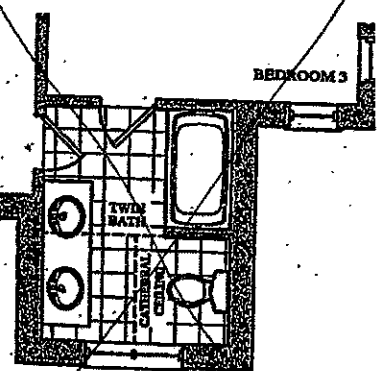

PART. SECOND FLOOR PLAN  
ELEV. 'B'

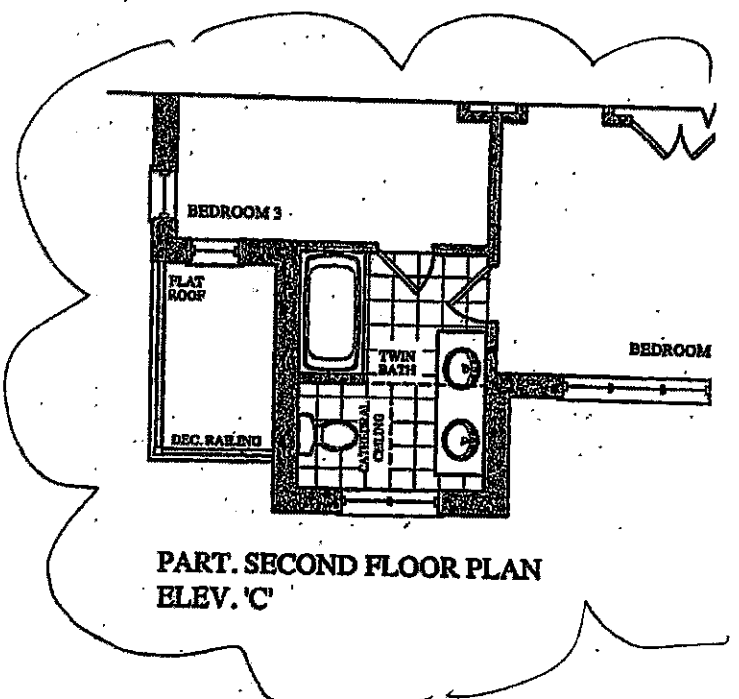

PART. SECOND FLOOR PLAN  
ELEV. 'C'

BE2-40L  
SEPT 18 2017

# The Siren

## SEMI SERIES

Elevation A • 1,688 sq.ft.

Elevation B • 1,677 sq.ft.

→ Elevation C • 1,687 sq.ft.

