

Brampton Encore - 52L - 2 - 28-2 Elev.A SIREN
CENTRAL VAC AND WIRING

Inv.1,521	1 - TELEPHONE AND CABLE ROUGH-IN LOCATIONS
Line23512	Note:
24Jul17 / 21Nov17	

Exterior Colours

Inv.1,521	1 - EXTERIOR COLOUR PACKAGE 7
Line24722	Note:
24Jul17 / 21Nov17	

FORMING

Inv.1,521	1 - EXTERIOR: INSTALL SIDE DOOR- HOME TO EXTERIOR- AS PER PLAN AND GRADE PERMITTING
Line23513	Note:
24Jul17 / 21Nov17	

FRAMING

Inv.1,521	1 - GARAGE: INSTALL ROUGH-IN MANDOOR - GARAGE TO HOUSE- AS PER PLAN-GRADE DOESN'T PERMIT DOOR
Line23514	Note:
24Jul17 / 21Nov17	

MISC.

Inv.1,521	1 - BONUS PACKAGE: \$4135.80 (INCLUDING TAXES) WORTH OF UPGRADES FROM GOLD PARK HOMES DÉCOR CENTRE IS BEING APPLIED TOWARD THE STRUCTURAL APPOINTMENT. PURCHASER HAS A REMAINING AMOUNT OF \$5864.20 (INCLUDING TAXES) TO BE USED TOWARD THE COLOUR APPOINTMENT
Line23516	Note:
24Jul17 / 21Nov17	
Inv.1,521	1 - Purchaser has attended a Structural appointment at the Decor Centre & has DECLINED any additional upgrades and accepts and acknowledges that there will be no further structural changes/additions/deletions to be made upon signing on July 24, 2017
Line23517	Note:
24Jul17 / 21Nov17	
Inv.1,521	1 - Purchasers are aware & accepts that ANY changes made to upgrades after signing this Purchasers Extra Form are subject to a minimum administration fee of \$500. PLUS a 10% holdback fee
Line23518	Note:
24Jul17 / 21Nov17	

WINDOWS - BASEMENT

Inv.1,521	4 - BASEMENT: INSTALL FOUR (X4) BASEMENT WINDOWS - UPGRADE EXISTING BASEMENT WINDOW TO 30 INCH X 24 INCH - MAY REQUIRE INSTALLATION OF WINDOW WELL
Line23515	Note: PURCHASER IS AWARE THAT THE SIDE WINDOW WILL GET A WINDOW WELL
24Jul17 / 21Nov17	

WINDOWS AND DOORS



Inv.1,521	1 - EXTERIOR: INSTALL SIDE DOOR- HOME TO EXTERIOR- AS PER PLAN AND GRADE PERMITTING
Line24721	Note:
24Jul17 / 21Nov17	

Telephone — (T)
 Cable — (C)

The Siren

SEMI SERIES

Elevation A • 1,688 sq.ft.
 Elevation B • 1,677 sq.ft.
 Elevation C • 1,687 sq.ft.

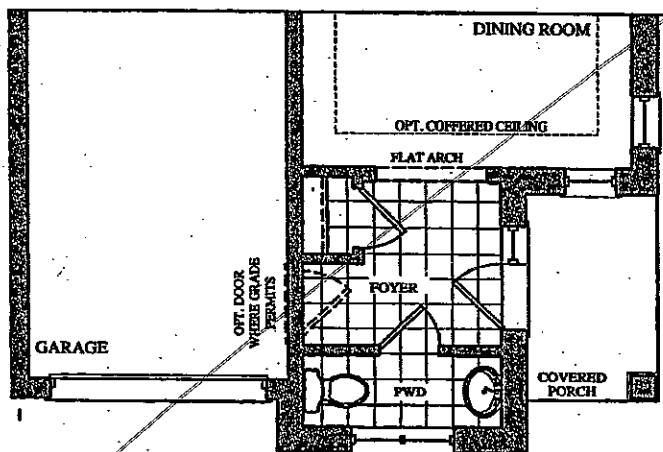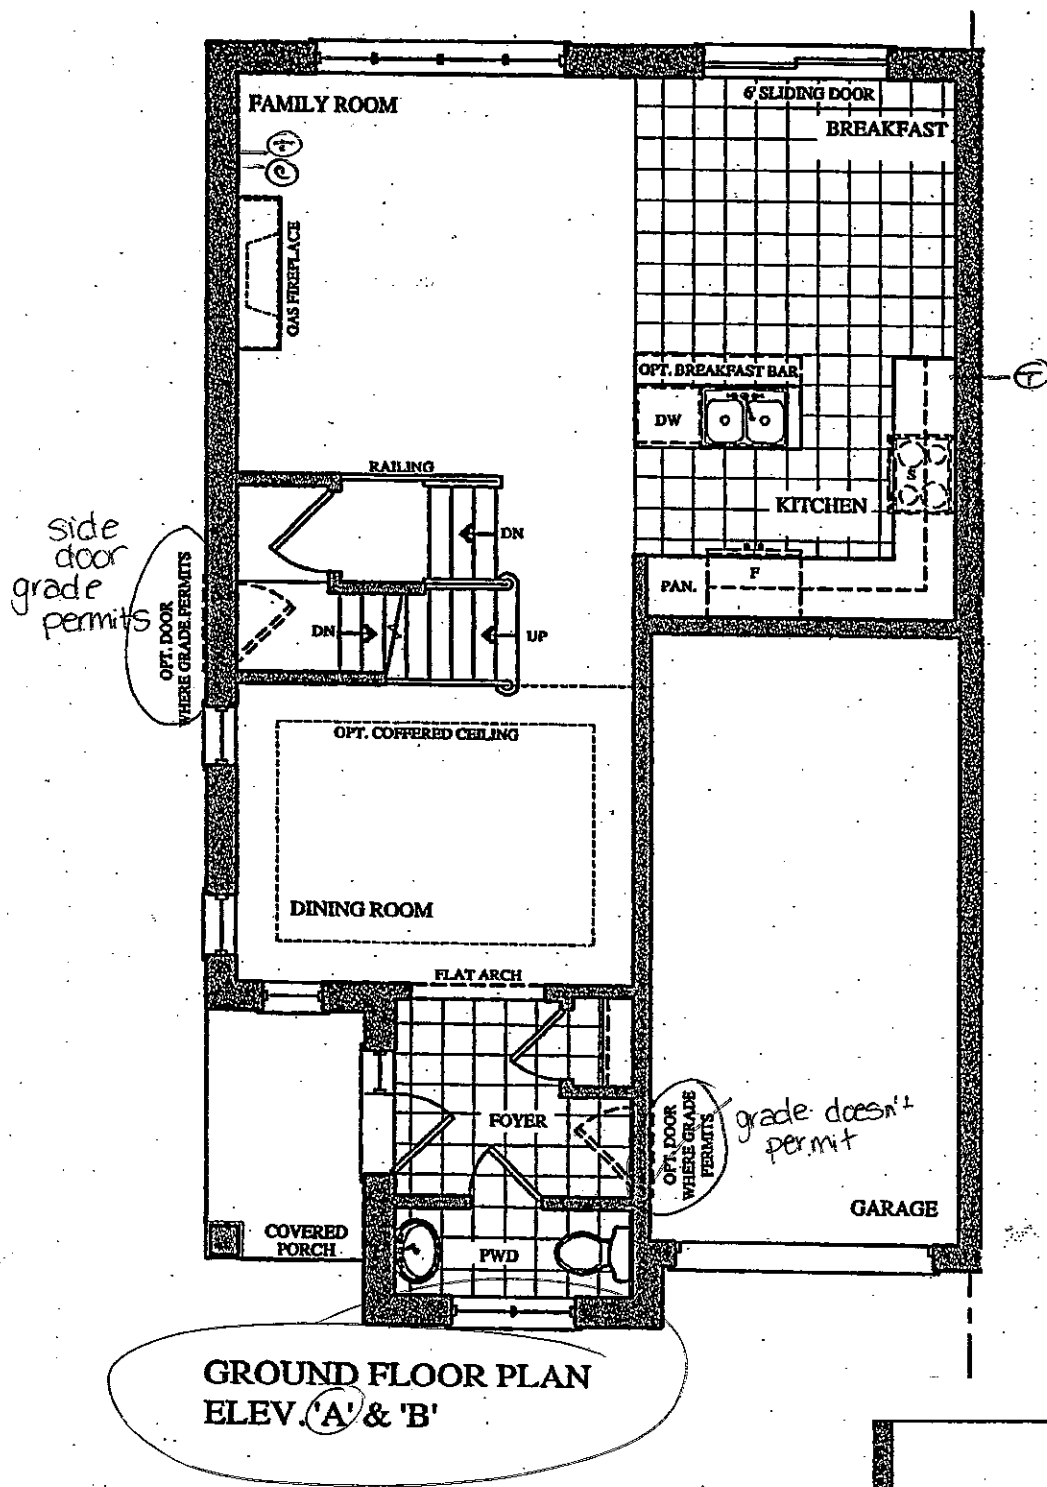

PART. GROUND FLOOR PLAN
 ELEV. 'C'

Lot 52L
 July 24, 17


65

Telephone — (T)
Cable — (C)


The Siren

SEMI SERIES

Elevation A • 1,688 sq.ft.
Elevation B • 1,677 sq.ft.
Elevation C • 1,687 sq.ft.

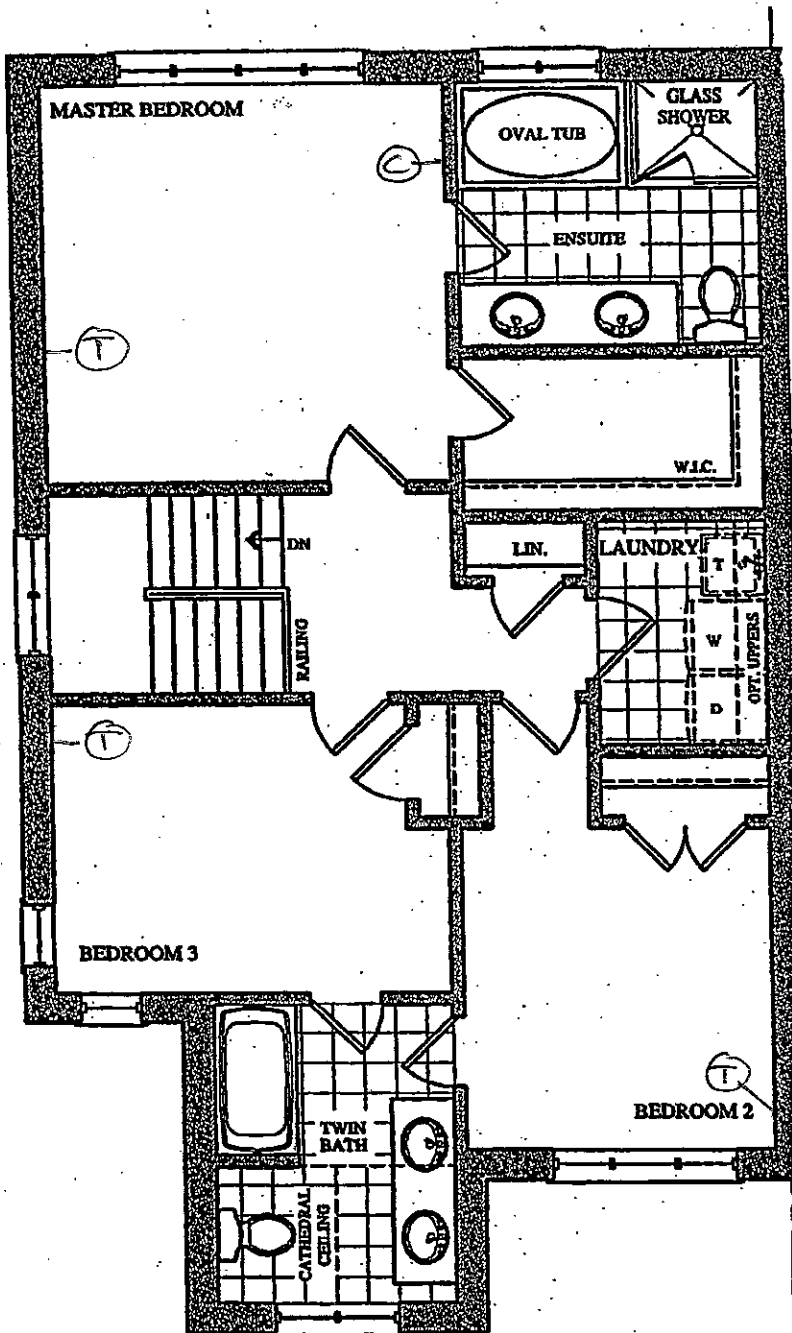


SECOND FLOOR PLAN
ELEV. 'A'

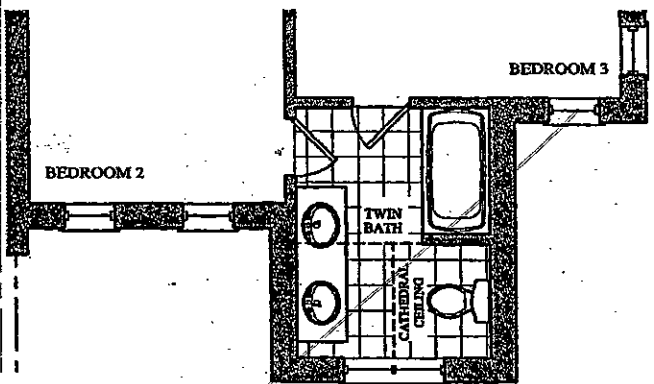

PART. SECOND FLOOR PLAN
ELEV. 'B'

Lot 52L
July 24, 17

(G.S.)

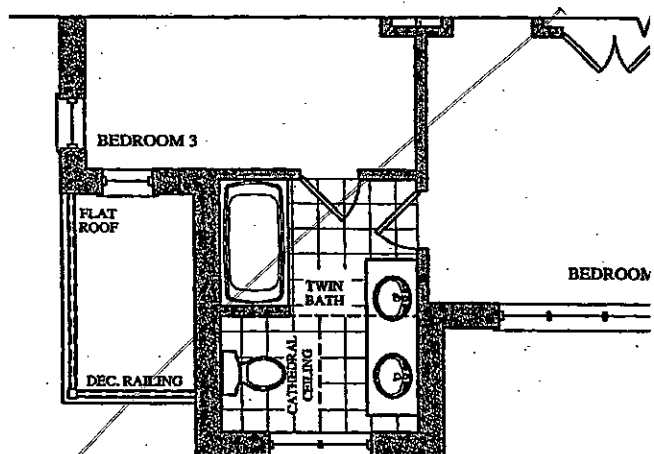


PART. SECOND FLOOR PLAN
ELEV. 'C'

The
Siren
SEMI SERIES

Elevation A • 1,688 sq.ft.
Elevation B • 1,677 sq.ft.
Elevation C • 1,687 sq.ft.

BSMNT WINDOWS
4x 30"x24" h

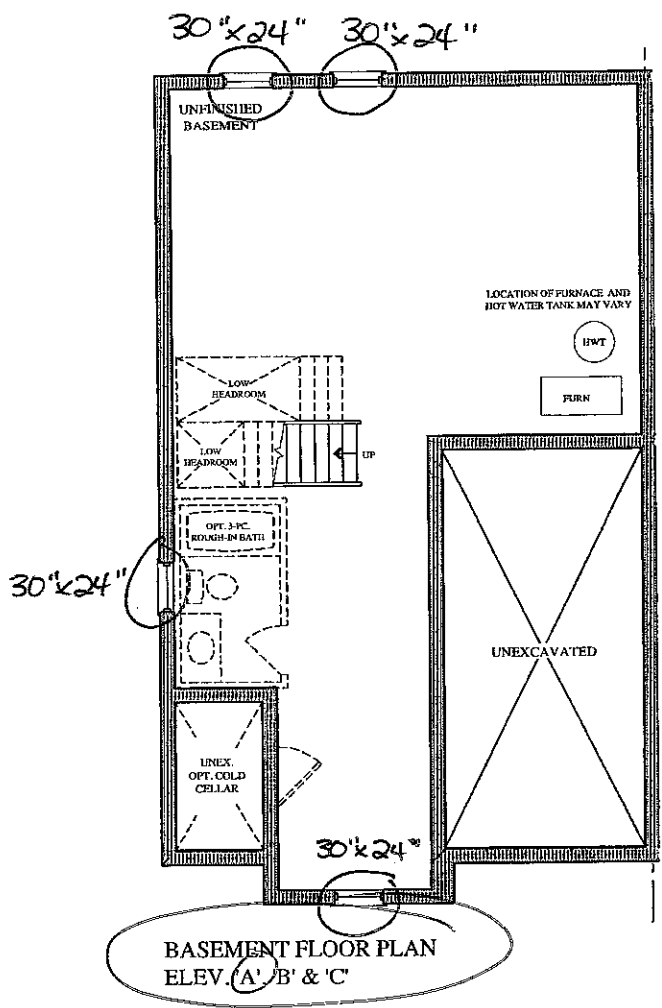

Prices, figures, illustrations, sizes, features and finishes are subject to change without notice. Areas and dimensions are approximate and actual usable floor space may vary from the stated area. Layout may be reverse of the unit purchased. E. & O.E.

GOLDPARK
WORTH MORE™

Lot 52L
July 24, 17

GS