

Brampton Encore - 54L - 2 - 28-8 Elev.A BEETHOVEN
CENTRAL VAC AND WIRING

Inv.1,532	1 - TELEPHONE AND CABLE ROUGH-IN LOCATIONS
Line23624	Note:
28Jul17 / 21Nov17	

Exterior Colours

Inv.1,532	1 - EXTERIOR COLOUR PACKAGE 1
Line24648	Note:
28Jul17 / 21Nov17	

MISC.

Inv.1,532	1 - Purchaser has attended a Structural appointment at the Decor Centre & has DECLINED any additional upgrades and accepts and acknowledges that there will be no further structural changes/additions/deletions to be made upon signing on July 28, 2017.
Line23625	Note:
28Jul17 / 21Nov17	
Inv.1,532	1 - Purchasers are aware & accepts that ANY changes made to upgrades after signing this Purchasers Extra Form are subject to a minimum administration fee of \$500. PLUS a 10% holdback fee
Line23626	Note:
28Jul17 / 21Nov17	

WINDOWS AND DOORS


Inv.1,532	1 - MANDOOR- GARAGE TO HOUSE- GRADE PERMITTING
Line24730	Note:
28Jul17 / 21Nov17	

Telephone — (T)
Cable — (C)

The Beethoven

SEMI SERIES

Elevation A • 2,372 sq.ft.
Elevation B • 2,372 sq.ft.
Elevation C • 2,372 sq.ft.
Elevation D • 2,372 sq.ft.

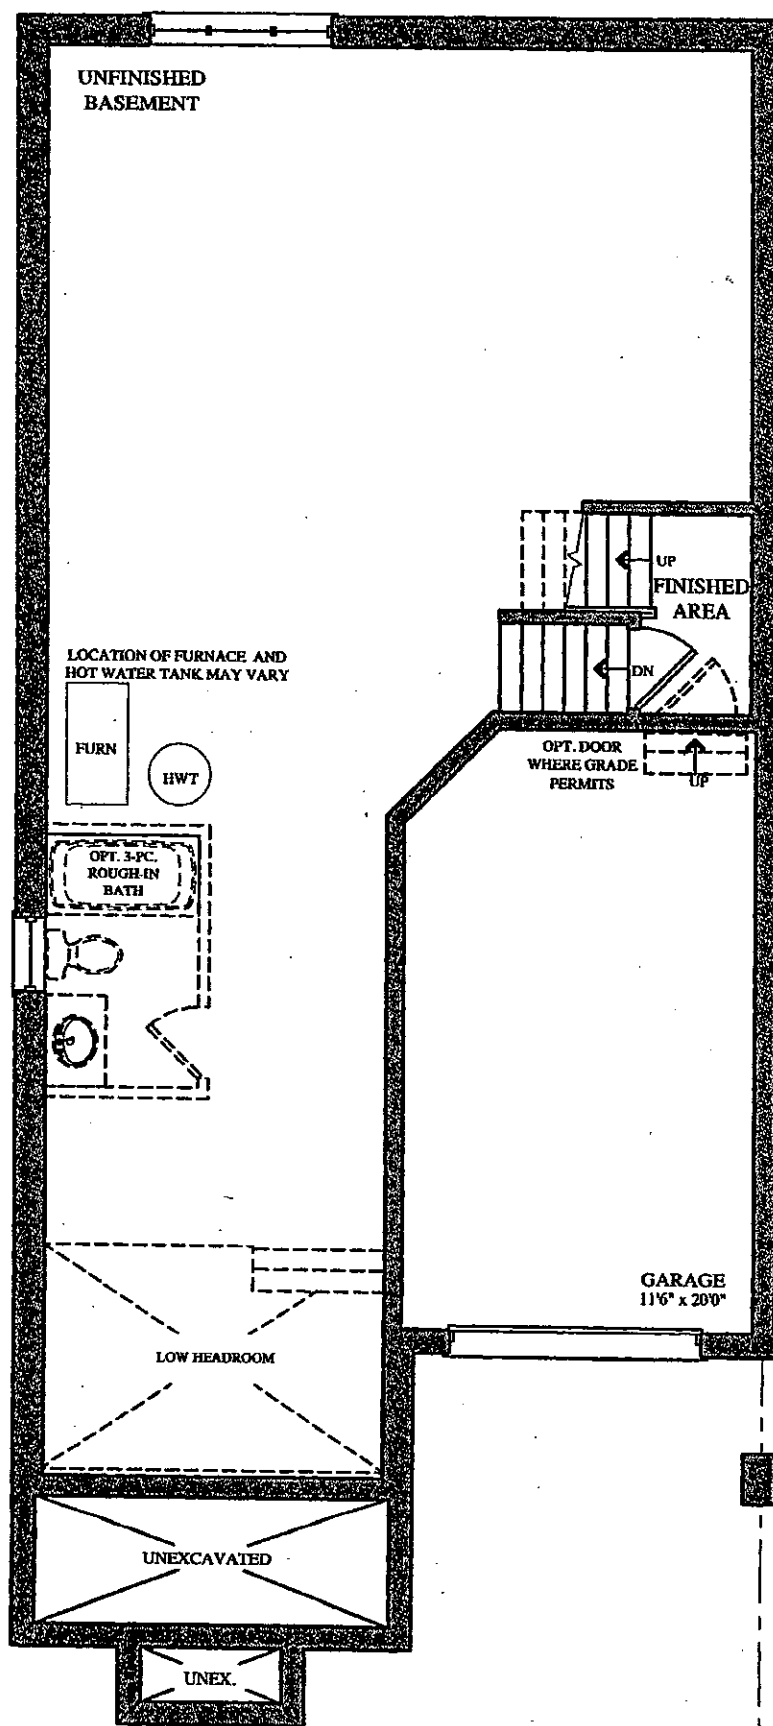

BASEMENT FLOOR PLAN
ELEV. 'A', 'B', 'C' & 'D'




Lot 54L
July 28, 17
(AH) (1/2)

Telephone — (T)
Cable — (C)

The Beethoven

SEMI SERIES

Elevation A • 2,372 sq.ft.
Elevation B • 2,372 sq.ft.
Elevation C • 2,372 sq.ft.
Elevation D • 2,372 sq.ft.

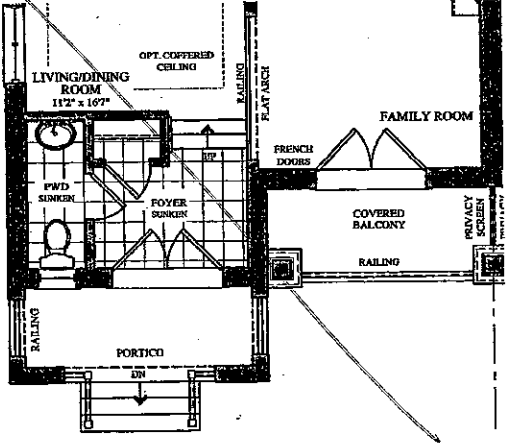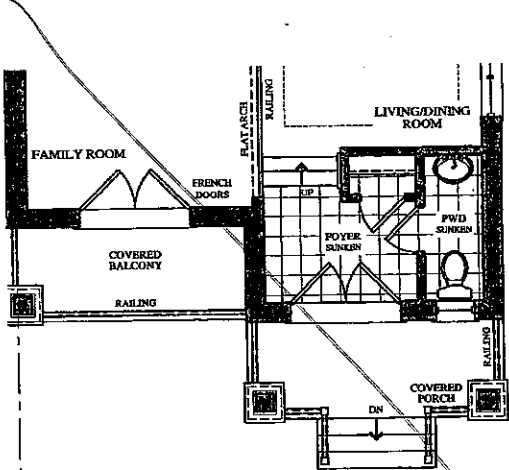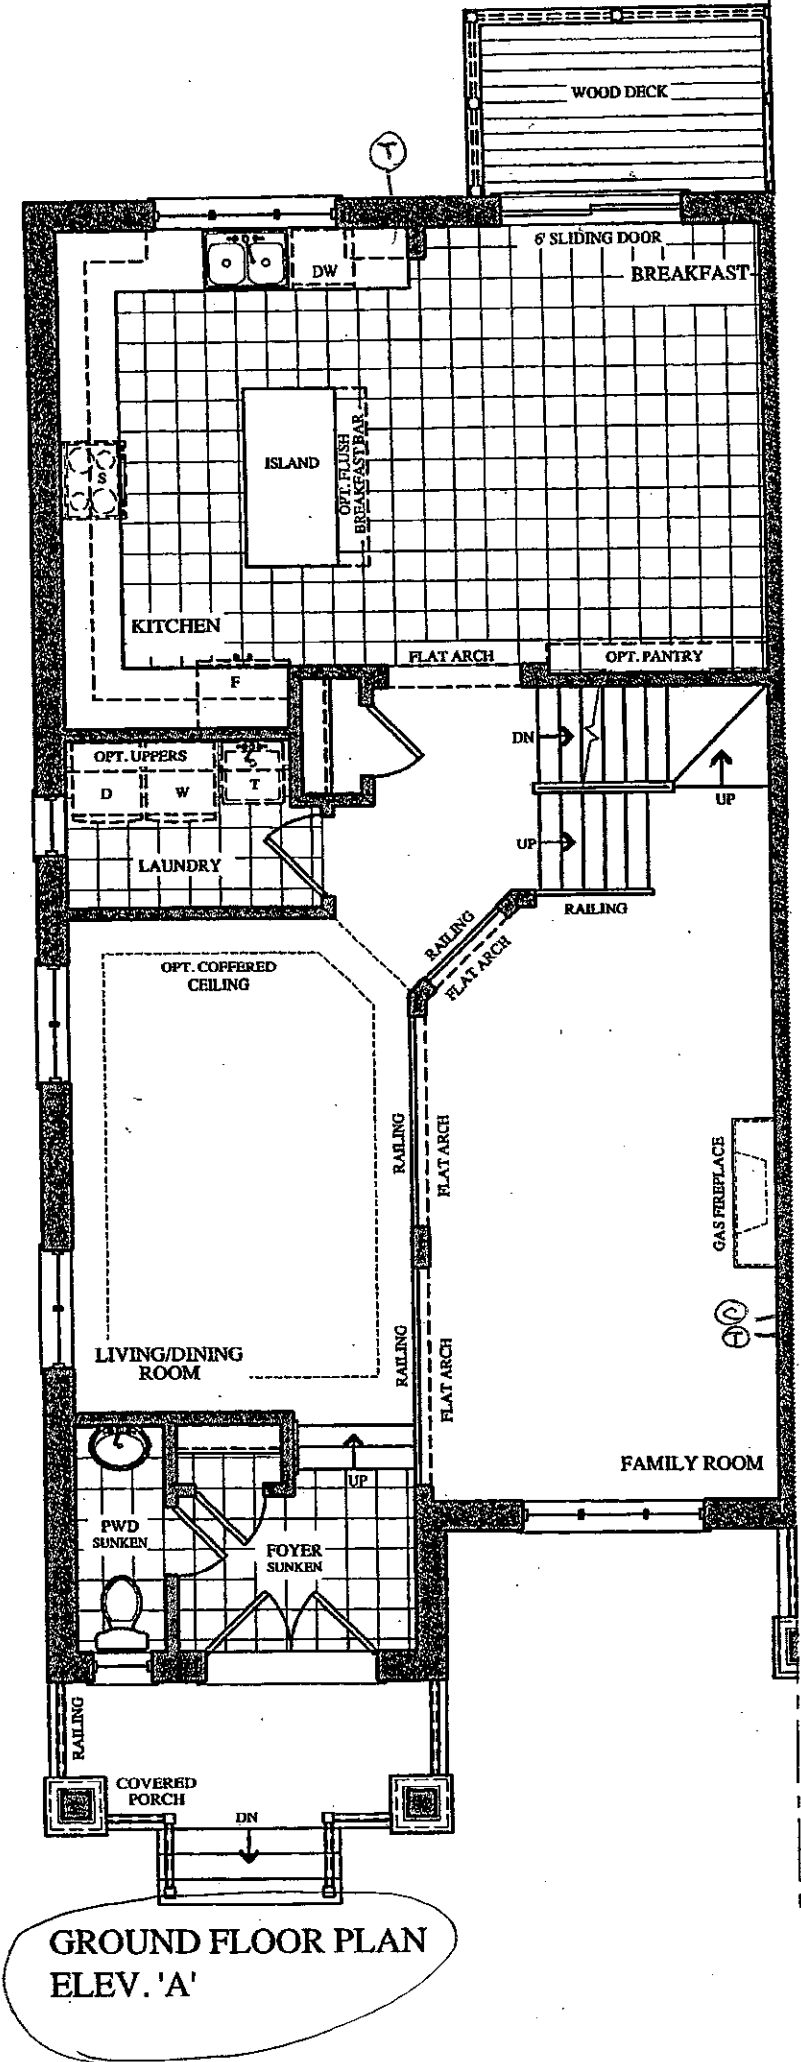


Lot 54L
July 28, 17
AM JX

Telephone — (T)
Cable — (C)


The Beethoven

SEMI SERIES


Elevation A • 2,372 sq.ft.
Elevation B • 2,372 sq.ft.
Elevation C • 2,372 sq.ft.
Elevation D • 2,372 sq.ft.

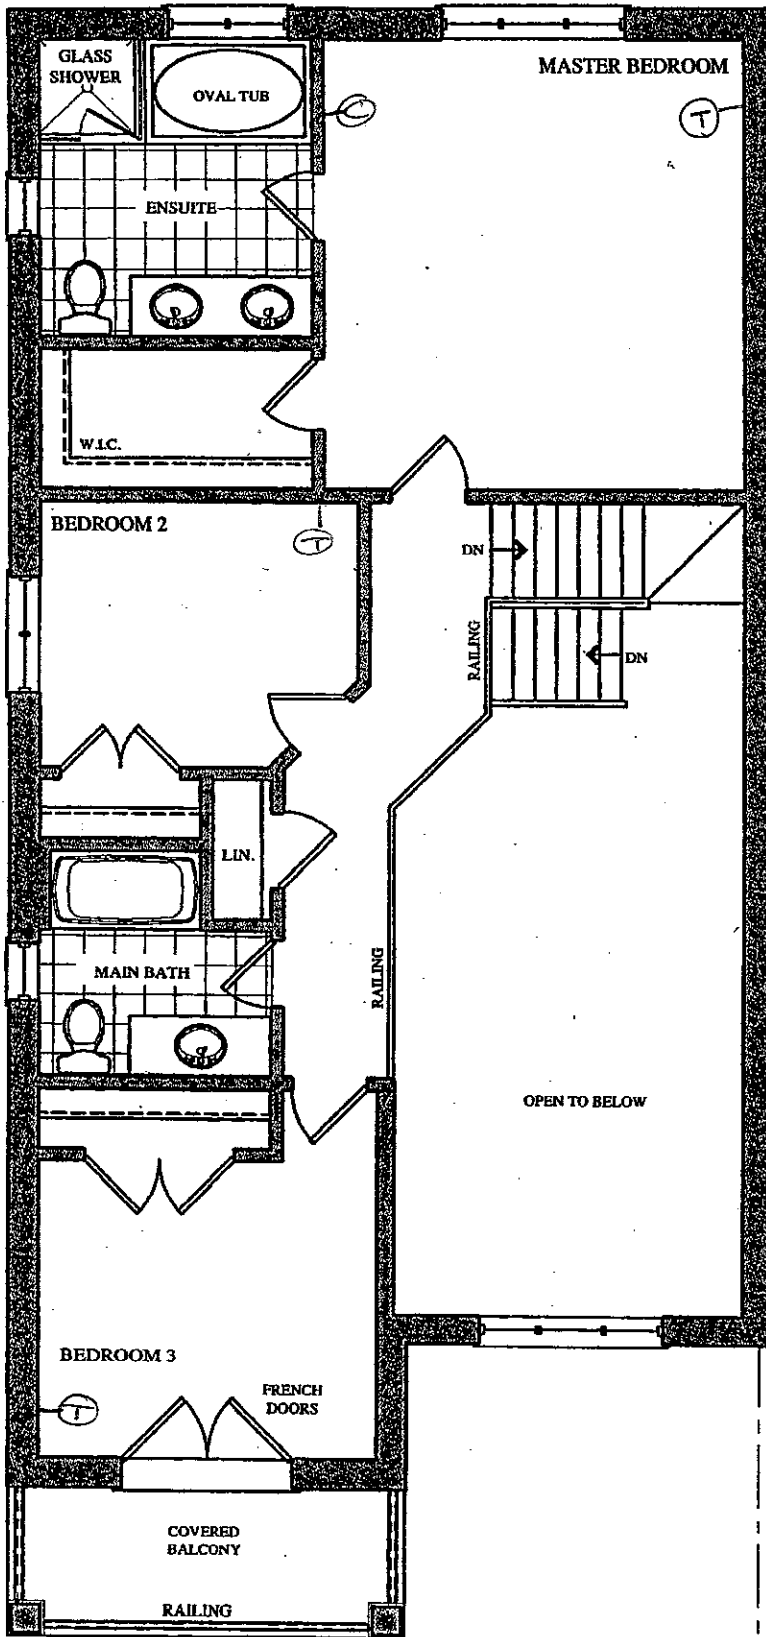

SECOND FLOOR PLAN
ELEV. 'A'

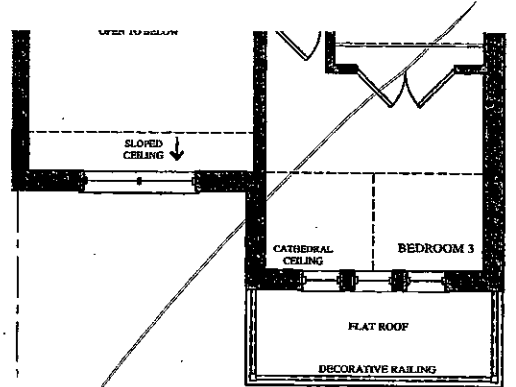

PART. SECOND FLOOR PLAN
ELEV. 'B'

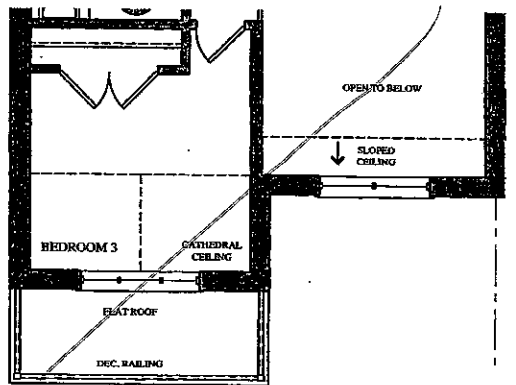

PART. SECOND FLOOR PLAN
ELEV. 'C' & 'D'

Lot 54L
July 28, 17

AM 27