

Brampton Encore - 55L - 2 - 28-2 Elev.CL SIREN

CENTRAL VAC AND WIRING

Inv.1,513	1 - TELEPHONE AND CABLE ROUGH-IN LOCATION SKETCH
Line23434	Note:
18Jul17 / 21Nov17	
Inv.1,513	1 - FAMILY ROOM: INSTALL CONDUIT PIPE- FOR TELEVISION- MUST SPECIFY LOCATION AND TERMINATION POINT
Line23435	Note:
18Jul17 / 21Nov17	

ELECTRICAL

Inv.1,513	1 - FAMILY ROOM: INSTALL 110V WALL RECEPTACLE ON DEDICATED CIRCUIT - ABOVE FIREPLACE FOR FUTURE TV
Line23436	Note:
18Jul17 / 21Nov17	

Exterior Colours

Inv.1,513	1 - EXTERIOR COLOUR PACKAGE #3
Line24747	Note:
18Jul17 / 21Nov17	

FRAMING

Inv.1,513	1 - GARAGE: ROUGH-IN MANDOOOR - EXTENDED HEIGHT GARAGE TO HOUSE- AS PER PLAN AND GRADE PERMITING
Line23438	Note:
18Jul17 / 21Nov17	
Inv.1,513	1 - MAIN FLOOR: INSTALL THREE (X3) STANDARD DOOR EXTENDED HEIGHT 96" (PRICE PER DOOR)- GROUND FLOOR 2 STOREY MODELS
Line24748	Note:
18Jul17 / 21Nov17	

INTERIOR TRIM AND DOORS

Inv.1,513	3 - MAIN FLOOR: INSTALL THREE (X3) STANDARD DOOR EXTENDED HEIGHT 96" (PRICE PER DOOR)- GROUND FLOOR 2 STOREY MODELS
Line23440	Note:
18Jul17 / 21Nov17	

MISC.

Inv.1,513	1 - REFUND- EXTERIOR: INSTALL SIDE DOOR- HOME TO EXTERIOR- AS PER PLAN AND GRADE PERMITTING
Line23437	Note:
18Jul17 / 21Nov17	
Inv.1,513	1 - REFUND MAIN FLOOR - MANDOOOR: INSTALL STANDARD MANDOOOR EXTENDED HEIGHT- GROUND FLOOR 2 STOREY MODELS- GRADE DOESN'T PERMIT
Line23441	Note:
18Jul17 / 21Nov17	
Inv.1,513	1 - BONUS PACKAGE: \$5,000.00 (INCLUDING TAXES) WORTH OF UPGRADES FROM GOLD PARK HOMES DÉCOR CENTRE IS BEING APPLIED TOWARD THE STRUCTURAL APPOINTMENT. PURCHASER HAS A REMAINING AMOUNT OF \$00 (INCLUDING TAXES) TO BE USED TOWARD THE COLOUR APPOINTMENT
Line23442	Note:
18Jul17 / 21Nov17	

Brampton Encore - 55L - 2 - 28-2 Elev.CL SIREN

Inv.1,513	1 - Purchaser has attended a Structural appointment at the Decor Centre & has DECLINED any additional upgrades and accepts and acknowledges that there will be no further structural changes/additions/deletions to be made upon signing on July 18, 2017
Line23443	Note:
18Jul17 / 21Nov17	

Inv.1,513	1 - Purchasers are aware & accepts that ANY changes made to upgrades after signing this Purchasers Extra Form are subject to a minimum administration fee of \$500. PLUS a 10% holdback fee.
Line23444	Note:
18Jul17 / 21Nov17	

WINDOWS - BASEMENT


Inv.1,513	2 - BASEMENT: INSTALL TWO (X2) BASEMENT WINDOWS - UPGRADE EXISTING BASEMENT WINDOW TO 30 INCH X 24 INCH - MAY REQUIRE INSTALLATION OF WINDOW WELL
Line23439	Note:
18Jul17 / 21Nov17	

Telephone — (T)
 Cable — (C)
 Electrical — (E)


The Siren

SEMI SERIES

Elevation A • 1,688 sq.ft.
 Elevation B • 1,677 sq.ft.
 Elevation C • 1,687 sq.ft.

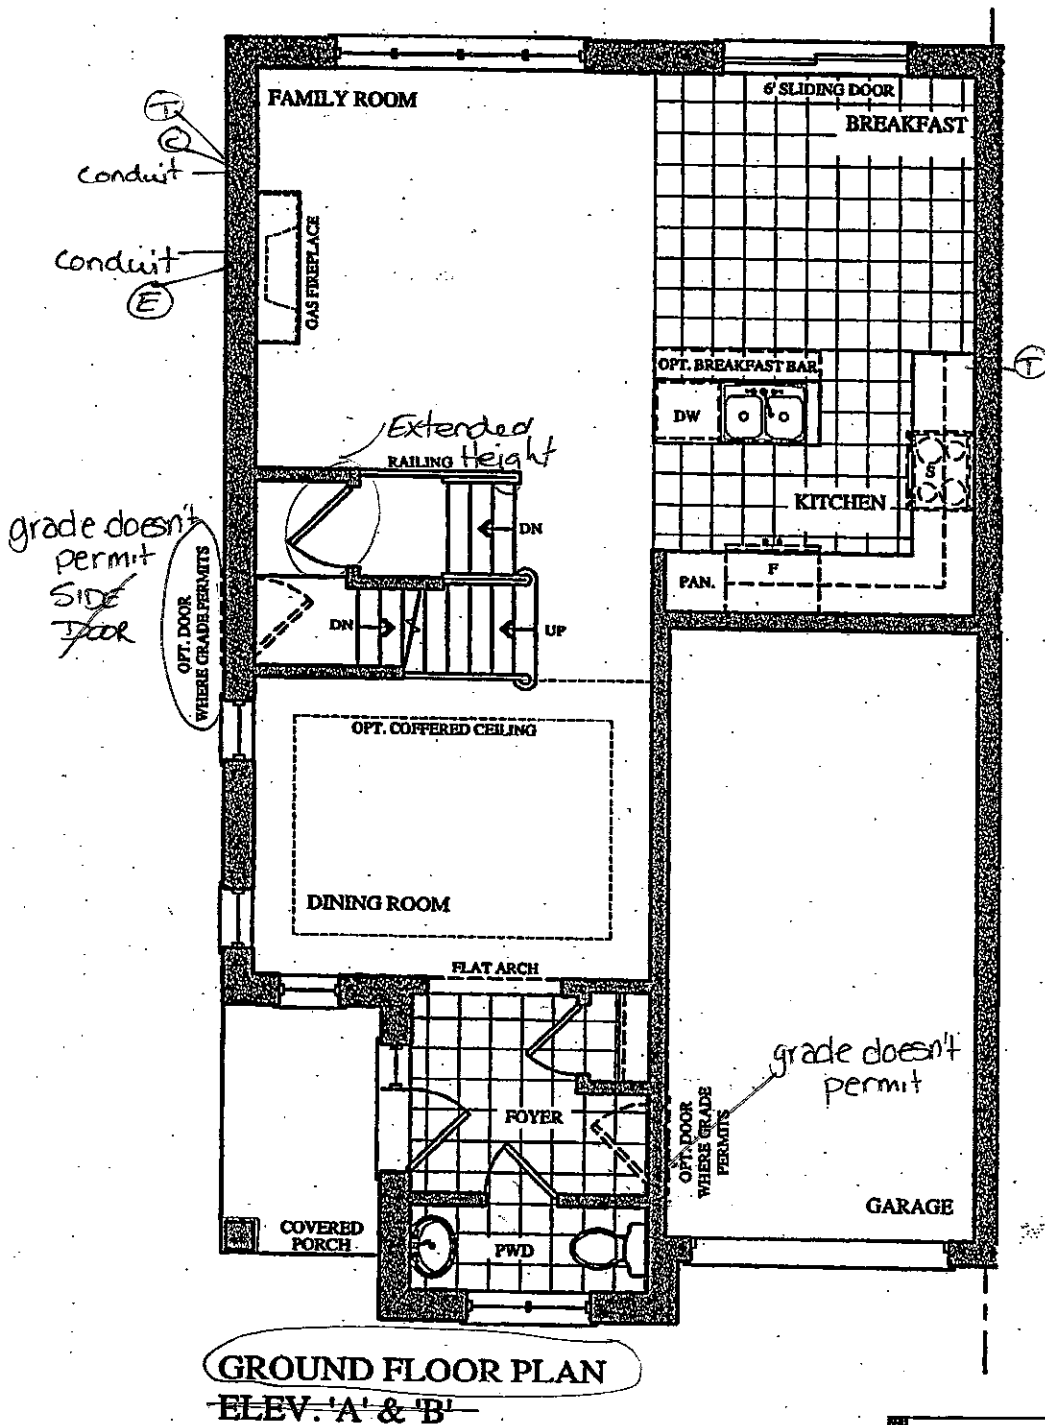

Lot 55L
 July 18, 17
 (Handwritten initials and date)

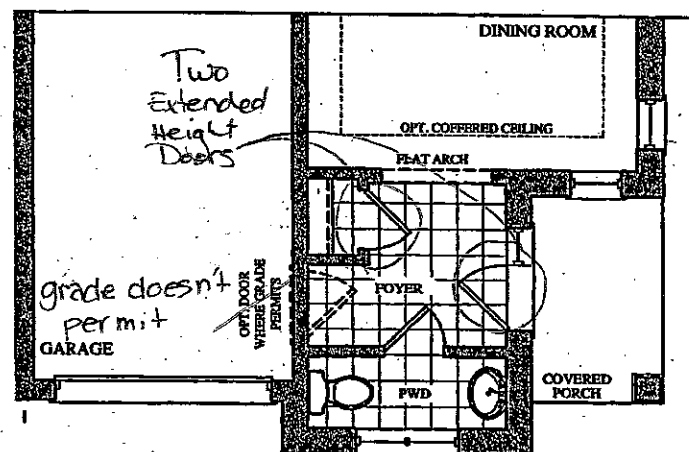


Telephone — (T)
 cable — (C)


The Siren

SEMI SERIES

Elevation A • 1,688 sq.ft.
 Elevation B • 1,677 sq.ft.
 Elevation C • 1,687 sq.ft.

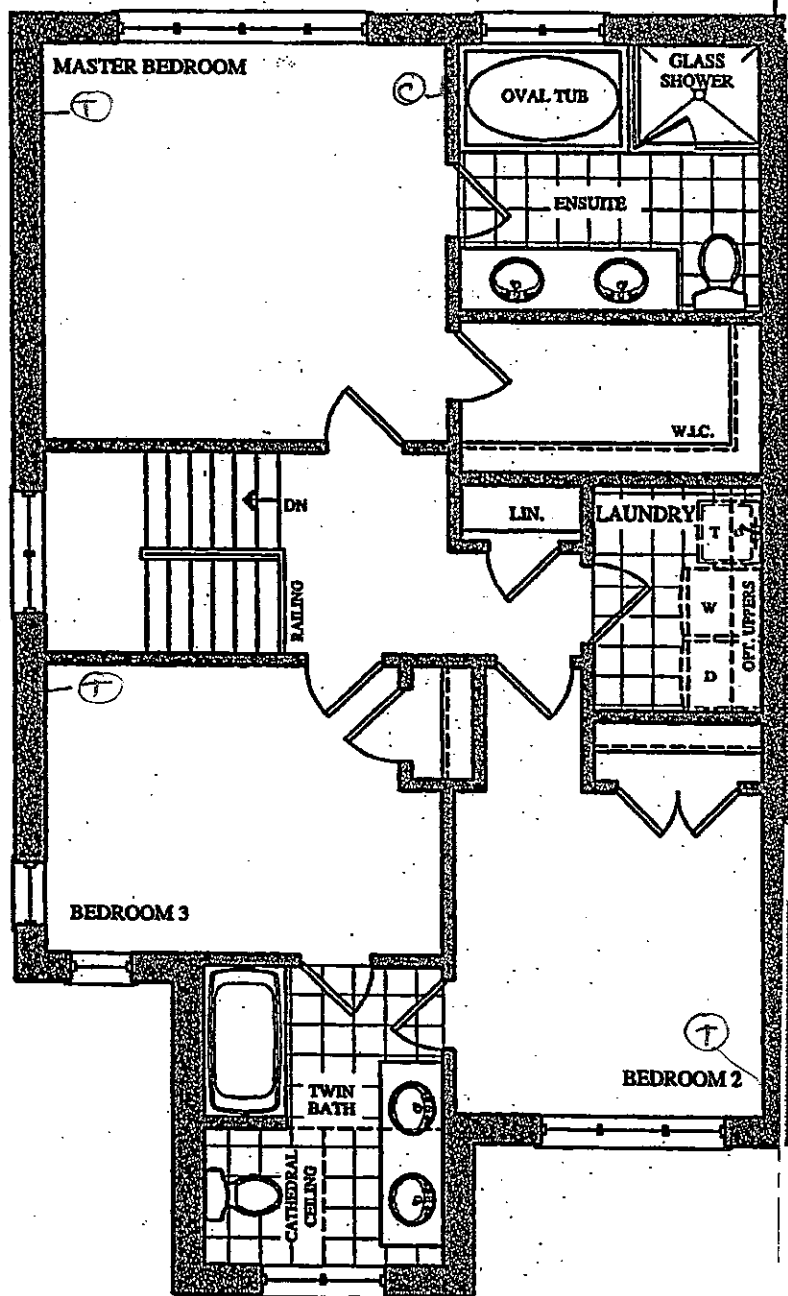


SECOND FLOOR PLAN
 ELEV. 'A'

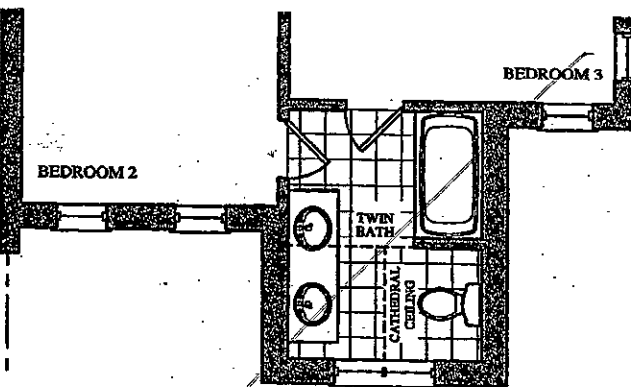

PART. SECOND FLOOR PLAN
 ELEV. 'B'

Lot 55L
 July 18, 17

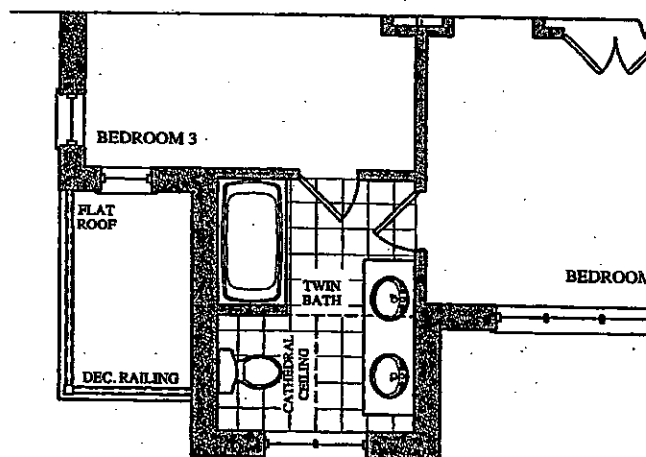


PART. SECOND FLOOR PLAN
 ELEV. 'C'

The
Siren
SEMI SERIES

Elevation A • 1,688 sq.ft.
Elevation B • 1,677 sq.ft.
Elevation C • 1,687 sq.ft.

BSMNT WINDOWS
2 x 30"x24"

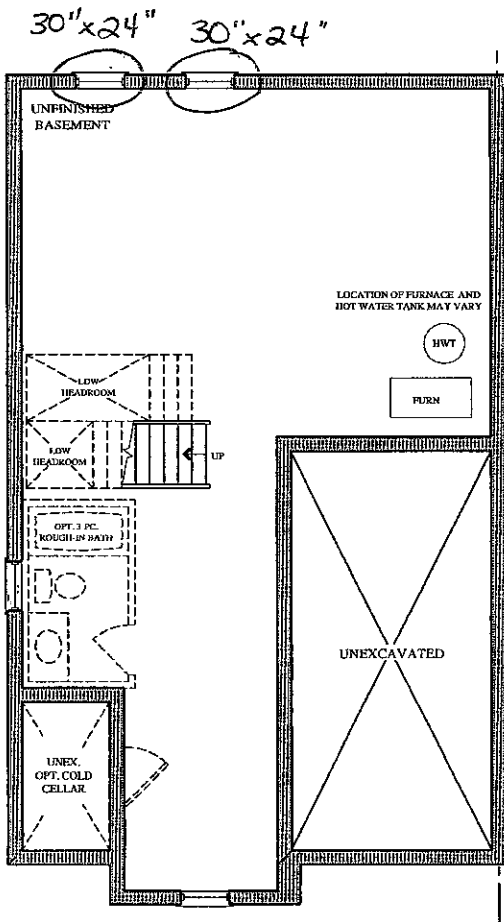

BASEMENT FLOOR PLAN
ELEV. 'A', 'B' & 'C'

Prices, figures, illustrations, sizes, features and finishes are subject to change without notice. Areas and dimensions are approximate and actual usable floor space may vary from the stated area. Layout may be reverse of the unit purchased. E. & O.E.

GOLDPARK
WORTH MORE™

Lot 55 L
July 18, 17
Two circular stamps are located below the date. The first stamp contains a checkmark, and the second stamp contains the letters 'HA'.