

Brampton Encore - 61R - 2 - 28-2 Elev.B Siren

CONCRETE AND DRAIN

Inv.1,436	1 - BASEMENT: ROUGH-IN - 3PC BASEMENT ROUGH-IN
Line22504	Note:
13Jun17 / 21Nov17	

ELECTRICAL

Inv.1,436	1 - FAMILY ROOM: 110V WALL RECEPTACLE ON NORMAL CIRCUIT- LOCATE ABOVE FIREPLACE, APPROX. 66" A.F.F.
Line22502	Note:
13Jun17 / 21Nov17	

Inv.1,436	1 - KITCHEN: RELOCATE STANDARD FIXTURE - LOCATE APPROX. CENTER ABOVE ISLAND
Line22503	Note:
13Jun17 / 21Nov17	

Exterior Colours

Inv.1,436	1 - EXTERIOR COLOUR PACKAGE #6
Line24749	Note:
13Jun17 / 21Nov17	

MISC.

Inv.1,436	1 - REFUND- SIDE DOOR- HOME TO EXTERIOR- AS PER PLAN AND GRADE PERMITTING
Line22505	Note:
13Jun17 / 21Nov17	

Inv.1,436	1 - Purchaser has attended an appointment at the Decor Centre & has DECLINED any additional upgrades and accepts and acknowledges that there will be no further changes/additions/deletions to be made upon signing on June 13 2017.
Line22507	Note:
13Jun17 / 21Nov17	

Inv.1,436	1 - Purchasers are aware & accepts that ANY changes made to upgrades after signing this Purchasers Extra Form are subject to a minimum administration fee of \$500. PLUS a 10% holdback fee.
Line22508	Note:
13Jun17 / 21Nov17	

Inv.1,436	1 - BONUS PACKAGE: \$5,000.00 (INCLUDING TAXES) WORTH OF UPGRADES FROM GOLD PARK HOMES DÉCOR CENTRE IS BEING APPLIED TOWARD THE STRUCTURAL APPOINTMENT. PURCHASER HAS A REMAINING AMOUNT OF \$00 (INCLUDING TAXES) TO BE USED TOWARD THE COLOUR APPOINTMENT.
Line22509	Note:
13Jun17 / 21Nov17	

WINDOWS - BASEMENT

Inv.1,436	2 - BASEMENT WINDOWS - UPGRADE EXISTING BASEMENT WINDOW TO 30 INCH X 24 INCH - MAY REQUIRE INSTALLATION OF WINDOW WELL
Line22506	Note:
13Jun17 / 21Nov17	

BE2-61R
JUNE 13 2017

0A 1A


The Siren

SEMI SERIES


Elevation A • 1,688 sq.ft.

→ Elevation B • 1,677 sq.ft.

Elevation C • 1,687 sq.ft.

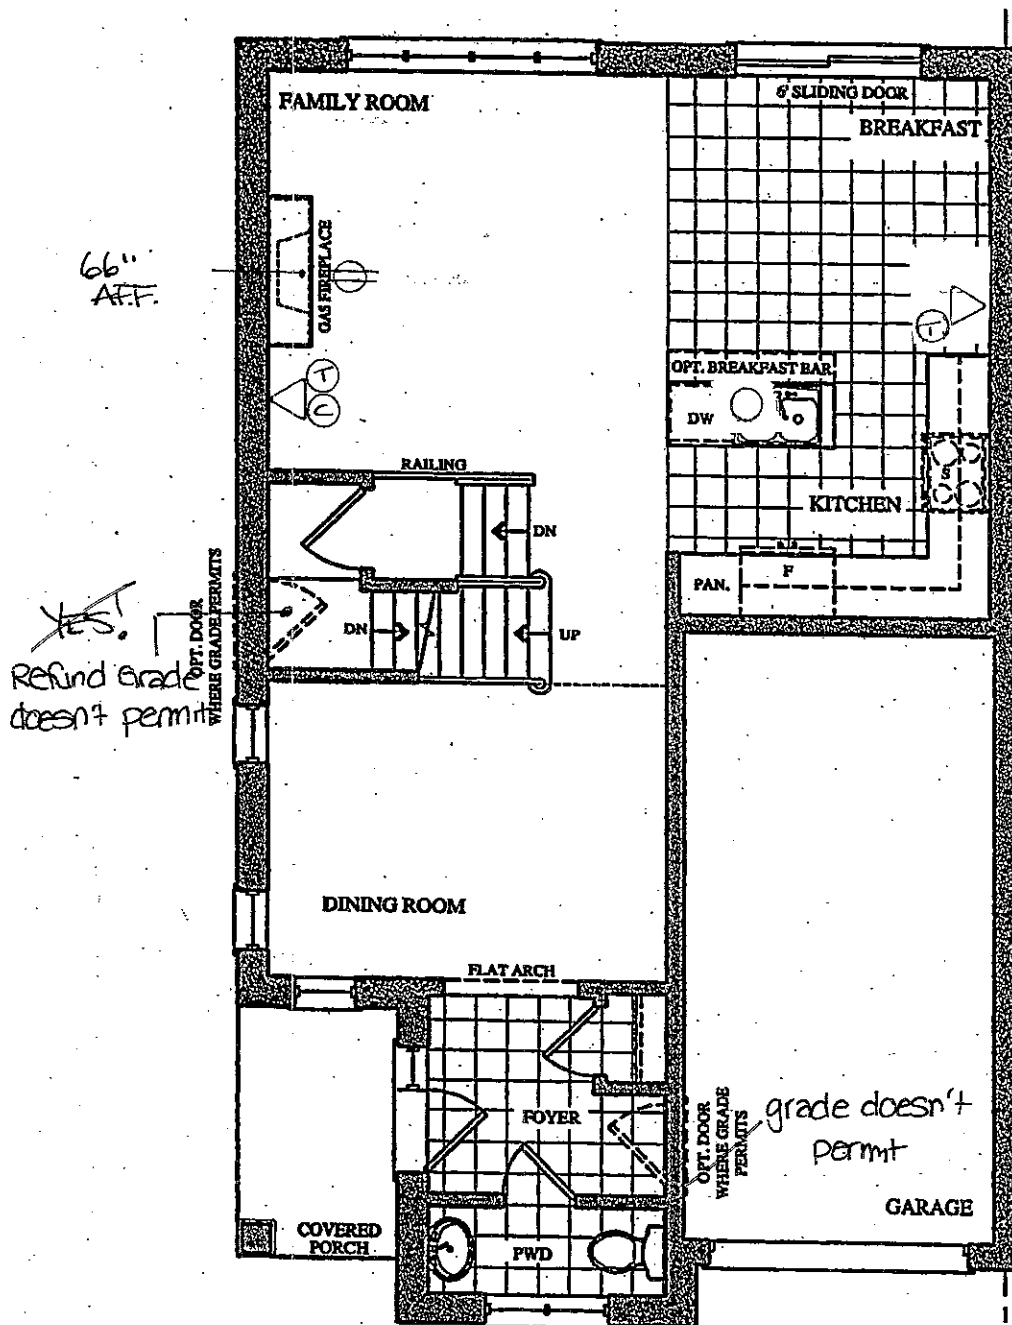

GROUND FLOOR PLAN
ELEV. 'A' & 'B'

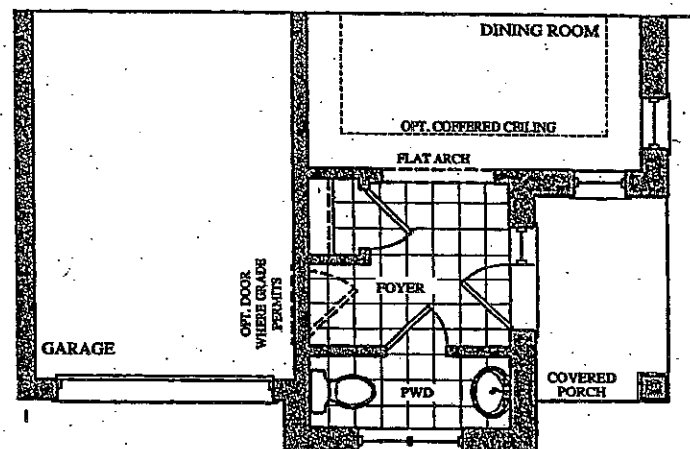


PART. GROUND FLOOR PLAN
ELEV. 'C'

BEZ-61R
JUNE 13 2017


OK VA

The Siren SEMI SERIES


Elevation A • 1,688 sq.ft.
Elevation B • 1,677 sq.ft.
Elevation C • 1,687 sq.ft.

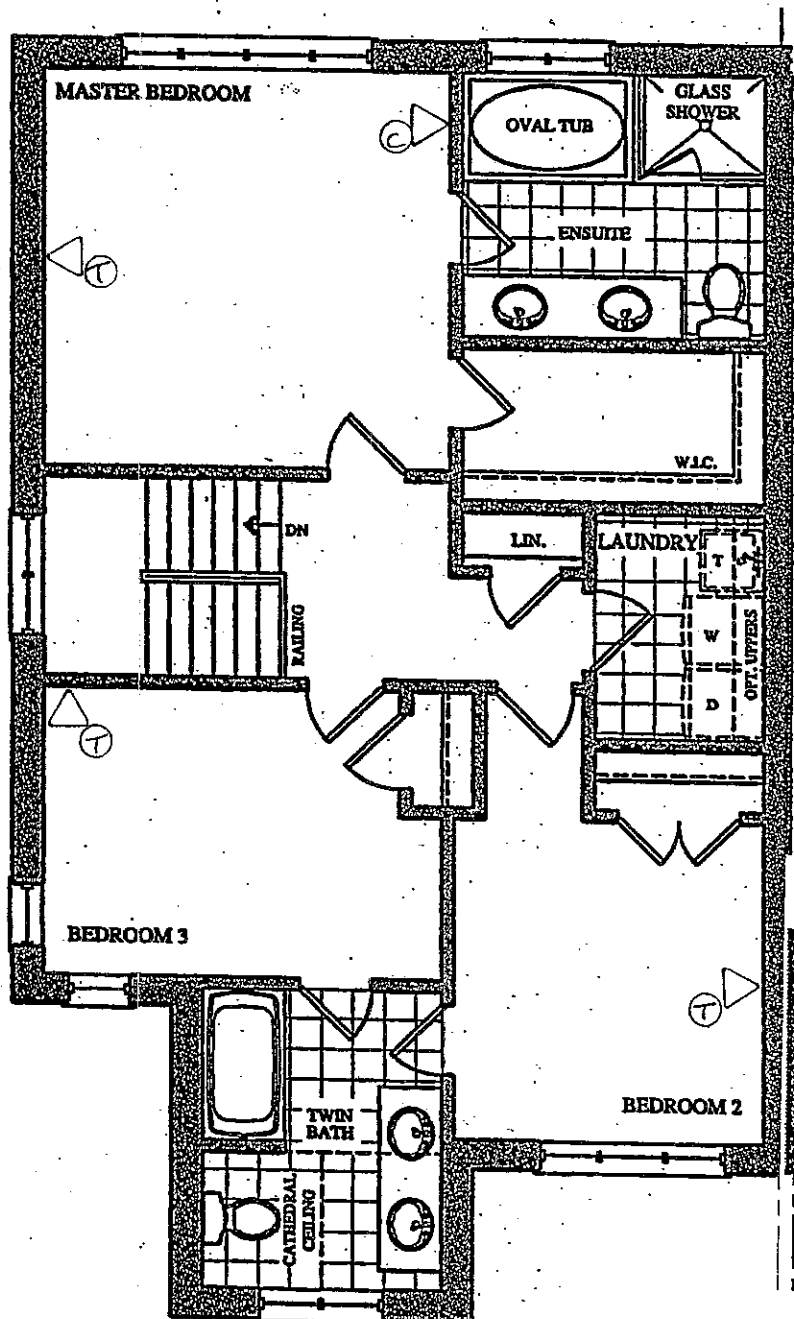

SECOND FLOOR PLAN
ELEV. 'A'

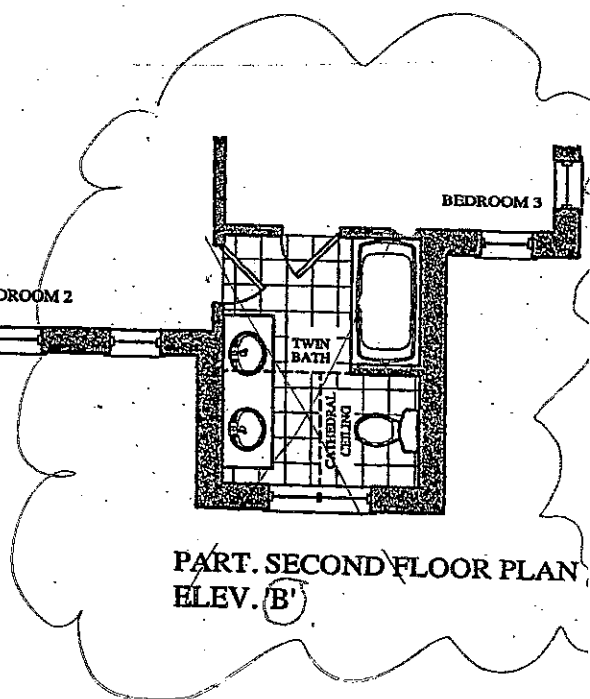

PART. SECOND FLOOR PLAN
ELEV. 'B'

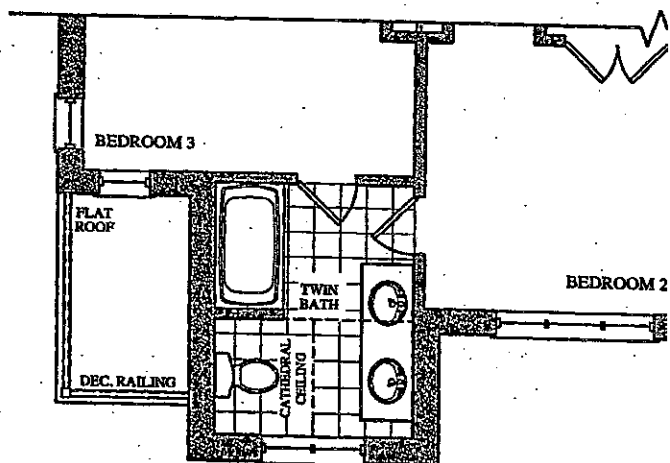

PART. SECOND FLOOR PLAN
ELEV. 'C'

BEZ-61R
JUNE 13 2017

DA VA

The Siren

SEMI SERIES

Elevation A • 1,688 sq.ft.
→ Elevation B • 1,677 sq.ft.
Elevation C • 1,687 sq.ft.

