

Brampton Encore - 38L - 2 - 28-4 Elev.C ROSSINI
CENTRAL VAC AND WIRING

Inv.1,505	1 - TELEPHONE AND CABLE ROUGH-IN LOCATIONS
Line23300	Note:
13Jul17 / 21Nov17	

CONCRETE AND DRAIN

Inv.1,505	1 - BASEMENT: INSTALL ROUGH-IN - 3PC BASEMENT ROUGH-IN
Line23306	Note:
13Jul17 / 21Nov17	

Inv.1,505	1 - BASEMENT: INSTALL BACKFLOW PREVENTER VALVE
Line23307	Note:
13Jul17 / 21Nov17	

ELECTRICAL

Inv.1,505	1 - LIVING ROOM: INSTALL ROUGH - IN CEILING OUTLET & SWITCH (WITH COVER PLATE) - DOES NOT INCLUDE FIXTURE - MUST SPECIFY LOCATION
Line23301	Note:
13Jul17 / 21Nov17	

Exterior Colours

Inv.1,505	1 - EXTERIOR COLOUR PACKAGE 7
Line24739	Note:
13Jul17 / 21Nov17	

FRAMING

Inv.1,505	1 - GARAGE: INSTALL MANDOOR - GARAGE TO HOUSE- AS PER PLAN AND GRADE PERMITTING
Line23304	Note:
13Jul17 / 21Nov17	

MISC.

Inv.1,505	1 - REFUND- EXTERIOR: INSTALL SIDE DOOR- HOME TO EXTERIOR- AS PER PLAN AND GRADE PERMITTING
Line23303	Note:
13Jul17 / 21Nov17	

Inv.1,505	1 - BONUS PACKAGE: \$5,000.00 (INCLUDING TAXES) WORTH OF UPGRADES FROM GOLD PARK HOMES DÉCOR CENTRE IS BEING APPLIED TOWARD THE STRUCTURAL APPOINTMENT. PURCHASER HAS A REMAINING AMOUNT OF \$00 (INCLUDING TAXES) TO BE USED TOWARD THE COLOUR APPOINTMENT.
Line23308	Note:
13Jul17 / 21Nov17	

Inv.1,505	1 - Purchaser has attended a Structural appointment at the Decor Centre & has DECLINED any additional upgrades and accepts and acknowledges that there will be no further structural changes/additions/deletions to be made upon signing on July 13, 2017
Line23309	Note:
13Jul17 / 21Nov17	

Inv.1,505	1 - Purchasers are aware & accepts that ANY changes made to upgrades after signing this Purchasers Extra Form are subject to a minimum administration fee of \$500. PLUS a 10% holdback fee
Line23310	Note:
13Jul17 / 21Nov17	

WINDOWS - BASEMENT

Brampton Encore - 38L - 2 - 28-4 Elev.C ROSSINI

Inv.1,505	3 - BASEMENT: INSTALL THREE (X3) BASEMENT WINDOWS - UPGRADE EXISTING BASEMENT WINDOW TO 30 INCH X 24 INCH - MAY REQUIRE INSTALLATION OF WINDOW WELL
	SEE SKETCH FOR LOCATIONS
Line23305	Note:
13Jul17 / 21Nov17	

WINDOWS AND DOORS


Inv.1,505	1 - GARAGE: INSTALL MANDOOR - GARAGE TO HOUSE- AS PER PLAN AND GRADE PERMITING
Line24741	Note:
13Jul17 / 21Nov17	


Telephone - (T)
Cable - (C)

The Rossini


SEMI SERIES

Elevation A • 1,911 sq.ft.
Elevation B • 1,902 sq.ft.
Elevation C • 1,966 sq.ft.
Elevation D • 1,971 sq.ft.

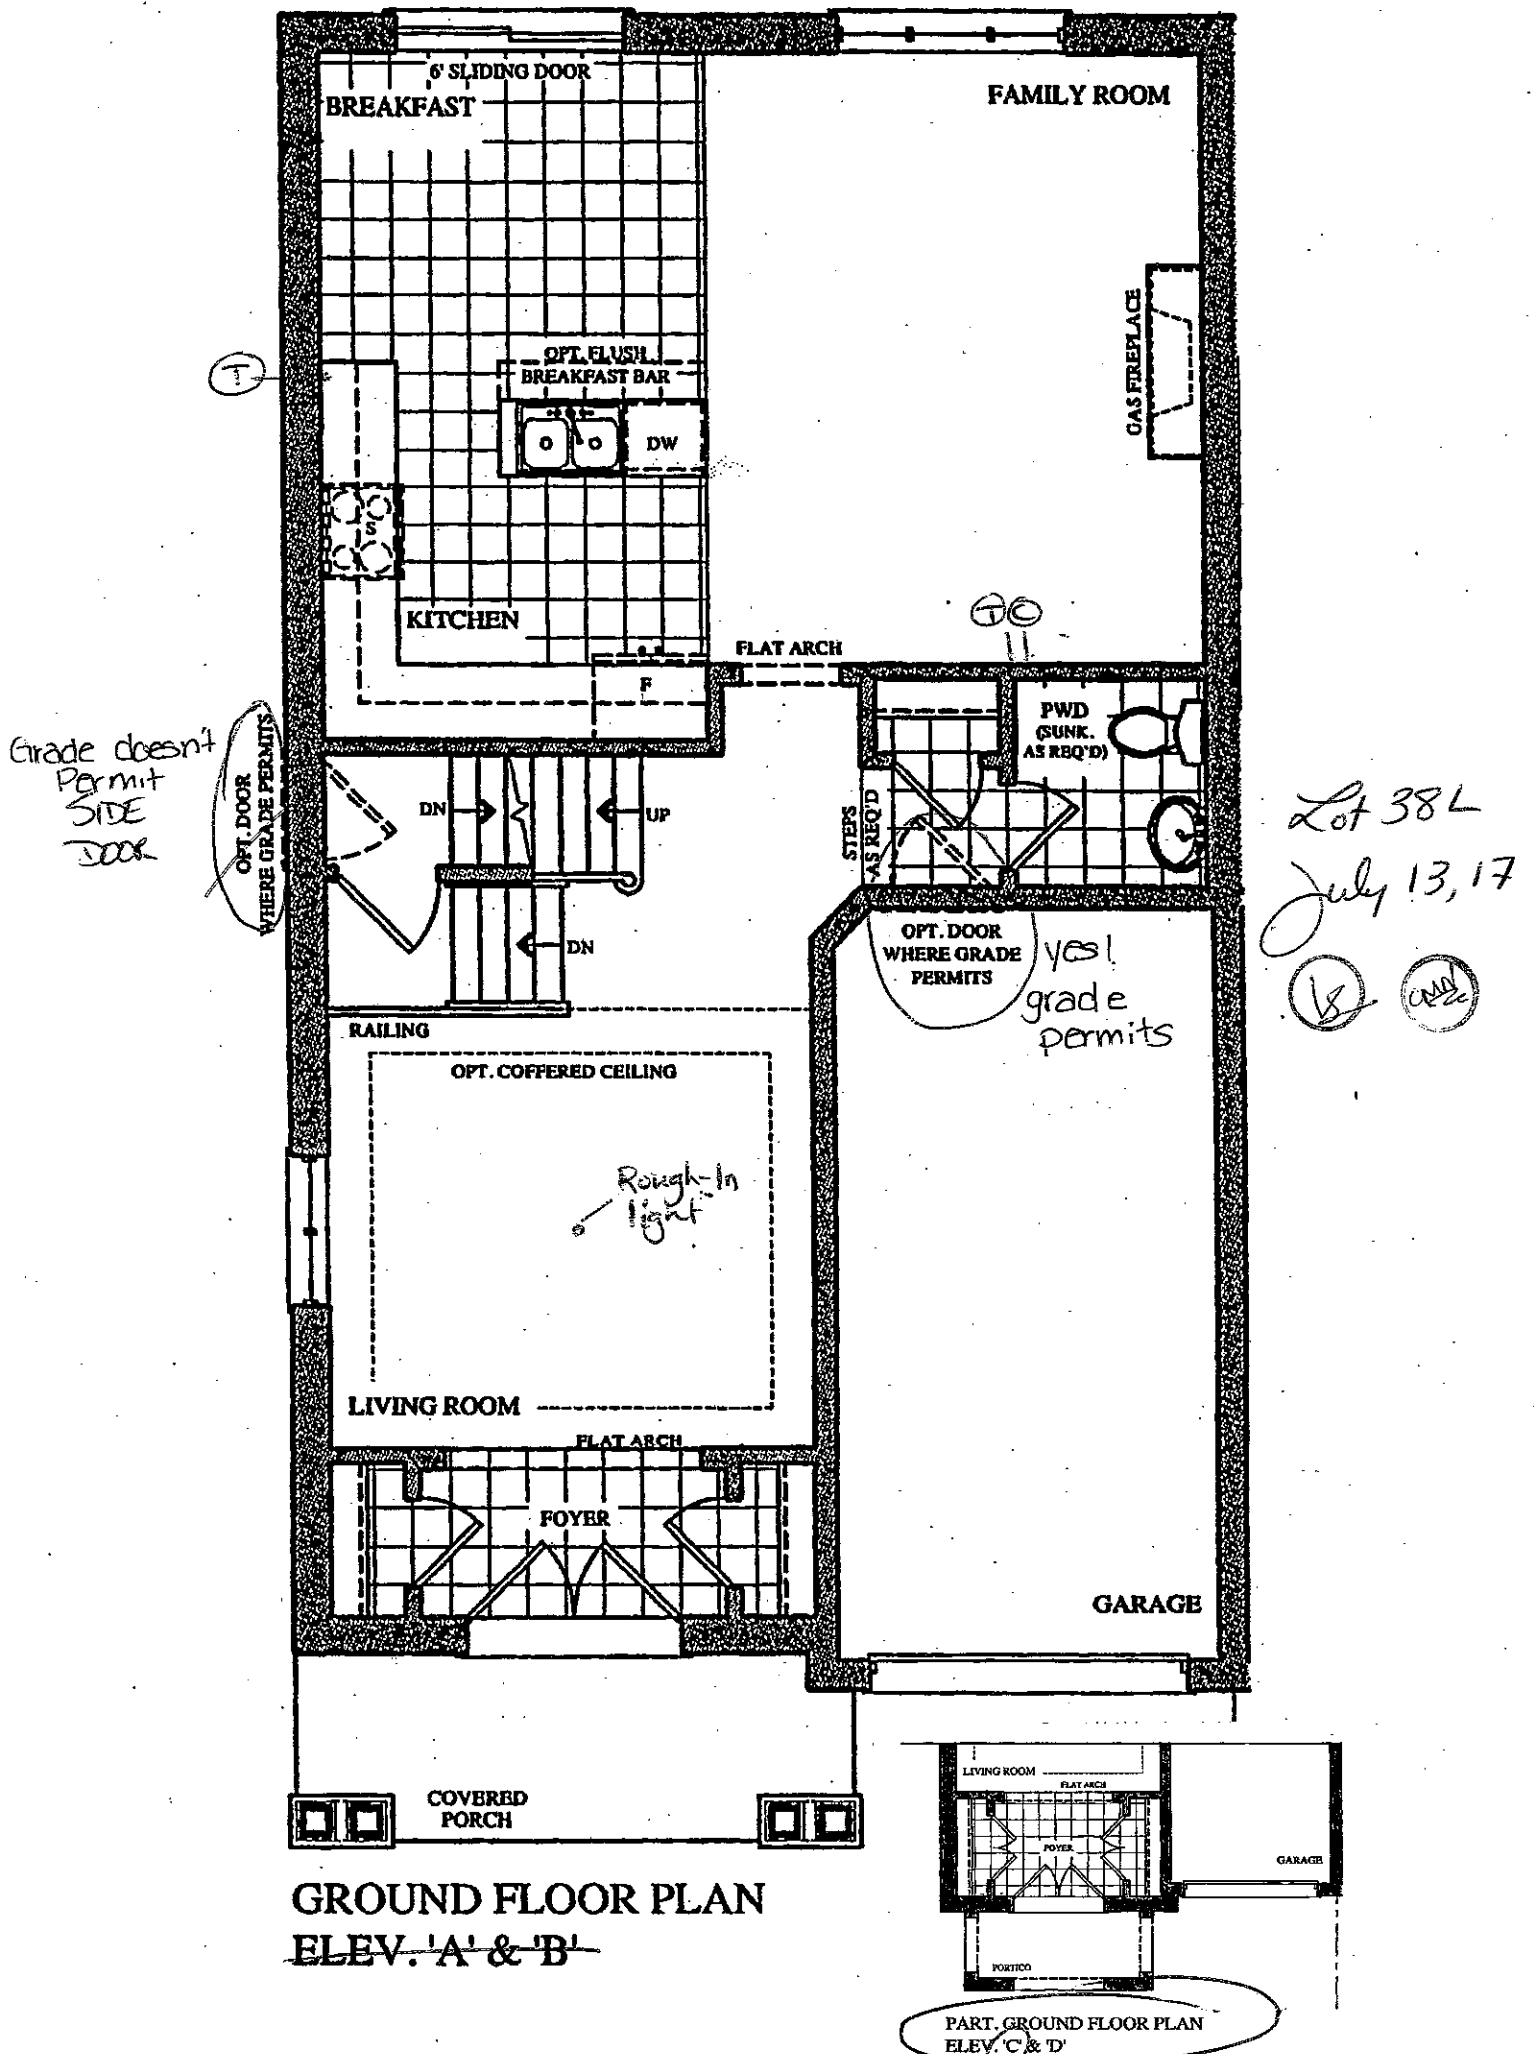

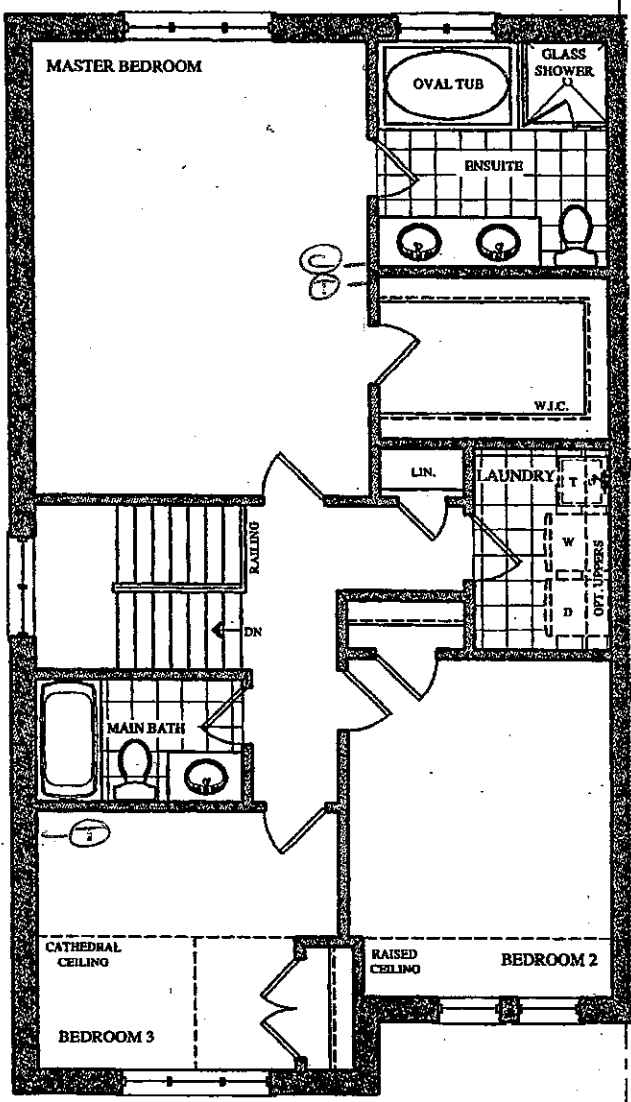

SECOND FLOOR PLAN
ELEV. 'A'

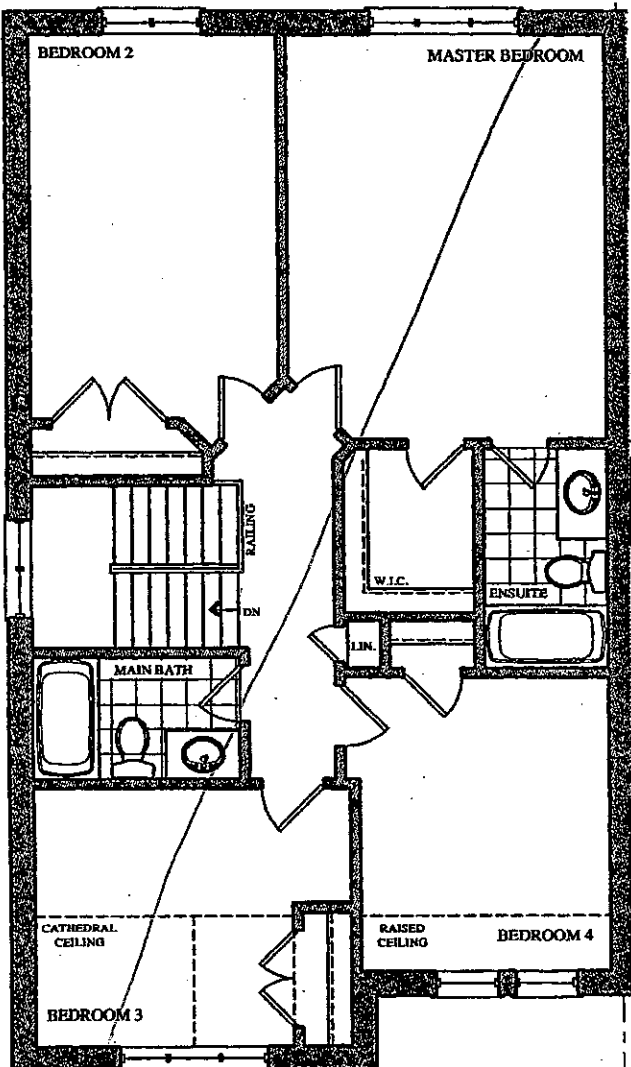


OPT. SECOND FLOOR PLAN
ELEV. 'A'


Telephone — (T)
Cable — (C)

The Rossini SEMI SERIES


Elevation A • 1,911 sq.ft.
Elevation B • 1,902 sq.ft.
Elevation C • 1,966 sq.ft.
Elevation D • 1,971 sq.ft.

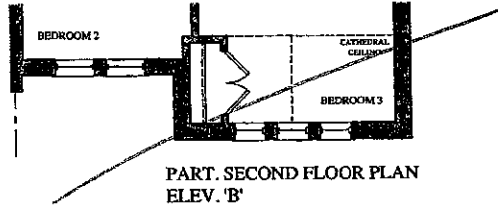


PART. SECOND FLOOR PLAN
ELEV. 'B'

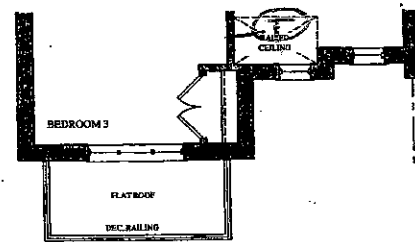


PART. SECOND FLOOR PLAN
ELEV. 'C'

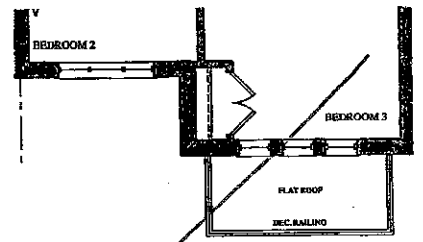


PART. SECOND FLOOR PLAN
ELEV. 'D'

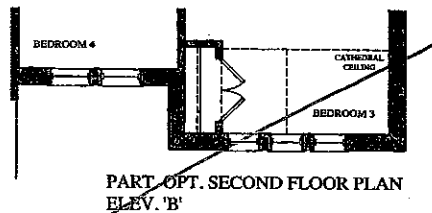

PART. OPT. SECOND FLOOR PLAN
ELEV. 'B'

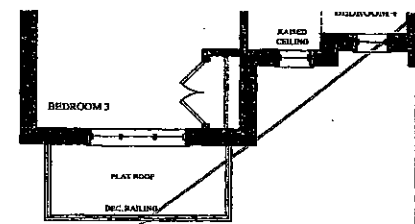

PART. OPT. SECOND FLOOR PLAN
ELEV. 'C'

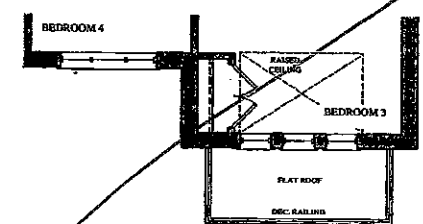

PART. OPT. SECOND FLOOR PLAN
ELEV. 'D'


Lot 38L
July 13, 17

(18) (CML)

ROSSINI SEMI SERIES

BSMNT WINDOWS
3 x 30"x24"

Elevation A • 1,911 sq.ft.
Elevation B • 1,902 sq.ft.
Elevation C • 1,966 sq.ft.
Elevation D • 1,971 sq.ft.

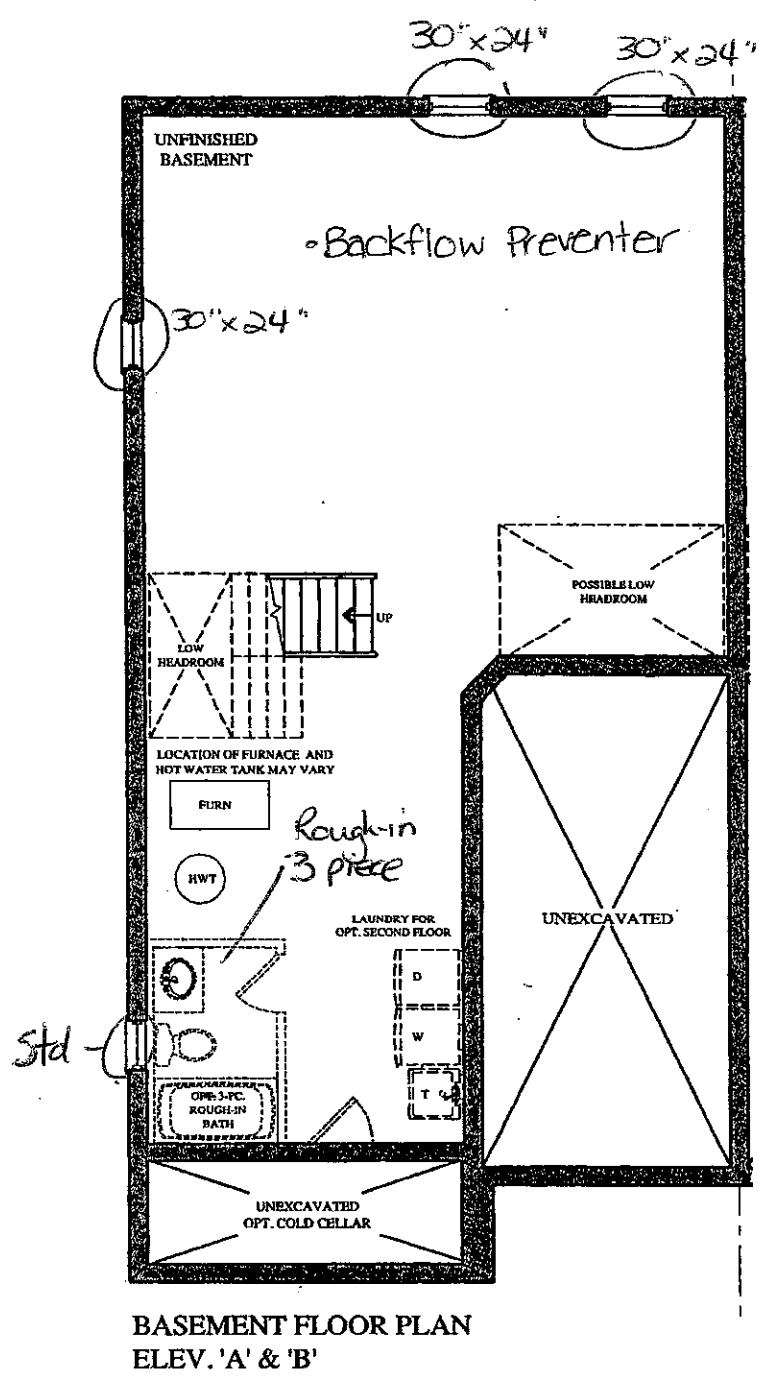

Lot 38L
July 13, 17

(LS) (CMAA)

