

Brampton Encore - 28L - 2 - 28-2 Elev.CL Siren

CENTRAL VAC AND WIRING

Inv.1,443	1 - FAMILY ROOM: CONDUIT PIPE- FOR TELEVISION- LOCATE APPROX. 66" A.F.F. ABOVE FIREPLACE, TERMINATING BY CABLE OUTLET, SEE PLAN FOR LOCATION.
Line22645	Note:
19Jun17 / 22Nov17	

CONCRETE AND DRAIN

Inv.1,443	1 - ROUGH-IN - 3PC BASEMENT ROUGH-IN
Line22647	Note:
19Jun17 / 22Nov17	

ELECTRICAL

Inv.1,443	1 - FAMILY ROOM: 110V WALL RECEPTACLE ON NORMAL CIRCUIT- LOCATE APPROX. 66" A.F.F. ABOVE FIREPLACE
Line22644	Note:
19Jun17 / 22Nov17	
Inv.1,443	1 - 200 AMP ELECTRICAL SERVICE
Line22646	Note:
19Jun17 / 22Nov17	
Inv.1,443	1 - HUMIDIFIER: WB3 - 12 (UP TO 2,000 SQ.FT.)
Line24783	Note:
19Jun17 / 22Nov17	

Exterior Colours

Inv.1,443	1 - EXTERIOR COLOUR PACKAGE #1
Line24784	Note:
19Jun17 / 22Nov17	

FRAMING

Inv.1,443	1 - MAIN FLOOR: FRAME MAIN FLOOR DOORS AND ARCHES AT 96" - ADDED WITH THE ADDITION OF TALLER INTERIOR DOORS
Line22652	Note:
19Jun17 / 22Nov17	

HVAC

Inv.1,443	1 - HUMIDIFIER: WB3 - 12 (UP TO 2,000 SQ.FT.)
Line22650	Note:
19Jun17 / 22Nov17	
Inv.1,443	1 - 2 ton A/C Unit
Line22651	Note:
19Jun17 / 22Nov17	

INTERIOR TRIM AND DOORS

Inv.1,443	1 - MAIN FLOOR: EXTENDED HEIGHT ARCHWAY (PRICE PER DOORWAY) -96"
Line22653	Note:
19Jun17 / 22Nov17	
Inv.1,443	3 - MAIN FLOOR: STANDARD DOOR EXTENDED HEIGHT 96" (PRICE PER DOOR)- GROUND FLOOR 2 STOREY MODELS
Line22654	Note:
19Jun17 / 22Nov17	

Brampton Encore - 28L - 2 - 28-2 Elev.CL Siren

MISC.

Inv.1,443	1 - REFUND- SIDE DOOR- HOME TO EXTERIOR- AS PER PLAN AND GRADE DOESN'T PERMIT
Line22648	Note:
19Jun17 / 22Nov17	
Inv.1,443	1 - Purchaser has attended an appointment at the Decor Centre & has DECLINED any additional upgrades and accepts and acknowledges that there will be no further changes/additions/deletions to be made upon signing on June 20 2017.
Line22689	Note:
19Jun17 / 22Nov17	
Inv.1,443	1 - Purchasers are aware & accepts that ANY changes made to upgrades after signing this Purchasers Extra Form are subject to a minimum administration fee of \$500. PLUS a 10% holdback fee.
Line22690	Note:
19Jun17 / 22Nov17	
Inv.1,443	1 - BONUS PACKAGE: \$5,000.00 (INCLUDING TAXES) WORTH OF UPGRADES FROM GOLD PARK HOMES DÉCOR CENTRE IS BEING APPLIED TOWARD THE STRUCTURAL APPOINTMENT. PURCHASER HAS A REMAINING AMOUNT OF \$00 (INCLUDING TAXES) TO BE USED TOWARD THE COLOUR APPOINTMENT.
Line22691	Note:
19Jun17 / 22Nov17	

PLUMBING

Inv.1,443	1 - HUMIDIFIER: WB3 - 12 (UP TO 2,000 SQ.FT.)
Line24782	Note:
19Jun17 / 22Nov17	

WINDOWS - BASEMENT

Inv.1,443	2 - BASEMENT WINDOWS - UPGRADE EXISTING BASEMENT WINDOW TO 30 INCH X 24 INCH - MAY REQUIRE INSTALLATION OF WINDOW WELL
Line22649	Note: SEE PLAN FOR LOCATION
19Jun17 / 22Nov17	


BEZ-28L
JUNE 19 2017



The Siren

SEMI SERIES


Elevation A • 1,688 sq.ft.
Elevation B • 1,677 sq.ft.
Elevation C • 1,687 sq.ft.

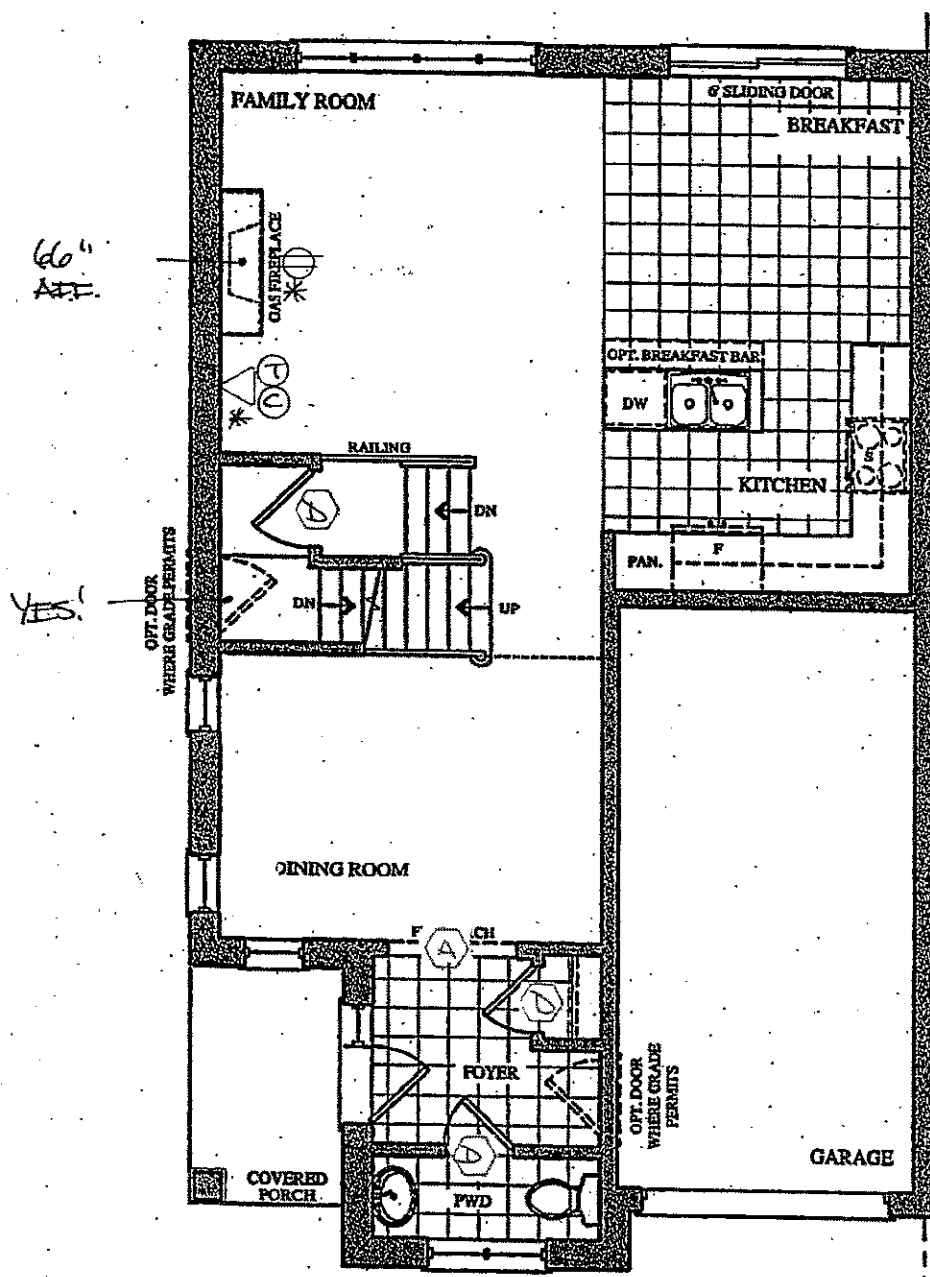

LEGEND

- ⊙ ELECTRICAL OUTLET
- * CONDUIT
- △ PHONE
- △ CABLE
- ⬡ 96" DOOR
- ⬡ 96" ARCH.

GROUND FLOOR PLAN
ELEV. 'A' & 'B'

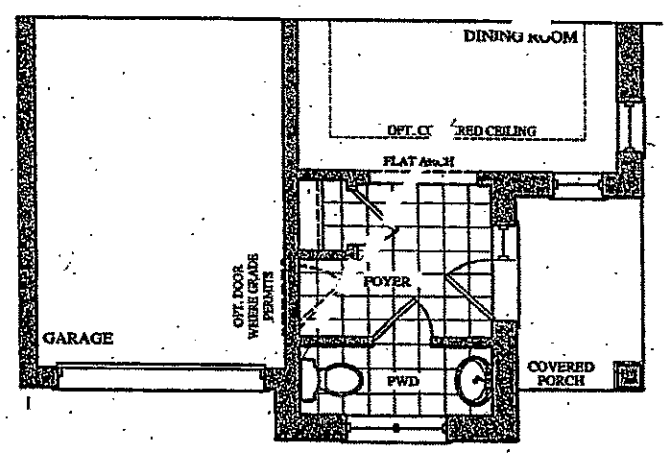

PART. GROUND FLOOR PLAN
ELEV. 'C'

BEZ-28L


JUNE 19 2017




The Siren

SEMI SERIES


Elevation A • 1,688 sq.ft.
Elevation B • 1,677 sq.ft.
Elevation C • 1,687 sq.ft.

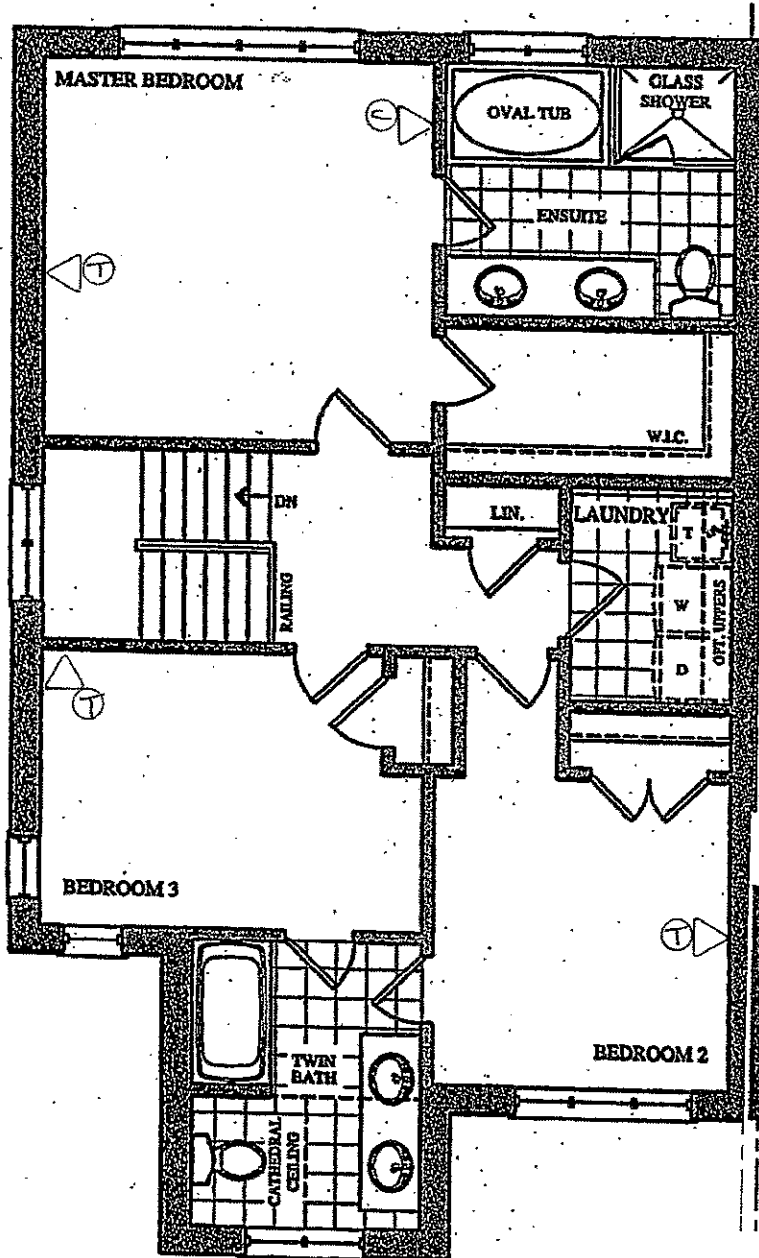

SECOND FLOOR PLAN
ELEV. 'A'

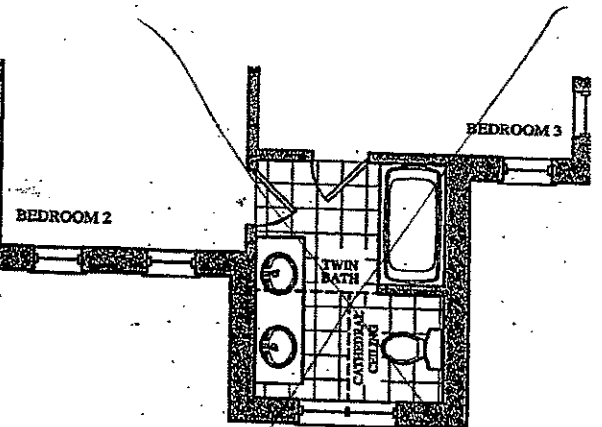

PART. SECOND FLOOR PLAN
ELEV. 'B'

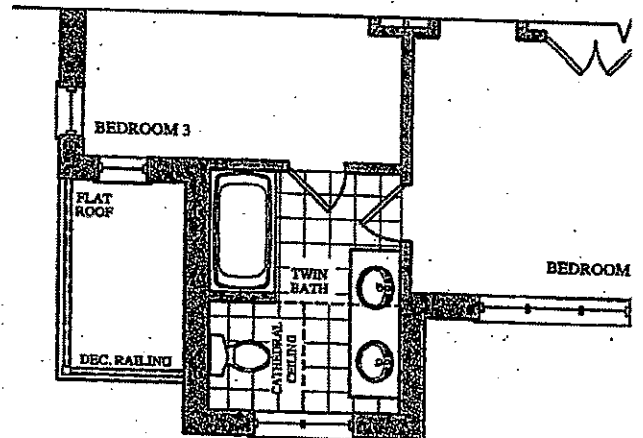

PART. SECOND FLOOR PLAN
ELEV. 'C'

BEZ-28L

JUNE 19 2017



The Siren

SEMI SERIES

Elevation A • 1,688 sq.ft.

Elevation B • 1,677 sq.ft.

→ Elevation C • 1,687 sq.ft.

