

Brampton Encore - 29L - 2 - 28-4 Elev.C Rossini OPT4

CONCRETE AND DRAIN

Inv.1,484	1 - ROUGH-IN - 3PC BASEMENT ROUGH-IN
Line23053	Note:
6Jul17 / 22Nov17	

ELECTRICAL

Inv.1,484	1 - KITCHEN: RELOCATE STANDARD CEILING LIGHT TO APPROX CENTER ABOVE ISLAND.
Line23052	Note:
6Jul17 / 22Nov17	

Exterior Colours

Inv.1,484	1 - EXTERIOR COLOUR PACKAGE #8
Line24780	Note:
6Jul17 / 22Nov17	

FRAMING

Inv.1,484	1 - MAIN FLOOR: EXTENDED HEIGHT ARCHWAY (PRICE PER DOORWAY) - 96"
Line24779	Note:
6Jul17 / 22Nov17	

INTERIOR TRIM AND DOORS

Inv.1,484	2 - MAIN FLOOR: EXTENDED HEIGHT ARCHWAY (PRICE PER DOORWAY) - 96"
Line23056	Note:
6Jul17 / 22Nov17	

MISC.

Inv.1,484	1 - REFUNDED- SIDE DOOR- HOME TO EXTERIOR- AS PER PLAN AND GRADE DOESN'T PERMIT
Line23055	Note:
6Jul17 / 22Nov17	
Inv.1,484	1 - Purchaser has attended an appointment at the Decor Centre & has DECLINED any additional upgrades and accepts and acknowledges that there will be no further changes/additions/deletions to be made upon signing on July 6 2017.
Line23057	Note:
6Jul17 / 22Nov17	
Inv.1,484	1 - Purchasers are aware & accepts that ANY changes made to upgrades after signing this Purchasers Extra Form are subject to a minimum administration fee of \$500. PLUS a 10% holdback fee.
Line23058	Note:
6Jul17 / 22Nov17	
Inv.1,484	1 - BONUS PACKAGE: \$5,000.00 (INCLUDING TAXES) WORTH OF UPGRADES FROM GOLD PARK HOMES DÉCOR CENTRE IS BEING APPLIED TOWARD THE STRUCTURAL APPOINTMENT. PURCHASER HAS A REMAINING AMOUNT OF \$00 (INCLUDING TAXES) TO BE USED TOWARD THE COLOUR APPOINTMENT.
Line23059	Note:
6Jul17 / 22Nov17	


WINDOWS - BASEMENT


Inv.1,484	2 - BASEMENT WINDOWS - UPGRADE EXISTING BASEMENT WINDOW TO 30 INCH X 24 INCH - MAY REQUIRE INSTALLATION OF WINDOW WELL
Line23054	Note:
6Jul17 / 22Nov17	

BEZ-29L
July 6 2017

The Rossini SEMI SERIES

Elevation A • 1,911 sq.ft.
Elevation B • 1,902 sq.ft.
→ Elevation C • 1,966 sq.ft.
Elevation D • 1,971 sq.ft.

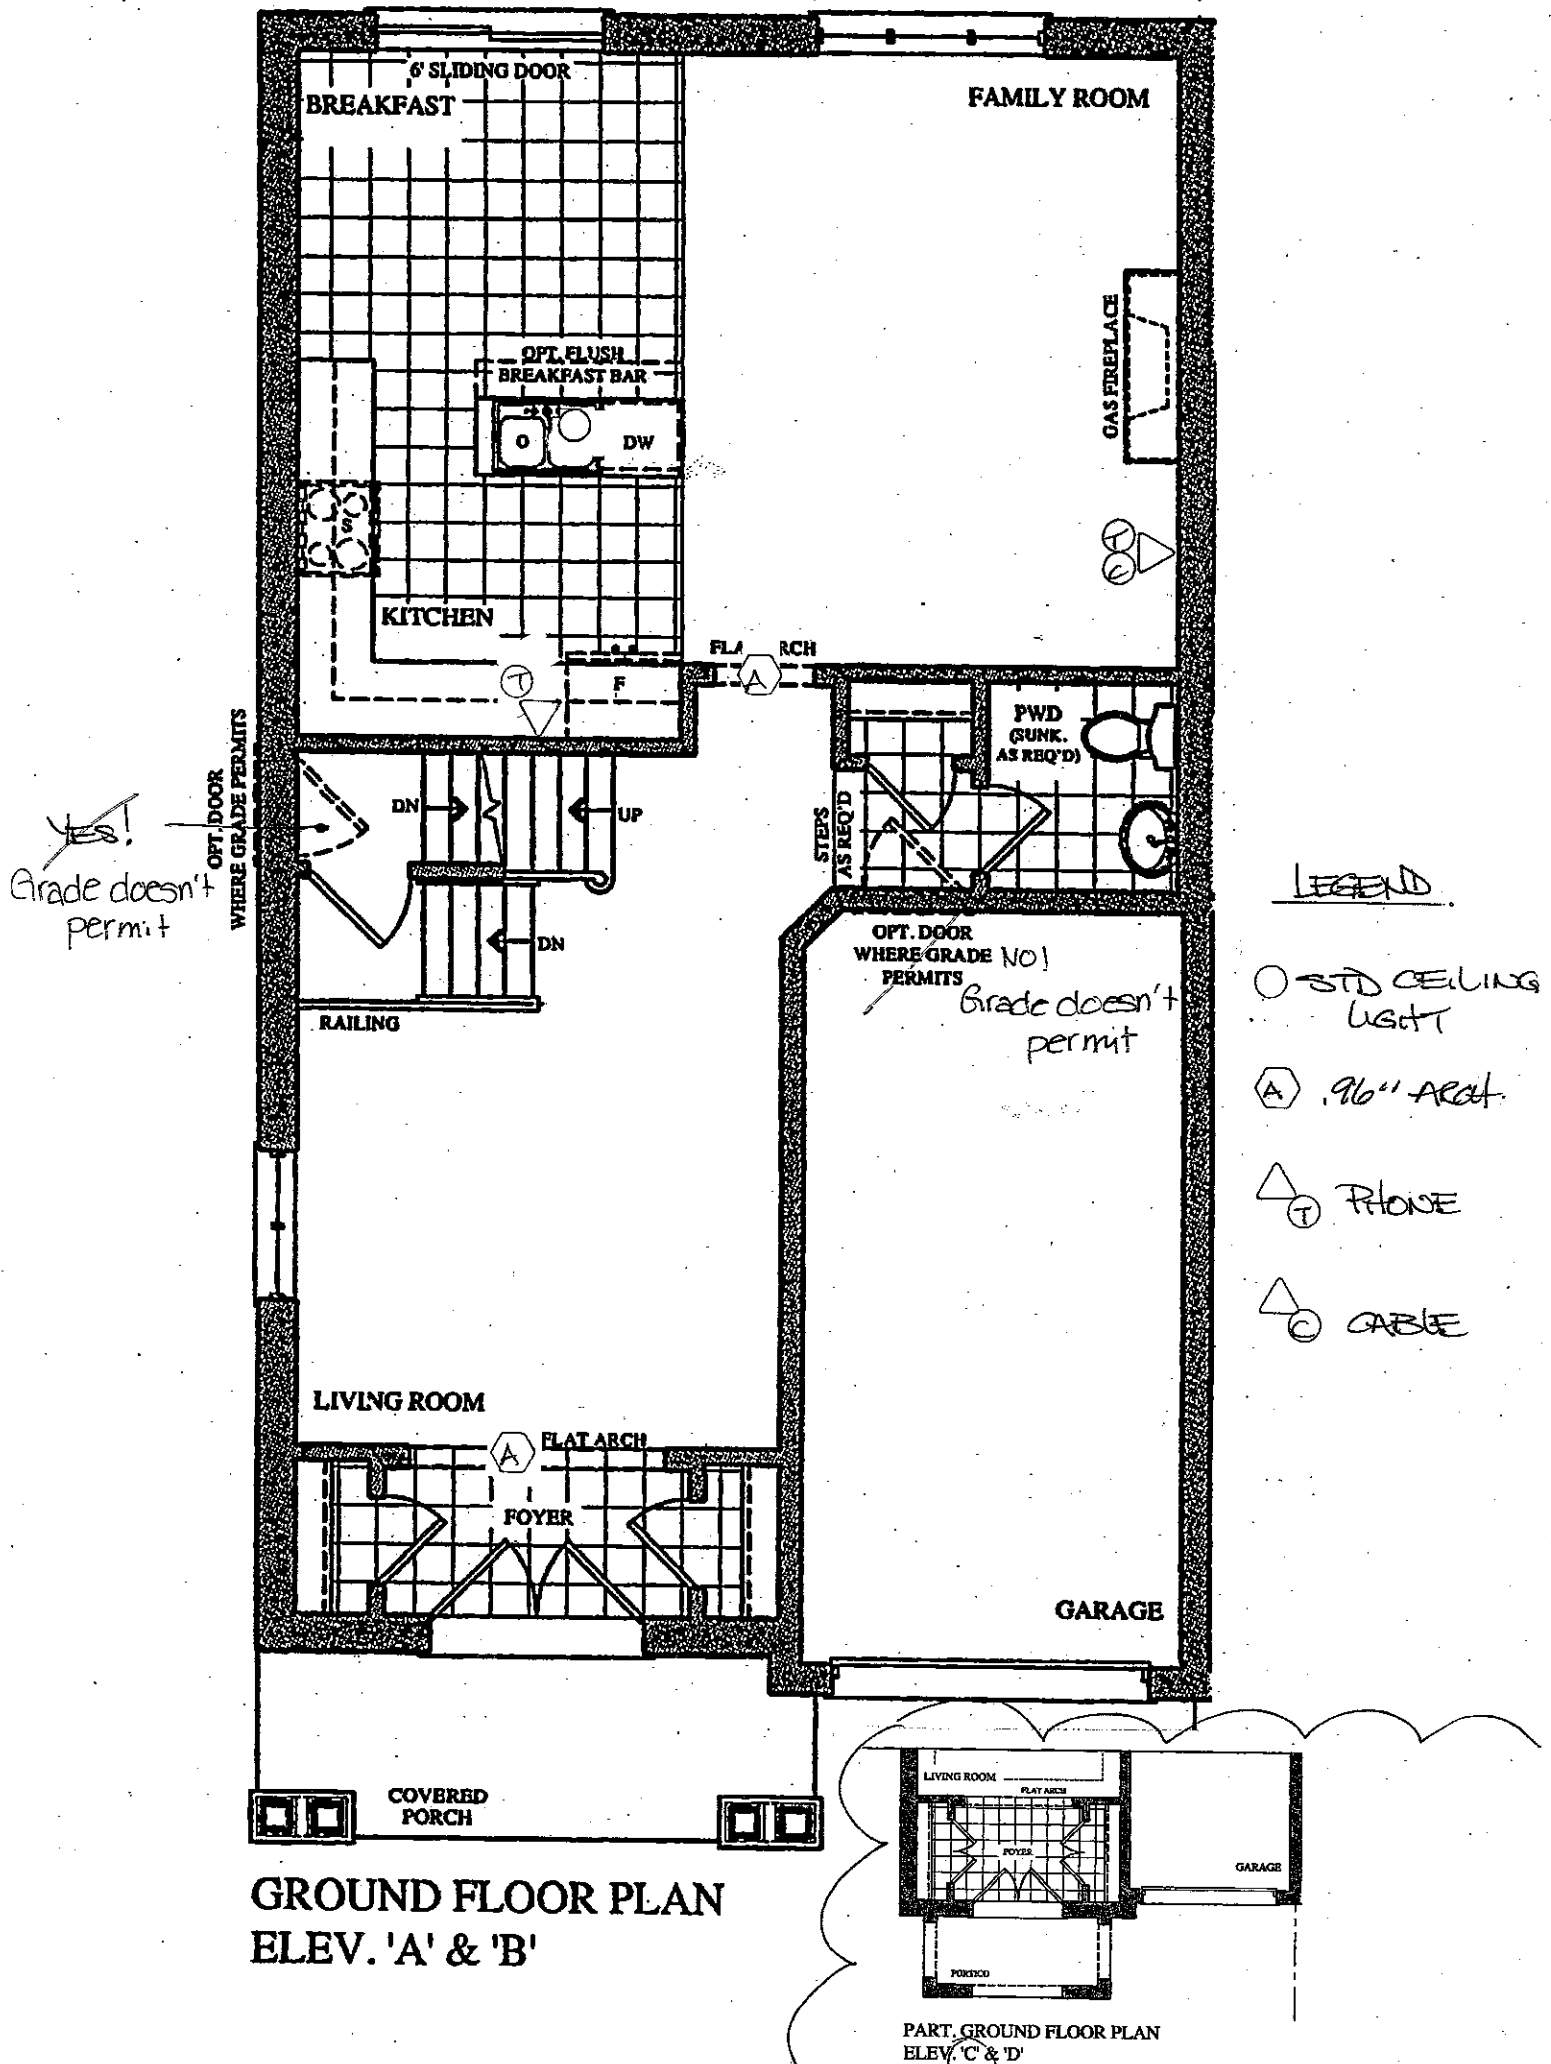

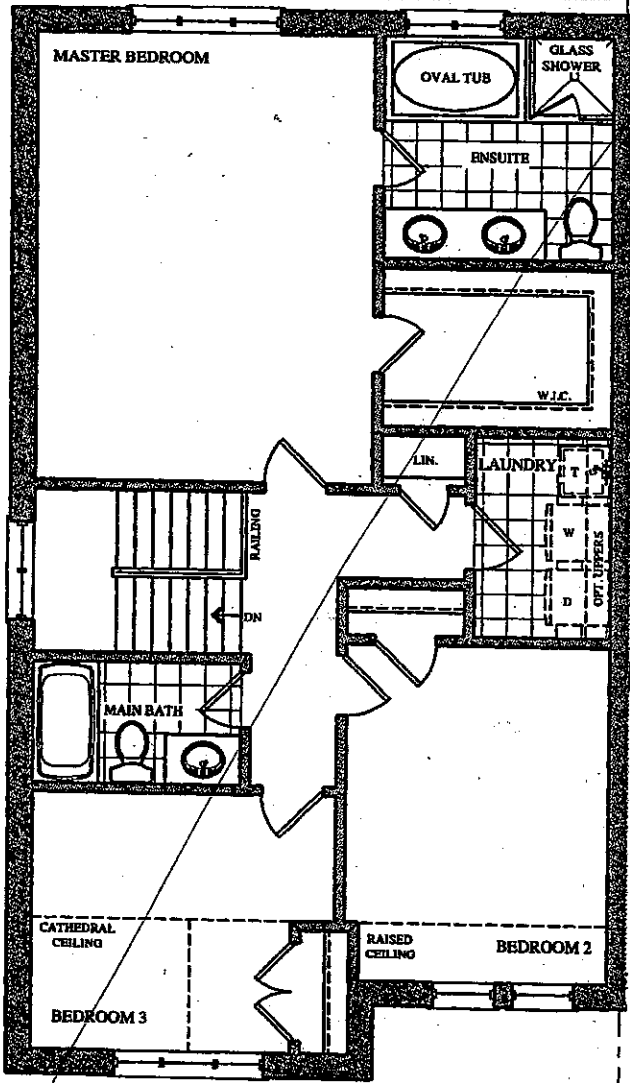


SECOND FLOOR PLAN
ELEV. 'A'


BEZ-20L (S)
July 6 2017

The Rossini SEMI SERIES


Elevation A • 1,911 sq.ft.
Elevation B • 1,902 sq.ft.
Elevation C • 1,966 sq.ft.
Elevation D • 1,971 sq.ft.

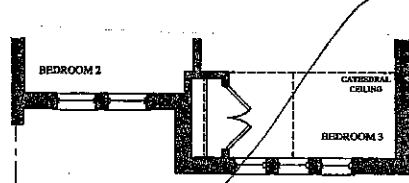


PART. SECOND FLOOR PLAN
ELEV. 'B'

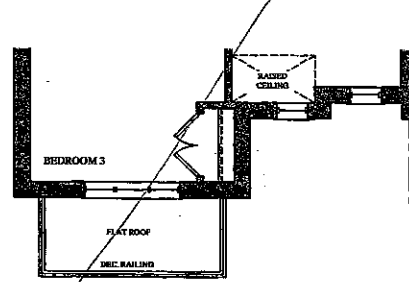


PART. SECOND FLOOR PLAN
ELEV. 'C'

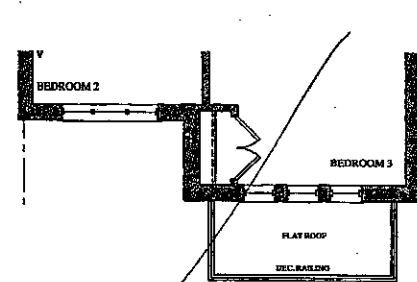


PART. SECOND FLOOR PLAN
ELEV. 'D'

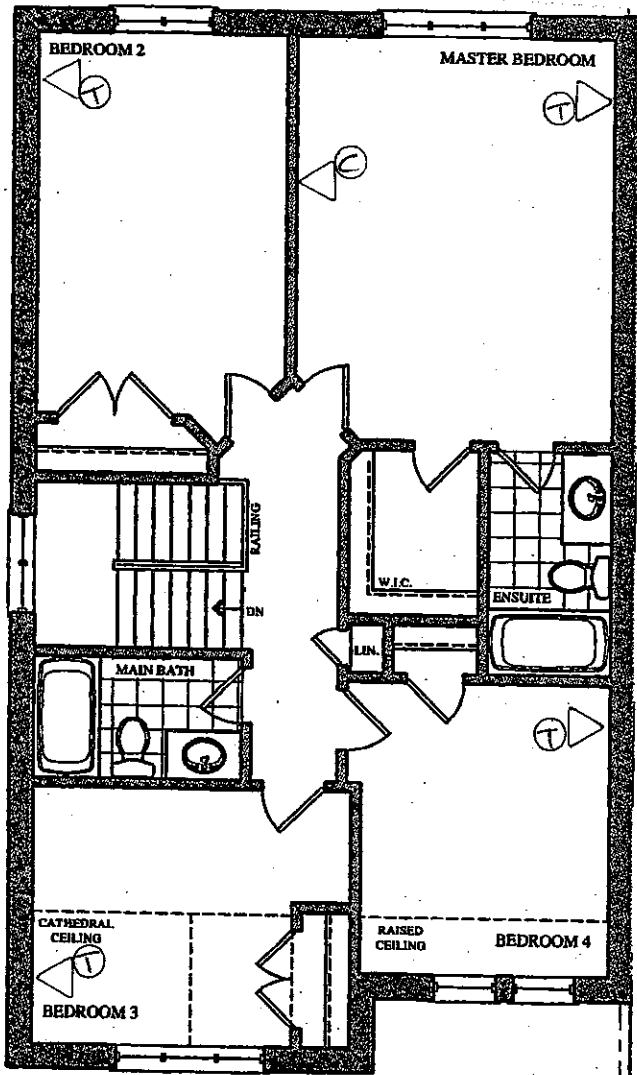


~~OPT. SECOND FLOOR PLAN
ELEV. 'A'~~

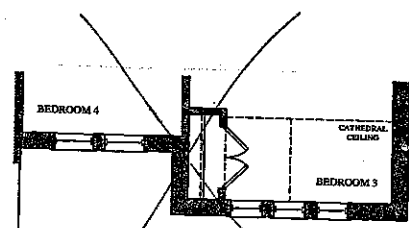

PART. OPT. SECOND FLOOR PLAN
ELEV. 'B'

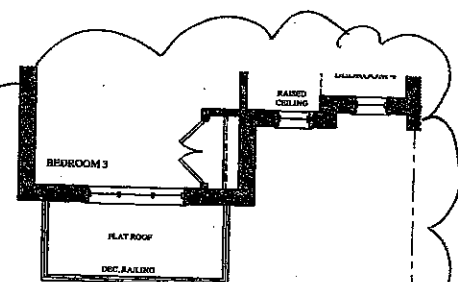

PART. OPT. SECOND FLOOR PLAN
ELEV. 'C'

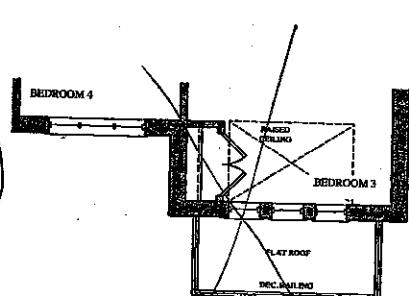


PART. OPT. SECOND FLOOR PLAN
ELEV. 'D'

REZ-29L (5)
July 6 2017


ROSSINI

SEMI SERIES

Elevation A • 1,911 sq.ft.
Elevation B • 1,902 sq.ft.
→ Elevation C • 1,966 sq.ft.
Elevation D • 1,971 sq.ft.

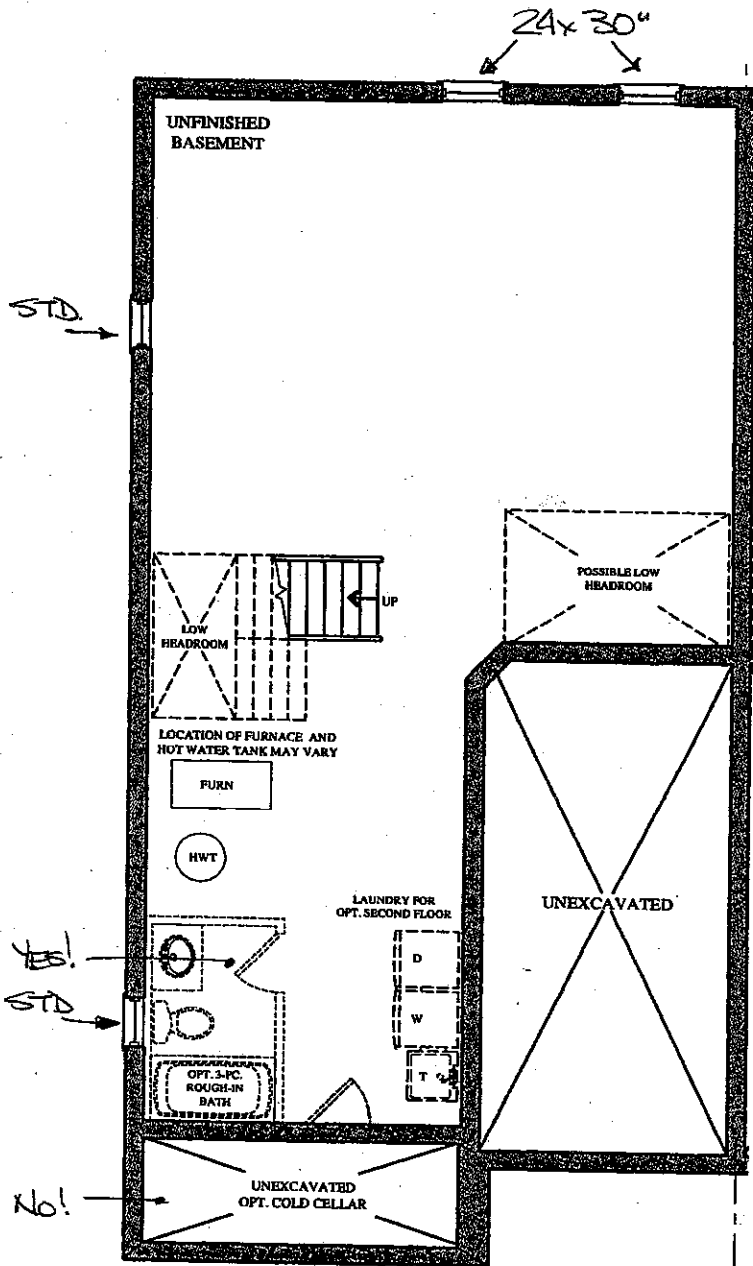

~~BASEMENT FLOOR PLAN
ELEV. 'A' & 'B'~~

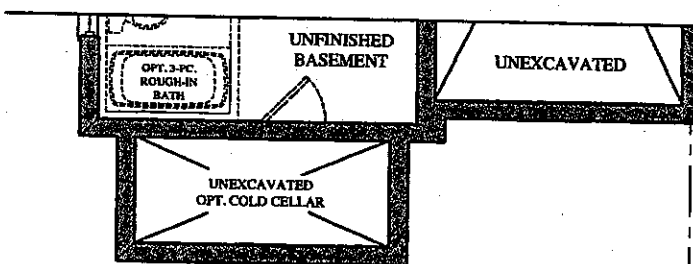

PART. BASEMENT FLOOR PLAN
ELEV. 'C' & 'D'