

Brampton Encore - 39L - 2 - 28-2 Elev.A SIREN

CENTRAL VAC AND WIRING

Inv.1,518	1 - TELEPHONE AND CABLE ROUGH-IN LOCATIONS
Line23474	Note:
21Jul17 / 23Nov17	

Exterior Colours

Inv.1,518	1 - EXTERIOR COLOUR PACKAGE #6
Line24768	Note:
21Jul17 / 23Nov17	

FRAMING

Inv.1,518	1 - GARAGE: INSTALL MANDOOR - GARAGE TO HOUSE- AS PER PLAN AND GRADE PERMITTING
Line23476	Note:
21Jul17 / 23Nov17	

Inv.1,518	1 - MAIN FLOOR: INSTALL THREE (X3) STANDARD DOOR EXTENDED HEIGHT 96" (PRICE PER DOOR)- GROUND FLOOR 2 STOREY MODELS
Line24766	Note:
21Jul17 / 23Nov17	

Inv.1,518	1 - MAIN FLOOR- MAN DOOR: INSTALL STANDARD MAN DOOR EXTENDED HEIGHT GROUND FLOOR 2 STOREY MODELS
Line24767	Note:
21Jul17 / 23Nov17	

INTERIOR TRIM AND DOORS

Inv.1,518	3 - MAIN FLOOR: INSTALL THREE (X3) STANDARD DOOR EXTENDED HEIGHT 96" (PRICE PER DOOR)- GROUND FLOOR 2 STOREY MODELS
Line23478	Note:
21Jul17 / 23Nov17	

MISC.

Inv.1,518	1 - REFUND- EXTERIOR: INSTALL SIDE DOOR- HOME TO EXTERIOR- AS PER PLAN AND GRADE PERMITTING
Line23475	Note:
21Jul17 / 23Nov17	

Inv.1,518	1 - BONUS PACKAGE: \$5,000.00 (INCLUDING TAXES) WORTH OF UPGRADES FROM GOLD PARK HOMES DÉCOR CENTRE IS BEING APPLIED TOWARD THE STRUCTURAL APPOINTMENT. PURCHASER HAS A REMAINING AMOUNT OF \$00 (INCLUDING TAXES) TO BE USED TOWARD THE COLOUR APPOINTMENT.
Line23480	Note:
21Jul17 / 23Nov17	

Inv.1,518	1 - Purchaser has attended a Structural appointment at the Decor Centre & has DECLINED any additional upgrades and accepts and acknowledges that there will be no further structural changes/additions/deletions to be made upon signing on July 21, 2017
Line23481	Note:
21Jul17 / 23Nov17	

Inv.1,518	1 - Purchasers are aware & accepts that ANY changes made to upgrades after signing this Purchasers Extra Form are subject to a minimum administration fee of \$500. PLUS a 10% holdback fee
Line23482	Note:
21Jul17 / 23Nov17	

WINDOWS - BASEMENT

Brampton Encore - 39L - 2 - 28-2 Elev.A SIREN

Inv.1,518	4 - BASEMENT: INSTALL FOUR (X4) BASEMENT WINDOWS - UPGRADE EXISTING BASEMENT WINDOW TO 30 INCH X 24 INCH - MAY REQUIRE INSTALLATION OF WINDOW WELL
Line23477	Note: PURCHASER IS AWARE THAT THE SIDE WILL GET A WINDOW WELL
21Jul17 / 23Nov17	

WINDOWS AND DOORS


Inv.1,518	1 - MAIN FLOOR- MAN DOOR: INSTALL STANDARD MAN DOOR EXTENDED HEIGHT GROUND FLOOR 2 STOREY MODELS
Line23479	Note:
21Jul17 / 23Nov17	

Telephone — (T)
 Cable — (C)


The Siren

SEMI SERIES

Elevation A • 1,688 sq.ft.
 Elevation B • 1,677 sq.ft.
 Elevation C • 1,687 sq.ft.

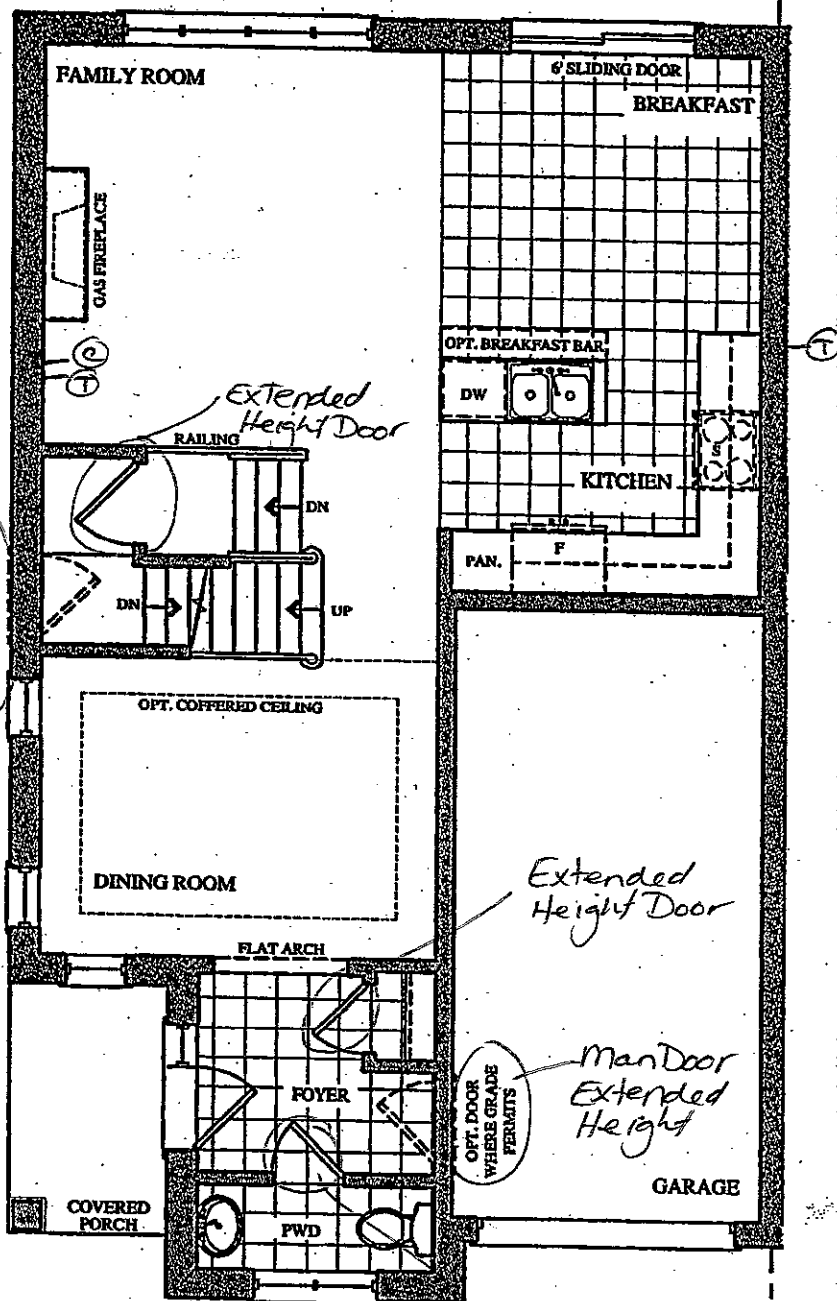

GROUND FLOOR PLAN
ELEV. 'A' & 'B'

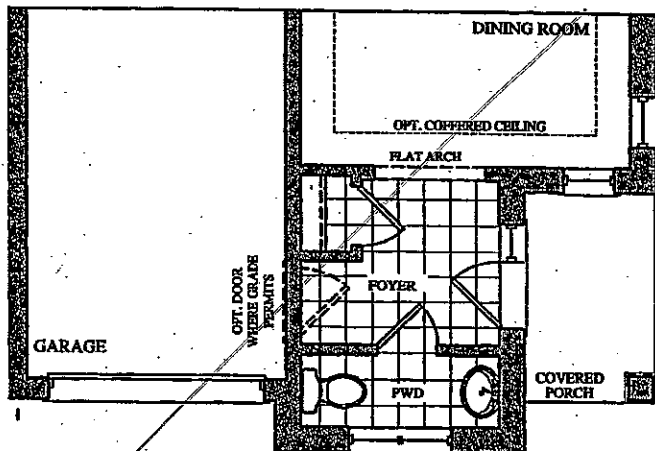

PART. GROUND FLOOR PLAN
ELEV. 'C'

Lot 39L

July 21, 17




Telephone — (T)
Cable — (C)

The Siren


SEMI SERIES

Elevation A • 1,688 sq.ft.
Elevation B • 1,677 sq.ft.
Elevation C • 1,687 sq.ft.

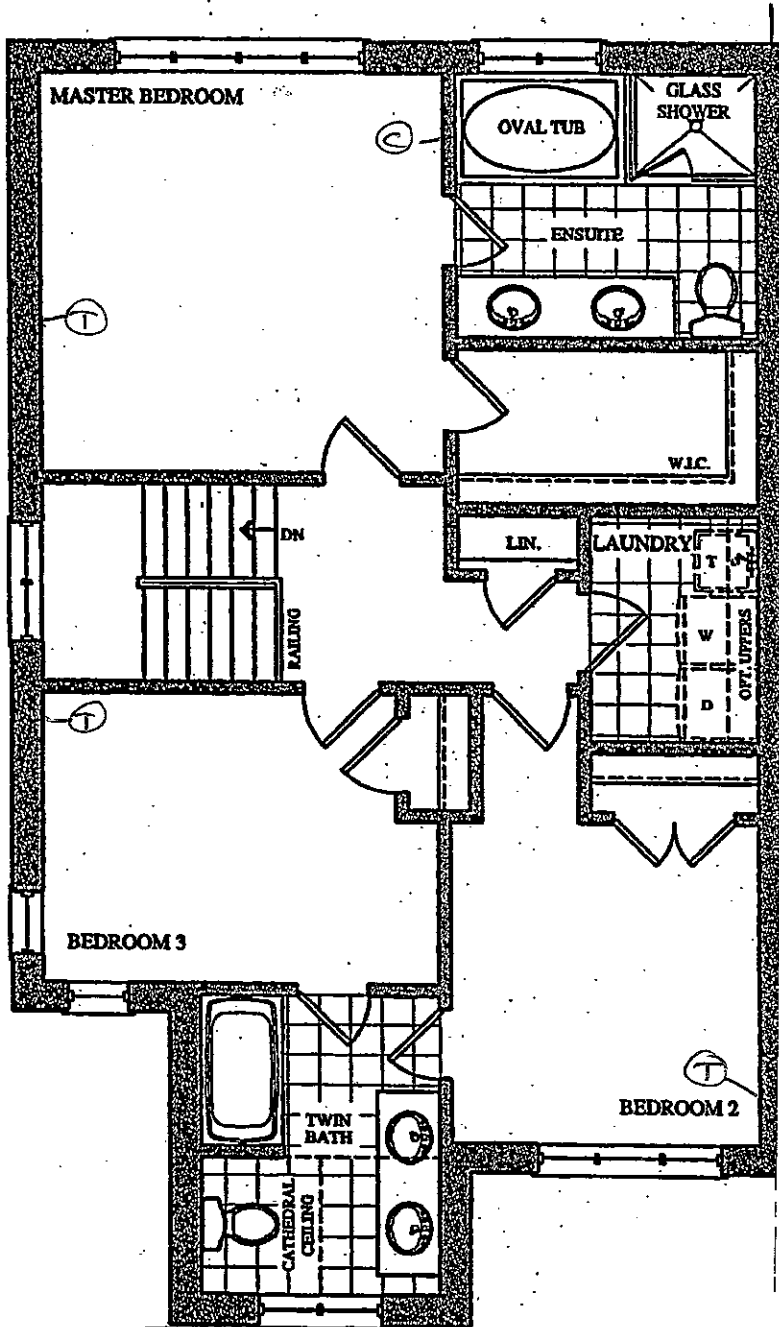


SECOND FLOOR PLAN
ELEV. 'A'

Lot 39L
July 21, 17
(15)

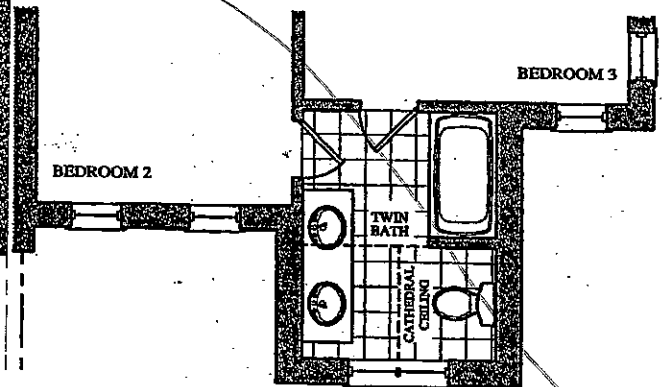

PART. SECOND FLOOR PLAN
ELEV. 'B'

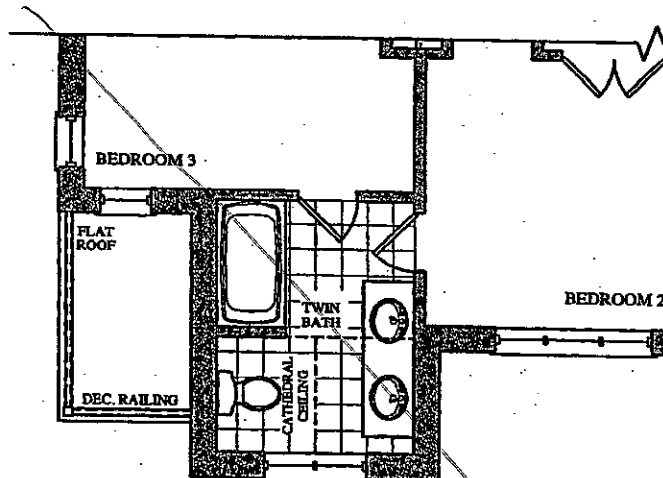


PART. SECOND FLOOR PLAN
ELEV. 'C'

The
Siren
SEMI SERIES

Elevation A • 1,688 sq.ft.
Elevation B • 1,677 sq.ft.
Elevation C • 1,687 sq.ft.

BSMNT WINDOWS
4 x 30" x 24"

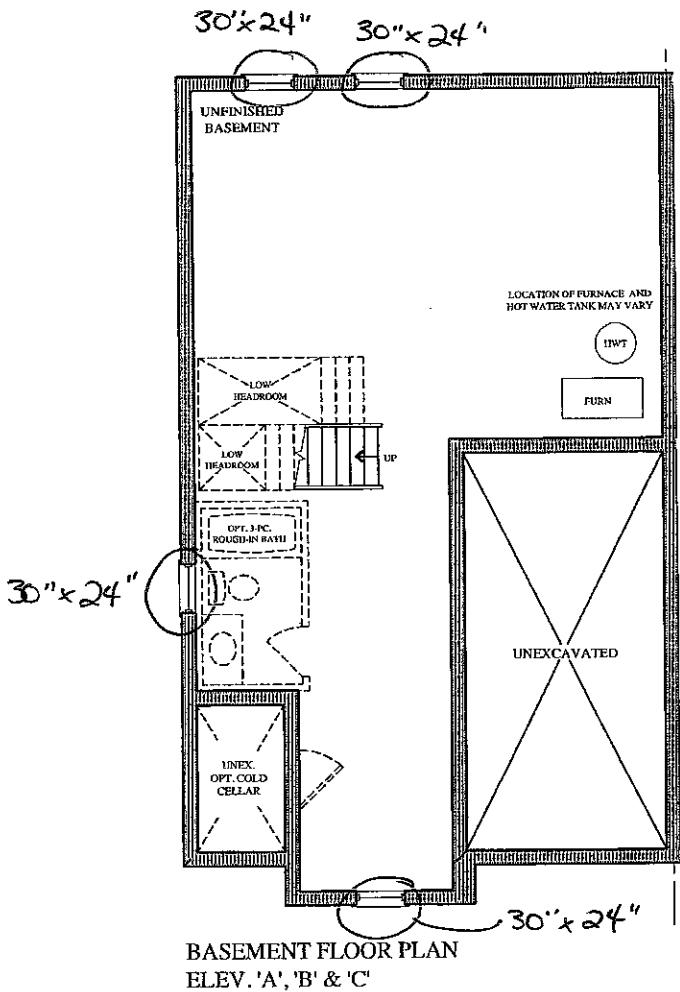

Prices, figures, illustrations, sizes, features and finishes are subject to change without notice. Areas and dimensions are approximate and actual usable floor space may vary from the stated area. Layout may be reverse of the unit purchased. E. & O.E.

GOLDPARK
WORTH MORE™

Lot 39L
July 21, 17
25