

Brampton Encore - 39R - 2 - 28-2 Elev.B SIREN

CENTRAL VAC AND WIRING

Inv.1,491	1 - FAMILY ROOM: CONDUIT PIPE- FOR TELEVISION- LOCATE APPROX. 66" A.F.F. ABOVE FIREPLACE, TERMINATING BY CABLE LOCATION.
Line23135	Note:
10Jul17 / 22Nov17	

ELECTRICAL

Inv.1,491	1 - FAMILY ROOM: 110V WALL RECEPTACLE ON NORMAL CIRCUIT- LOCATE APPROX. 66" A.F.F. ABOVE FIREPLACE.
Line23136	Note:
10Jul17 / 22Nov17	

Exterior Colours

Inv.1,491	1 - EXTERIOR COLOUR PACKAGE #6
Line24769	Note:
10Jul17 / 22Nov17	

FRAMING

Inv.1,649	1 - MANDOOR-GARAGE TO HOUSE- GRADE PERMITS
Line24787	Note:
22Nov17 / 22Nov17	

MISC.

Inv.1,491	1 - REFUND-SIDE DOOR- HOME TO EXTERIOR- AS PER PLAN AND GRADE PERMITTING- GRADE DOESN'T PERMIT
Line23137	Note:
10Jul17 / 22Nov17	
Inv.1,491	1 - Purchasers are aware & accepts that ANY changes made to upgrades after signing this Purchasers Extra Form are subject to a minimum administration fee of \$500. PLUS a 10% holdback fee.
Line23140	Note:
10Jul17 / 22Nov17	
Inv.1,491	1 - BONUS PACKAGE: \$10,000.00 (INCLUDING TAXES) WORTH OF UPGRADES FROM GOLD PARK HOMES DÉCOR CENTRE IS BEING APPLIED TOWARD THE STRUCTURAL APPOINTMENT. PURCHASER HAS A REMAINING AMOUNT OF \$6717.35 (INCLUDING TAXES) TO BE USED TOWARD THE COLOUR APPOINTMENT.
Line23141	Note:
10Jul17 / 22Nov17	

PAINT

Inv.1,491	1 - Purchasers are aware & accepts that ANY changes made to upgrades after signing this Purchasers Extra Form are subject to a minimum administration fee of \$500. PLUS a 10% holdback fee.
Line23142	Note:
10Jul17 / 22Nov17	

WINDOWS AND DOORS


Inv.1,649	1 - MANDOOR-GARAGE TO HOUSE- GRADE PERMITS
Line24788	Note:
22Nov17 / 22Nov17	

BE2-392
July 10 2017 (B) (B)


The Siren

SEMI SERIES

Elevation A • 1,688 sq.ft.
Elevation B • 1,677 sq.ft.
Elevation C • 1,687 sq.ft.

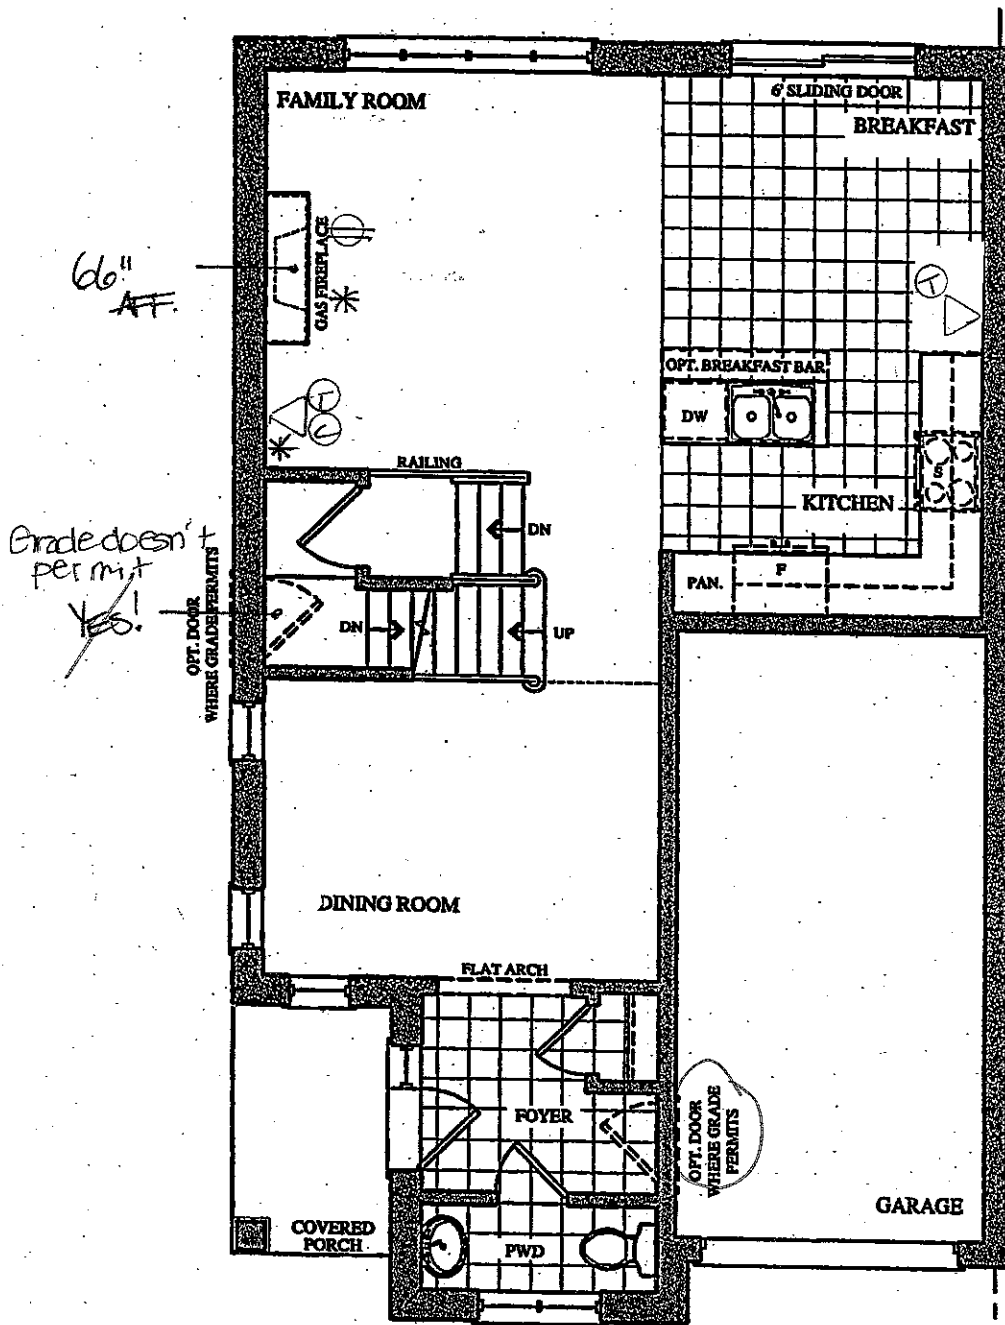

GROUND FLOOR PLAN
ELEV. 'A' & 'B'

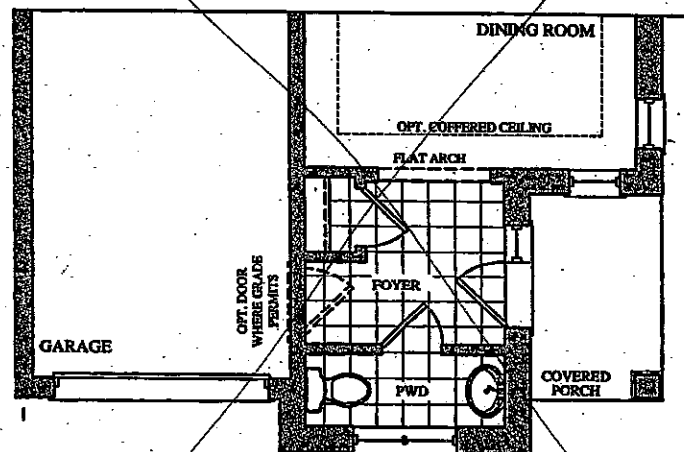


PART. GROUND FLOOR PLAN
ELEV. 'C'

BE2-39R
JULY 10. 2017 (4) (B)


The Siren

SEMI SERIES


Elevation A • 1,688 sq.ft.
Elevation B • 1,677 sq.ft.
Elevation C • 1,687 sq.ft.

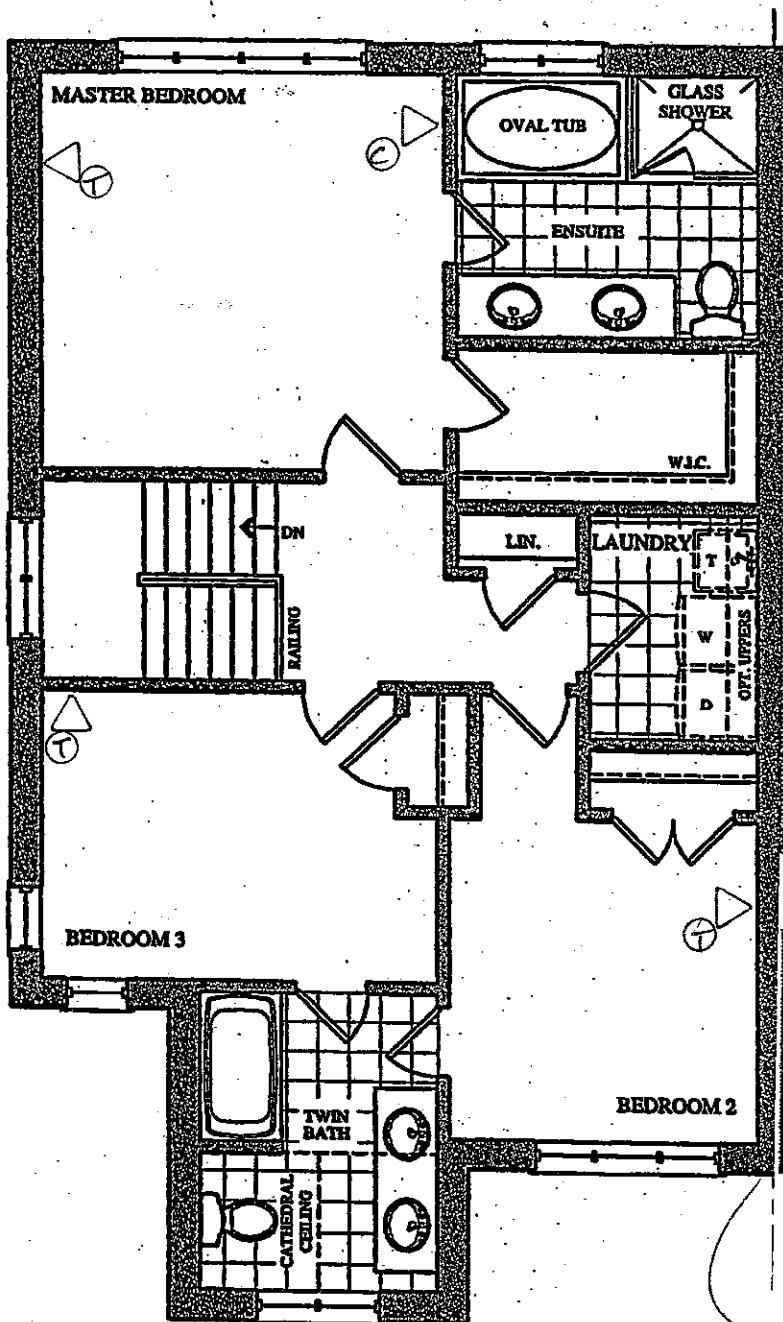

~~SECOND FLOOR PLAN
ELEV. 'A'~~

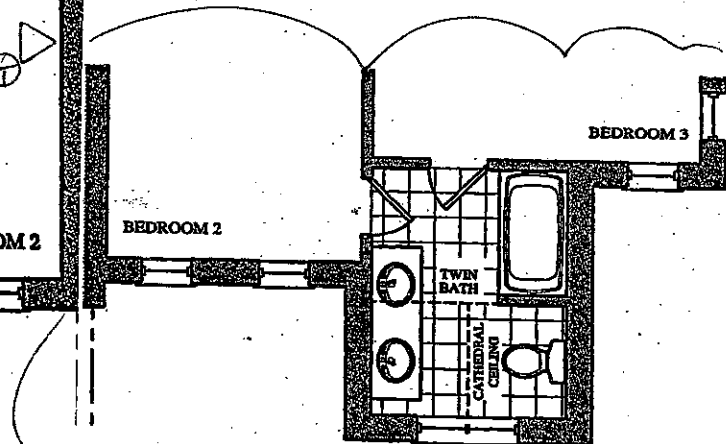

PART. SECOND FLOOR PLAN
ELEV. 'B'

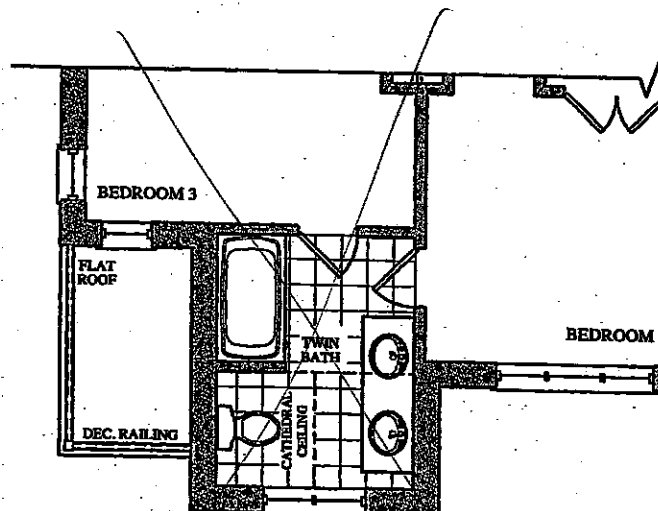

PART. SECOND FLOOR PLAN
ELEV. 'C'

BE2-30R
July 10 2017

The Siren

SEMI SERIES

Elevation A • 1,688 sq.ft.

Elevation B • 1,677 sq.ft.

Elevation C • 1,687 sq.ft.

