

Brampton Encore - 57R - 2 - 28-4 Elev.D Rossini

CONCRETE AND DRAIN

Inv.1,466	1 - BASEMENT: ROUGH-IN - 3PC BASEMENT ROUGH-IN
Line22853	Note:
29Jun17 / 23Nov17	

ELECTRICAL

Inv.1,466	1 - FAMILY ROOM: 110V WALL RECEPTACLE ON NORMAL CIRCUIT- LOCATE APPROX. 66" A.F.F. ABOVE FIREPLACE.
Line22850	Note:
29Jun17 / 23Nov17	

Inv.1,466	1 - KITCHEN: 240V/40A WALL RECEPTICAL ON DEDICATED CIRCUIT- FOR 4 WIRE BUILT-IN WALL OVEN - SEE PLAN FOR LOCATION
Line22851	Note:
29Jun17 / 23Nov17	

Inv.1,466	1 - KITCHEN: ROUGH - IN CEILING OUTLET & SWITCH (WITH COVER PLATE) - DOES NOT INCLUDE FIXTURE - LOCATE APPROX. CENTER ABOVE ISLAND
Line22852	Note:
29Jun17 / 23Nov17	

Inv.1,466	1 - HUMIDIFIER: WB3 - 12 (UP TO 2,000 SQ.FT.)
Line24664	Note:
29Jun17 / 23Nov17	

Exterior Colours

Inv.1,466	1 - EXTERIOR COLOUR PACKAGE # 4
Line24666	Note:
29Jun17 / 23Nov17	

FRAMING

Inv.1,466	1 - MAIN FLOOR: EXTENDED HEIGHT ARCHWAY (PRICE PER DOORWAY) -96"
Line24665	Note:
29Jun17 / 23Nov17	

HVAC

Inv.1,466	1 - HUMIDIFIER: WB3 - 12 (UP TO 2,000 SQ.FT.)
Line22855	Note:
29Jun17 / 23Nov17	

Inv.1,466	1 - A/C - 2.0 TON
Line22856	Note:
29Jun17 / 23Nov17	

INTERIOR TRIM AND DOORS

Inv.1,466	1 - MAIN FLOOR: EXTENDED HEIGHT ARCHWAY (PRICE PER DOORWAY) -96"
Line22857	Note:
29Jun17 / 23Nov17	

MISC.

Inv.1,466	1 - REFUND- GRADE DOESN'T PERMIT- SIDE DOOR- HOME TO EXTERIOR- AS PER PLAN AND GRADE PERMITTING
Line22854	Note:
29Jun17 / 23Nov17	

Brampton Encore - 57R - 2 - 28-4 Elev.D Rossini

Inv.1,466	1 - Purchaser has attended an appointment at the Decor Centre & has DECLINED any additional upgrades and accepts and acknowledges that there will be no further changes/additions/deletions to be made upon signing on June 29 2017.
Line22859	Note:
29Jun17 / 23Nov17	
Inv.1,466	1 - Purchasers are aware & accepts that ANY changes made to upgrades after signing this Purchasers Extra Form are subject to a minimum administration fee of \$500. PLUS a 10% holdback fee.
Line22860	Note:
29Jun17 / 23Nov17	
Inv.1,466	1 - BONUS PACKAGE: \$5,000.00 (INCLUDING TAXES) WORTH OF UPGRADES FROM GOLD PARK HOMES DÉCOR CENTRE IS BEING APPLIED TOWARD THE STRUCTURAL APPOINTMENT. PURCHASER HAS A REMAINING AMOUNT OF \$00 (INCLUDING TAXES) TO BE USED TOWARD THE COLOUR APPOINTMENT.
Line22862	Note:
29Jun17 / 23Nov17	


PLUMBING


Inv.1,466	1 - KITCHEN: ROUGH-IN - WATERLINE FOR FRIDGE
Line22858	Note:
29Jun17 / 23Nov17	
Inv.1,466	1 - HUMIDIFIER: WB3 - 12 (UP TO 2,000 SQ.FT.)
Line24663	Note:
29Jun17 / 23Nov17	

BE2-57R. (C)
JUNE 29 2017

The Rossini SEMI SERIES

Elevation A • 1,911 sq.ft.
Elevation B • 1,902 sq.ft.
Elevation C • 1,966 sq.ft.
Elevation D • 1,971 sq.ft.

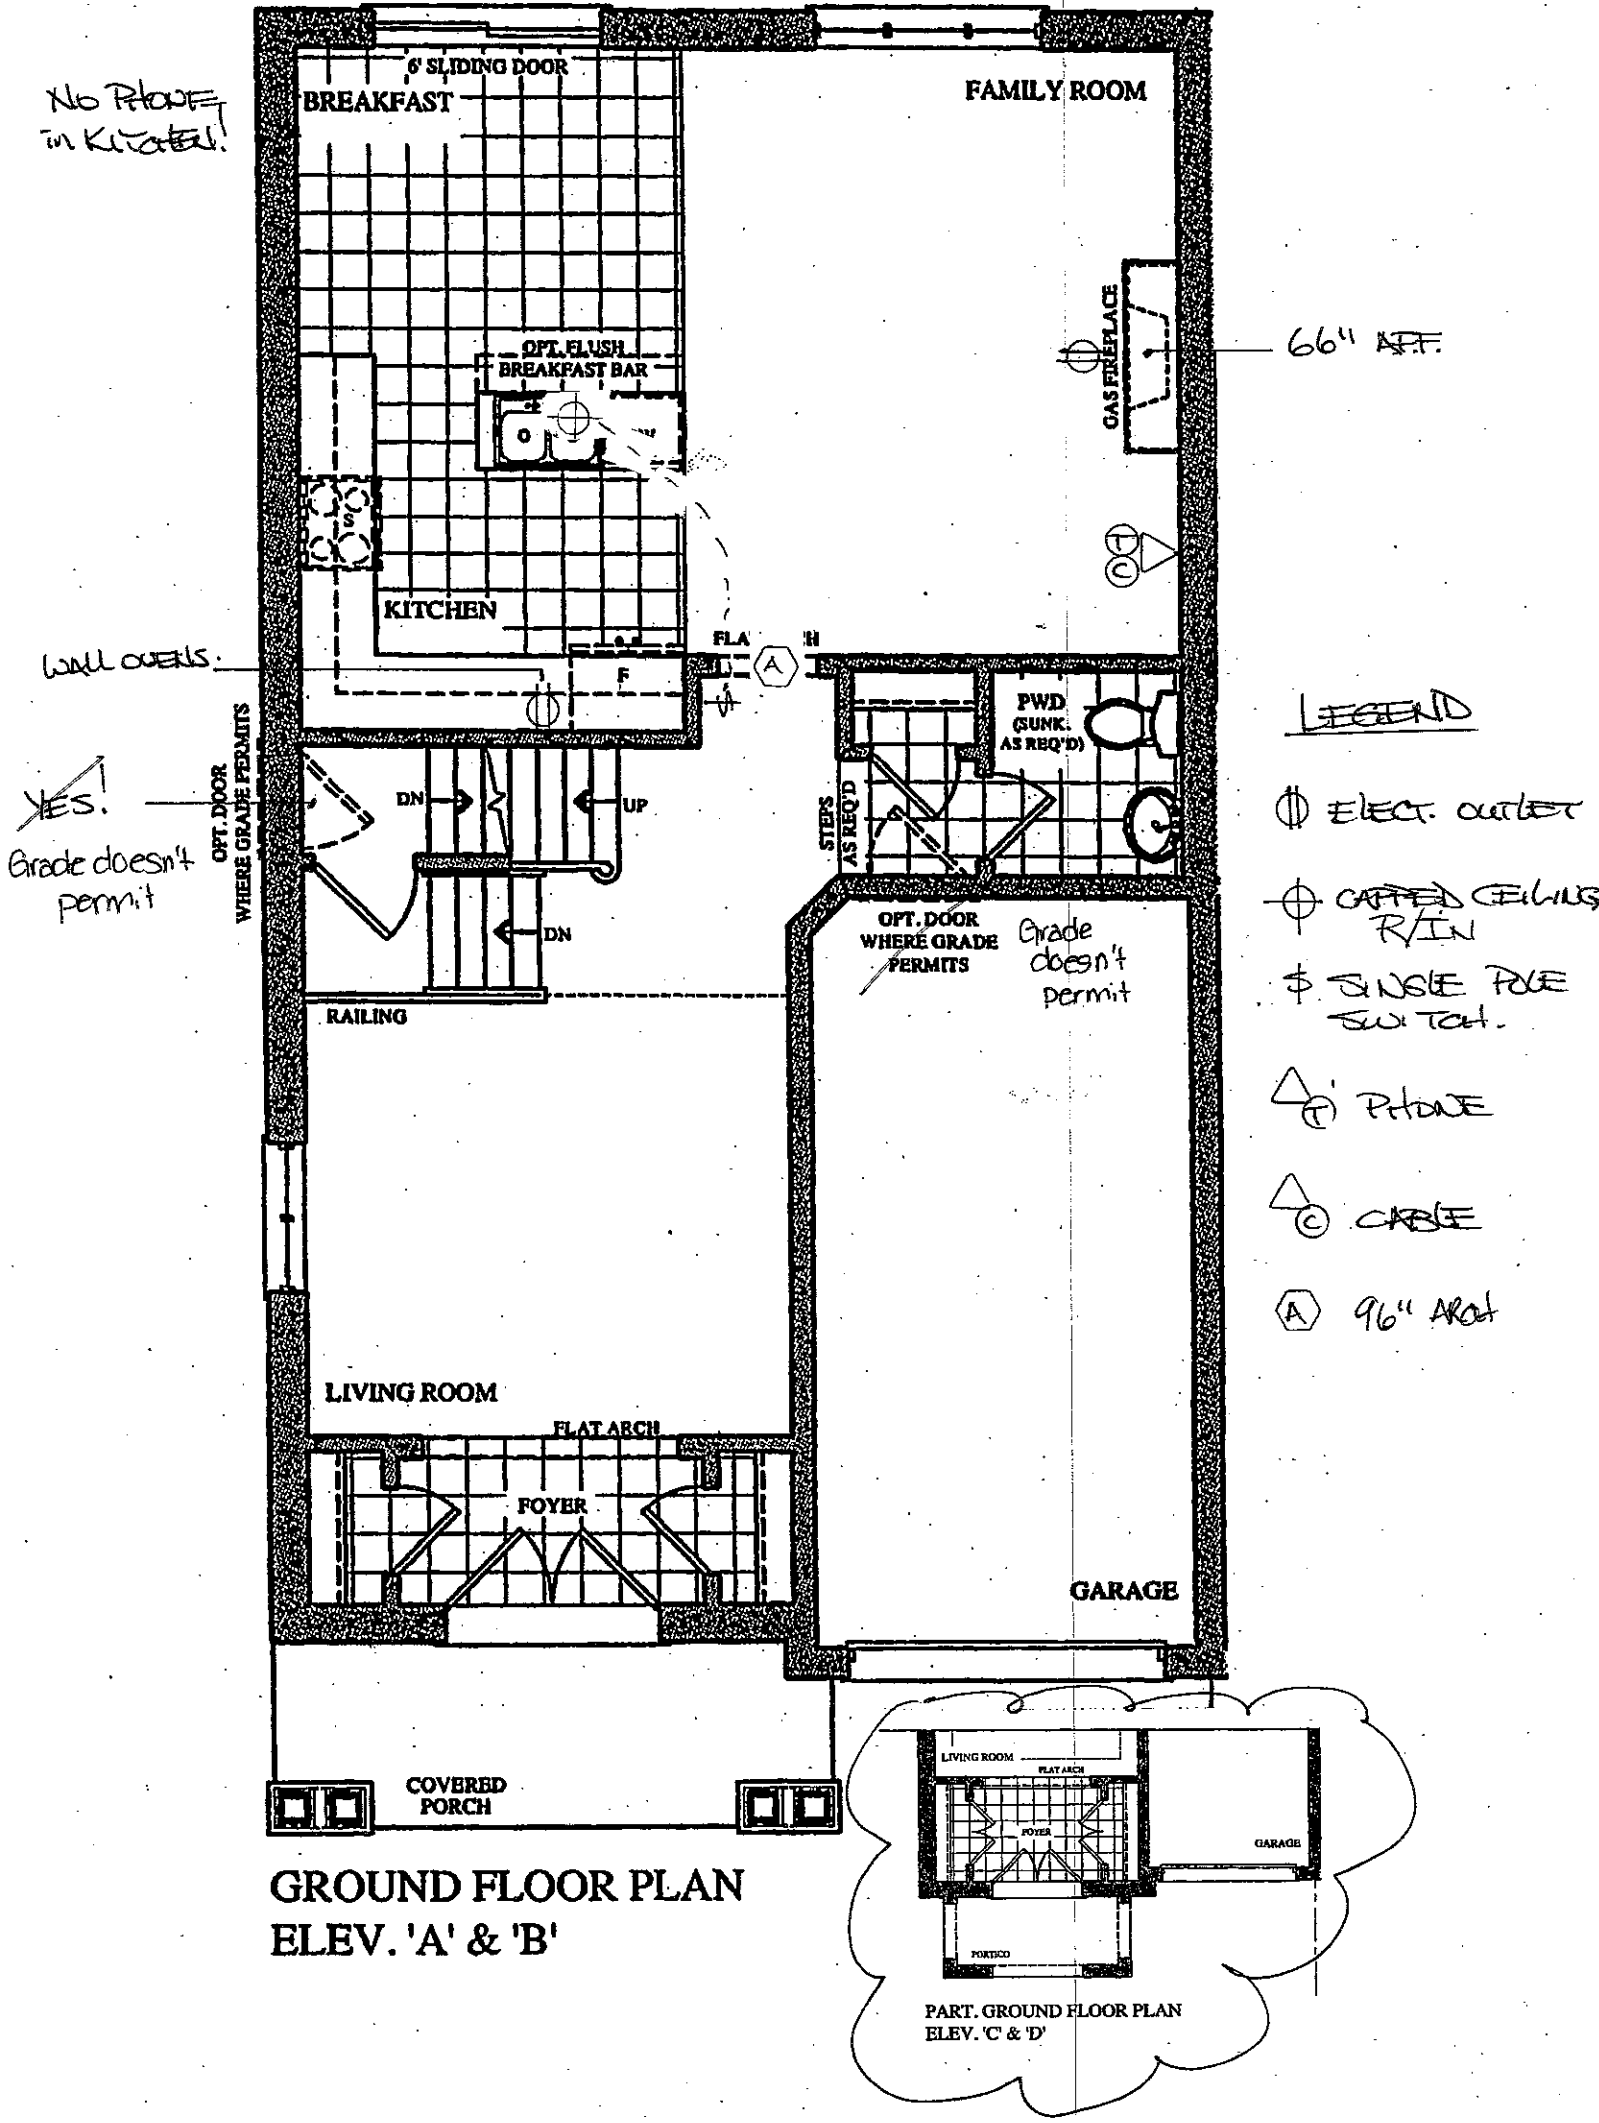




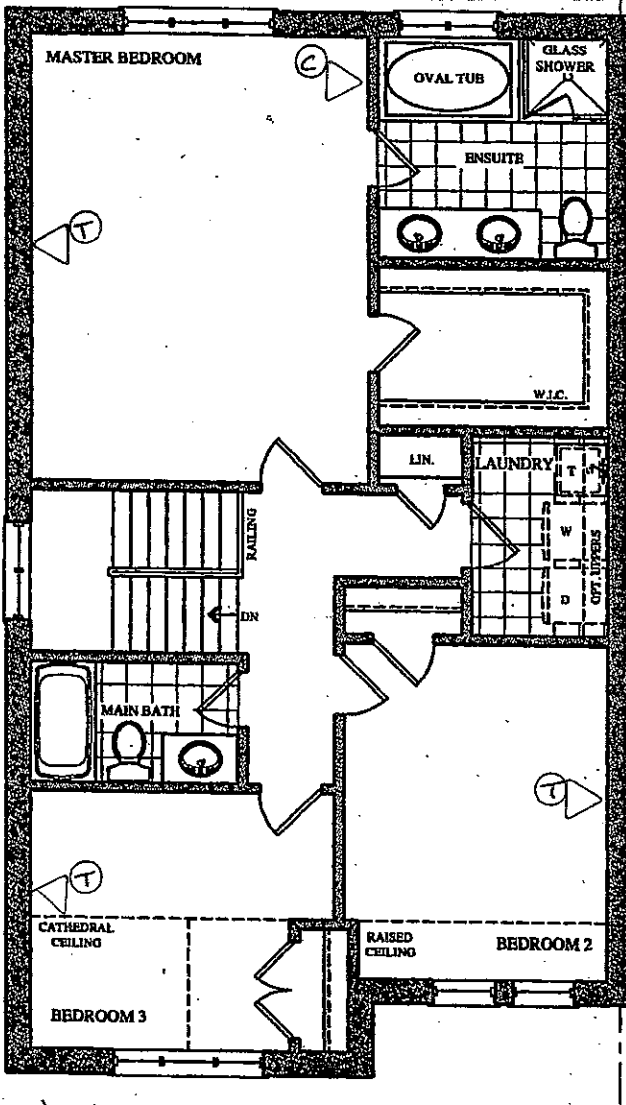


SECOND FLOOR PLAN
ELEV. 'A'




BE2-57R (57)
JUNE 29 2017

The Rossini SEMI SERIES

Elevation A • 1,911 sq.ft.
Elevation B • 1,902 sq.ft.
Elevation C • 1,966 sq.ft.
Elevation D • 1,971 sq.ft.

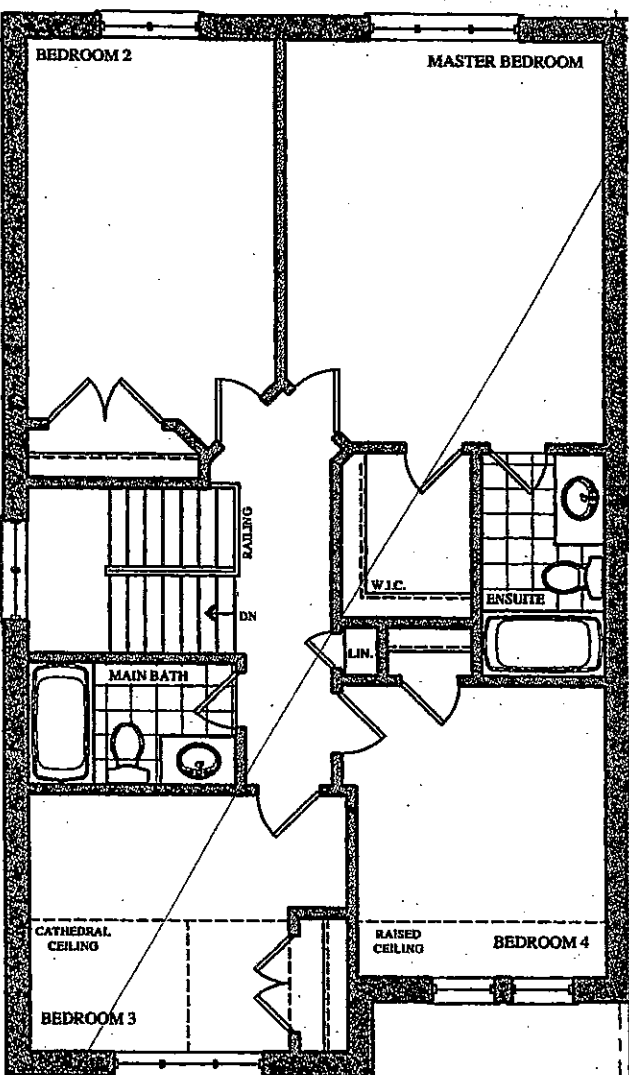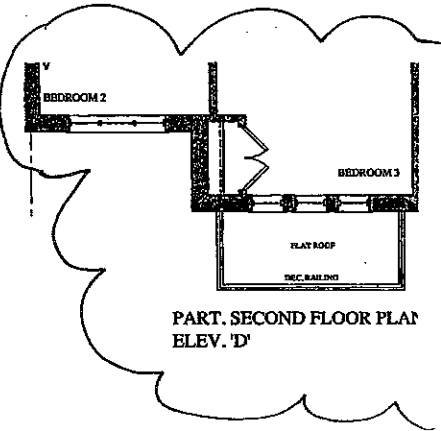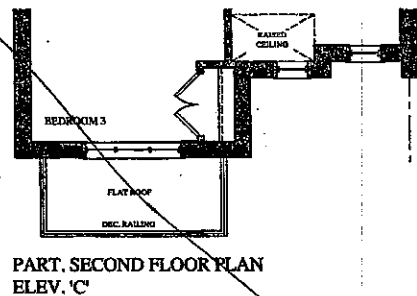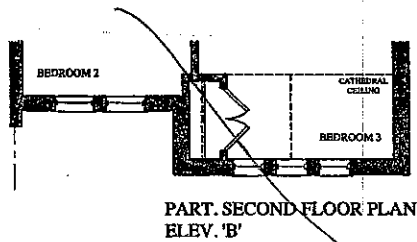


OPT. SECOND FLOOR PLAN
ELEV. 'A'

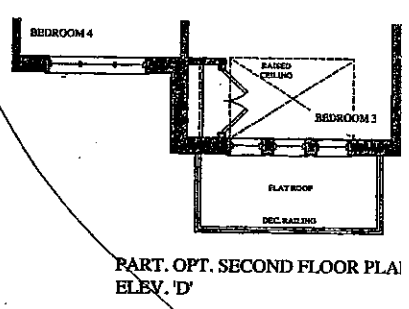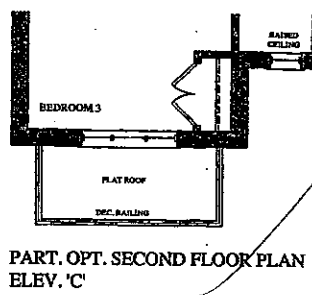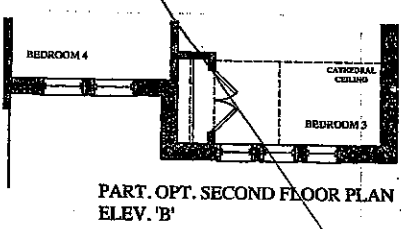


BE2-57R
JUNE 29 2017 (61)

THE Rossini SEMI SERIES

Elevation A • 1,911 sq.ft.
Elevation B • 1,902 sq.ft.
Elevation C • 1,966 sq.ft.
→ Elevation D • 1,971 sq.ft.

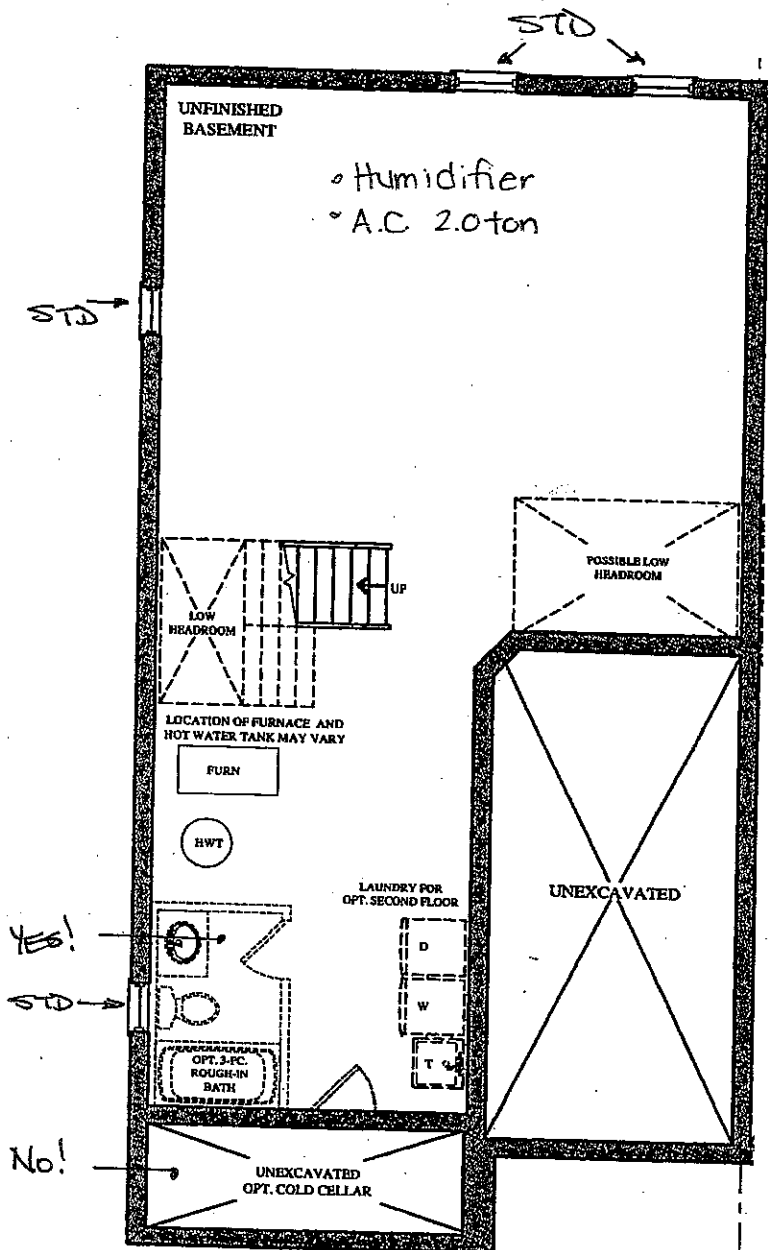

~~BASEMENT FLOOR PLAN~~
~~ELEV. 'A' & 'B'~~

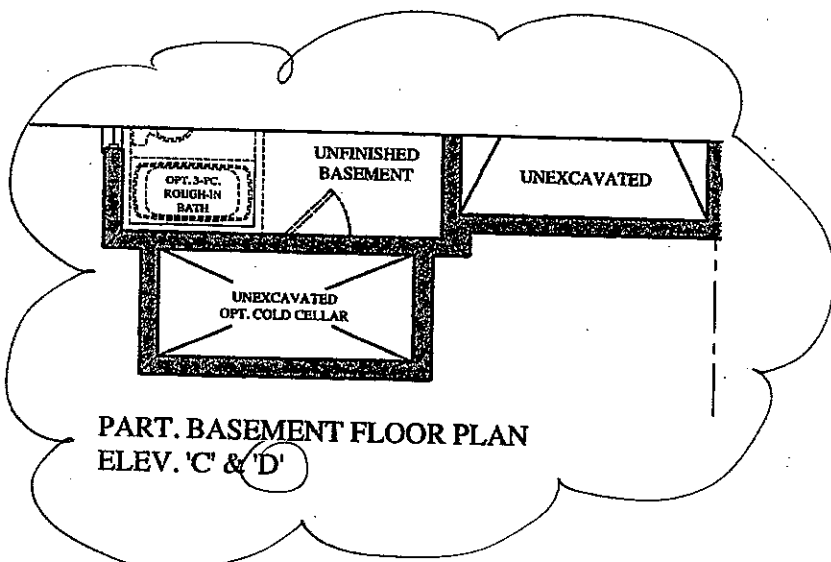

PART. BASEMENT FLOOR PLAN
ELEV. 'C' & 'D'