

**Brampton Encore - 89L - 2 - 28-2 Elev.CL Siren**

**CENTRAL VAC AND WIRING**

Inv.1,523	1 - TELEPHONE AND CABLE ROUGH-IN LOCATIONS
Line23536	Note:
24Jul17 / 23Nov17	
Inv.1,523	1 - FAMILY ROOM: INSTALL CONDUIT PIPE- FOR TELEVISION- MUST SPECIFY LOCATION AND TERMINATION POINT
Line23537	Note:
24Jul17 / 23Nov17	

**CONCRETE AND DRAIN**

Inv.1,523	1 - BASEMENT: INSTALL ROUGH-IN - 3PC BASEMENT ROUGH-IN
Line23539	Note:
24Jul17 / 23Nov17	

**ELECTRICAL**

Inv.1,523	1 - FAMILY ROOM: INSTALL 110V WALL RECEPTACLE ON DEDICATED CIRCUIT - ABOVE FIREPLACE FOR FUTURE TV
Line23538	Note:
24Jul17 / 23Nov17	

**Exterior Colours**

Inv.1,523	1 - EXTERIOR COLOUR PACKAGE # 6
Line24789	Note:
24Jul17 / 23Nov17	

**FRAMING**

Inv.1,523	1 - GARAGE: INSTALL ROUGH-IN MANDOOR - GARAGE TO HOUSE- AS PER PLAN AND GRADE PERMITTING
Line23540	Note:
24Jul17 / 23Nov17	

**MISC.**

Inv.1,523	1 - BONUS PACKAGE: \$5000.00 (INCLUDING TAXES) WORTH OF UPGRADES FROM GOLD PARK HOMES DÉCOR CENTRE IS BEING APPLIED TOWARD THE STRUCTURAL APPOINTMENT. PURCHASER HAS A REMAINING AMOUNT OF \$0.00 (INCLUDING TAXES) TO BE USED TOWARD THE COLOUR APPOINTMENT.
Line23541	Note:
24Jul17 / 23Nov17	
Inv.1,523	1 - Purchaser has attended a Structural appointment at the Decor Centre & has DECLINED any additional upgrades and accepts and acknowledges that there will be no further structural changes/additions/deletions to be made upon signing on July 24, 2017
Line23542	Note:
24Jul17 / 23Nov17	
Inv.1,523	1 - Purchasers are aware & accepts that ANY changes made to upgrades after signing this Purchasers Extra Form are subject to a minimum administration fee of \$500. PLUS a 10% holdback fee
Line23543	Note:
24Jul17 / 23Nov17	
Inv.1,523	1 - REFUND-EXTERIOR: INSTALL SIDE DOOR- HOME TO EXTERIOR- AS PER PLAN AND GRADE PERMITTING GRADE DOESN'T PERMIT
Line23544	Note:
24Jul17 / 23Nov17	




# The Siren

## SEMI SERIES

Elevation A • 1,688 sq.ft.


Elevation B • 1,677 sq.ft.

Elevation C • 1,687 sq.ft.

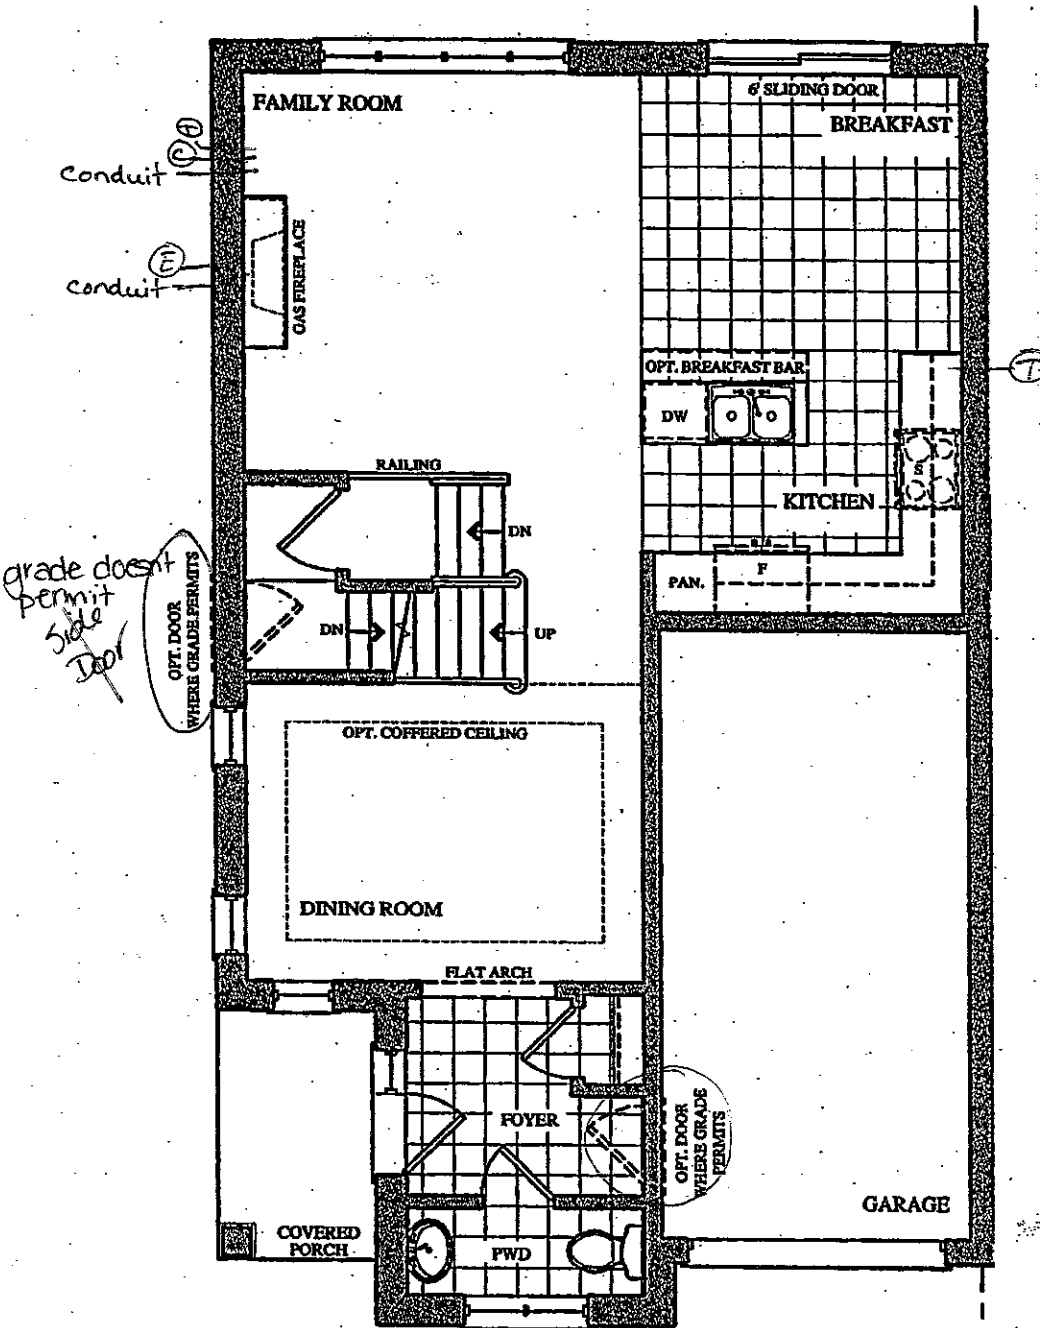

GROUND FLOOR PLAN  
ELEV. 'A' & 'B'

Lot 89L  
July 24, 17

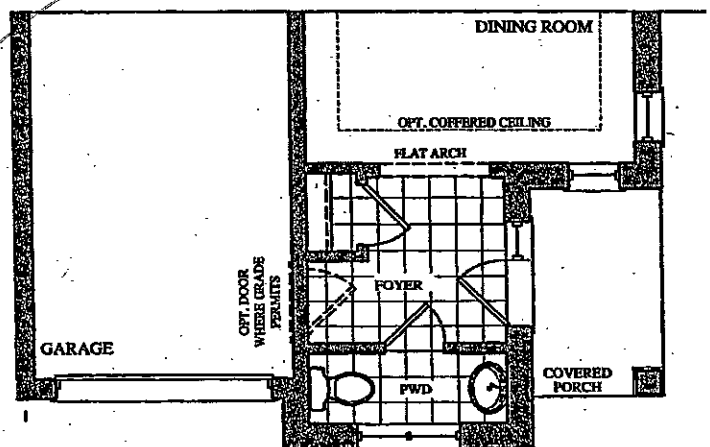

PART. GROUND FLOOR PLAN  
ELEV. 'C'


# The Siren

## SEMI SERIES


Elevation A • 1,688 sq.ft.

Elevation B • 1,677 sq.ft.



Elevation C • 1,687 sq.ft.

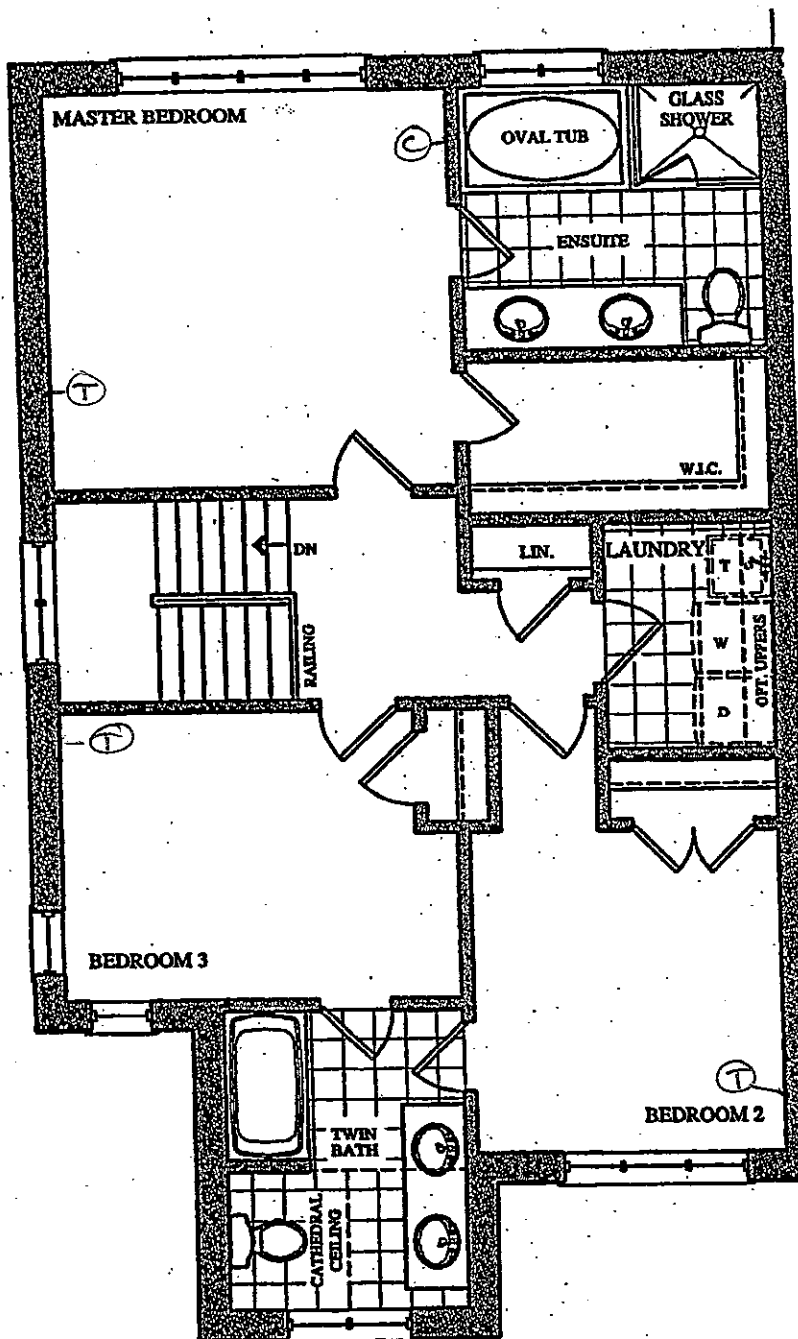


SECOND FLOOR PLAN  
ELEV. 'A'

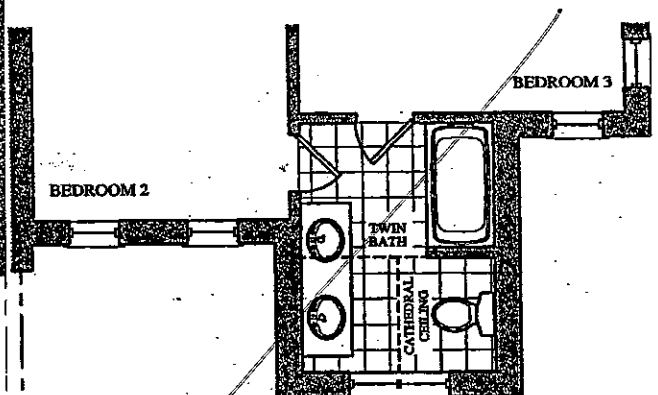

PART. SECOND FLOOR PLAN  
ELEV. 'B'

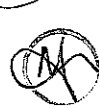
Lot 89L  
July 24, 17  
 

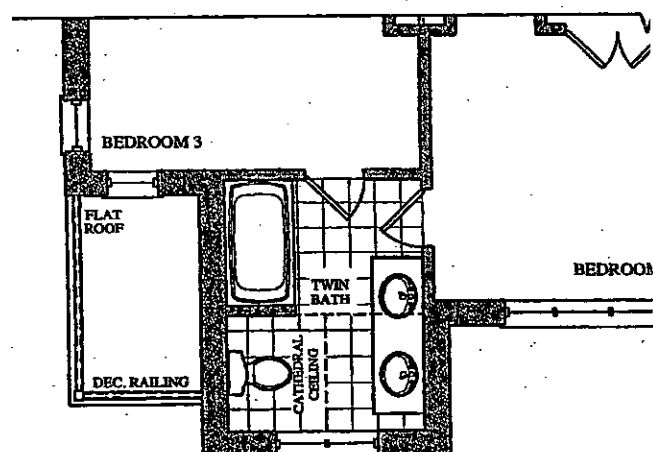

PART. SECOND FLOOR PLAN  
ELEV. 'C'

The  
Siren  
SEMI SERIES

Elevation A • 1,688 sq.ft.  
Elevation B • 1,677 sq.ft.  
Elevation C • 1,687 sq.ft.

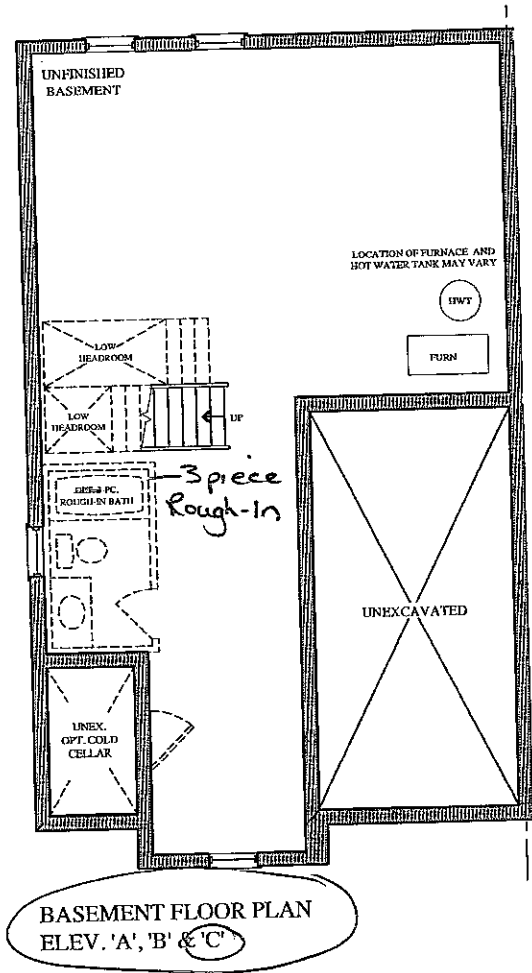

Prices, figures, illustrations, sizes, features and finishes are subject to change without notice. Areas and dimensions are approximate and actual usable floor space may vary from the stated area. Layout may be reverse of the unit purchased. E. & O.E.

GOLDPARK  
WORTH MORE™

Lot 89L  
July 24, 17  
AA