

Brampton Encore - 63L - 2 - 28-7 Elev.C Wagner

CENTRAL VAC AND WIRING

Inv.1,538	1 - TELEPHONE AND CABLE ROUGH-IN LOCATION SKETCH
Line23668	Note:
31Jul17 / 23Nov17	

ELECTRICAL

Inv.1,538	1 - LIVING ROOM: INSTALL ROUGH - IN WALL OUTLET & SWITCH (WITH COVER PLATE) - DOES NOT INCLUDE FIXTURE - MUST SPECIFY LOCATION
Line23686	Note:
31Jul17 / 23Nov17	

Inv.1,538	1 - KITCHEN: INSTALL GAS LINE ROUGH - GROUND FLOOR FOR STOVE, INCLUDES 110V PLUG
Line24816	Note:
31Jul17 / 23Nov17	

Exterior Colours

Inv.1,538	1 - EXTERIOR COLOUR PACKAGE #1
Line24817	Note:
31Jul17 / 23Nov17	

FRAMING

Inv.1,654	1 - MANDOOR- GARAGE TO HOUSE- GRADE PERMITS
Line24819	Note:
23Nov17 / 23Nov17	

HVAC

Inv.1,538	1 - INSTALL 2.5 TON AIR CONDITIONER
Line23687	Note:
31Jul17 / 23Nov17	

Inv.1,538	1 - KITCHEN: INSTALL GAS LINE ROUGH - GROUND FLOOR FOR STOVE, INCLUDES 110V PLUG
Line23673	Note:
31Jul17 / 23Nov17	

MISC.

Inv.1,538	1 - BONUS PACKAGE: \$5000.00 (INCLUDING TAXES) WORTH OF UPGRADES FROM GOLD PARK HOMES DÉCOR CENTRE IS BEING APPLIED TOWARD THE STRUCTURAL APPOINTMENT. PURCHASER HAS A REMAINING AMOUNT OF \$0 (INCLUDING TAXES) TO BE USED TOWARD THE COLOUR APPOINTMENT
Line23674	Note:
31Jul17 / 23Nov17	

Inv.1,538	1 - Purchaser has attended a Structural appointment at the Decor Centre & has DECLINED any additional upgrades and accepts and acknowledges that there will be no further structural changes/additions/deletions to be made upon signing on July 31, 2017
Line23675	Note:
31Jul17 / 23Nov17	

Inv.1,538	1 - Purchasers are aware & accepts that ANY changes made to upgrades after signing this Purchasers Extra Form are subject to a minimum administration fee of \$500. PLUS a 10% holdback fee
Line23676	Note:
31Jul17 / 23Nov17	

PLUMBING

Brampton Encore - 63L - 2 - 28-7 Elev.C Wagner

Inv.1,538	1 - KITCHEN: INSTALL ROUGH-IN - WATERLINE FOR FRIDGE
Line23672	Note:
31Jul17 / 23Nov17	


WINDOWS AND DOORS

Inv.1,654	1 - MANDOOR- GARAGE TO HOUSE- GRADE PERMITS
Line24818	Note:
23Nov17 / 23Nov17	


Telephone — (T)
 Cable — (C)
 Electrical — (E)

The Wagner SEMI SERIES

Elevation A • 2,127 sq.ft.
 Elevation B • 2,117 sq.ft.
 Elevation C • 2,127 sq.ft.
 Elevation D • 2,127 sq.ft.

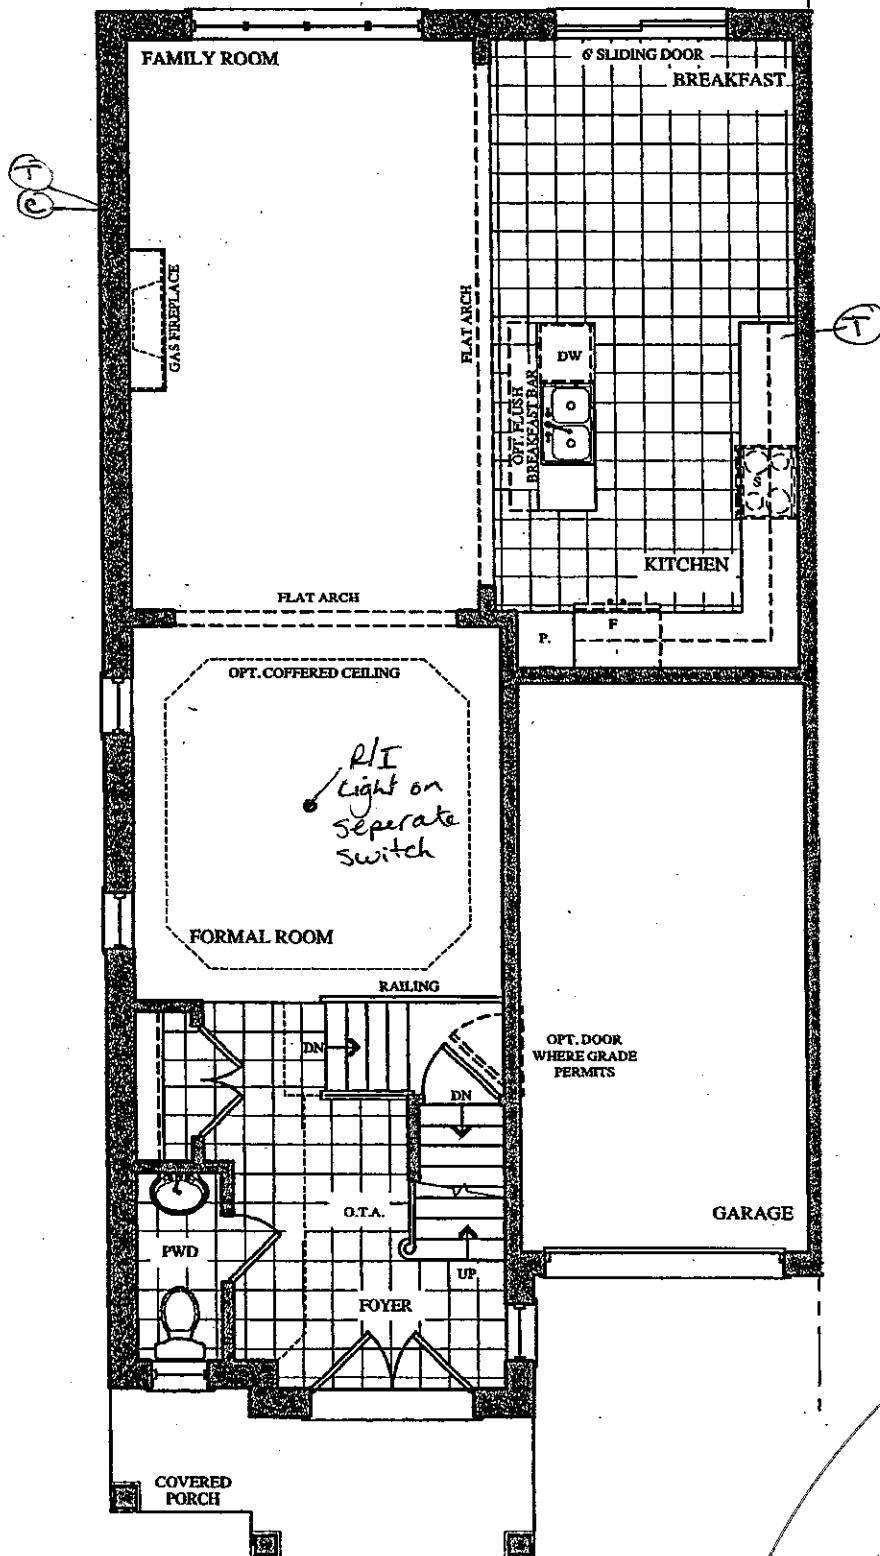

GROUND FLOOR PLAN
ELEV. 'A' & 'B'

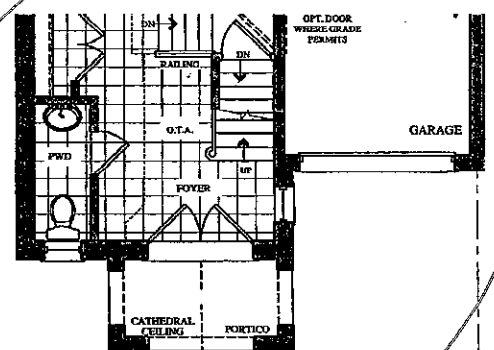

PART. GROUND FLOOR PLAN
ELEV. 'C' & 'D'


Lot 63L
 July 31, 17

(H)


Telephone — (T)
 Cable — (C)

The Wagner SEMI SERIES


Elevation A • 2,127 sq.ft.
 Elevation B • 2,117 sq.ft.
 Elevation C • 2,127 sq.ft.
 Elevation D • 2,127 sq.ft.

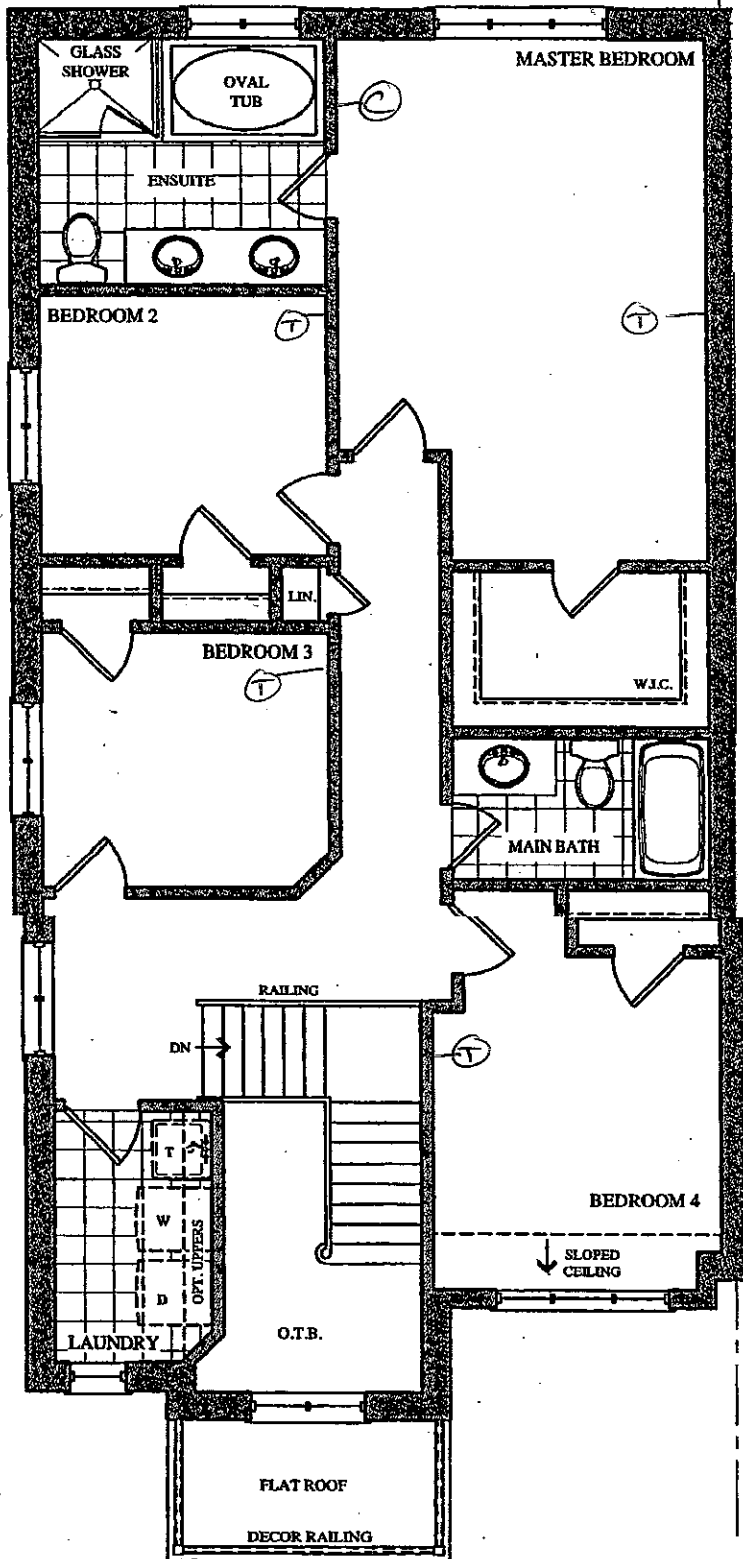


SECOND FLOOR PLAN
ELEV. 'A'

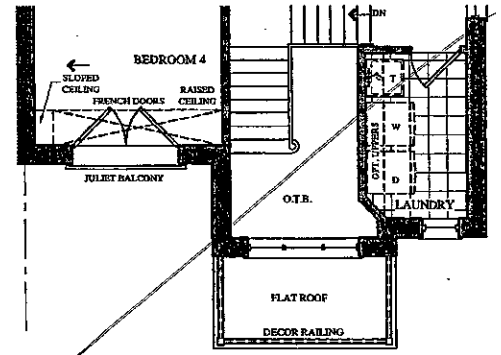

PART. SECOND FLOOR PLAN
ELEV. 'B'

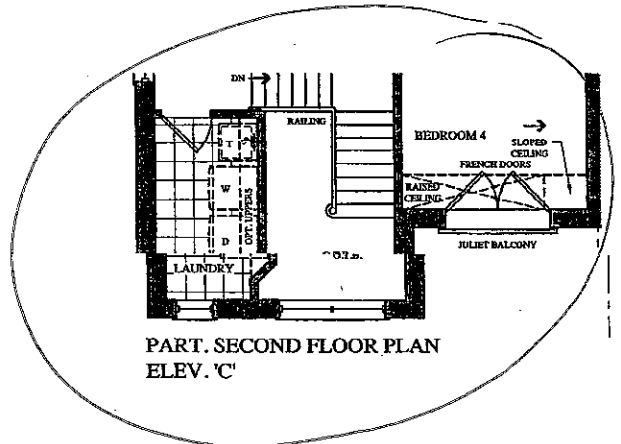

PART. SECOND FLOOR PLAN
ELEV. 'C'

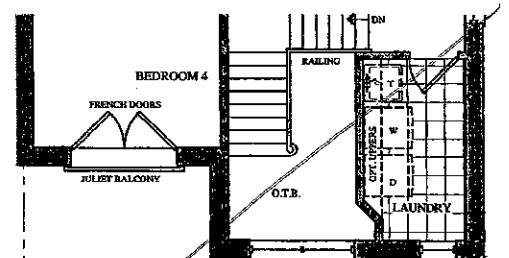

PART. SECOND FLOOR PLAN
ELEV. 'D'


Lot 63L
 July 31, 17

(B)

The Wagner

SEMI SERIES


Elevation A • 2,127 sq.ft.
Elevation B • 2,117 sq.ft.
Elevation C • 2,127 sq.ft.
Elevation D • 2,127 sq.ft.

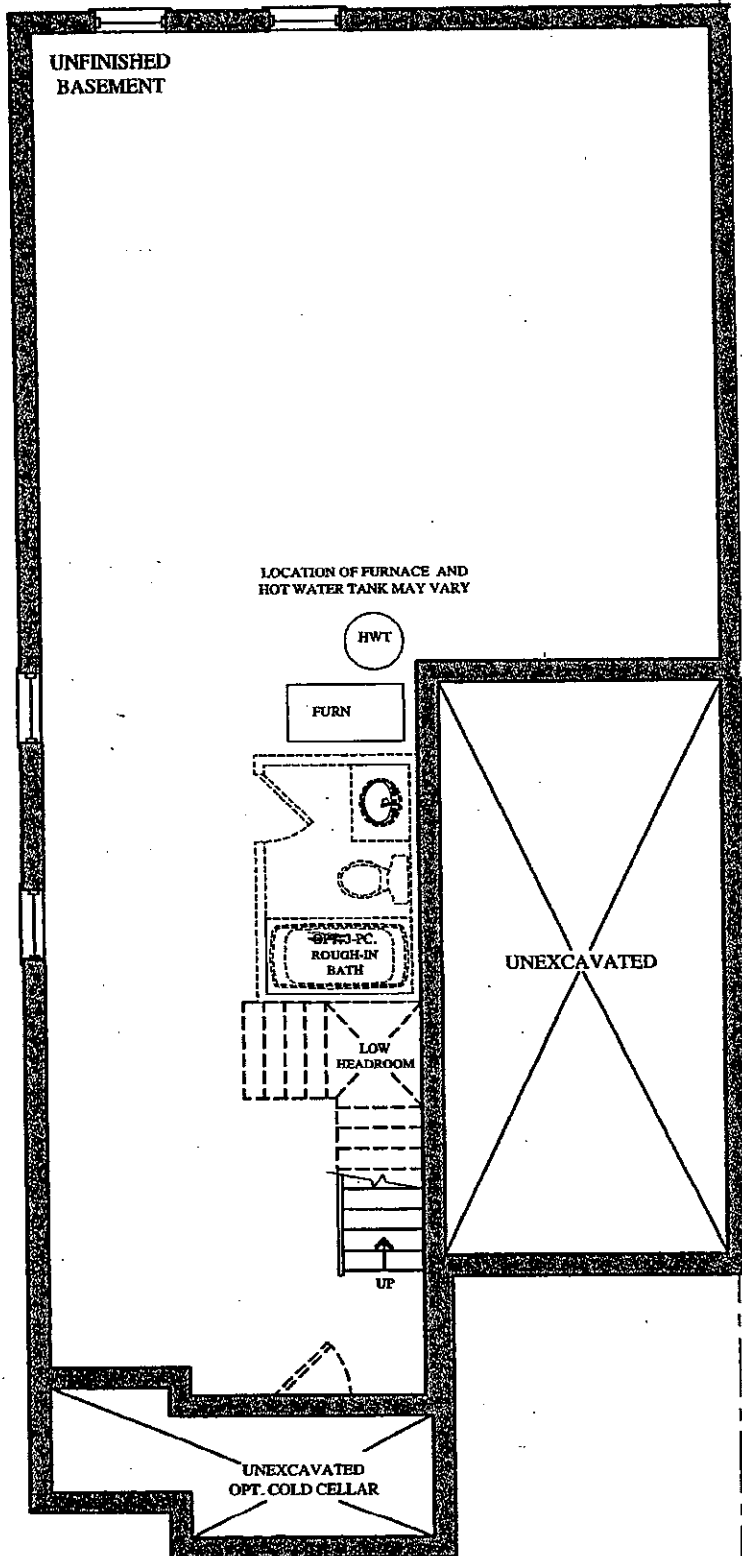

**BASEMENT FLOOR PLAN
ELEV. 'A' & 'B'**

Lot 63L
July 31, 17

89

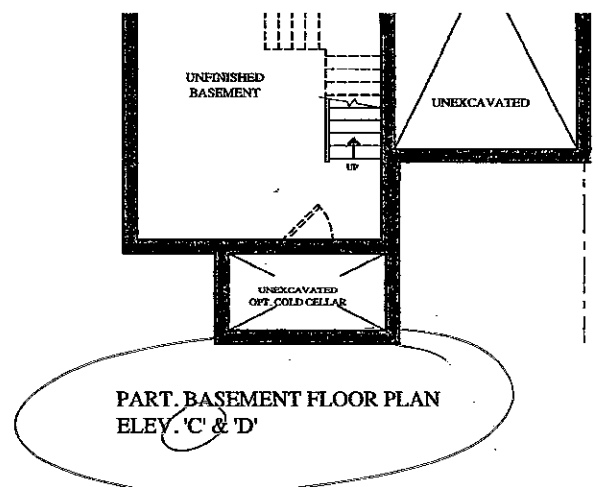

**PART. BASEMENT FLOOR PLAN
ELEV. 'C' & 'D'**