

Brampton Encore - 57L - 2 - 28-4 Elev.C ROSSINI
CENTRAL VAC AND WIRING

Inv.1,539	1 - TELEPHONE AND CABLE ROUGH-IN LOCATIONS
Line23677	Note:
31Jul17 / 23Nov17	

CONCRETE AND DRAIN

Inv.1,539	1 - BASEMENT: INSTALL ROUGH-IN - 3PC BASEMENT ROUGH-IN
Line23678	Note:
31Jul17 / 23Nov17	

Exterior Colours

Inv.1,539	1 - EXTERIOR COLOUR PACKAGE # 4
Line24662	Note:
31Jul17 / 23Nov17	

Inv.1,539	1 - EXTERIOR COLOUR PACKAGE #4
Line24811	Note:
31Jul17 / 23Nov17	

FRAMING

Inv.1,539	1 - GARAGE: INSTALL ROUGH-IN MANDOOR - GARAGE TO HOUSE- AS PER PLAN AND GRADE PERMITTING
Line23680	Note:
31Jul17 / 23Nov17	

MISC.

Inv.1,539	1 - REFUND EXTERIOR: INSTALL SIDE DOOR- HOME TO EXTERIOR- AS PER PLAN AND GRADE PERMITTING
Line23679	Note:
31Jul17 / 23Nov17	

Inv.1,539	1 - BONUS PACKAGE: \$4802.50 (INCLUDING TAXES) WORTH OF UPGRADES FROM GOLD PARK HOMES DÉCOR CENTRE IS BEING APPLIED TOWARD THE STRUCTURAL APPOINTMENT. PURCHASER HAS A REMAINING AMOUNT OF \$197.50 (INCLUDING TAXES) TO BE USED TOWARD THE COLOUR APPOINTMENT
Line23681	Note:
31Jul17 / 23Nov17	

Inv.1,539	1 - Purchaser has attended a Structural appointment at the Decor Centre & has DECLINED any additional upgrades and accepts and acknowledges that there will be no further structural changes/additions/deletions to be made upon signing on July 31, 2017
Line23682	Note:
31Jul17 / 23Nov17	


Inv.1,539	1 - Purchasers are aware & accepts that ANY changes made to upgrades after signing this Purchasers Extra Form are subject to a minimum administration fee of \$500. PLUS a 10% holdback fee
Line23683	Note:
31Jul17 / 23Nov17	


Telephone — ①
 Cable — ②

The Rossini

SEMI SERIES

Elevation A • 1,911 sq.ft.
 Elevation B • 1,902 sq.ft.
 Elevation C • 1,966 sq.ft.
 Elevation D • 1,971 sq.ft.

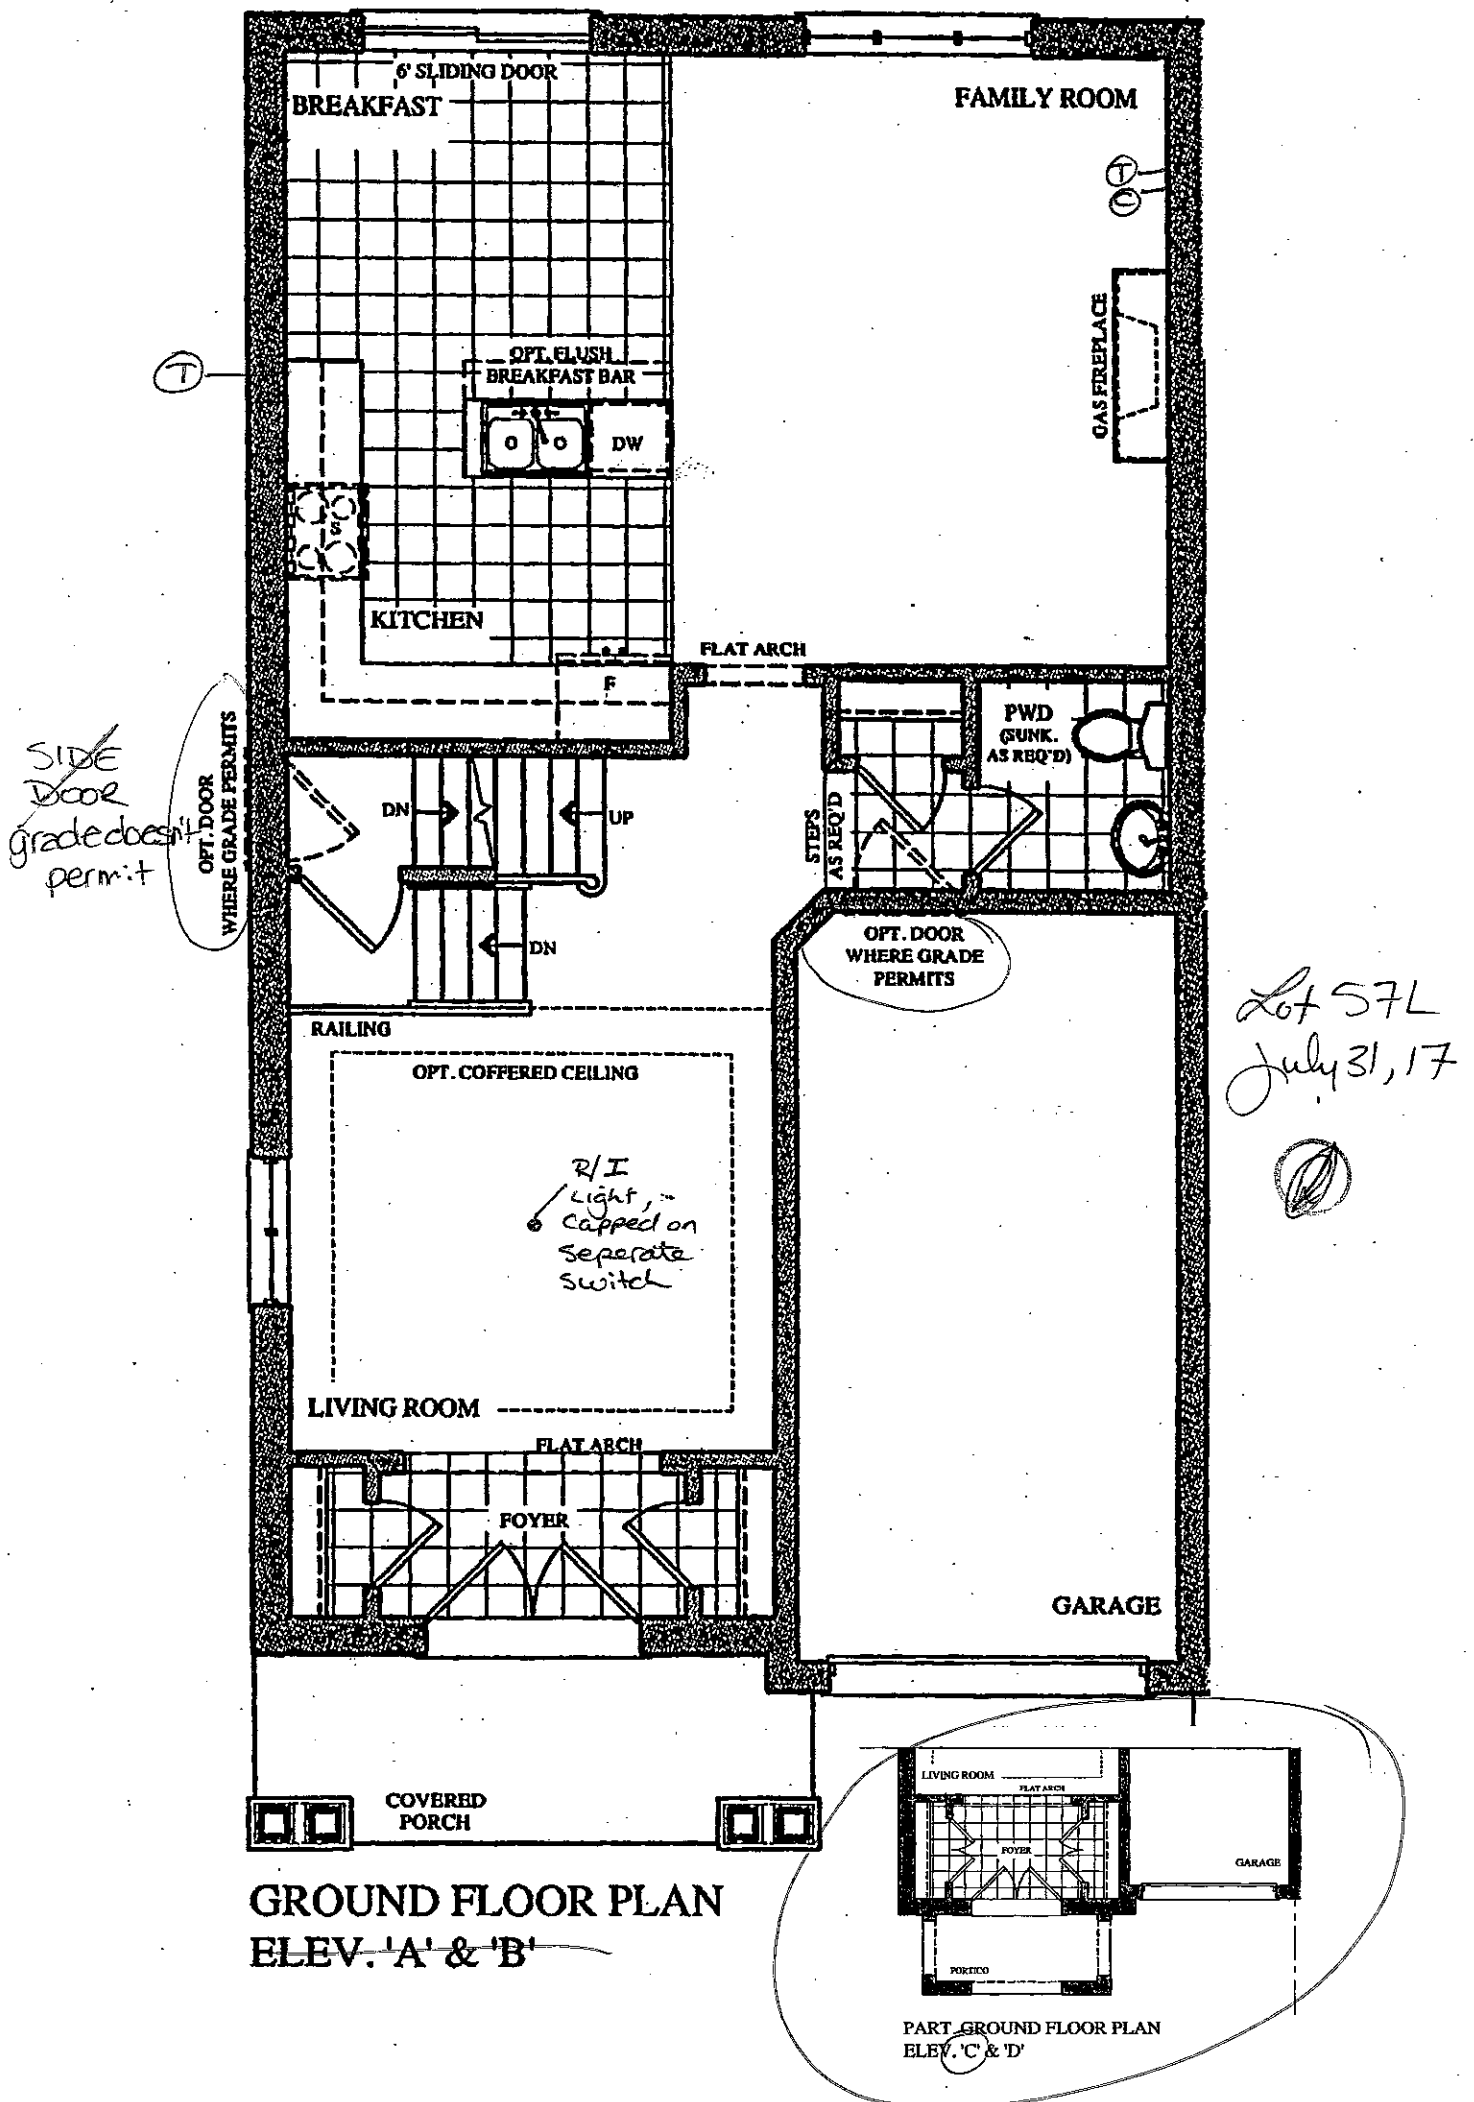

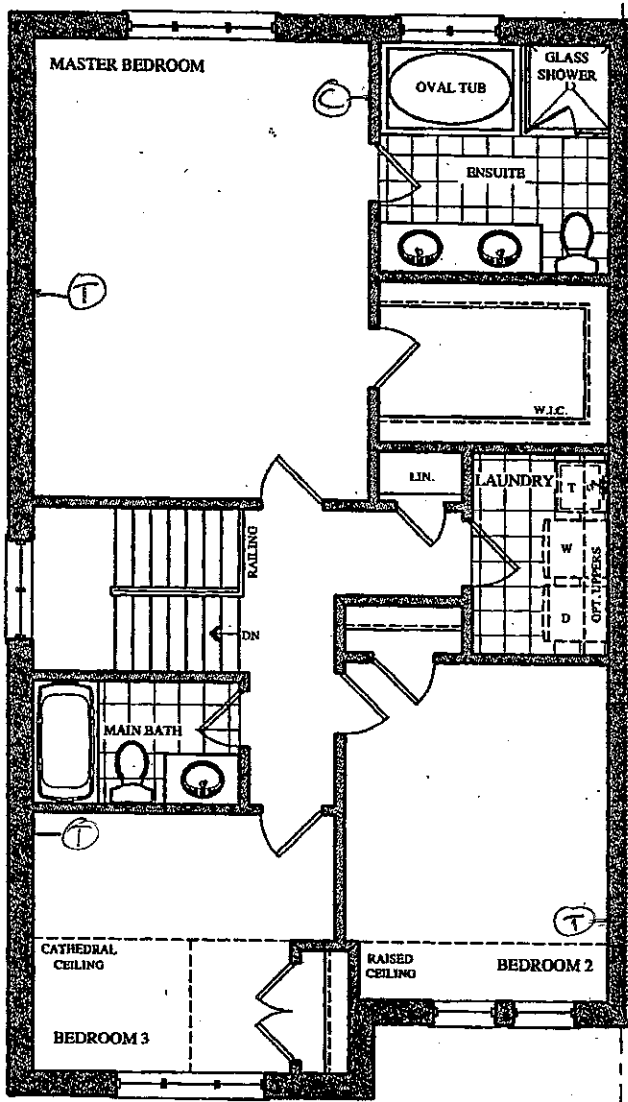


SECOND FLOOR PLAN
ELEV. 'A'


Telephone — (T)
Cable — (C)

The Rossini SEMI SERIES


Elevation A • 1,911 sq.ft.
Elevation B • 1,902 sq.ft.
Elevation C • 1,966 sq.ft.
Elevation D • 1,971 sq.ft.

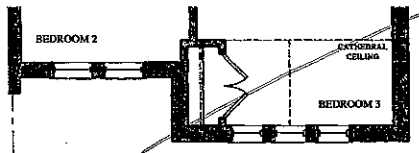


PART. SECOND FLOOR PLAN
ELEV. 'B'

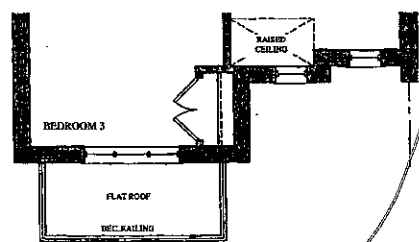


PART. SECOND FLOOR PLAN
ELEV. 'C'

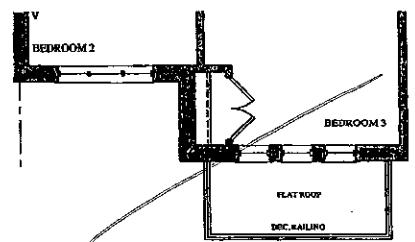


PART. SECOND FLOOR PLAN
ELEV. 'D'

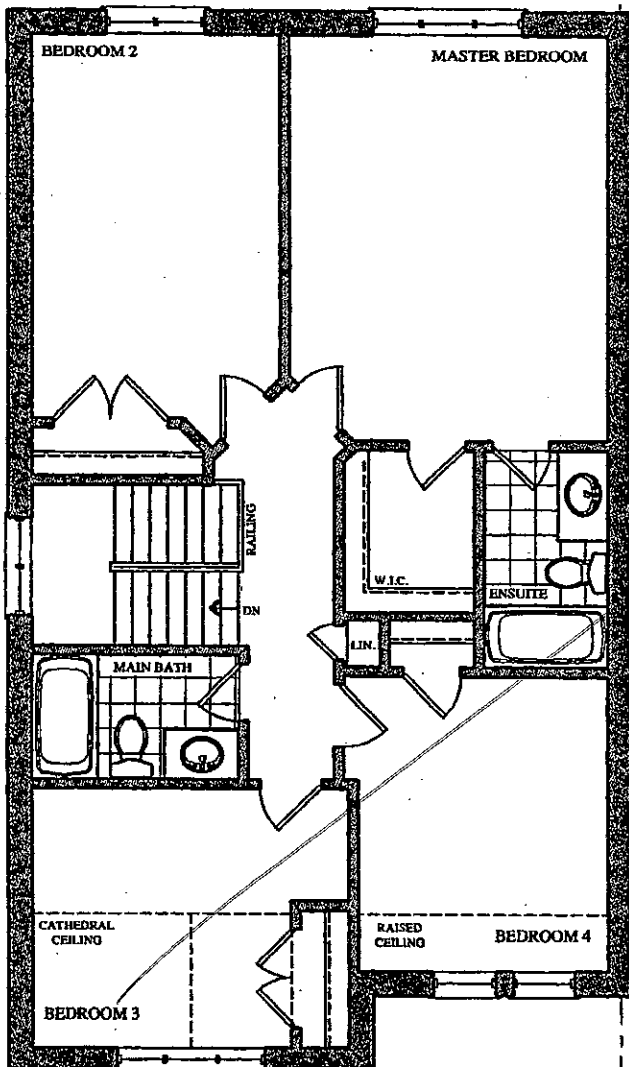


OPT. SECOND FLOOR PLAN
ELEV. 'A'

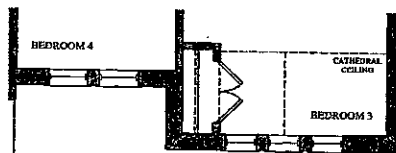

PART. OPT. SECOND FLOOR PLAN
ELEV. 'B'

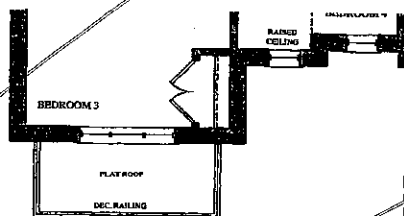

PART. OPT. SECOND FLOOR PLAN
ELEV. 'C'

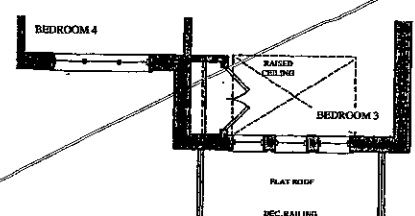


PART. OPT. SECOND FLOOR PLAN
ELEV. 'D'

Lot 57L
July 31, 17


Rossini

SEMI SERIES

Elevation A • 1,911 sq.ft.
 Elevation B • 1,902 sq.ft.
 Elevation C • 1,966 sq.ft.
 Elevation D • 1,971 sq.ft.

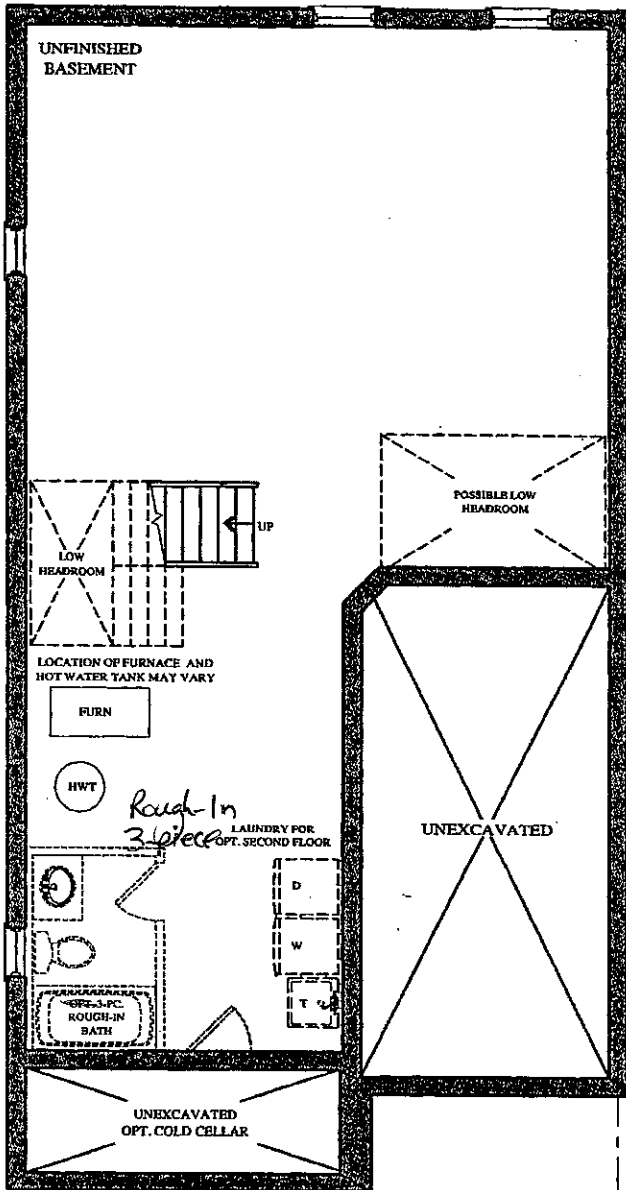

BASEMENT FLOOR PLAN
 ELEV. 'A' & 'B'

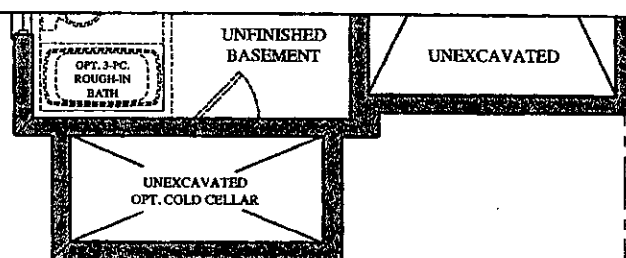

PART. BASEMENT FLOOR PLAN
 ELEV. 'C' & 'D'

Lot 57L
 July 31, 17

