

Brampton Encore - 60R - 2 - 28-2 Elev.CR Siren

CONCRETE AND DRAIN

Inv.1,457	1 - ROUGH-IN - 3PC BASEMENT ROUGH-IN
Line22785	Note:
26Jun17 / 23Nov17	

ELECTRICAL

Inv.1,457	1 - KITCHEN: RELOCATE STANDARD CEILING LIGHT TO APPROX. CENTER ABOVE ISLAND
Line22788	Note:
26Jun17 / 23Nov17	

Exterior Colours

Inv.1,457	1 - EXTERIOR COLOUR PACKAGE 8
Line24679	Note:
26Jun17 / 23Nov17	

FORMING

Inv.1,457	1 - SIDE DOOR- HOME TO EXTERIOR- AS PER PLAN AND GRADE PERMITTING
Line22786	Note:
26Jun17 / 23Nov17	

FRAMING

Inv.1,457	1 - MAIN FLOOR: EXTENDED HEIGHT ARCHWAY (PRICE PER DOORWAY) -96"
Line24678	Note:
26Jun17 / 23Nov17	

INTERIOR TRIM AND DOORS

Inv.1,457	1 - MAIN FLOOR: EXTENDED HEIGHT ARCHWAY (PRICE PER DOORWAY) -96"
Line22787	Note:
26Jun17 / 23Nov17	

MISC.

Inv.1,457	1 - BONUS PACKAGE: \$10,000.00 (INCLUDING TAXES) WORTH OF UPGRADES FROM GOLD PARK HOMES DÉCOR CENTRE IS BEING APPLIED TOWARD THE STRUCTURAL APPOINTMENT. PURCHASER HAS A REMAINING AMOUNT OF \$4802.00 (INCLUDING TAXES) TO BE USED TOWARD THE COLOUR APPOINTMENT.
Line22789	Note:
26Jun17 / 23Nov17	

Inv.1,457	1 - Purchasers are aware & accepts that ANY changes made to upgrades after signing this Purchasers Extra Form are subject to a minimum administration fee of \$500. PLUS a 10% holdback fee
Line22790	Note:
26Jun17 / 23Nov17	

Inv.1,457	1 - Purchaser has attended an appointment at the Decor Centre & has DECLINED any additional upgrades and accepts and acknowledges that there will be no further changes/additions/deletions to be made upon signing on June 26 2017.
Line22791	Note:
26Jun17 / 23Nov17	

WINDOWS AND DOORS


Inv.1,457	1 - SIDE DOOR- HOME TO EXTERIOR- AS PER PLAN AND GRADE PERMITTING
Line24810	Note:
26Jun17 / 23Nov17	

BEZ-60R
JUNE 26 2017 (11.7)

The Siren

SEMI SERIES


Elevation A • 1,688 sq.ft.
Elevation B • 1,677 sq.ft.
→ Elevation C • 1,687 sq.ft.

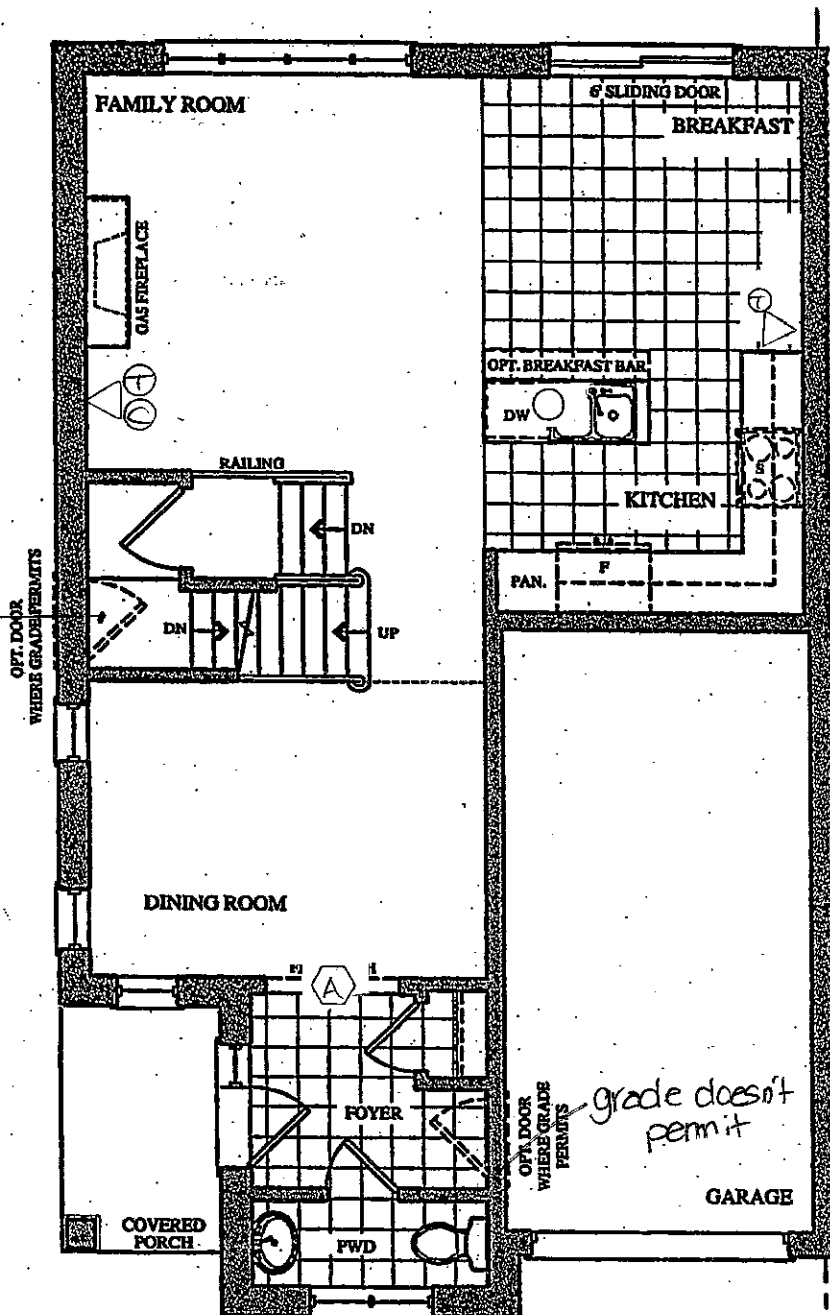

LEGEND

- STD CEILING LIGHT
- △ ⊕ PHONE
- △ ⊖ CABLE
- ⬡ 96" ARCH

~~GROUND FLOOR PLAN
ELEV. 'A' & 'B'~~

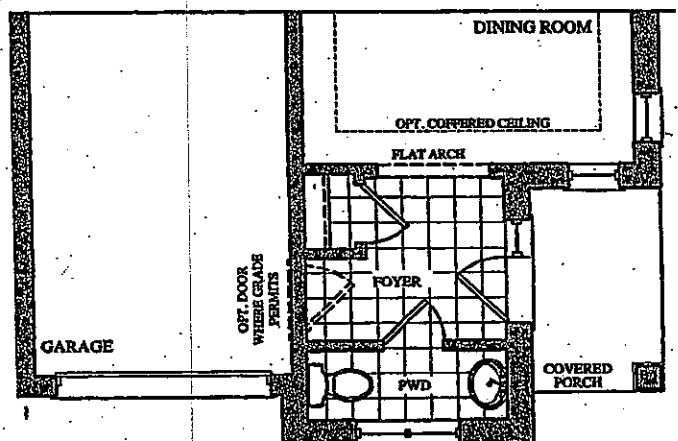


PART. GROUND FLOOR PLAN
ELEV. 'C'

BE2-60R
JUNE 26 2017 (H)K


The Siren

SEMI SERIES


Elevation A • 1,688 sq.ft.
Elevation B • 1,677 sq.ft.
→ Elevation C • 1,687 sq.ft.

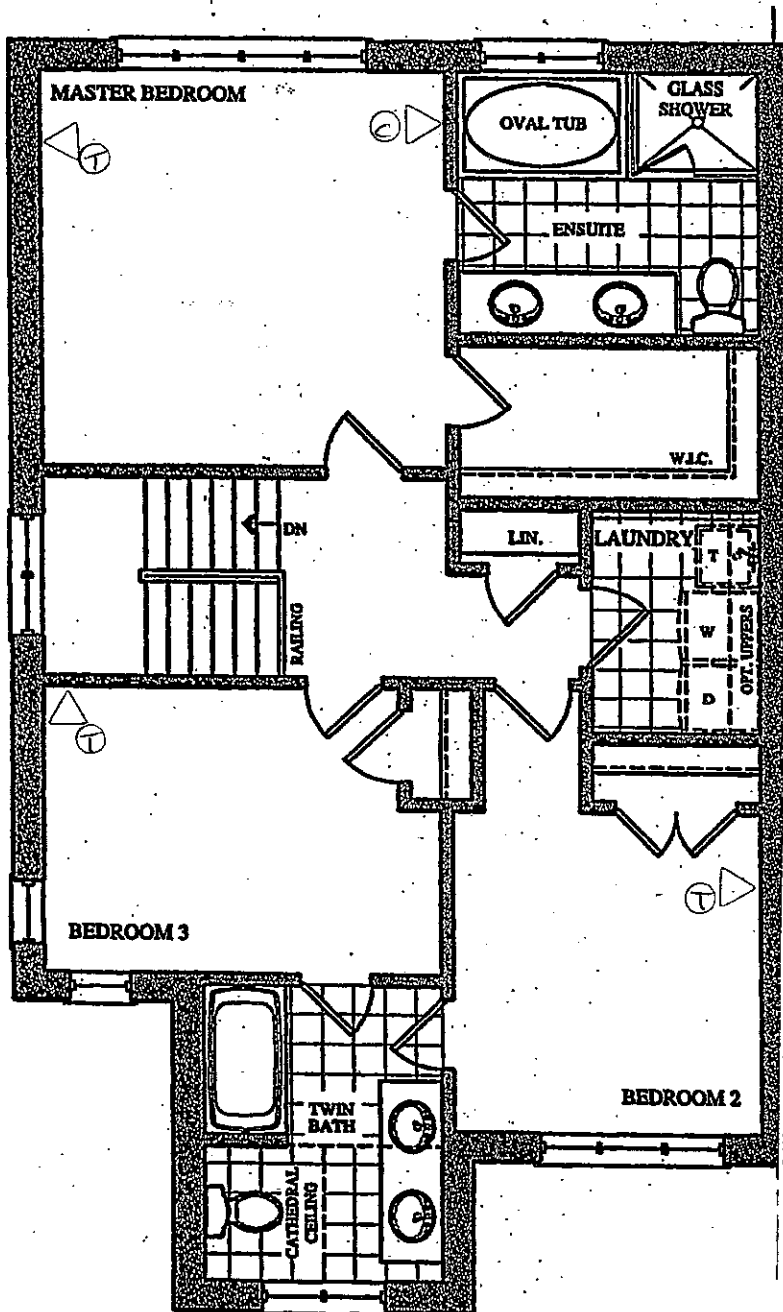

SECOND FLOOR PLAN
ELEV. 'A'

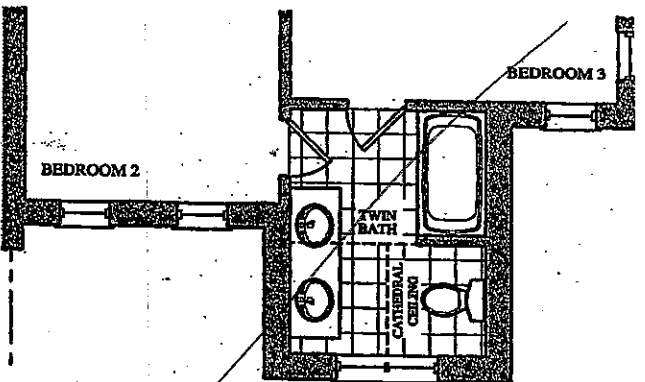

PART. SECOND FLOOR PLAN
ELEV. 'B'

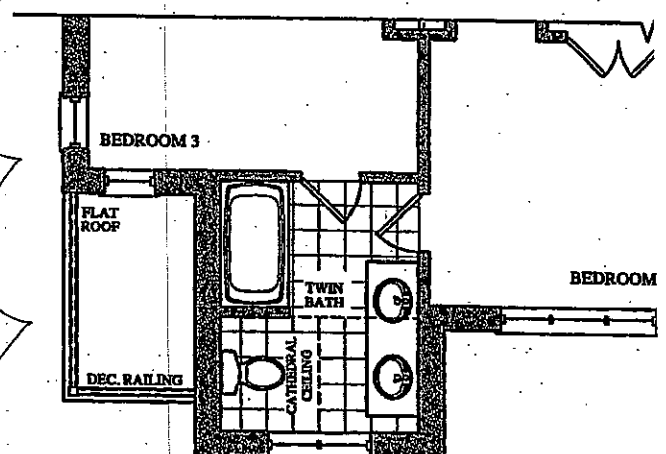

PART. SECOND FLOOR PLAN
ELEV. 'C'

RED-60R
JUNE 26 2017

11-K

The Siren

SEMI SERIES

Elevation A • 1,688 sq.ft.
Elevation B • 1,677 sq.ft.
→ Elevation C • 1,687 sq.ft.

