

**Brampton Encore - 56L - 2 - 28-2 Elev.A SIREN**  
**CENTRAL VAC AND WIRING**

Inv.1,498	1 - TELEPHONE AND CABLE ROUGH-IN LOCATION
Line23194	Note:
11Jul17 / 23Nov17	

**CONCRETE AND DRAIN**

Inv.1,498	1 - BASEMENT: INSTALL ROUGH-IN - 3PC BASEMENT ROUGH-IN
Line23196	Note:
11Jul17 / 23Nov17	

**Exterior Colours**

Inv.1,498	1 - EXTERIOR COLOUR PACKAGE #6
Line24659	Note:
11Jul17 / 23Nov17	

**FRAMING**

Inv.1,498	1 - MAIN FLOOR: INSTALL THREE (X3) STANDARD DOOR EXTENDED HEIGHT 96" (PRICE PER DOOR)- GROUND FLOOR 2 STOREY MODELS
Line24657	Note:
11Jul17 / 23Nov17	
Inv.1,498	1 - GARAGE: INSTALL STANDARD MANDOOR- EXTENDED HEIGHT WHERE GRADE PERMITS
Line24809	Note:
11Jul17 / 23Nov17	

**INTERIOR TRIM AND DOORS**

Inv.1,498	3 - MAIN FLOOR: INSTALL THREE (X3) STANDARD DOOR EXTENDED HEIGHT 96" (PRICE PER DOOR)- GROUND FLOOR 2 STOREY MODELS
Line23197	Note:
11Jul17 / 23Nov17	

**MISC.**

Inv.1,498	1 - BONUS PACKAGE: \$5198.00 (INCLUDING TAXES) WORTH OF UPGRADES FROM GOLD PARK HOMES DÉCOR CENTRE IS BEING APPLIED TOWARD THE STRUCTURAL APPOINTMENT. PURCHASER HAS A REMAINING AMOUNT OF \$4802.00 (INCLUDING TAXES) TO BE USED TOWARD THE COLOUR APPOINTMENT
Line23199	Note:
11Jul17 / 23Nov17	
Inv.1,498	1 - Purchaser has attended a Structural appointment at the Decor Centre & has DECLINED any additional upgrades and accepts and acknowledges that there will be no further structural changes/additions/deletions to be made upon signing on July 11, 2017
Line23200	Note:
11Jul17 / 23Nov17	
Inv.1,498	1 - Purchasers are aware & accepts that ANY changes made to upgrades after signing this Purchasers Extra Form are subject to a minimum administration fee of \$500. PLUS a 10% holdback fee
Line23201	Note:
11Jul17 / 23Nov17	

**WINDOWS - BASEMENT**

Brampton Encore - 56L - 2 - 28-2 Elev.A SIREN

Inv.1,498	3 - BASEMENT: INSTALL THREE (X3) BASEMENT WINDOWS - UPGRADE EXISTING BASEMENT WINDOW TO 30 INCH X 24 INCH - MAY REQUIRE INSTALLATION OF WINDOW WELL
Line23195	Note: PURCHASER IS AWARE THAT THEY WILL GET A WINDOW WELL FOR SIDE WINDOW
11Jul17 / 23Nov17	

WINDOWS AND DOORS



Inv.1,498	1 - GARAGE: INSTALL STANDARD MANDOOR- EXTENDED HEIGHT WHERE GRADE PERMITS
Line23198	Note:
11Jul17 / 23Nov17	

Telephone — (T)  
 Cable — (C)

# The Siren

## SEMI SERIES

Elevation A • 1,688 sq.ft.  
 Elevation B • 1,677 sq.ft.  
 Elevation C • 1,687 sq.ft.

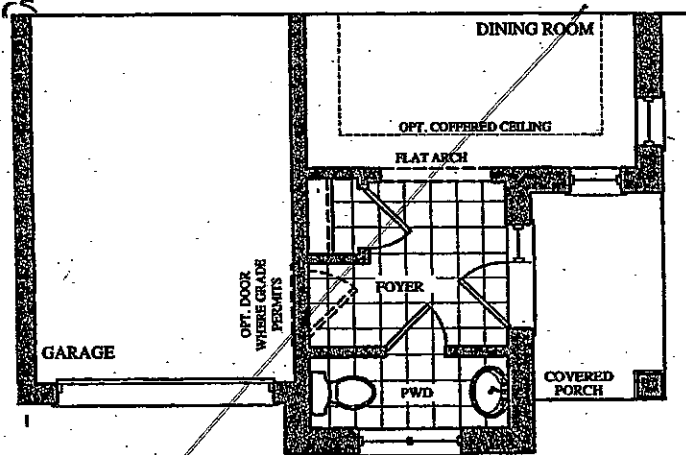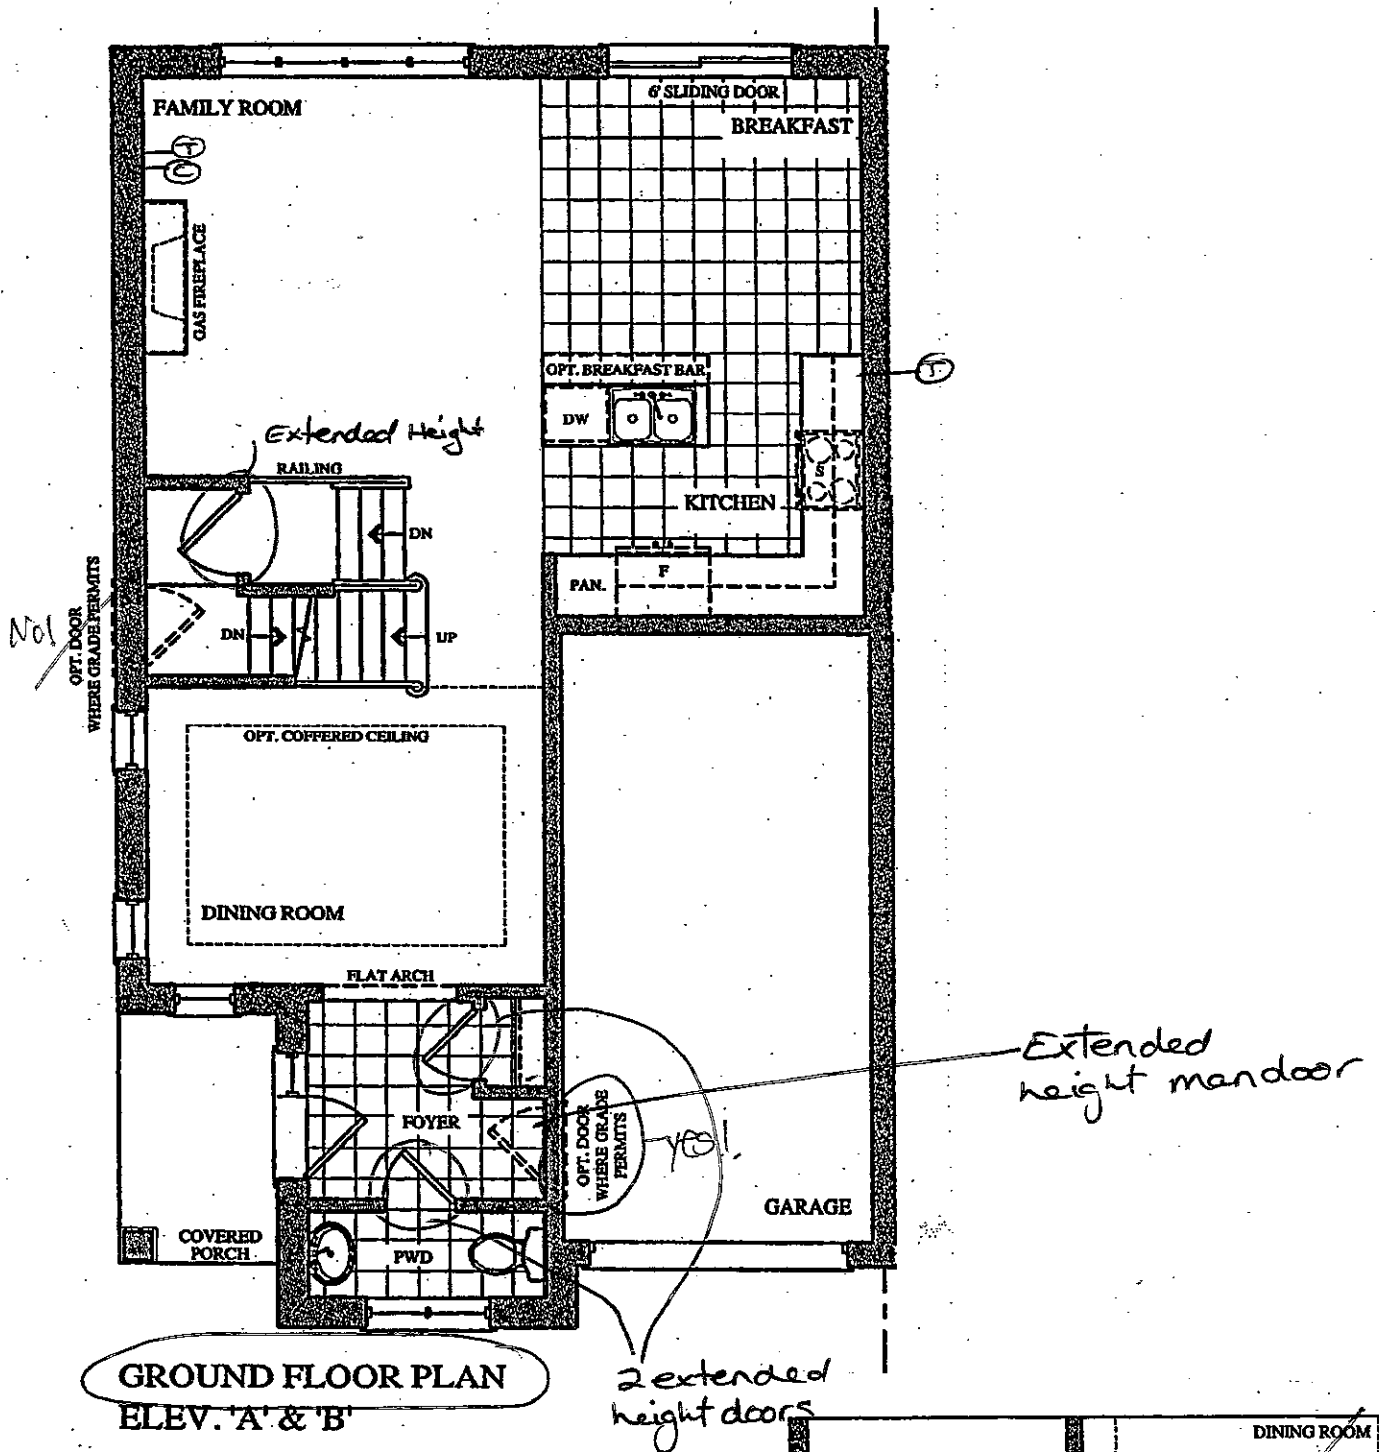

Lot 56L  
 July 11, 17


(B)

PART. GROUND FLOOR PLAN  
ELEV. 'C'

The  
Siren  
SEMI SERIES

BSMNT WINDOWS  
3 x 30"x24"

Elevation A • 1,688 sq.ft.  
Elevation B • 1,677 sq.ft.  
Elevation C • 1,687 sq.ft.

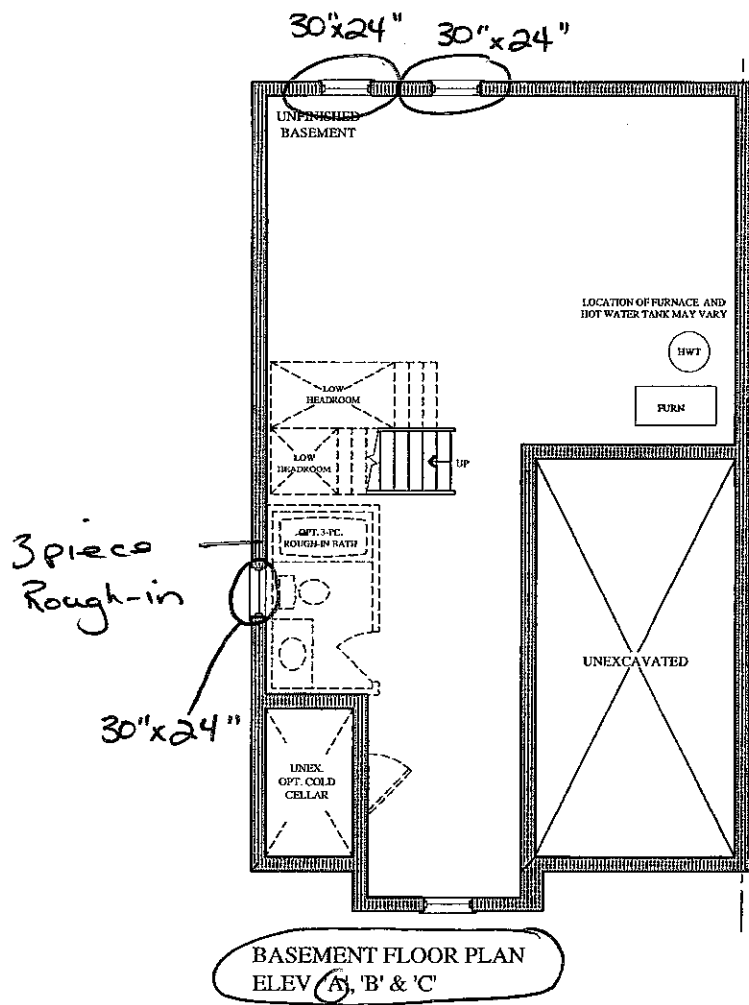

Prices, figures, illustrations, sizes, features and finishes are subject to change without notice. Areas and dimensions are approximate and actual usable floor space may vary from the stated area. Layout may be reverse of the unit purchased. E. & O.E.

GOLDPARK  
WORTH MORE™


Lot 56L  
July 11, 17  
④

Telephone — (T)  
 Cable — (C)


# The Siren

## SEMI SERIES

Elevation A • 1,688 sq.ft.  
 Elevation B • 1,677 sq.ft.  
 Elevation C • 1,687 sq.ft.

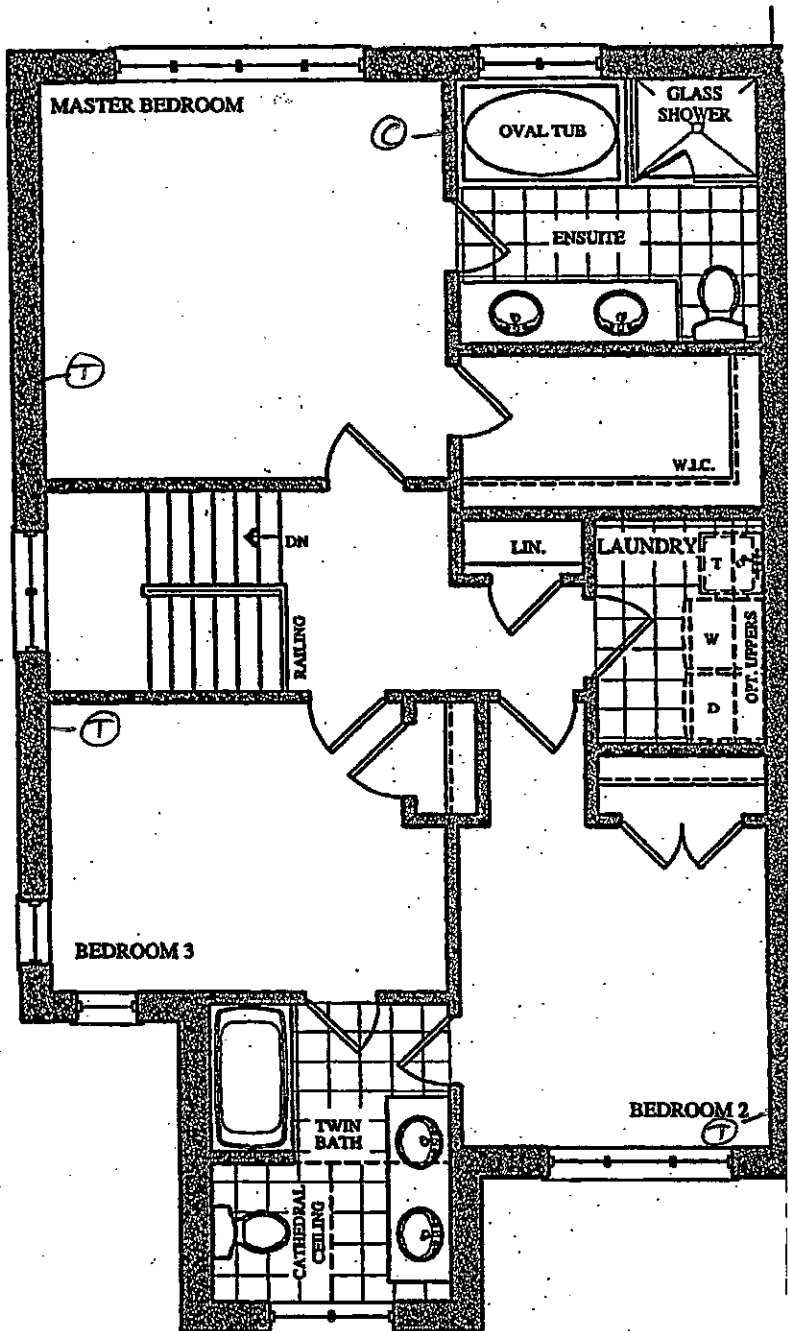


SECOND FLOOR PLAN  
 ELEV. 'A'

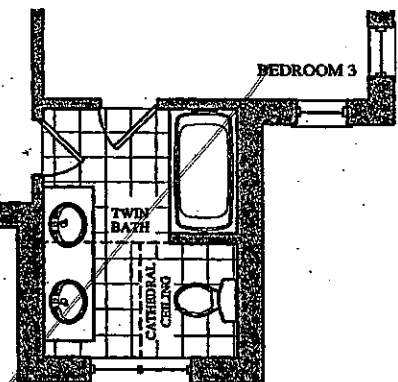

PART. SECOND FLOOR PLAN  
 ELEV. 'B'

Lot 56L  
 July 11, 17

(Signature)

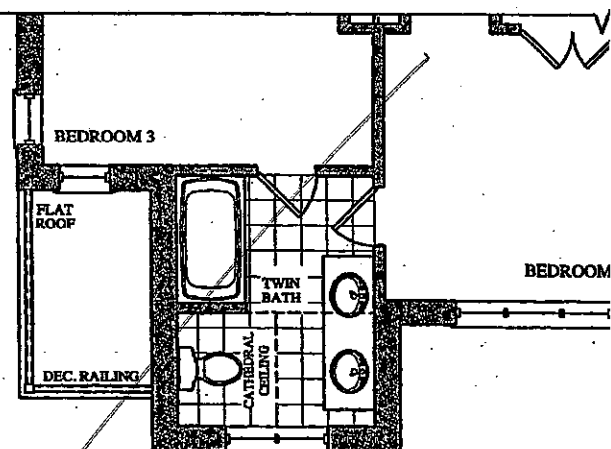

PART. SECOND FLOOR PLAN  
 ELEV. 'C'