

CONSTRUCTION SUMMARY

Brampton Encore - 55R - 2 - 28-2 Elev.CR SIREN

CENTRAL VAC AND WIRING

Inv.1,475	1 - FAMILY ROOM: CONDUIT PIPE- FOR TELEVISION- LOCATE ABOVE FIREPLACE, APPROX. 66" A.F.F., TERMINATING AT CABLE LOCATION. SEE PLAN FOR LOCATION.
Line22974	Note:
6Jul17 / 23Nov17	

CONCRETE AND DRAIN

Inv.1,475	1 - ROUGH-IN - 3PC BASEMENT ROUGH-IN
Line22977	Note:
6Jul17 / 23Nov17	

ELECTRICAL

Inv.1,475	1 - FAMILY ROOM: 110V WALL RECEPTACLE ON NORMAL CIRCUIT- LOCATE APPROX. 66" A.F.F.
Line22973	Note:
6Jul17 / 23Nov17	
Inv.1,475	1 - KITCHEN: RELOCATE STANDARD CEILING LIGHT TO ABOVE ISLAND, SEE PLAN FOR LOCATION.
Line22975	Note:
6Jul17 / 23Nov17	
Inv.1,475	1 - KITCHEN: ROUGH - IN CEILING OUTLET ON SAME SWITCH - DOES NOT INCLUDE FIXTURE - LOCATE ABOVE ISLAND, USE SAME SWITCH AS STANDARD LIGHT
Line22976	Note:
6Jul17 / 23Nov17	
Inv.1,475	1 - KITCHEN: 220V WALL RECEPTICAL ON DEDICATED CIRCUIT- FOR 4 WIRE BUILT-IN WALL OVEN - 220v/40a
Line22986	Note:
6Jul17 / 23Nov17	
Inv.1,475	1 - KITCHEN: GAS LINE ROUGH - GROUND FLOOR , COMPLETE WITH 110v ELECTRICAL FOR STOVE
Line24655	Note:
6Jul17 / 23Nov17	

Exterior Colours

Inv.1,475	1 - EXTERIOR COLOUR PACKAGE #3
Line24807	Note:
6Jul17 / 23Nov17	

FRAMING

Inv.1,475	1 - MAIN FLOOR: EXTENDED HEIGHT ARCHWAY (PRICE PER DOORWAY) -96"
Line24656	Note:
6Jul17 / 23Nov17	

HVAC

Inv.1,475	1 - KITCHEN: GAS LINE ROUGH - GROUND FLOOR , COMPLETE WITH 110v ELECTRICAL FOR STOVE
Line22980	Note:
6Jul17 / 23Nov17	

INTERIOR TRIM AND DOORS

Brampton Encore - 55R - 2 - 28-2 Elev.CR SIREN

Inv.1,475	1 - MAIN FLOOR: EXTENDED HEIGHT ARCHWAY (PRICE PER DOORWAY) -96"
Line22981	Note:
6Jul17 / 23Nov17	

MISC.

Inv.1,475	1 - REFUND-GRADE DOESN'T PERMIT- SIDE DOOR- HOME TO EXTERIOR- AS PER PLAN AND GRADE PERMITTING
Line22978	Note:
6Jul17 / 23Nov17	

Inv.1,475	1 - Purchaser has attended an appointment at the Decor Centre & has DECLINED any additional upgrades and accepts and acknowledges that there will be no further changes/additions/deletions to be made upon signing on July 6 2017.
Line22983	Note:
6Jul17 / 23Nov17	


Inv.1,475	1 - Purchasers are aware & accepts that ANY changes made to upgrades after signing this Purchasers Extra Form are subject to a minimum administration fee of \$500. PLUS a 10% holdback fee
Line22984	Note:
6Jul17 / 23Nov17	

Inv.1,475	1 - BONUS PACKAGE: \$5,000.00 (INCLUDING TAXES) WORTH OF UPGRADES FROM GOLD PARK HOMES DÉCOR CENTRE IS BEING APPLIED TOWARD THE STRUCTURAL APPOINTMENT. PURCHASER HAS A REMAINING AMOUNT OF \$00 (INCLUDING TAXES) TO BE USED TOWARD THE COLOUR APPOINTMENT.
Line22985	Note:
6Jul17 / 23Nov17	

PLUMBING

Inv.1,475	1 - KITCHEN: ROUGH-IN - WATERLINE FOR FRIDGE
Line22982	Note:
6Jul17 / 23Nov17	

BEZ-55R
July 6 2017

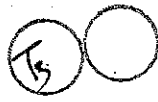


The Siren

SEMI SERIES


Elevation A • 1,688 sq.ft.

Elevation B • 1,677 sq.ft.

→ Elevation C • 1,687 sq.ft.

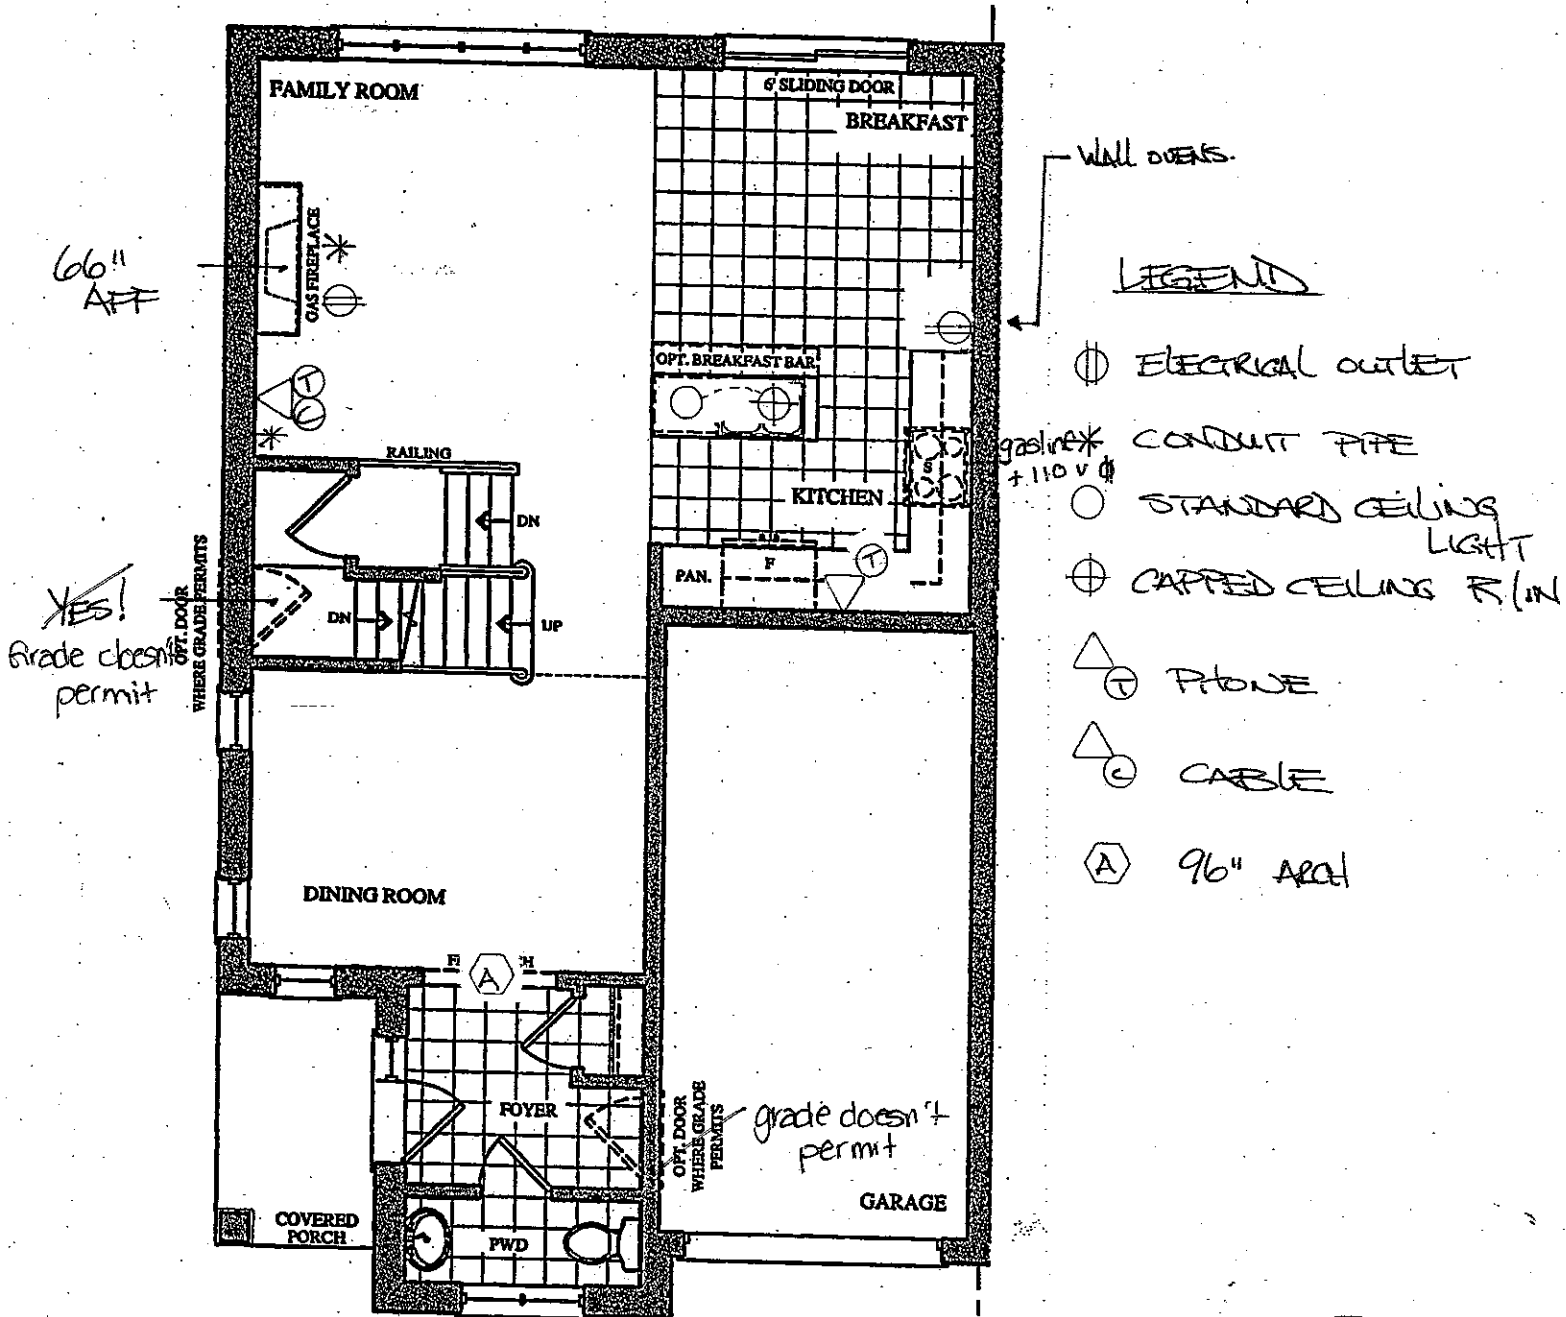

GROUND FLOOR PLAN
ELEV. 'A' & 'B'

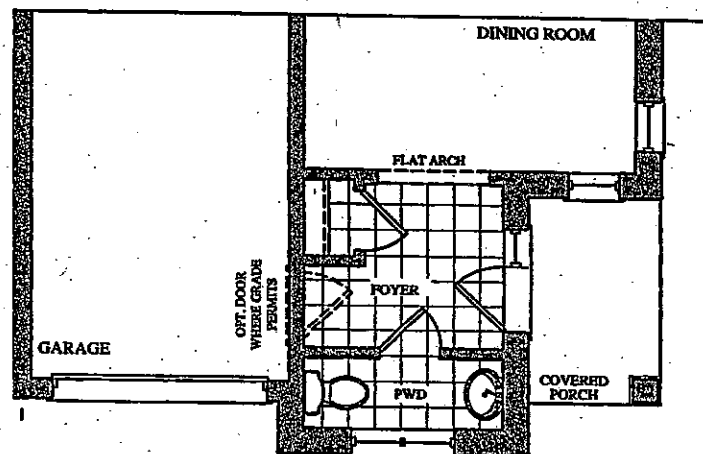

PART. GROUND FLOOR PLAN
ELEV. 'C'

BE2-552
July 6 2017

15


The Siren

SEMI SERIES


Elevation A • 1,688 sq.ft.

Elevation B • 1,677 sq.ft.


→ Elevation C • 1,687 sq.ft.

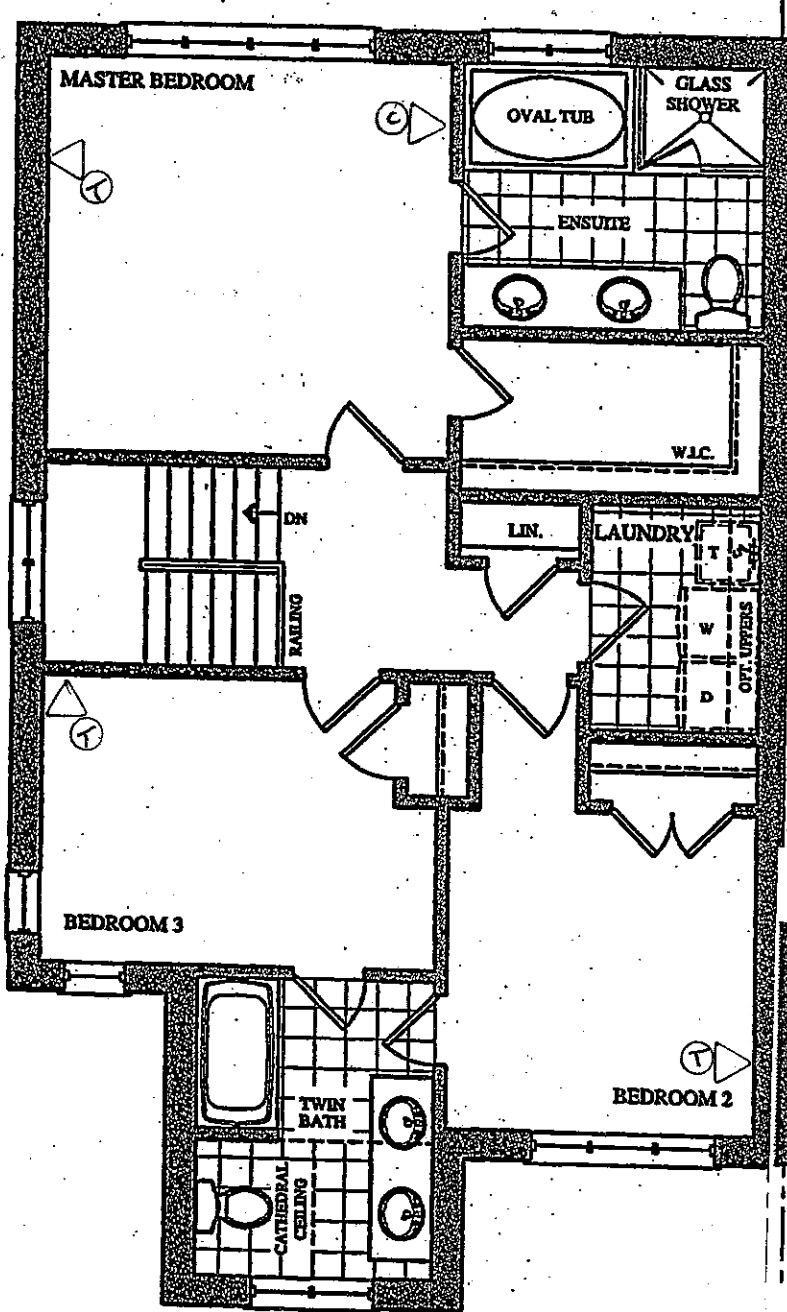

~~SECOND FLOOR PLAN
ELEV. 'A'~~

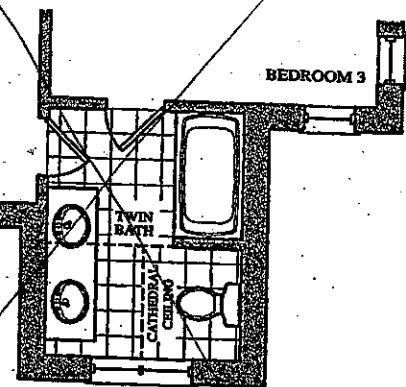

PART. SECOND FLOOR PLAN
ELEV. 'B'

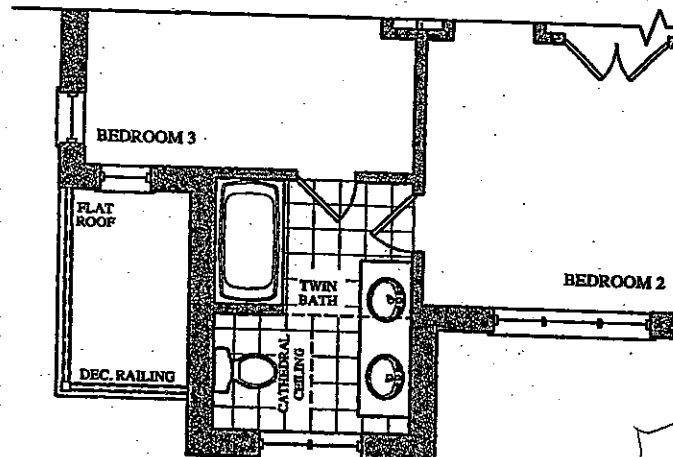

PART. SECOND FLOOR PLAN
ELEV. 'C'

BEZ-55R
July 6 2017



The Siren

SEMI SERIES

Elevation A • 1,688 sq.ft.

Elevation B • 1,677 sq.ft.

→ Elevation C • 1,687 sq.ft.

