

Brampton Encore - 34L - 2 - 28-6 Elev.C Berlio OPT4

CONCRETE AND DRAIN

Inv.1,477	1 - ROUGH-IN - 3PC BASEMENT ROUGH-IN
Line22989	Note:
6Jul17 / 23Nov17	

ELECTRICAL

Inv.1,477	1 - KITCHEN: RELOCATE STANDARD CEILING TO ABOVE ISLAND. SEE PLAN FOR LOCATION
Line22987	Note:
6Jul17 / 23Nov17	

Inv.1,477	1 - KITCHEN: ROUGH - IN CEILING OUTLET ON SAME SWITCH - DOES NOT INCLUDE FIXTURE - LOCATE ABOVE ISLAND, USE SAME SWITCH AS STANDARD LIGHT. SEE PLAN FOR LOCATION
Line22988	Note:
6Jul17 / 23Nov17	

Exterior Colours

Inv.1,477	1 - EXTERIOR COLOUR PACKAGE #9
Line24806	Note:
6Jul17 / 23Nov17	

FORMING

Inv.1,477	1 - SIDE DOOR- HOME TO EXTERIOR- AS PER PLAN AND GRADE PERMITTING
Line22990	Note:
6Jul17 / 23Nov17	

FRAMING

Inv.1,477	1 - MAIN FLOOR: EXTENDED HEIGHT ARCHWAY (PRICE PER DOORWAY) -96"
Line24804	Note:
6Jul17 / 23Nov17	

Inv.1,477	1 - MAIN FLOOR: STANDARD DOOR EXTENDED HEIGHT 96" (PRICE PER DOOR)- GROUND FLOOR 2 STOREY MODELS
Line24805	Note:
6Jul17 / 23Nov17	

INTERIOR TRIM AND DOORS

Inv.1,477	2 - MAIN FLOOR: EXTENDED HEIGHT ARCHWAY (PRICE PER DOORWAY) -96"
Line22992	Note:
6Jul17 / 23Nov17	

Inv.1,477	3 - MAIN FLOOR: STANDARD DOOR EXTENDED HEIGHT 96" (PRICE PER DOOR)- GROUND FLOOR 2 STOREY MODELS
Line22993	Note:
6Jul17 / 23Nov17	

MISC.

Inv.1,477	1 - Purchaser has attended an appointment at the Decor Centre & has DECLINED any additional upgrades and accepts and acknowledges that there will be no further changes/additions/deletions to be made upon signing on July 6 2017.
Line22994	Note:
6Jul17 / 23Nov17	

Brampton Encore - 34L - 2 - 28-6 Elev.C Berlio OPT4

Inv.1,477	1 - Purchasers are aware & accepts that ANY changes made to upgrades after signing this Purchasers Extra Form are subject to a minimum administration fee of \$500. PLUS a 10% holdback fee.
Line22995	Note:
6Jul17 / 23Nov17	

Inv.1,477	1 - BONUS PACKAGE: \$5,000.00 (INCLUDING TAXES) WORTH OF UPGRADES FROM GOLD PARK HOMES DÉCOR CENTRE IS BEING APPLIED TOWARD THE STRUCTURAL APPOINTMENT. PURCHASER HAS A REMAINING AMOUNT OF \$00 (INCLUDING TAXES) TO BE USED TOWARD THE COLOUR APPOINTMENT.
Line22996	Note:
6Jul17 / 23Nov17	

WINDOWS - BASEMENT

Inv.1,477	2 - BASEMENT WINDOWS - UPGRADE EXISTING BASEMENT WINDOW TO 30 INCH X 24 INCH - MAY REQUIRE INSTALLATION OF WINDOW WELL
Line22991	Note:
6Jul17 / 23Nov17	

WINDOWS AND DOORS

Inv.1,477	1 - SIDE DOOR- HOME TO EXTERIOR- AS PER PLAN AND GRADE PERMITTING
Line24803	Note:
6Jul17 / 23Nov17	

BEZ-34L
July 6 2017

(M2) ○

The Berlio

SEMI SERIES

Elevation A • 2,047 sq.ft.

Elevation B • 2,037 sq.ft.

→ Elevation C • 2,037 sq.ft.

Elevation D • 2,047 sq.ft.

LEGEND

○ STD CEILING LIGHT


⊕ CAPPED CEILING R/LN

⬡ 96" ARCH


⬢ 96" DOOR

△ PHONE

△ CABLE

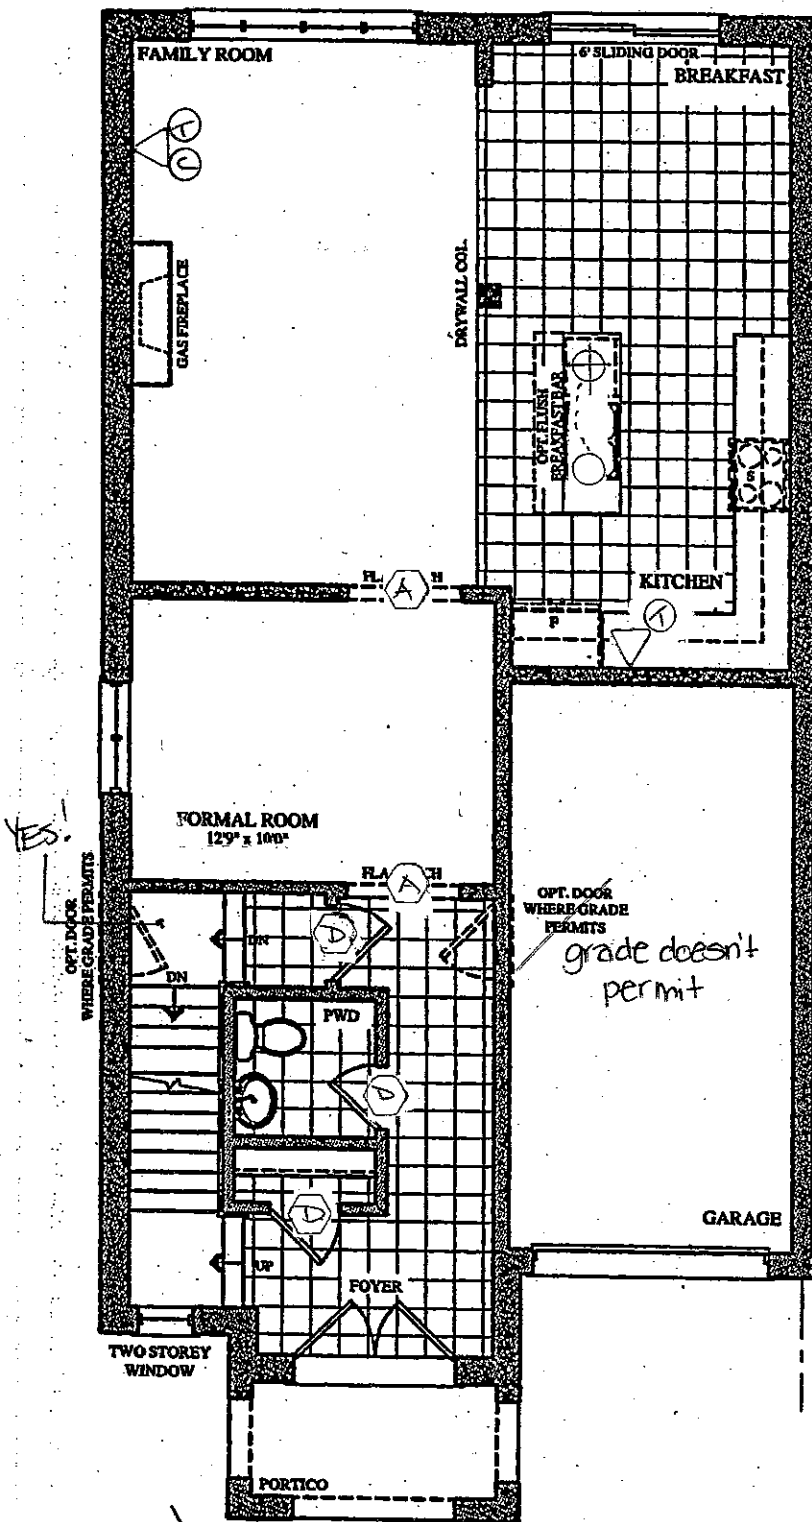

~~GROUND FLOOR PLAN
ELEV. 'A' & 'B'~~

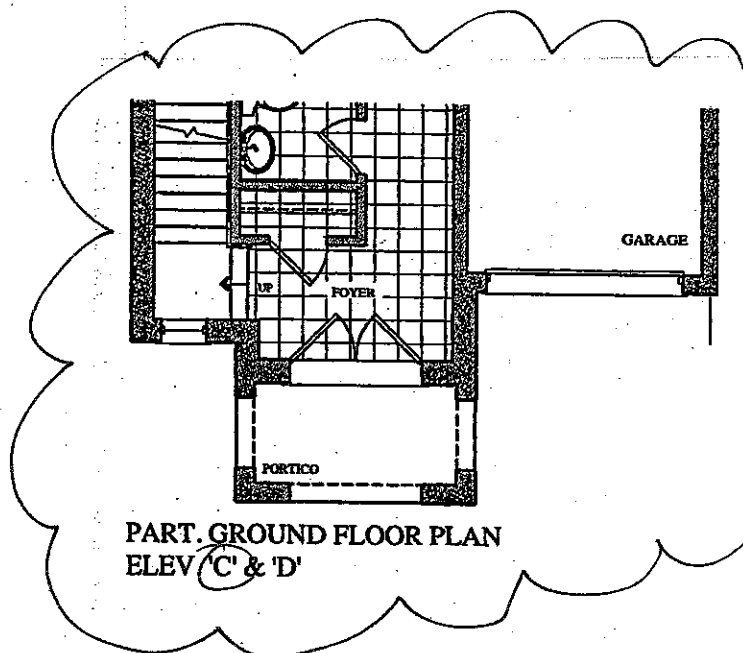

PART. GROUND FLOOR PLAN
ELEV. 'C' & 'D'

The Berlio


SEMI SERIES

Elevation A • 2,047 sq.ft.


Elevation B • 2,037 sq.ft.

Elevation C • 2,037 sq.ft.


Elevation D • 2,047 sq.ft.

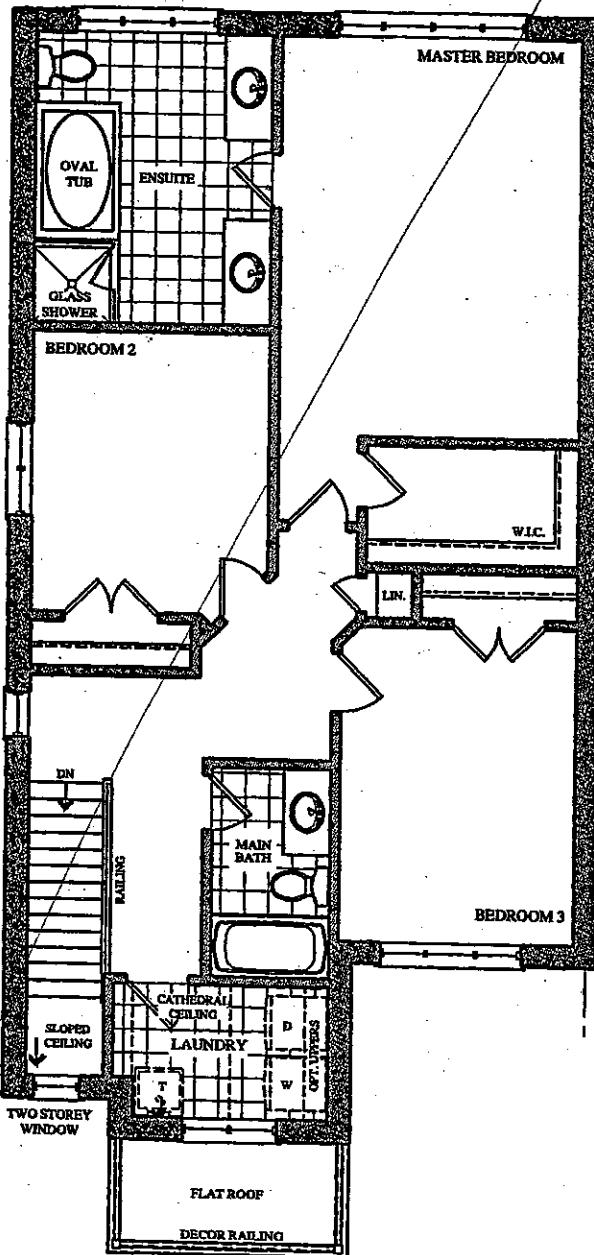


SECOND FLOOR PLAN
ELEV. 'A'

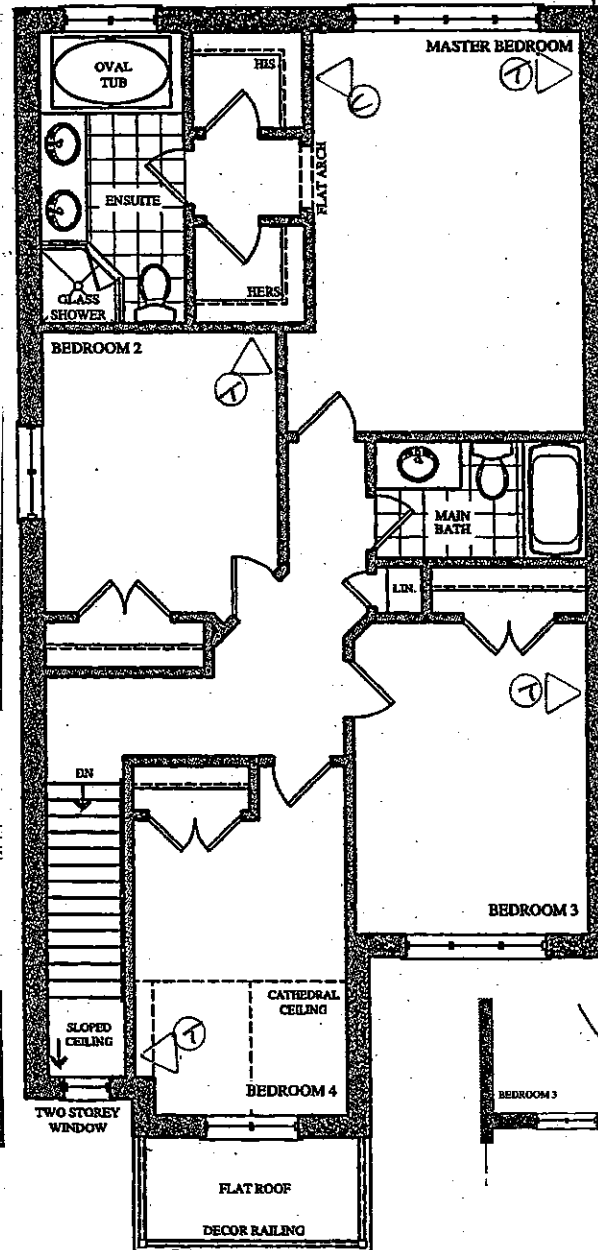


P. E OPT. 4 BED SECOND FLOOR PLAN
ELEV. 'A'

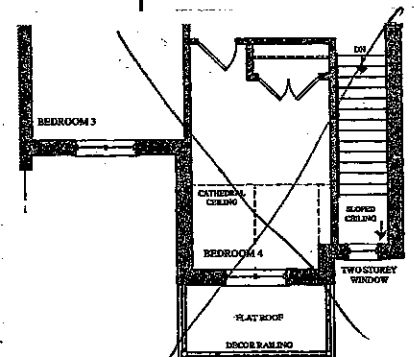


PART. OPT. 4 BED SECOND FLOOR PLAN
ELEV. 'B'

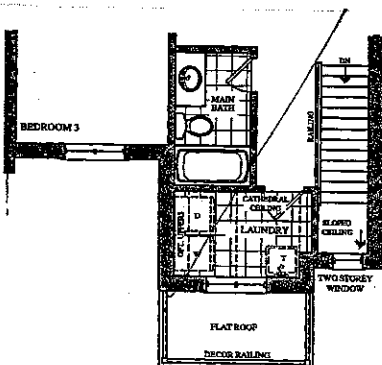


PART. SECOND FLOOR PLAN
ELEV. 'B'

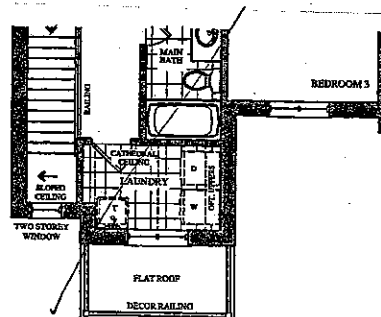


PART. SECOND FLOOR PLAN
ELEV. 'C'

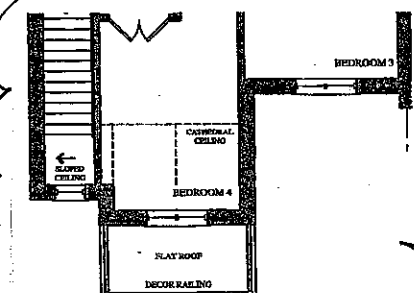

PART. OPT. 4 BED SECOND FLOOR PLAN
ELEV. 'C'

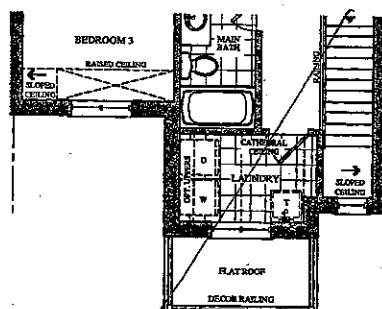

PART. SECOND FLOOR PLAN
ELEV. 'D'

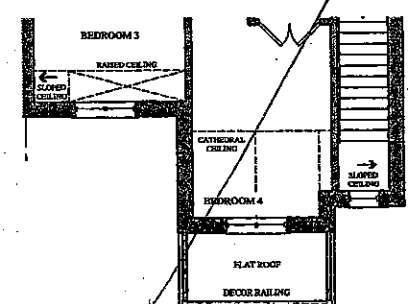


PART. OPT. 4 BED SECOND FLOOR PLAN

The
Berlio
SEMI SERIES

- Elevation A • 2,047 sq.ft.
- Elevation B • 2,037 sq.ft.
- Elevation C • 2,037 sq.ft.
- Elevation D • 2,047 sq.ft.

BE2-34L. (MR)  
July 6 2017

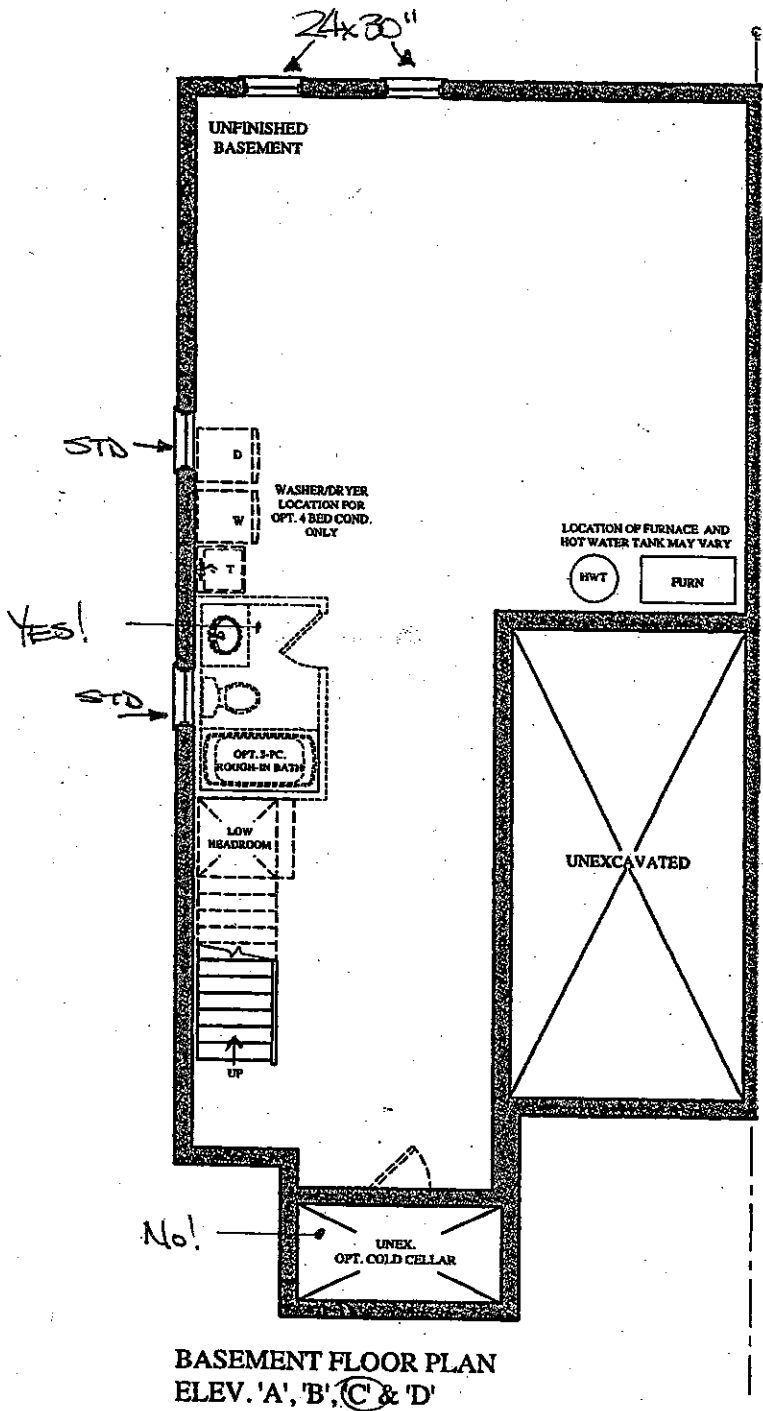

Prices, figures, illustrations, sizes, features and finishes are subject to change without notice. Areas and dimensions are approximate and actual usable floor space may vary from the stated area. Layout may be reverse of the unit purchased. E. & O.E.

GOLDPARK
WORTH MORE™