

Brampton Encore - 25R - 2 - 28-6 Elev.D Berlio OPT4

CENTRAL VAC AND WIRING

Inv.1,512	1 - TELEPHONE AND CABLE ROUGH-IN LOCATIONS
Line23423	Note:
18Jul17 / 23Nov17	
Inv.1,512	1 - FAMILY ROOM: INSTALL CONDUIT PIPE- FOR TELEVISION- MUST SPECIFY LOCATION AND TERMINATION POINT
Line23424	Note:
18Jul17 / 23Nov17	

ELECTRICAL

Inv.1,512	1 - FAMILY ROOM: INSTALL 110V WALL RECEPTACLE ON DEDICATED CIRCUIT - ABOVE FIREPLACE FOR FUTURE TV
Line23425	Note:
18Jul17 / 23Nov17	
Inv.1,512	1 - LIVING ROOM: INSTALL ROUGH - IN WALL OUTLET & SWITCH (WITH COVER PLATE) - DOES NOT INCLUDE FIXTURE - MUST SPECIFY LOCATION
Line23426	Note:
18Jul17 / 23Nov17	

Exterior Colours

Inv.1,512	1 - EXTERIOR COLOUR CHART #8
Line24821	Note:
18Jul17 / 23Nov17	

FORMING

Inv.1,512	1 - EXTERIOR: INSTALL SIDE DOOR- HOME TO EXTERIOR- AS PER PLAN AND GRADE PERMITTING
Line23428	Note:
18Jul17 / 23Nov17	

FRAMING

Inv.1,512	1 - MANDOOR - ROUGH-IN GARAGE TO HOUSE- AS PER PLAN AND GRADE PERMITTING
Line23429	Note:
18Jul17 / 23Nov17	

MISC.

Inv.1,512	1 - BONUS PACKAGE: \$4983.30 (INCLUDING TAXES) WORTH OF UPGRADES FROM GOLD PARK HOMES DÉCOR CENTRE IS BEING APPLIED TOWARD THE STRUCTURAL APPOINTMENT. PURCHASER HAS A REMAINING AMOUNT OF \$16.70 (INCLUDING TAXES) TO BE USED TOWARD THE COLOUR APPOINTMENT
Line23431	Note:
18Jul17 / 23Nov17	
Inv.1,512	1 - Purchaser has attended a Structural appointment at the Decor Centre & has DECLINED any additional upgrades and accepts and acknowledges that there will be no further structural changes/additions/deletions to be made upon signing on July 18, 2017
Line23432	Note:
18Jul17 / 23Nov17	
Inv.1,512	1 - Purchasers are aware & accepts that ANY changes made to upgrades after signing this Purchasers Extra Form are subject to a minimum administration fee of \$500. PLUS a 10% holdback fee
Line23433	Note:
18Jul17 / 23Nov17	

WINDOWS - BASEMENT

Brampton Encore - 25R - 2 - 28-6 Elev.D Berlio OPT4

Inv.1,512	4 - BASEMENT: INSTALL FOUR (X4) BASEMENT WINDOWS - UPGRADE EXISTING BASEMENT WINDOW TO 30 INCH X 24 INCH - MAY REQUIRE INSTALLATION OF WINDOW WELL
Line23427	Note: PURCHASER IS AWARE THAT THEY WILL GET THE WINDOW WELLS ON THE SIDE OF THE HOUSE
18Jul17 / 23Nov17	

WINDOWS AND DOORS


Inv.1,512	1 - EXTERIOR: INSTALL SIDE DOOR- HOME TO EXTERIOR- AS PER PLAN AND GRADE PERMITTING
Line24820	Note:
18Jul17 / 23Nov17	

Telephone — (T)
Cable — (C)
Electrical — (E)

The Berlio


SEMI SERIES

Elevation A • 2,047 sq.ft.
Elevation B • 2,037 sq.ft.
Elevation C • 2,037 sq.ft.
Elevation D • 2,047 sq.ft.

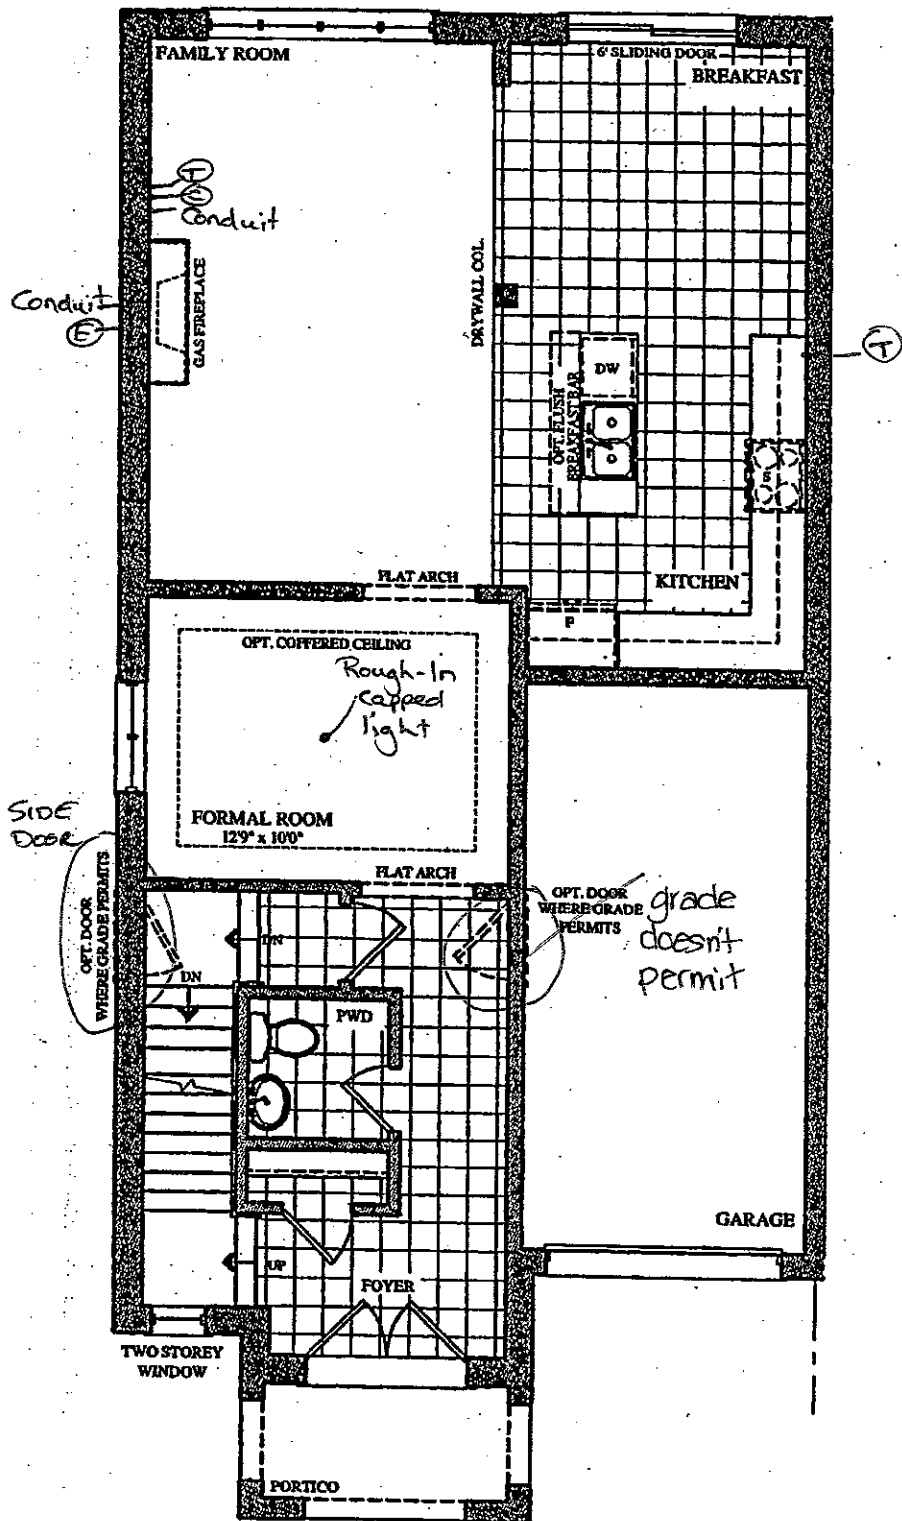

GROUND FLOOR PLAN
ELEV. 'A' & 'B'

Lot 25R
July 18, 17

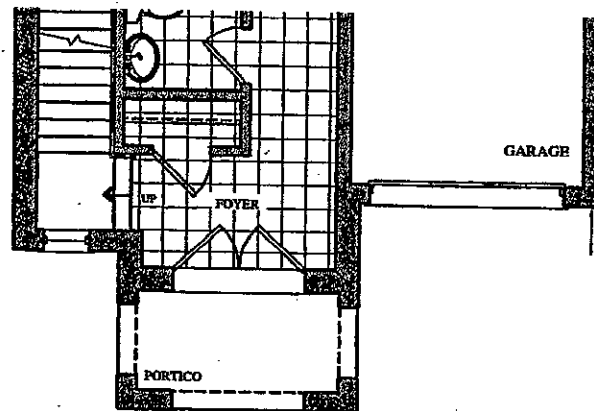


PART GROUND FLOOR PLAN
ELEV. 'C' & 'D'


The Berlio

SEMI SERIES


Elevation A • 2,047 sq.ft.
Elevation B • 2,037 sq.ft.
Elevation C • 2,037 sq.ft.
Elevation D • 2,047 sq.ft.

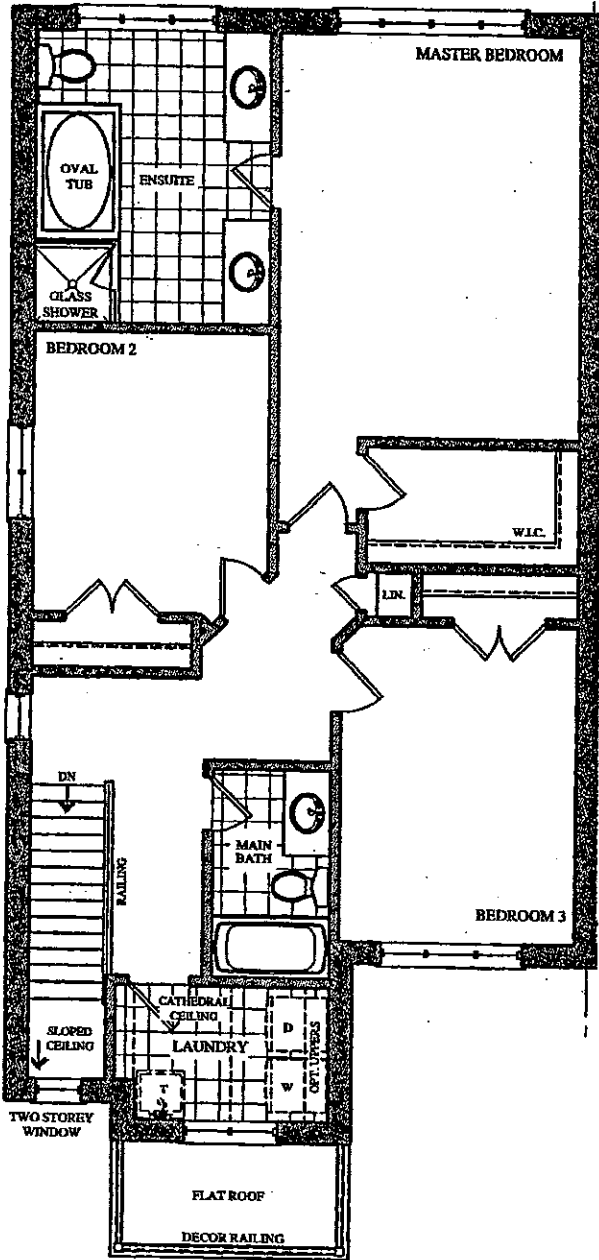


SECOND FLOOR PLAN
ELEV. 'A'

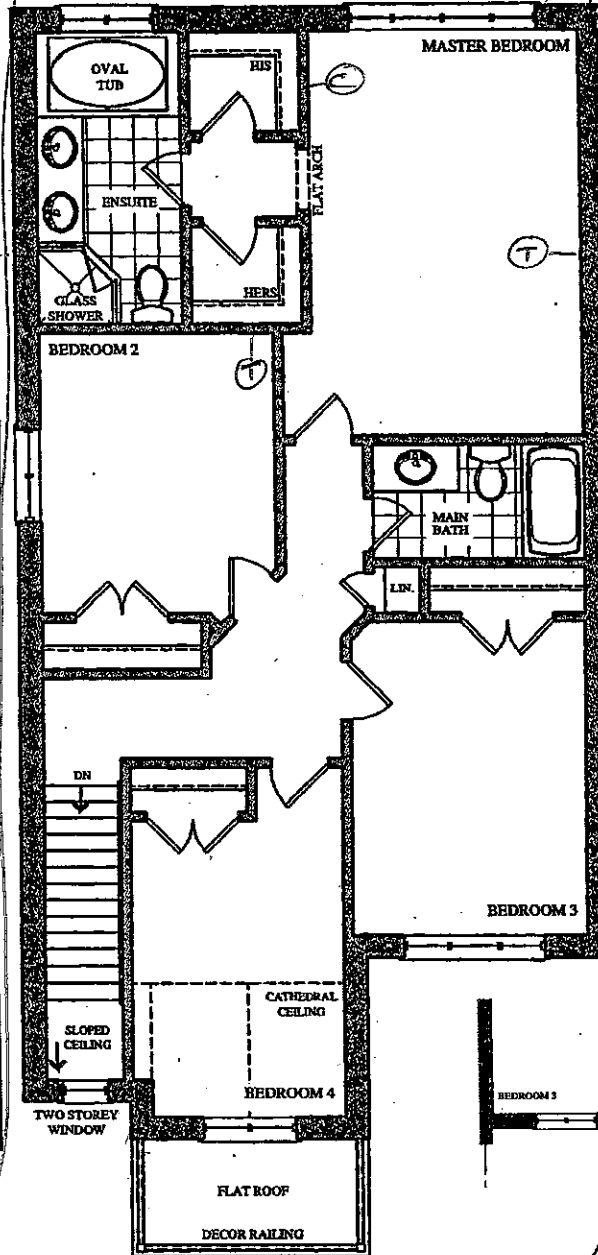


P. E OPT. 4 BED SECOND FLOOR PLAN
ELEV. 'A'

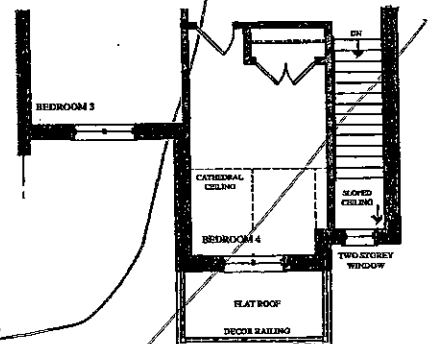


PART. OPT. 4 BED SECOND FLOOR PLAN
ELEV. 'B'

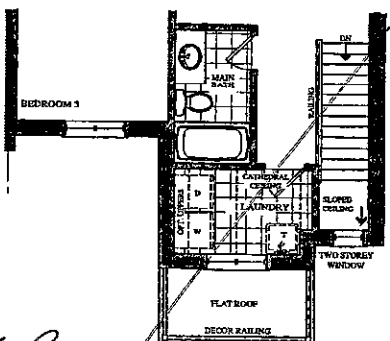


PART. SECOND FLOOR PLAN
ELEV. 'B'

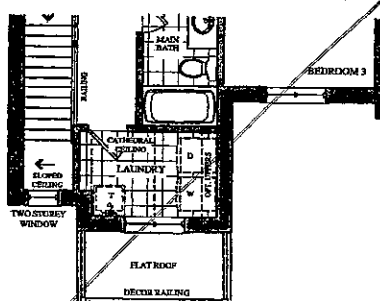


PART. SECOND FLOOR PLAN
ELEV. 'C'

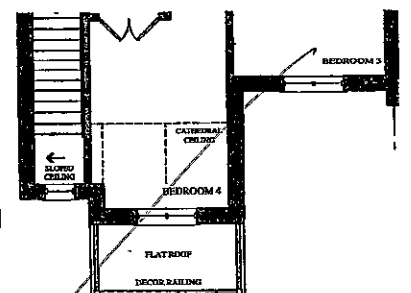

PART. OPT. 4 BED SECOND FLOOR PLAN
ELEV. 'C'

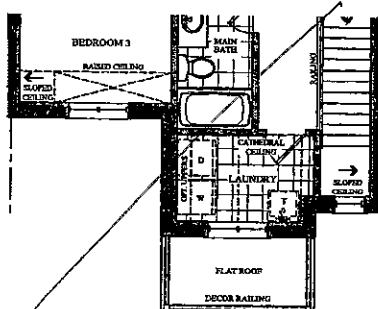

PART. SECOND FLOOR PLAN
ELEV. 'D'

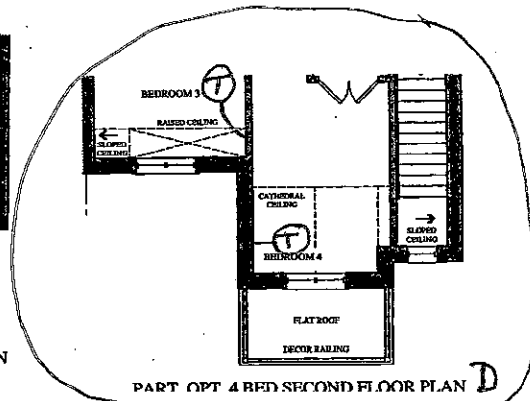


PART. OPT. 4 BED SECOND FLOOR PLAN
ELEV. 'D'

Lot 25 R
July 18, 17

AP

The
Berlio
SEMI SERIES

Elevation A • 2,047 sq.ft.
Elevation B • 2,037 sq.ft.
Elevation C • 2,037 sq.ft.
Elevation D • 2,047 sq.ft.

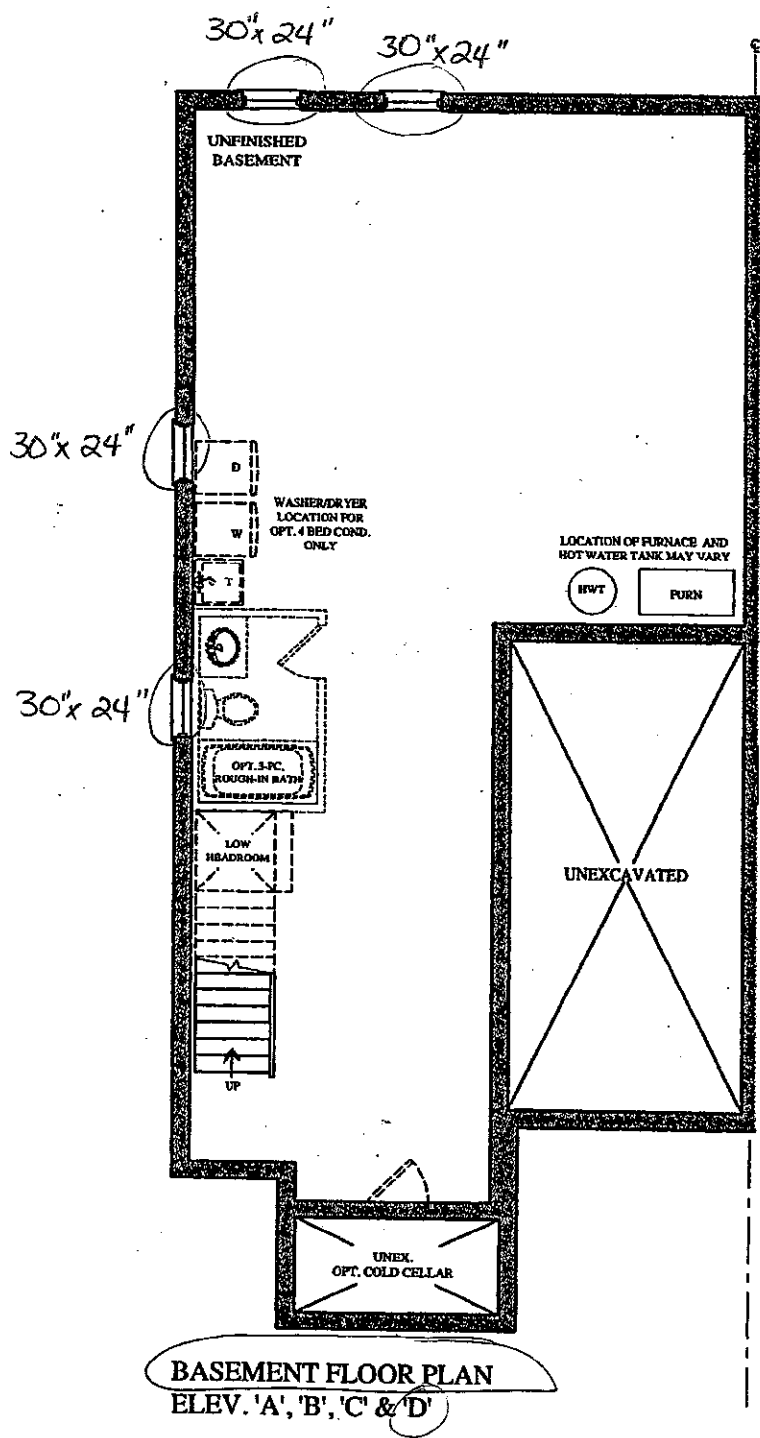

Prices, figures, illustrations, sizes, features and finishes are subject to change without notice. Areas and dimensions are approximate and actual usable floor space may vary from the stated area. Layout may be reverse of the unit purchased. E. & O.E.

GOLDPARK
WORTH MORE™

Lot 25R
July 18, 17
AP