

Brampton Encore - 50R - 2 - 28-7 Elev.D Wagner

CENTRAL VAC AND WIRING

Inv.1,410	1 - FAMILY ROOM: CONDUIT PIPE- FOR TELEVISION- LOCATE APPROX. 66" A.F.F. ABOVE FIREPLACE, TERMINATING BESIDE CABLE OUTLET. SEE PLAN FOR LOCATION.
Line22028	Note:
1Jun17 / 27Nov17	

CONCRETE AND DRAIN

Inv.1,410	1 - BASEMENT: BACK-FLOW PREVENTER VALVE
Line22033	Note:
1Jun17 / 27Nov17	

ELECTRICAL

Inv.1,410	1 - FAMILY ROOM: 110V WALL RECEPTACLE ON NORMAL CIRCUIT- LOCATE APPROX. 66" A.F.F. ABOVE FIREPLACE
Line22027	Note:
1Jun17 / 27Nov17	

Inv.1,410	1 - KITCHEN: RELOCATE STANDARD CEILING LIGHT TO APPROX. CENTER ABOVE ISLAND. SEE PLAN FOR LOCATION.
Line22029	Note:
1Jun17 / 27Nov17	

Exterior Colours

Inv.1,410	1 - EXTERIOR COLOUR PACKAGE #4
Line24635	Note:
1Jun17 / 27Nov17	

Inv.1,410	
Line24825	Note:
1Jun17 / 27Nov17	

FRAMING

Inv.1,410	1 - MANDOOR- GARAGE TO HOUSE- GRADE PERMITS
Line24634	Note:
1Jun17 / 27Nov17	

Inv.1,410	1 - MAIN FLOOR: EXTENDED HEIGHT ARCHWAY (PRICE PER DOORWAY) -96"
Line24636	Note:
1Jun17 / 27Nov17	

Inv.1,410	1 - MAIN FLOOR: EXTENDED HEIGHT ARCHWAYS (PRICE PER DOORWAY) -96"
Line24826	Note:
1Jun17 / 27Nov17	

Inv.1,657	1 - MANDOOR GARAGE TO HOUSE
Line24829	Note:
27Nov17 / 27Nov17	

HVAC

Inv.1,410	1 - INSTALL A/C - LENNOX 2.5 TON
Line22030	Note:
1Jun17 / 27Nov17	

INTERIOR TRIM AND DOORS

Brampton Encore - 50R - 2 - 28-7 Elev.D Wagner

Inv.1,410	2 - MAIN FLOOR: EXTENDED HEIGHT ARCHWAY (PRICE PER DOORWAY) -96"
Line22032	Note:
1Jun17 / 27Nov17	

MISC.

Inv.1,410	1 - Purchaser has attended an appointment at the Decor Centre & has DECLINED any additional upgrades and accepts and acknowledges that there will be no further changes/additions/deletions to be made upon signing on June 1, 2017.
Line22034	Note:
1Jun17 / 27Nov17	

Inv.1,410	1 - Purchasers are aware & accepts that ANY changes made to upgrades after signing this Purchasers Extra Form are subject to a minimum administration fee of \$500. PLUS a 10% holdback fee.
Line22035	Note:
1Jun17 / 27Nov17	

Inv.1,410	1 - BONUS PACKAGE: \$5,000.00 (INCLUDING TAXES) WORTH OF UPGRADES FROM GOLD PARK HOMES DÉCOR CENTRE IS BEING APPLIED TOWARD THE STRUCTURAL APPOINTMENT. PURCHASER HAS A REMAINING AMOUNT OF \$00 (INCLUDING TAXES) TO BE USED TOWARD THE COLOUR APPOINTMENT.
Line22036	Note:
1Jun17 / 27Nov17	

WINDOWS AND DOORS

Inv.1,410	1 - MANDOOR GARAGE TO HOUSE- GRADE PERMITS
Line24633	Note:
1Jun17 / 27Nov17	

Inv.1,657	
Line24828	Note:
27Nov17 / 27Nov17	


BE2-50R
JUNE 1 2017



The Wagner SEMI SERIES

Elevation A • 2,127 sq.ft.
Elevation B • 2,117 sq.ft.
Elevation C • 2,127 sq.ft.
→ Elevation D • 2,127 sq.ft.

66" AFF

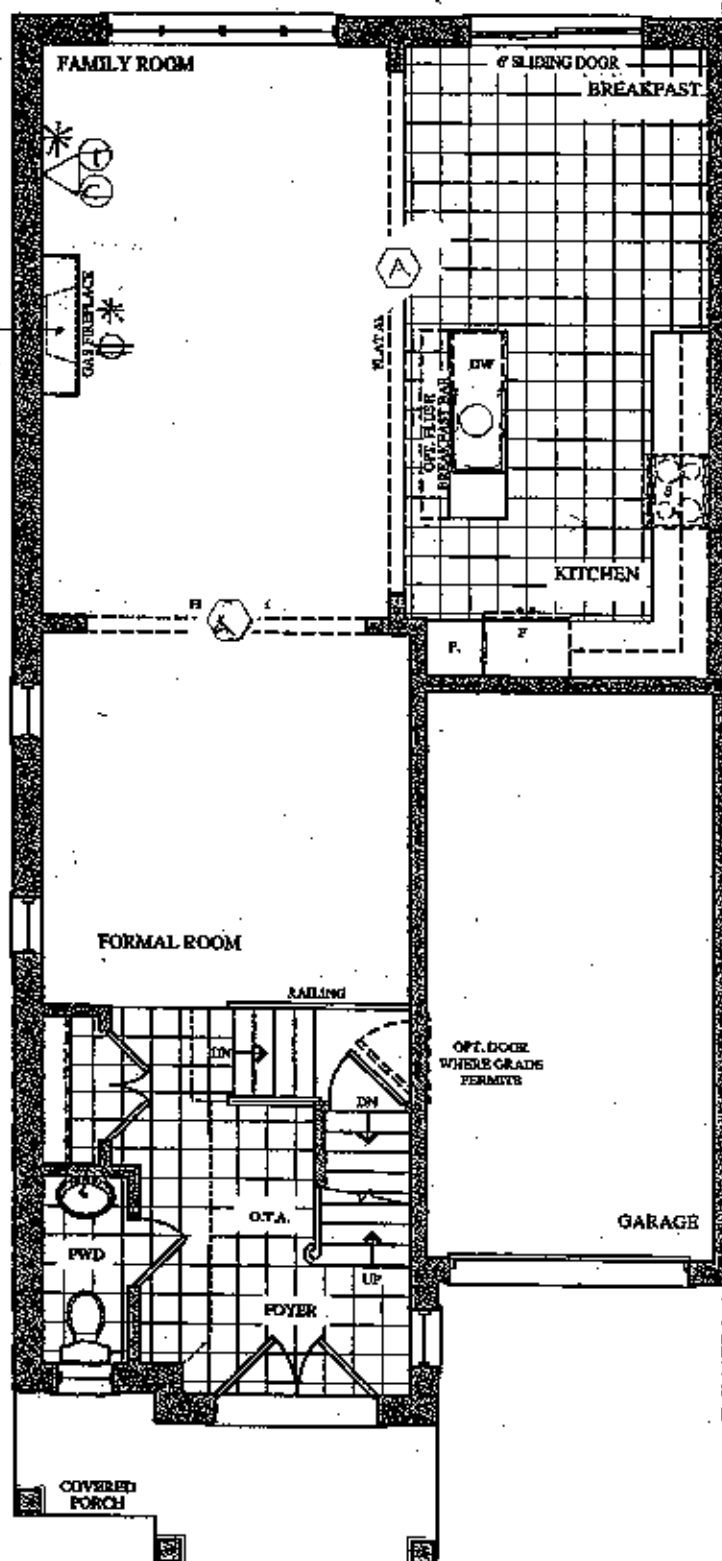


GROUND FLOOR PLAN
ELEV. 'A' & 'B'

NO PHONE in KITCHEN!

LEGEND

- STD CEILING LIGHT
- ⊕ ELECT. OUTLET
- Ⓐ 96" A.R.T.
- △ ⊕ PHONE
- △ ⊕ CABLE

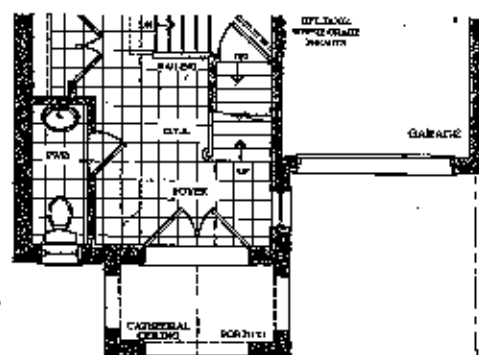


PART. GROUND-FLOOR PLAN
ELEV. 'C' & 'D'

BEZ-502
JUNE 1 2017




The Wagner SEMI SERIES


Elevation A • 2,127 sq.ft.
Elevation B • 2,117 sq.ft.
Elevation C • 2,127 sq.ft.
→ Elevation D • 2,127 sq.ft.

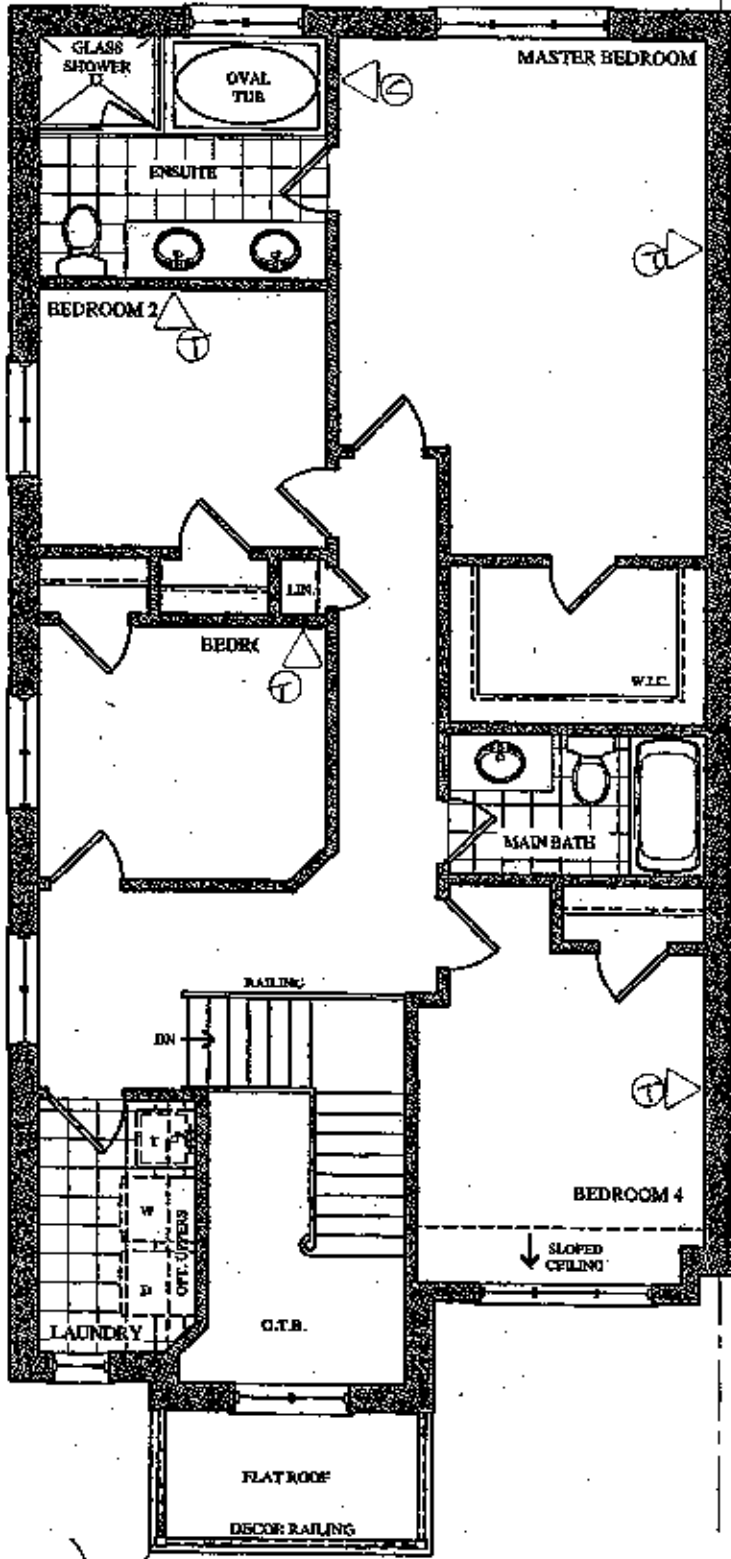


~~SECOND FLOOR PLAN
ELEV. 'A'~~

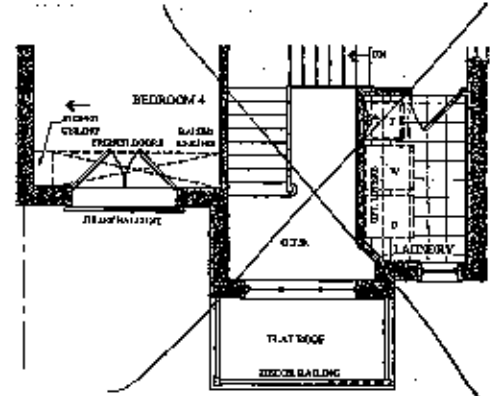

PART. SECOND FLOOR PLAN
ELEV. 'B'

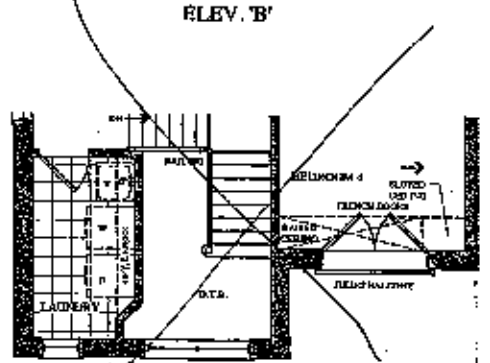

PART. SECOND FLOOR PLAN
ELEV. 'C'

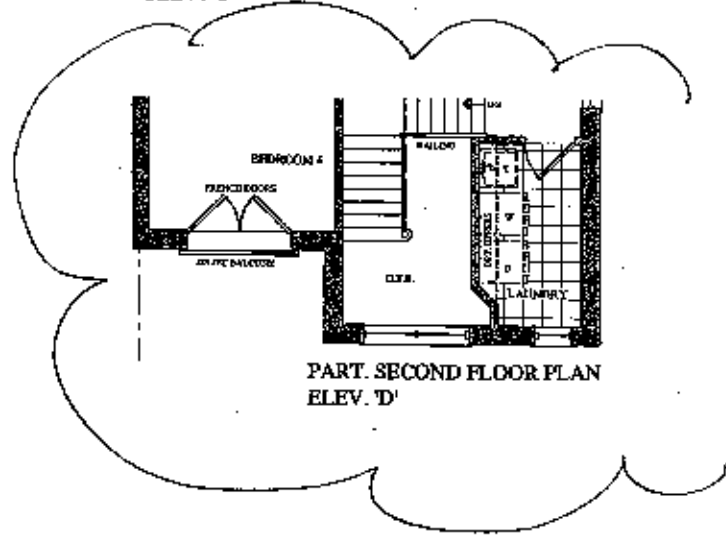


PART. SECOND FLOOR PLAN
ELEV. 'D'


BE2-50R
JUNE 1 2017

The Wagner SEMI SERIES

Elevation A • 2,127 sq.ft.
Elevation B • 2,117 sq.ft.
Elevation C • 2,127 sq.ft.
→ Elevation D • 2,127 sq.ft.

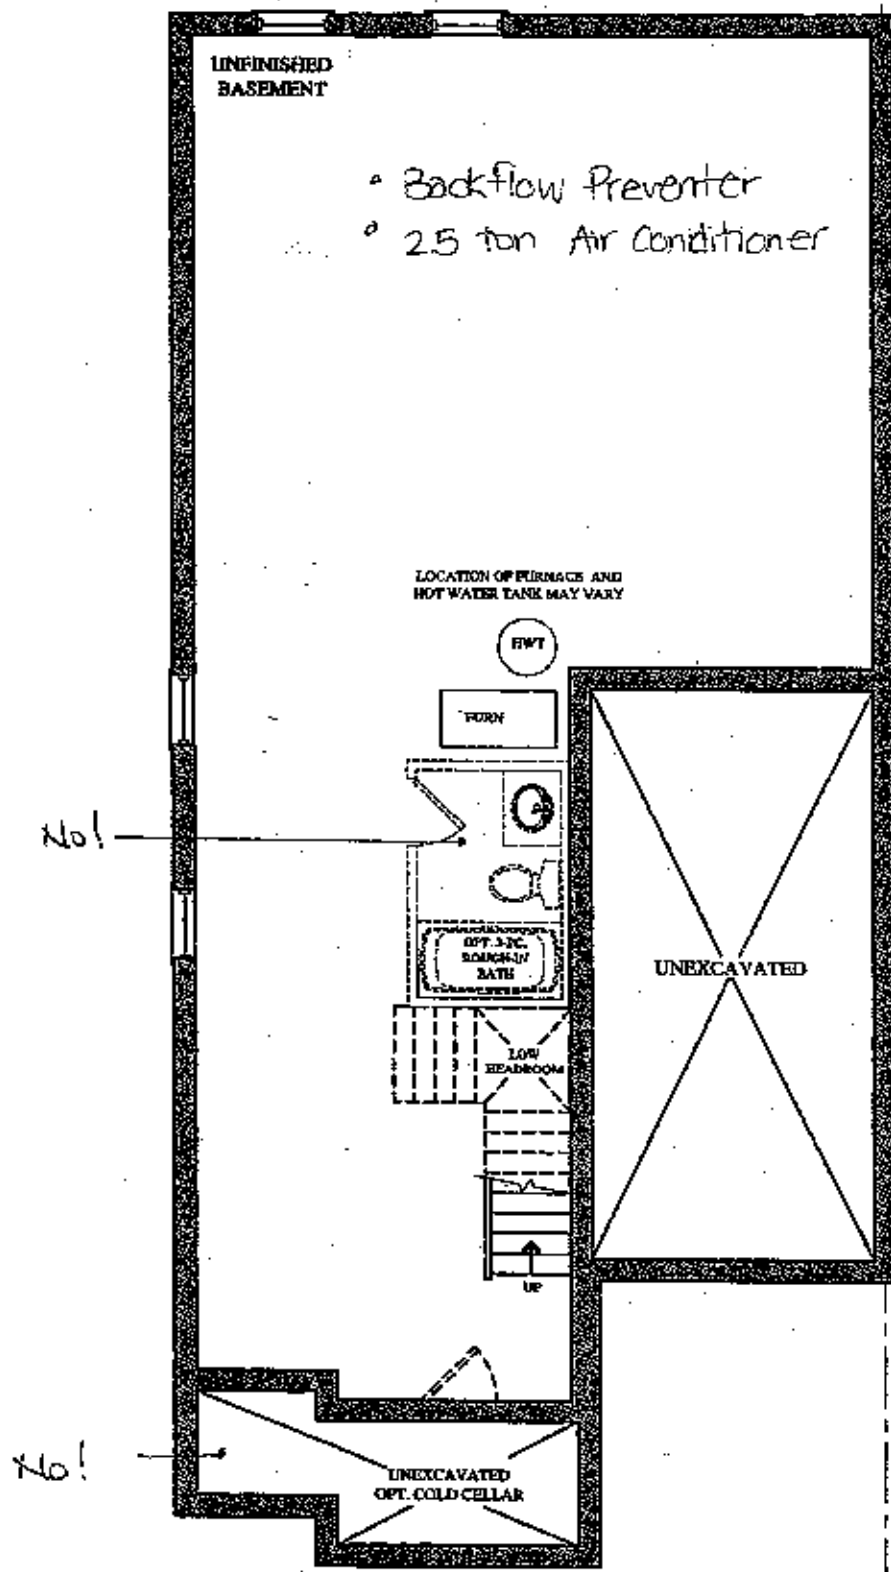

~~BASEMENT FLOOR PLAN
ELEV. 'A' & 'B'~~

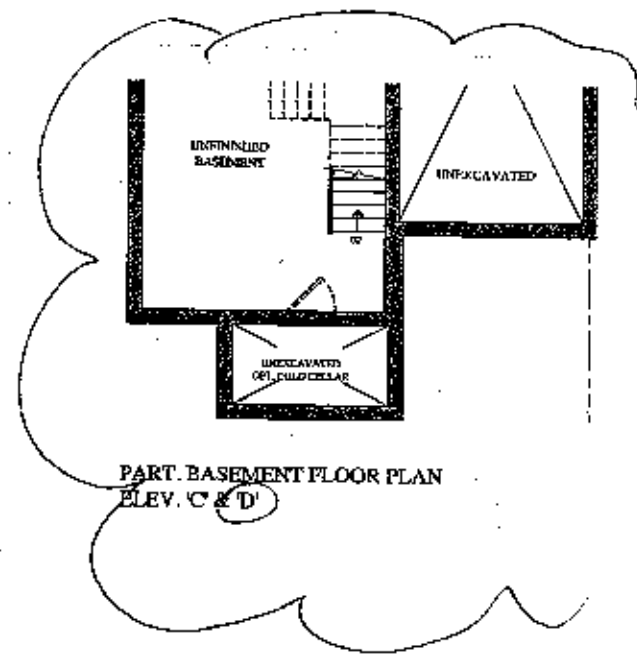

PART. BASEMENT FLOOR PLAN
ELEV. 'C' & 'D'