

Brampton Encore - 32L - 2 - 28-2 Elev.CL Siren

CONCRETE AND DRAIN

Inv.1,445	1 - ROUGH-IN - 3PC BASEMENT ROUGH-IN
Line22677	Note:
20Jun17 / 27Nov17	

ELECTRICAL

Inv.1,445	1 - FAMILY ROOM: 110V WALL RECEPTACLE ON NORMAL CIRCUIT- LOCATE ABOVE FIREPLACE, APPROX 66" A.F.F.
Line22679	Note:
20Jun17 / 27Nov17	

Inv.1,445	1 - KITCHEN: RELOCATE STANDARD CEILING LIGHT TO ABOVE ISLAND, SEE PLAN FOR LOCATION
Line22680	Note:
20Jun17 / 27Nov17	

Inv.1,445	1 - KITCHEN: ROUGH - IN CEILING OUTLET ON SAME SWITCH - DOES NOT INCLUDE FIXTURE - LOCATE ABOVE ISLAND, USE SAME SWITCH AS STANDARD LIGHT. SEE PLAN FOR LOCATION.
Line22681	Note:
20Jun17 / 27Nov17	

Exterior Colours

Inv.1,445	1 - EXTERIOR COLOUR PACKAGE # 5
Line24835	Note:
20Jun17 / 27Nov17	

FRAMING

Inv.1,445	1 - MAIN FLOOR: EXTENDED HEIGHT ARCHWAY (PRICE PER DOORWAY) - 96" ARCH
Line24834	Note:
20Jun17 / 27Nov17	

INTERIOR TRIM AND DOORS

Inv.1,445	1 - MAIN FLOOR: EXTENDED HEIGHT ARCHWAY (PRICE PER DOORWAY) - 96" ARCH
Line22683	Note:
20Jun17 / 27Nov17	

MISC.

Inv.1,445	1 - REFUND-SIDE DOOR- HOME TO EXTERIOR- GRADE DOESN'T PERMIT
Line22676	Note:
20Jun17 / 27Nov17	

Inv.1,445	1 - Purchaser has attended an appointment at the Decor Centre & has DECLINED any additional upgrades and accepts and acknowledges that there will be no further changes/additions/deletions to be made upon signing on June 20 2017.
Line22684	Note:
20Jun17 / 27Nov17	

Inv.1,445	1 - Purchasers are aware & accepts that ANY changes made to upgrades after signing this Purchasers Extra Form are subject to a minimum administration fee of \$500. PLUS a 10% holdback fee.
Line22685	Note:
20Jun17 / 27Nov17	

Brampton Encore - 32L - 2 - 28-2 Elev.CL Siren

Inv.1,445	1 - BONUS PACKAGE: \$5,000.00 (INCLUDING TAXES) WORTH OF UPGRADES FROM GOLD PARK HOMES DÉCOR CENTRE IS BEING APPLIED TOWARD THE STRUCTURAL APPOINTMENT. PURCHASER HAS A REMAINING AMOUNT OF \$00 (INCLUDING TAXES) TO BE USED TOWARD THE COLOUR APPOINTMENT.
Line22686	Note:
20Jun17 / 27Nov17	

WINDOWS - BASEMENT


Inv.1,445	2 - BASEMENT WINDOWS - UPGRADE EXISTING BASEMENT WINDOW TO 30 INCH X 24 INCH - MAY REQUIRE INSTALLATION OF WINDOW WELL.
Line22678	Note:
20Jun17 / 27Nov17	

AF #10 BE2-32L
JUNE 20 2017

The Siren

SEMI SERIES


Elevation A • 1,688 sq.ft.
Elevation B • 1,677 sq.ft.
Elevation C • 1,687 sq.ft.

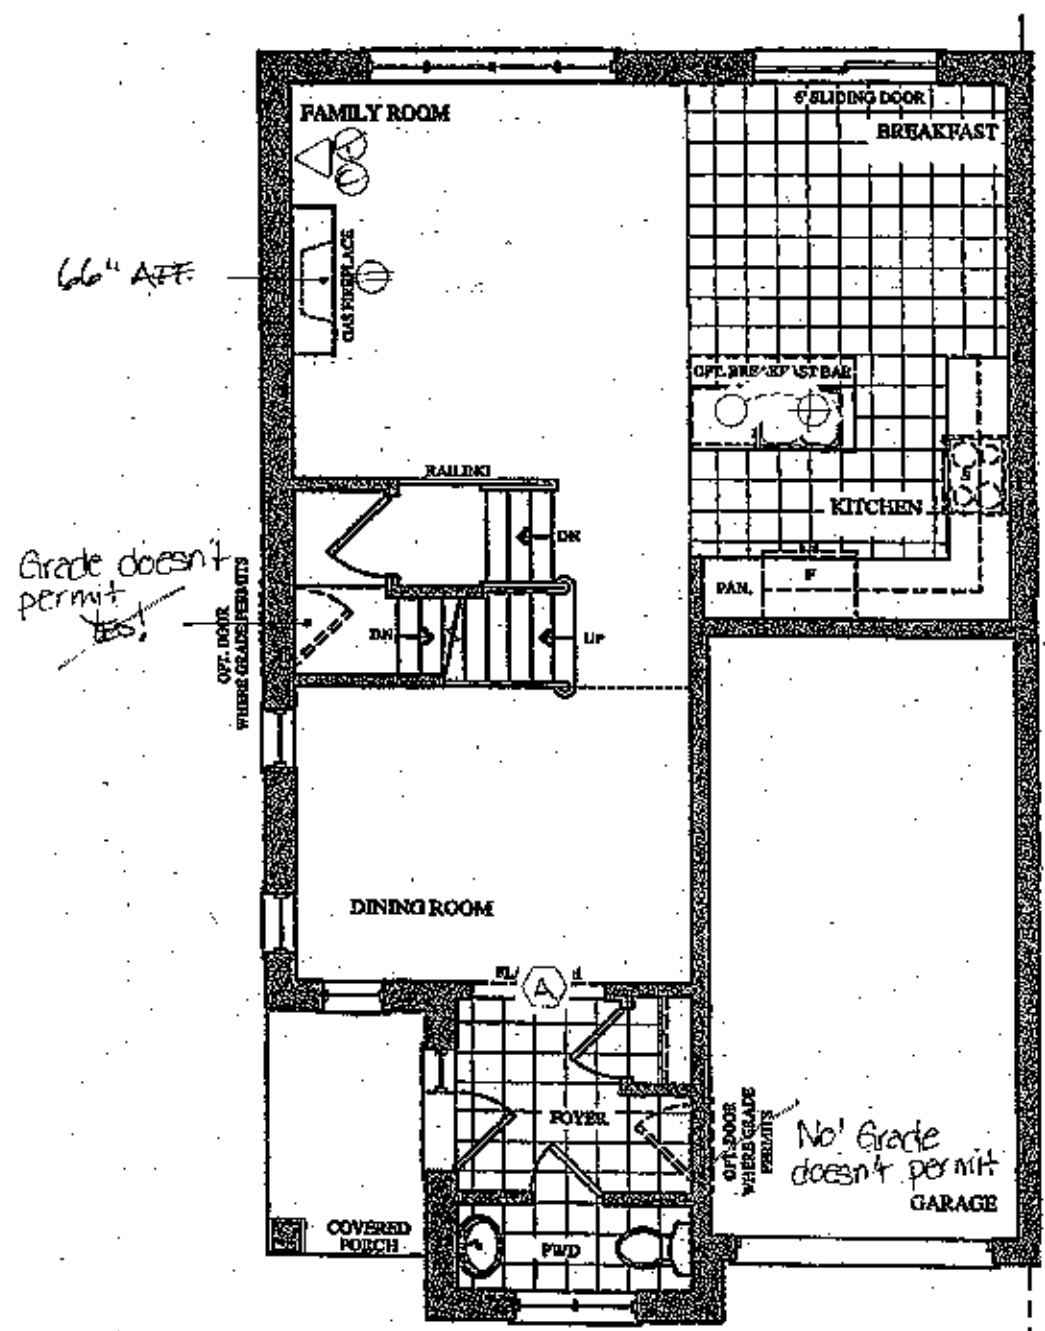

GROUND FLOOR PLAN
ELEV. 'A' & 'B'

No PHONE
in Kitchen.

- LEGEND
- ⊙ ELECTRICAL OUTLET
 - STD CEILING LIGHT
 - ⊕ CAPPED CEILING R/W
 - △ (T) PHONE
 - △ (C) CABLE
 - ⬡ (A) 96" ARCH.

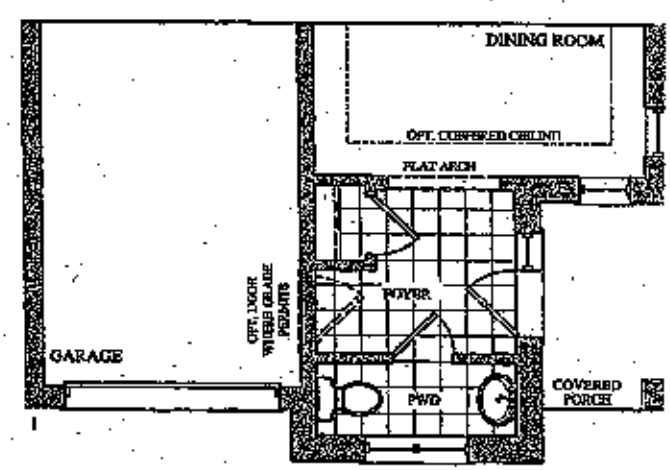


PART. GROUND FLOOR PLAN
ELEV. 'C'


AF 1.1 BE2-32L
JUNE 20 2017

The Siren SEMI SERIES


Elevation A • 1,688 sq.ft.
Elevation B • 1,677 sq.ft.
Elevation C • 1,687 sq.ft.

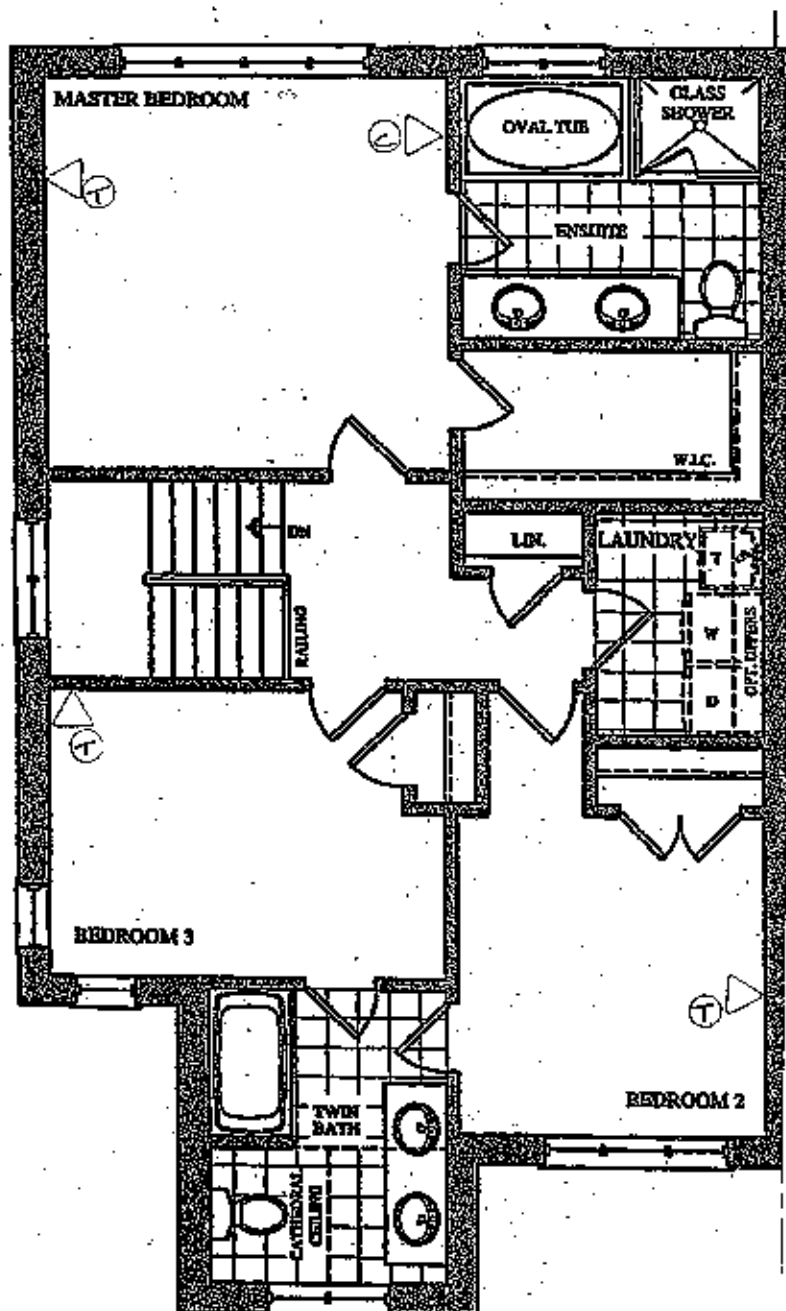

SECOND FLOOR PLAN
ELEV. 'A'

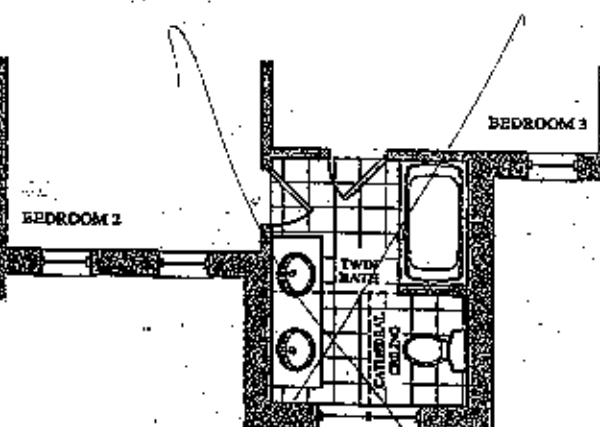

PART. SECOND FLOOR PLAN
ELEV. 'B'

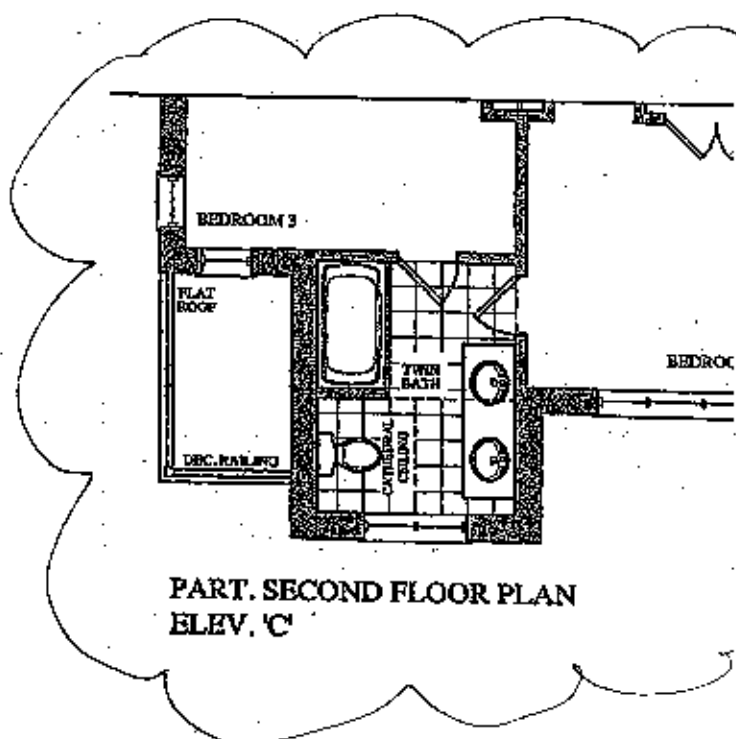

PART. SECOND FLOOR PLAN
ELEV. 'C'

Ac BE2-32L
June 20 2017

The Siren

SEMI SERIES

Elevation A • 1,688 sq.ft.

Elevation B • 1,677 sq.ft.

Elevation C • 1,687 sq.ft.

