

Brampton Encore - 58R - 2 - 28-6 Elev.B Berlio OPT4

CENTRAL VAC AND WIRING

Inv.1,514	1 - TELEPHONE AND CABLE ROUGH-IN LOCATIONS
Line23445	Note:
18Jul17 / 23Nov17	

Inv.1,514	1 - FAMILY ROOM: INSTALL CONDUIT PIPE- FOR TELEVISION- MUST SPECIFY LOCATION AND TERMINATION POINT
Line23446	Note:
18Jul17 / 23Nov17	

ELECTRICAL

Inv.1,514	1 - FAMILY ROOM: INSTALL 110V WALL RECEPTACLE ON DEDICATED CIRCUIT - ABOVE FIREPLACE FOR FUTURE TV
Line23447	Note:
18Jul17 / 23Nov17	

Inv.1,514	1 - LIVING ROOM: INSTALL ROUGH - IN CEILING OUTLET & SWITCH (WITH COVER PLATE) - DOES NOT INCLUDE FIXTURE - MUST SPECIFY LOCATION
Line23448	Note:
18Jul17 / 23Nov17	

Exterior Colours

Inv.1,514	1 - EXTERIOR COLOUR PACKAGE # 1
Line24669	Note:
18Jul17 / 23Nov17	

FORMING

Inv.1,514	1 - EXTERIOR: INSTALL SIDE DOOR- HOME TO EXTERIOR- AS PER PLAN AND GRADE PERMITTING
Line23449	Note:
18Jul17 / 23Nov17	

FRAMING

Inv.1,514	1 - GARAGE: INSTALL ROUGH-IN MANDOOR - GARAGE TO HOUSE- AS PER PLAN AND GRADE DOESN'T PERMIT DOOR
Line23450	Note:
18Jul17 / 23Nov17	

MISC.

Inv.1,514	1 - BONUS PACKAGE: \$4181.00 (INCLUDING TAXES) WORTH OF UPGRADES FROM GOLD PARK HOMES DÉCOR CENTRE IS BEING APPLIED TOWARD THE STRUCTURAL APPOINTMENT. PURCHASER HAS A REMAINING AMOUNT OF \$819.00 (INCLUDING TAXES) TO BE USED TOWARD THE COLOUR APPOINTMENT
Line23451	Note:
18Jul17 / 23Nov17	

Inv.1,514	1 - Purchaser has attended a Structural appointment at the Decor Centre & has DECLINED any additional upgrades and accepts and acknowledges that there will be no further structural changes/additions/deletions to be made upon signing on July 18, 2017.
Line23452	Note:
18Jul17 / 23Nov17	

Inv.1,514	1 - Purchasers are aware & accepts that ANY changes made to upgrades after signing this Purchasers Extra Form are subject to a minimum administration fee of \$500. PLUS a 10% holdback fee
Line23453	Note:
18Jul17 / 23Nov17	

PLUMBING

Brampton Encore - 58R - 2 - 28-6 Elev.B Berlio OPT4

Inv.1,514	1 - KITCHEN: INSTALL ROUGH-IN - WATERLINE FOR FIRDGE
Line23454	Note:
18Jul17 / 23Nov17	

WINDOWS AND DOORS

Inv.1,514	1 - EXTERIOR: INSTALL SIDE DOOR- HOME TO EXTERIOR- AS PER PLAN AND GRADE PERMITTING
Line24797	Note:
18Jul17 / 23Nov17	

encore
BRAMPTON

Telephone — (T)


Cable — (C)

Electrical — (E)


The Berlio

SEMI SERIES

Elevation A • 2,047 sq.ft.
Elevation B • 2,037 sq.ft.
Elevation C • 2,037 sq.ft.
Elevation D • 2,047 sq.ft.

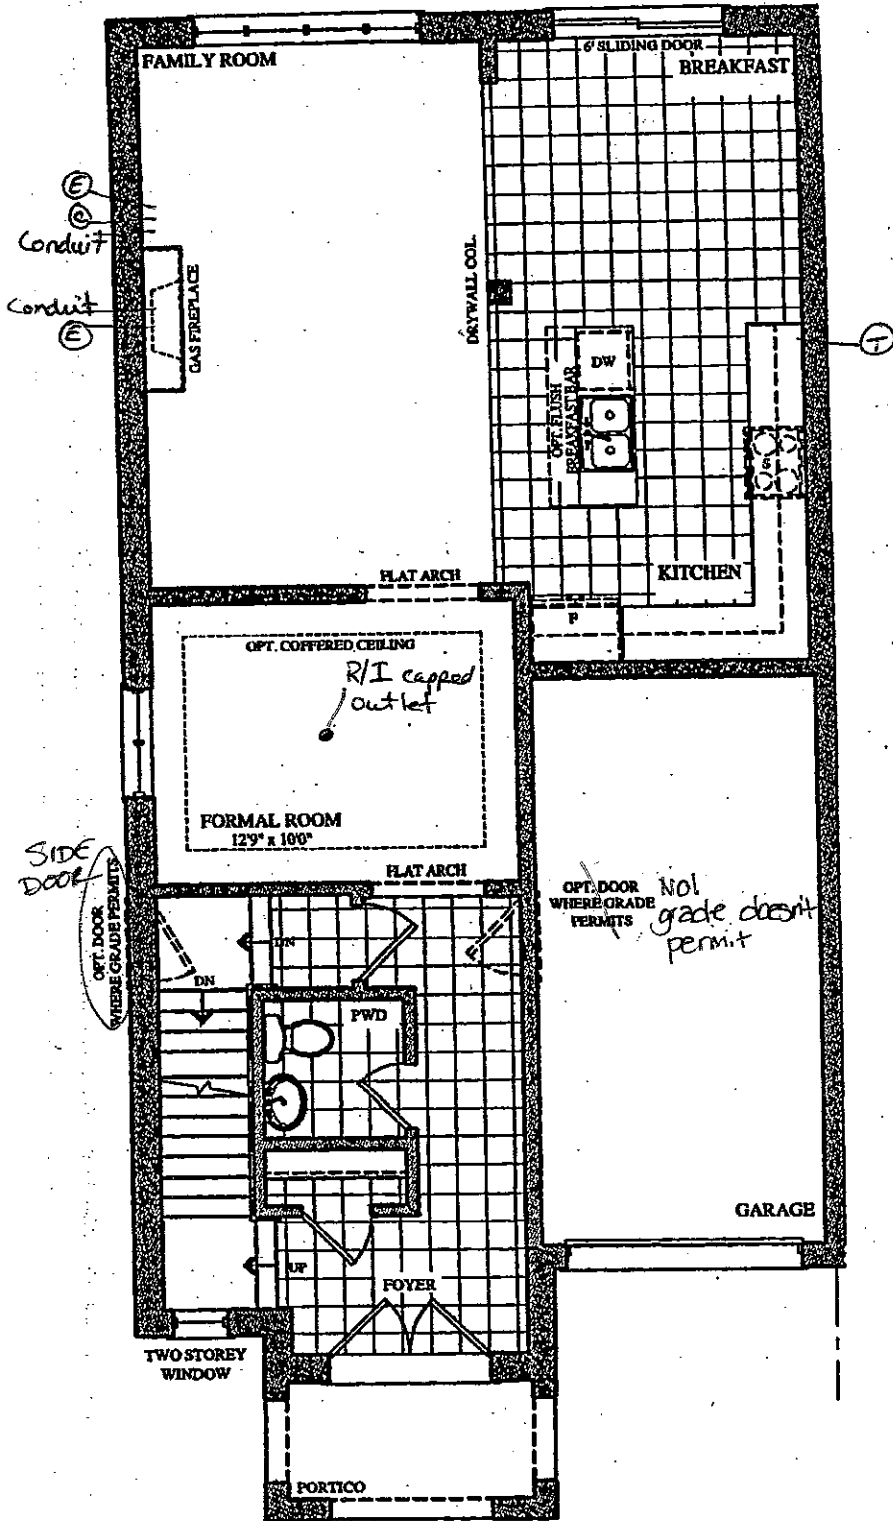

GROUND FLOOR PLAN
ELEV. 'A' & 'B'

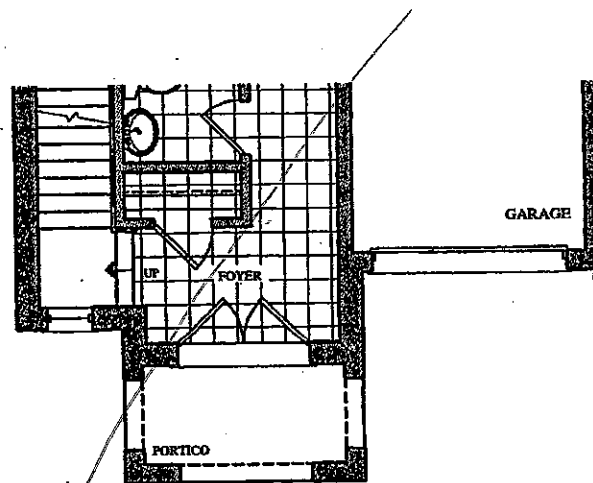

PART. GROUND FLOOR PLAN
ELEV. 'C' & 'D'


Lot 58R
July 18, 17

(RC) (RB)


The Berlio

SEMI SERIES


Elevation A • 2,047 sq.ft.
Elevation B • 2,037 sq.ft.
Elevation C • 2,037 sq.ft.
Elevation D • 2,047 sq.ft.

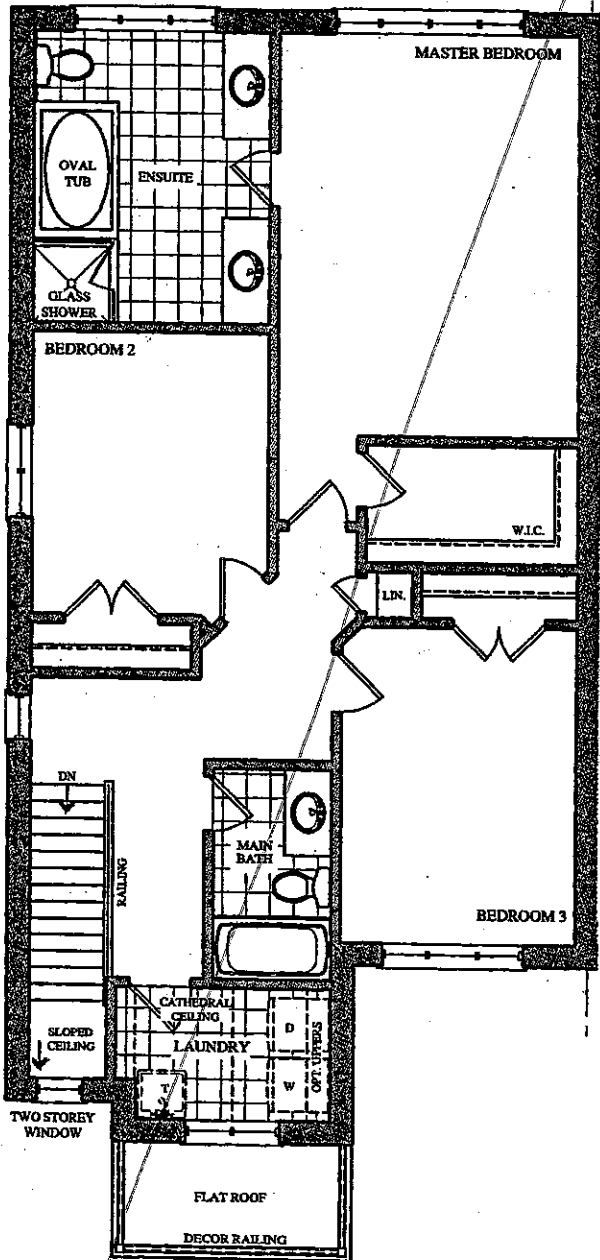


SECOND FLOOR PLAN
ELEV. 'A'

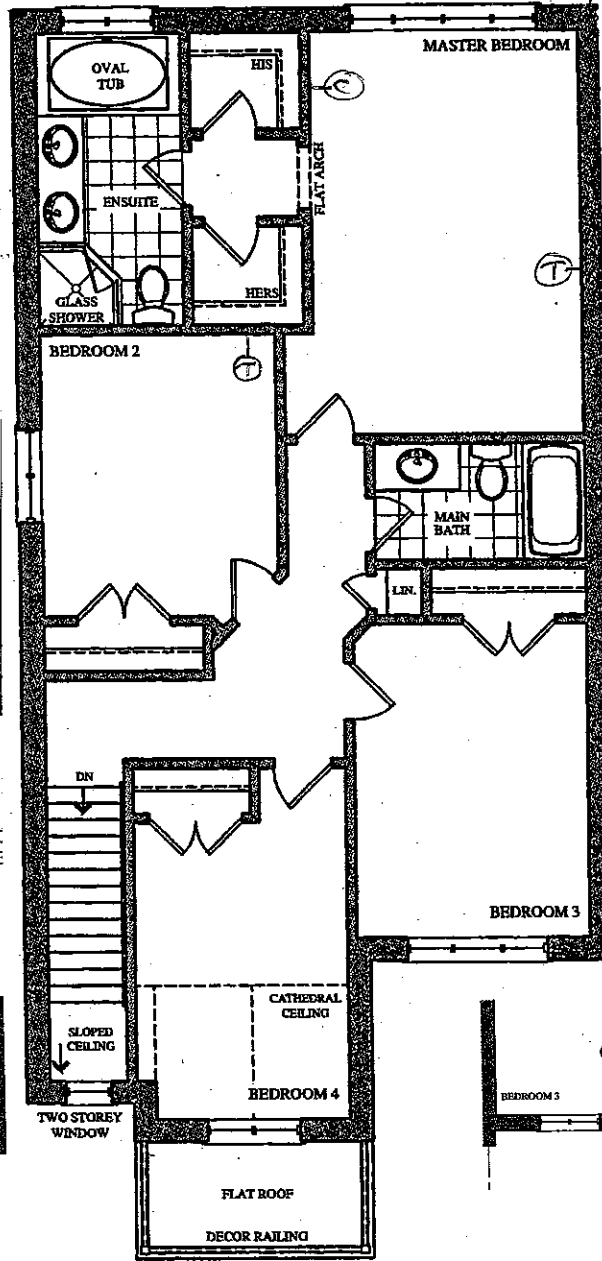


P. E
OPT. 4 BED SECOND FLOOR PLAN
ELEV. 'A'

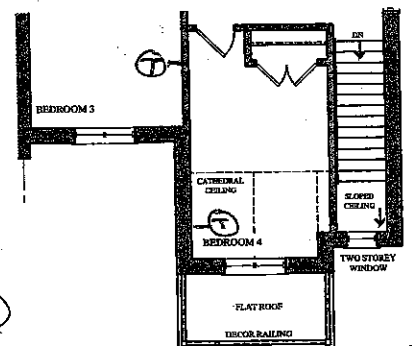


PART. OPT. 4 BED SECOND FLOOR PLAN
ELEV. 'B'

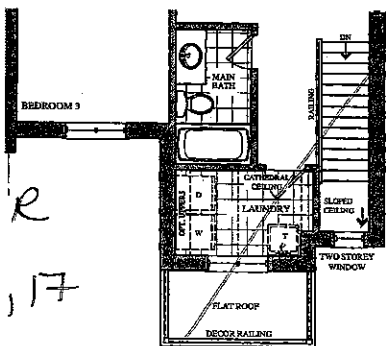


PART. SECOND FLOOR PLAN
ELEV. 'B'

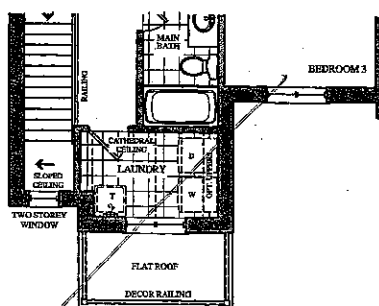


PART. SECOND FLOOR PLAN
ELEV. 'C'

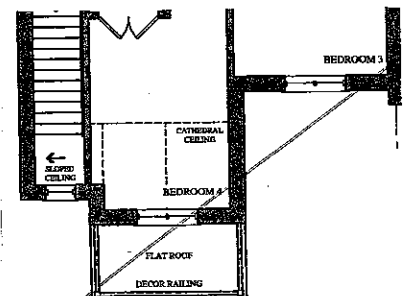

PART. OPT. 4 BED SECOND FLOOR PLAN
ELEV. 'C'

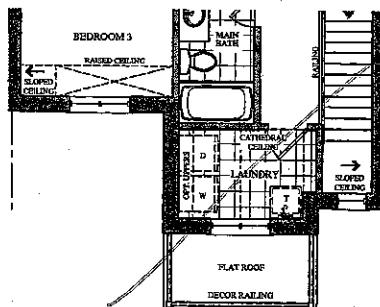

PART. SECOND FLOOR PLAN
ELEV. 'D'

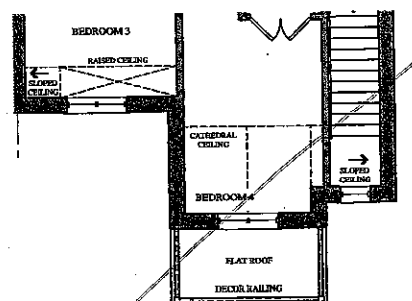


PART. OPT. 4 BED SECOND FLOOR PLAN

Lot 58 R
July 18, 17

RC RB

The
Berlio
SEMI SERIES

Elevation A • 2,047 sq.ft.
Elevation B • 2,037 sq.ft.
Elevation C • 2,037 sq.ft.
Elevation D • 2,047 sq.ft.

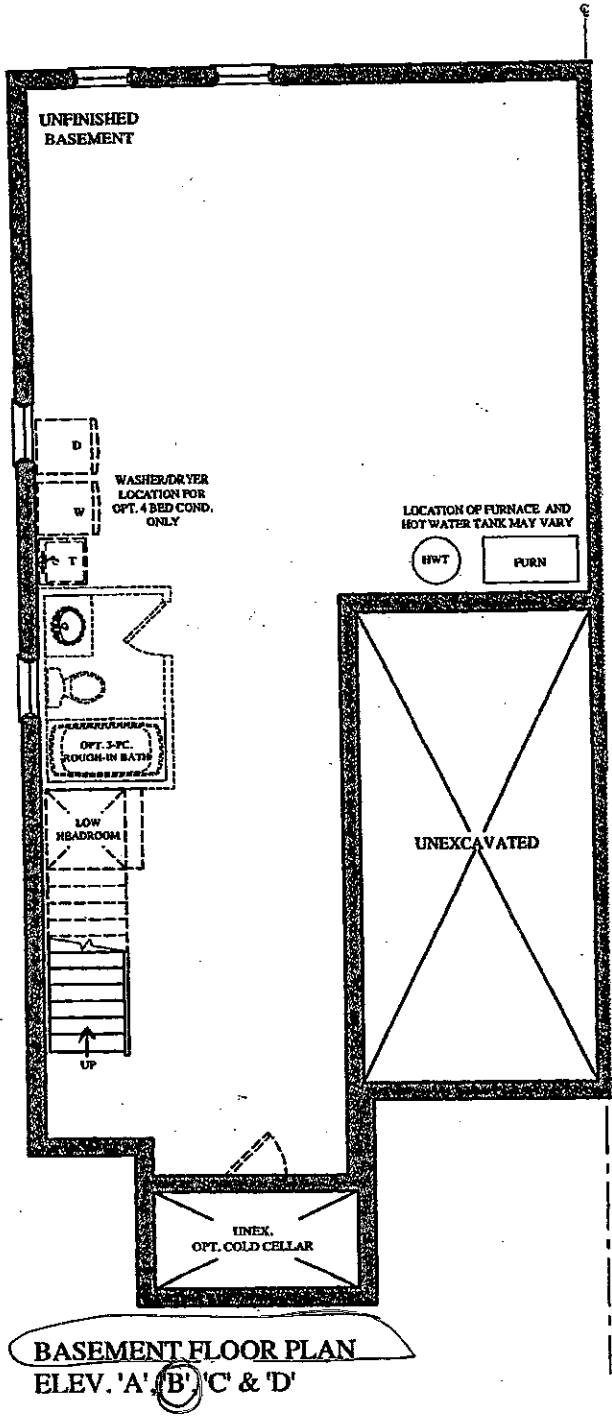

Prices, figures, illustrations, sizes, features and finishes are subject to change without notice. Areas and dimensions are approximate and actual usable floor space may vary from the stated area. Layout may be reverse of the unit purchased. E. & O.E.

GOLDPARK
WORTH MOR

Lot 58R
July 18, 17

RC
RB