

Brampton Encore - 34R - 2 - 28-6 Elev.D Berlio OPT4

CENTRAL VAC AND WIRING

Inv.1,526	1 - TELEPHONE AND CABLE ROUGH-IN LOCATION SKETCH
Line23566	Note:
26Jul17 / 27Nov17	

ELECTRICAL

Inv.1,526	1 - LIVING ROOM: INSTALL ROUGH - IN CEILING OUTLET & SWITCH (WITH COVER PLATE) - DOES NOT INCLUDE FIXTURE - MUST SPECIFY LOCATION
Line23573	Note:
26Jul17 / 27Nov17	

Inv.1,526	1 - GAS LINE ROUGH - GROUND FLOOR / BASEMENT / EXTERIOR. INCLUDES 110V PLUG
Line24837	Note:
26Jul17 / 27Nov17	

Exterior Colours

Inv.1,526	1 - EXTERIOR COLOUR PACKAGE # 9
Line24838	Note:
26Jul17 / 27Nov17	

FORMING

Inv.1,526	1 - EXTERIOR: INSTALL SIDE DOOR- HOME TO EXTERIOR- AS PER PLAN AND GRADE PERMITTING
Line23574	Note:
26Jul17 / 27Nov17	

FRAMING

Inv.1,526	1 - GARAGE: INSTALL ROUGH-IN MANDOOR - GARAGE TO HOUSE- AS PER PLAN AND GRADE PERMITTING
Line23575	Note:
26Jul17 / 27Nov17	

HVAC

Inv.1,526	1 - GAS LINE ROUGH - GROUND FLOOR / BASEMENT / EXTERIOR. INCLUDES 110V PLUG
Line23572	Note:
26Jul17 / 27Nov17	

MISC.

Inv.1,526	1 - BONUS PACKAGE: \$5,000.00 (INCLUDING TAXES) WORTH OF UPGRADES FROM GOLD PARK HOMES DÉCOR CENTRE IS BEING APPLIED TOWARD THE STRUCTURAL APPOINTMENT. PURCHASER HAS A REMAINING AMOUNT OF \$00 (INCLUDING TAXES) TO BE USED TOWARD THE COLOUR APPOINTMENT
Line23577	Note:
26Jul17 / 27Nov17	

Inv.1,526	1 - Purchaser has attended a Structural appointment at the Decor Centre & has DECLINED any additional upgrades and accepts and acknowledges that there will be no further structural changes/additions/deletions to be made upon signing on July 26, 2017
Line23578	Note:
26Jul17 / 27Nov17	

Inv.1,526	1 - Purchasers are aware & accepts that ANY changes made to upgrades after signing this Purchasers Extra Form are subject to a minimum administration fee of \$500. PLUS a 10% holdback fee
Line23579	Note:
26Jul17 / 27Nov17	

Brampton Encore - 34R - 2 - 28-6 Elev.D Berlio OPT4

WINDOWS - BASEMENT

Inv.1,526	4 - BASEMENT: INSTALL FOUR (X4) BASEMENT WINDOWS - UPGRADE EXISTING BASEMENT WINDOW TO 30 INCH X 24 INCH - MAY REQUIRE INSTALLATION OF WINDOW WELL.
Line23576	Note: PURCHASER IS AWARE THAT THE SIDE WINDOWS WILL HAVE A WINDOW WELL.
26Jul17 / 27Nov17	

WINDOWS AND DOORS

Inv.1,526	1 - EXTERIOR: INSTALL SIDE DOOR- HOME TO EXTERIOR- AS PER PLAN AND GRADE PERMITTING
Line24836	Note:
26Jul17 / 27Nov17	


encore
BRAMPTON

Telephone — (T)
Cable — (C)


The Berlio

SEMI SERIES

Elevation A • 2,047 sq.ft.
Elevation B • 2,037 sq.ft.
Elevation C • 2,037 sq.ft.
Elevation D • 2,047 sq.ft.

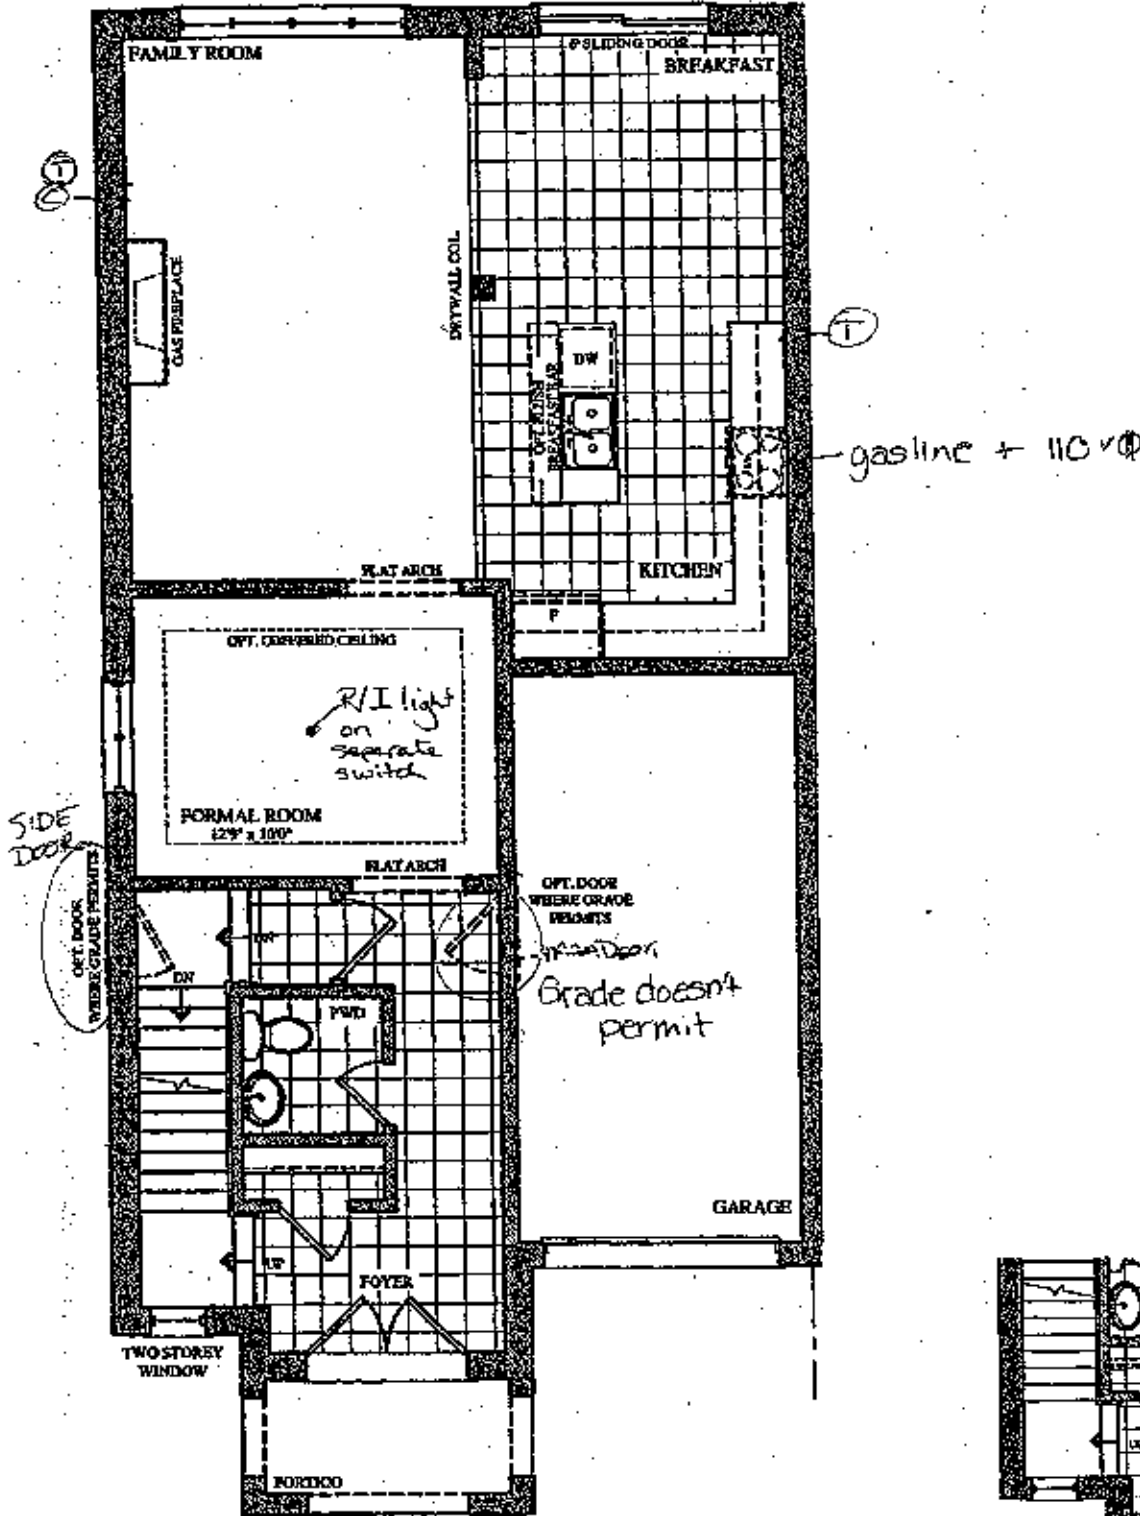

GROUND FLOOR PLAN
ELEV. 'A' & 'B'

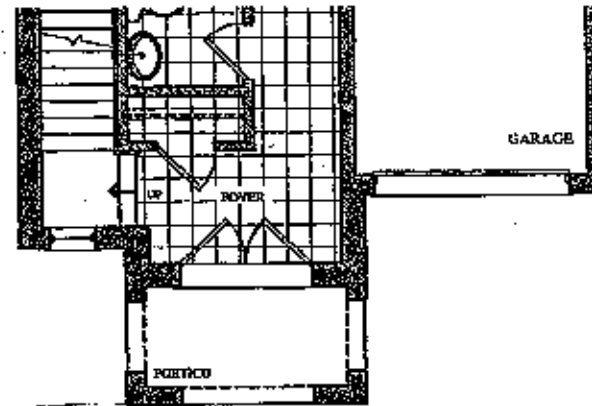

PART. GROUND FLOOR PLAN
ELEV. 'C' & 'D'

Lot 34R

July 26, 17




encore
BRAMPTON.

Telephone — (T)
Cable — (C)


The Berlio

SEMI SERIES


Elevation A • 2,047 sq.ft.
Elevation B • 2,037 sq.ft.
Elevation C • 2,037 sq.ft.
Elevation D • 2,047 sq.ft.

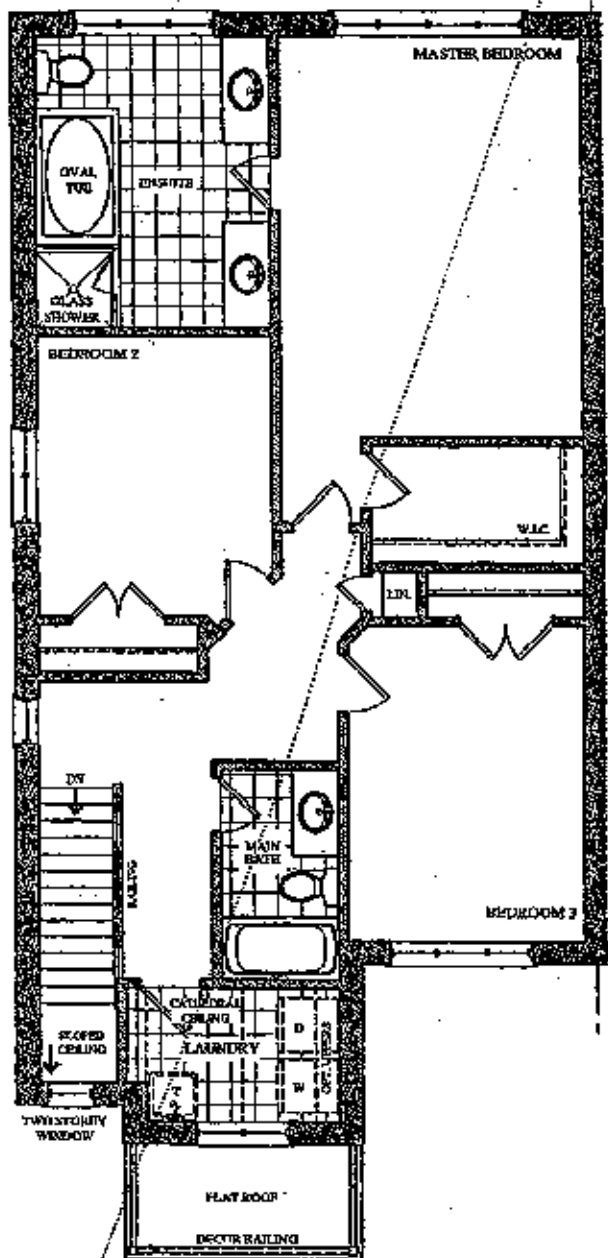


SECOND FLOOR PLAN
ELEV. 'A'

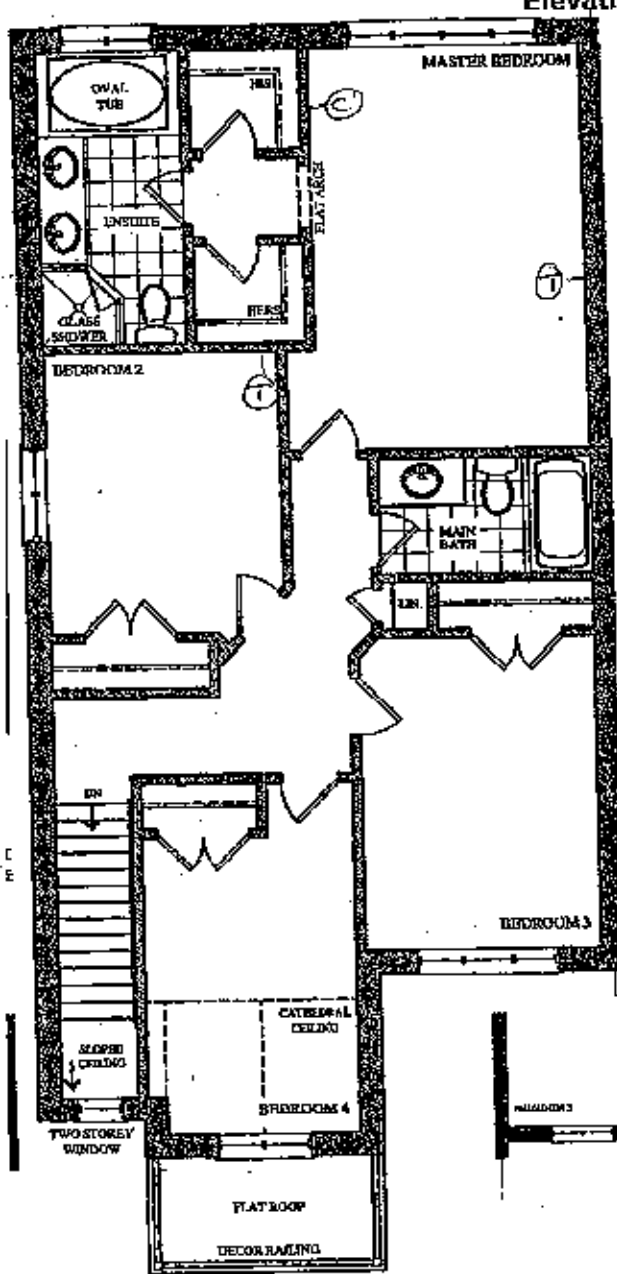


OPT. 4 BED SECOND FLOOR PLAN
ELEV. 'A'

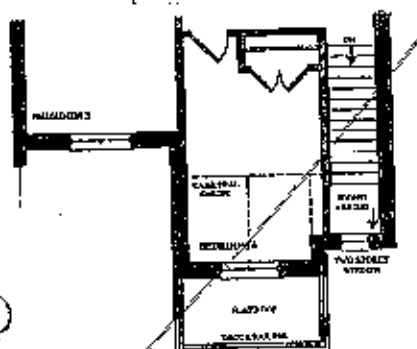


PART. OPT. 4 BED SECOND FLOOR PLAN
ELEV. 'B'

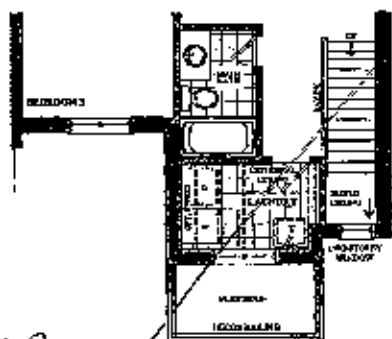


PART. SECOND FLOOR PLAN
ELEV. 'B'

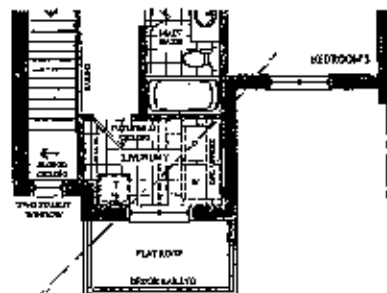


PART. SECOND FLOOR PLAN
ELEV. 'C'

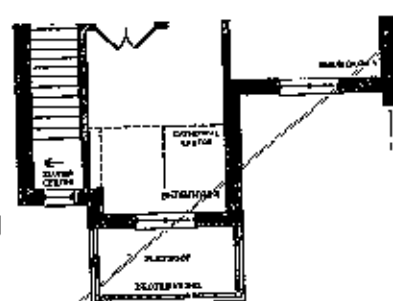

PART. OPT. 4 BED SECOND FLOOR PLAN
ELEV. 'C'

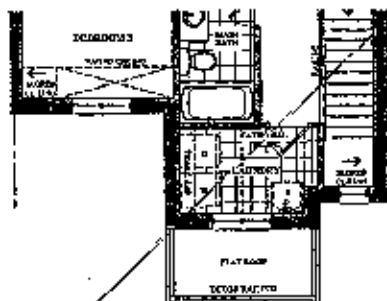

PART. SECOND FLOOR PLAN
ELEV. 'D'

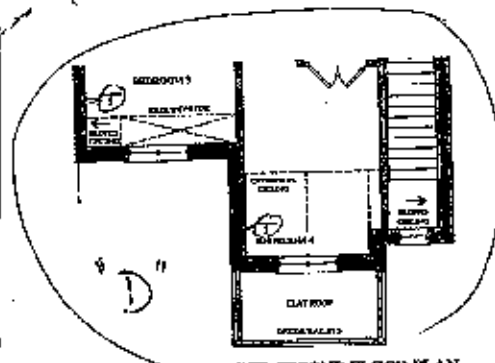

Lot 34R

July 26, 17




BSMUT WINDOWS
4x 30"x24"

The Berlio

SEMI SERIES

Elevation A • 2,047 sq.ft.
Elevation B • 2,037 sq.ft.
Elevation C • 2,037 sq.ft.
Elevation D • 2,047 sq.ft.

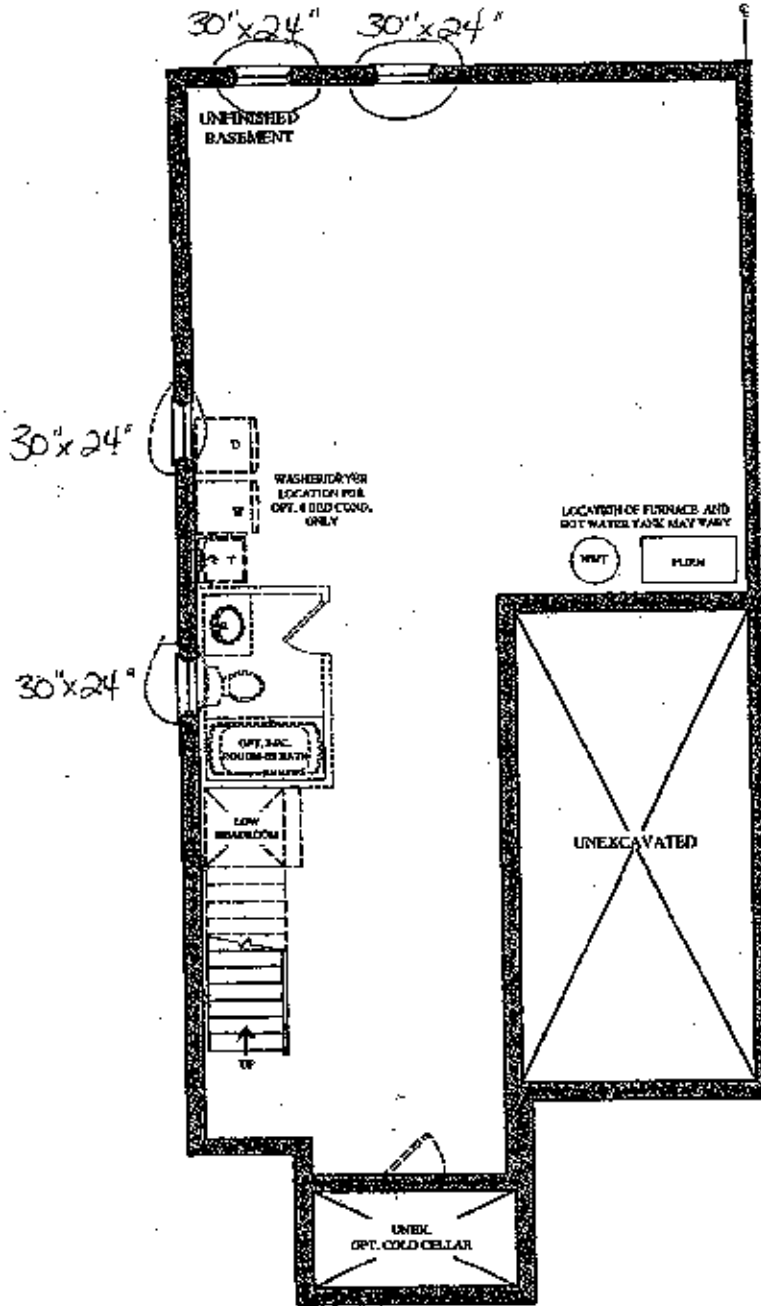

BASEMENT FLOOR PLAN
ELEV. 'A', 'B', 'C' & 'D'

Prices, figures, illustrations, sizes, features and finishes are subject to change without notice. Areas and dimensions are approximate and actual usable floor space may vary from the stated size. Layout may be reverse of the unit purchased. E. & O.E.

GOLDPARK
WORTH MORI

Lot 34R
July 26, 17

NP