

Brampton Encore - 37R - 2 - 28-4 Elev.B ROSSINI OPT4

CENTRAL VAC AND WIRING

Inv.1,470	1 - FAMILY ROOM: CONDUIT PIPE- FOR TELEVISION- LOCATE APPROX. 66" ABOVE FIREPLACE, TERMINATING BY CABLE OUTLET
Line22926	Note:
4Jul17 / 29Nov17	

CONCRETE AND DRAIN

Inv.1,470	1 - ROUGH-IN - 3PC BASEMENT ROUGH-IN
Line22930	Note:
4Jul17 / 29Nov17	

ELECTRICAL

Inv.1,470	1 - FAMILY ROOM: 110V WALL RECEPTACLE ON NORMAL CIRCUIT- LOCATE ABOVE FIREPLACE, APPROX. 66" A.F.F.
Line22925	Note:
4Jul17 / 29Nov17	
Inv.1,470	1 - KITCHEN: RELOCATE STANDARD CEILING LIGHT TO APPROX. CENTER ABOVE ISLAND
Line22927	Note:
4Jul17 / 29Nov17	
Inv.1,470	1 - HUMIDIFIER: WB3 - 17 (UP TO 3,000 SQ.FT.)
Line24890	Note:
4Jul17 / 29Nov17	

Exterior Colours

Inv.1,470	1 - EXTERIOR COLOUR PACKAGE # 8
Line24894	Note:
4Jul17 / 29Nov17	

FRAMING

Inv.1,470	1 - MAIN FLOOR: EXTENDED HEIGHT ARCHWAY (PRICE PER DOORWAY) -96"
Line24892	Note:
4Jul17 / 29Nov17	
Inv.1,470	1 - MAIN FLOOR: STANDARD DOOR EXTENDED HEIGHT 96" (PRICE PER DOOR)- GROUND FLOOR 2 STOREY MODELS
Line24893	Note:
4Jul17 / 29Nov17	

GARAGE DOORS

Inv.1,470	1 - GARAGE DOOR OPENER *BELT-DRIVE* - WITH 1 REMOTE- PRICE IS PER DOOR
Line22942	Note:
4Jul17 / 29Nov17	

HVAC

Inv.1,470	1 - HUMIDIFIER: WB3 - 17 (UP TO 3,000 SQ.FT.)
Line22934	Note:
4Jul17 / 29Nov17	
Inv.1,470	1 - 2 TON A/C
Line22935	Note:
4Jul17 / 29Nov17	

Brampton Encore - 37R - 2 - 28-4 Elev.B ROSSINI OPT4
INTERIOR TRIM AND DOORS

Inv.1,470	2 - MAIN FLOOR: EXTENDED HEIGHT ARCHWAY (PRICE PER DOORWAY) -96"
Line22936	Note:
4Jul17 / 29Nov17	
Inv.1,470	5 - MAIN FLOOR: STANDARD DOOR EXTENDED HEIGHT 96" (PRICE PER DOOR)- GROUND FLOOR 2 STOREY MODELS
Line22937	Note:
4Jul17 / 29Nov17	

MISC.

Inv.1,470	1 - SIDE DOOR- HOME TO EXTERIOR- AS PER PLAN AND GRADE PERMITTING
Line22931	Note:
4Jul17 / 29Nov17	
Inv.1,470	1 - Purchaser has attended an appointment at the Decor Centre & has DECLINED any additional upgrades and accepts and acknowledges that there will be no further changes/additions/deletions to be made upon signing on July 4 2017.
Line22939	Note:
4Jul17 / 29Nov17	
Inv.1,470	1 - Purchasers are aware & accepts that ANY changes made to upgrades after signing this Purchasers Extra Form are subject to a minimum administration fee of \$500. PLUS a 10% holdback fee.
Line22940	Note:
4Jul17 / 29Nov17	
Inv.1,470	1 - BONUS PACKAGE: \$5,000.00 (INCLUDING TAXES) WORTH OF UPGRADES FROM GOLD PARK HOMES DÉCOR CENTRE IS BEING *deferred* TO THE STRUCTURAL APPOINTMENT. PURCHASER HAS A REMAINING AMOUNT OF \$5,000 (INCLUDING TAXES) TO BE USED TOWARD THE COLOUR APPOINTMENT.
Line22941	Note:
4Jul17 / 29Nov17	

PLUMBING

Inv.1,470	1 - KITCHEN: ROUGH-IN - WATERLINE FOR FRIDGE
Line22938	Note:
4Jul17 / 29Nov17	
Inv.1,470	1 - HUMIDIFIER: WB3 - 17 (UP TO 3,000 SQ.FT.)
Line24891	Note:
4Jul17 / 29Nov17	

WINDOWS - BASEMENT


Inv.1,470	2 - BASEMENT WINDOWS - UPGRADE EXISTING BASEMENT WINDOW TO 30 INCH X 24 INCH - MAY REQUIRE INSTALLATION OF WINDOW WELL
Line22933	Note:
4Jul17 / 29Nov17	

BE2-37R
July 4 2017


SPM BSB R.S.

The Rossini SEMI SERIES


Elevation A • 1,911 sq.ft.
Elevation B • 1,902 sq.ft.
Elevation C • 1,966 sq.ft.
Elevation D • 1,971 sq.ft.

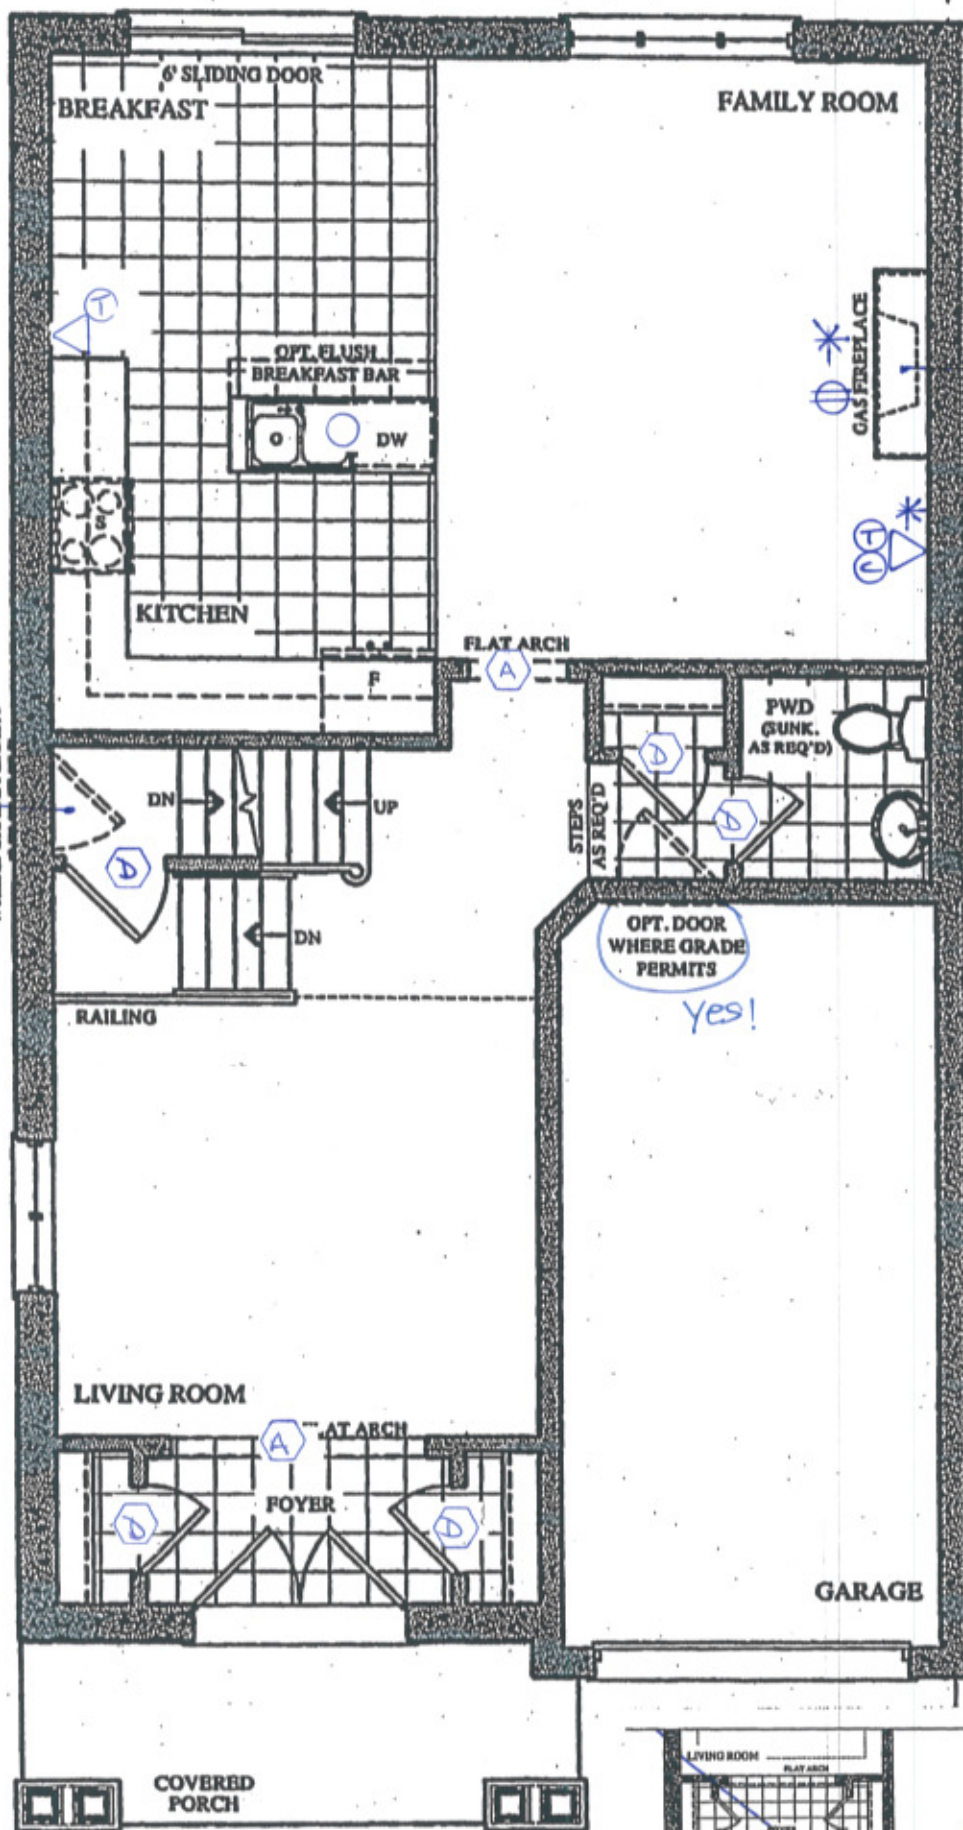

GROUND FLOOR PLAN
ELEV. 'A' & 'B'

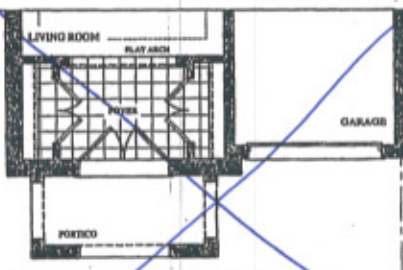

PART. GROUND FLOOR PLAN
ELEV. 'C' & 'D'

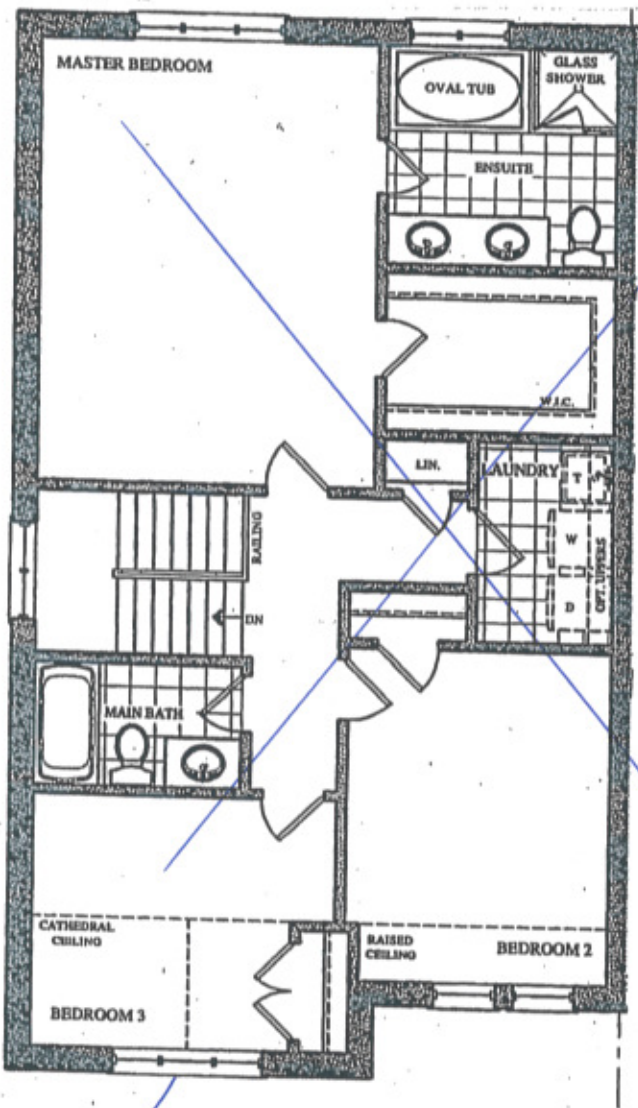


SECOND FLOOR PLAN
ELEV. 'A'

BE2-37R
July 4 2017


S.M. B.S.B. P.S.

The Rossini SEMI SERIES


Elevation A • 1,911 sq.ft.
Elevation B • 1,902 sq.ft.
Elevation C • 1,966 sq.ft.
Elevation D • 1,971 sq.ft.

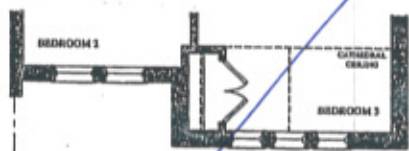


PART. SECOND FLOOR PLAN
ELEV. 'B'

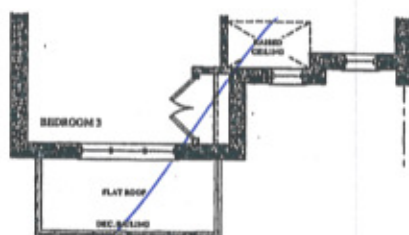


PART. SECOND FLOOR PLAN
ELEV. 'C'

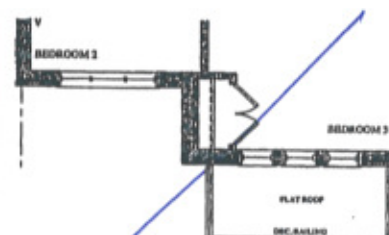


PART. SECOND FLOOR PLAN
ELEV. 'D'

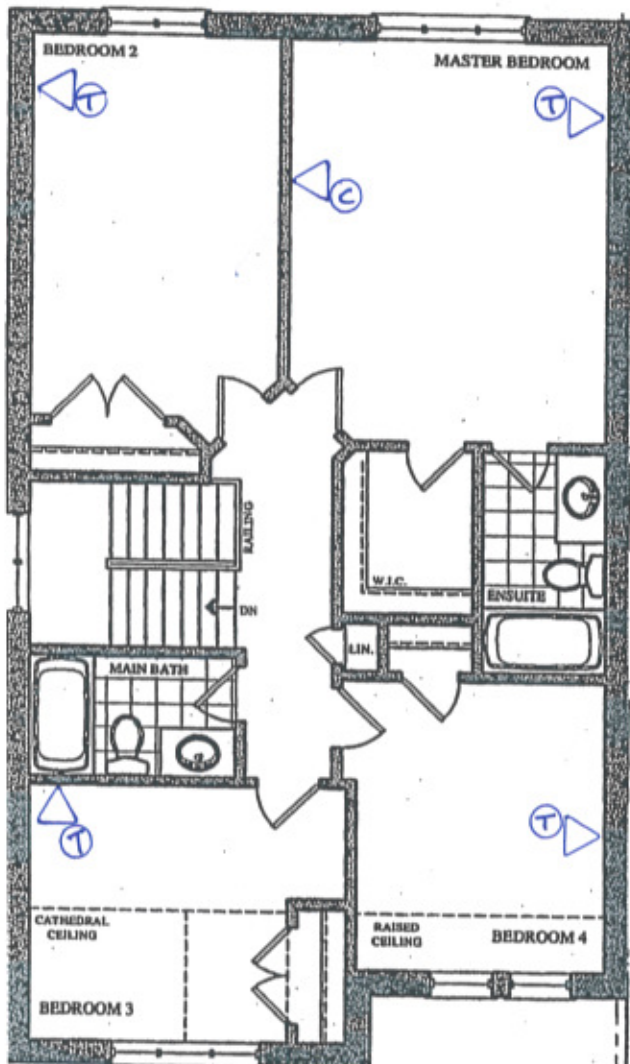


OPT. SECOND FLOOR PLAN
ELEV. 'A'

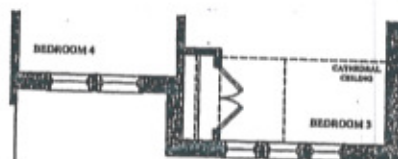

PART. OPT. SECOND FLOOR PLAN
ELEV. 'B'

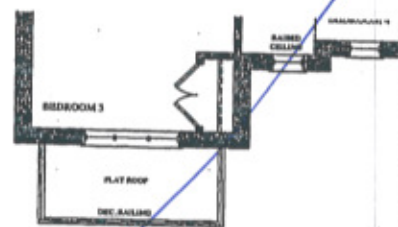

PART. OPT. SECOND FLOOR PLAN
ELEV. 'C'

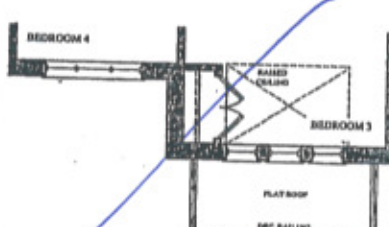

PART. OPT. SECOND FLOOR PLAN
ELEV. 'D'


BE2-37R
July 4 2017

S.M. B.S.B. R.S.


Rossini

SEMI SERIES

Elevation A • 1,911 sq.ft.
→ Elevation B • 1,902 sq.ft.
Elevation C • 1,966 sq.ft.
Elevation D • 1,971 sq.ft.

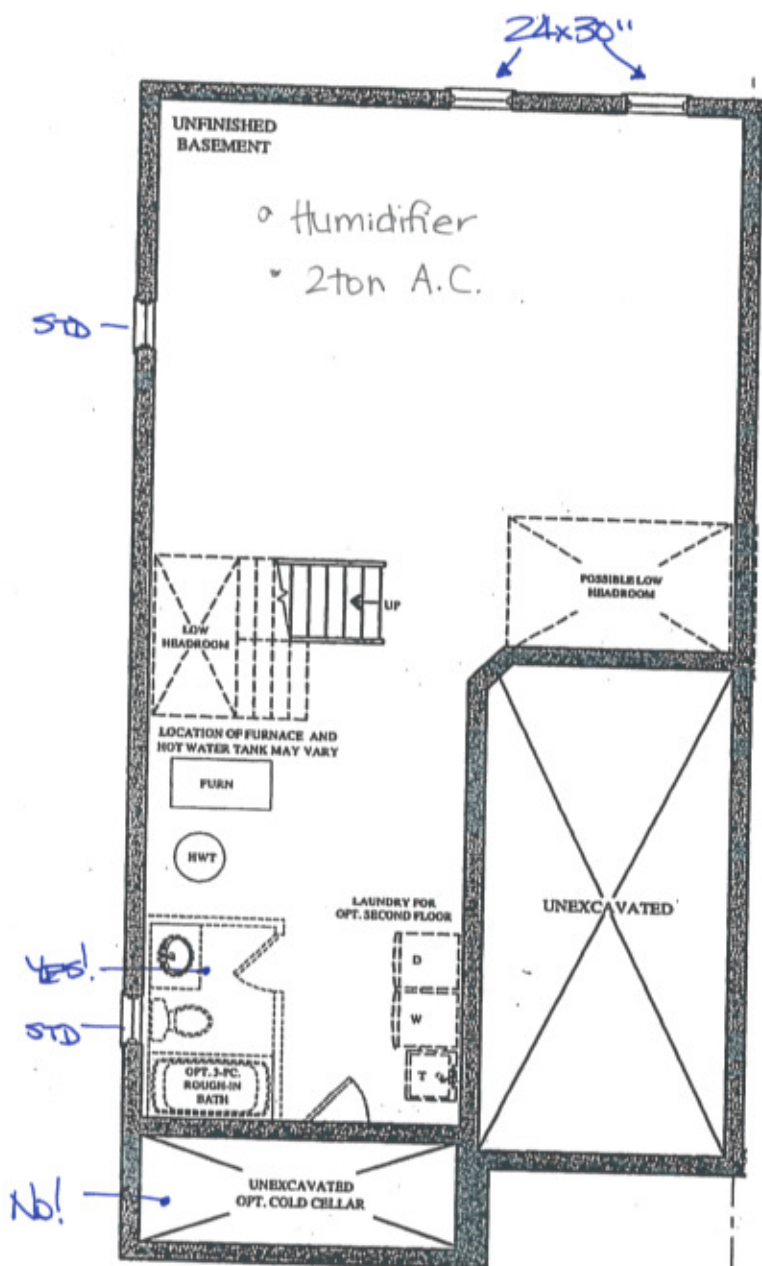

BASEMENT FLOOR PLAN
ELEV. 'A' & 'B'

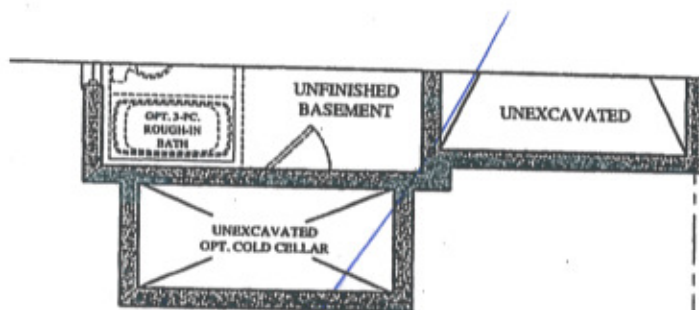

PART. BASEMENT FLOOR PLAN
ELEV. 'C' & 'D'