

Brampton Encore - 43L - 2 - 28-5 Elev.A DEBUSSY
CENTRAL VAC AND WIRING

Inv.1,531	1 - TELEPHONE AND CABLE ROUGH-IN LOCATIONS
Line23615	Note:
28Jul17 / 1Dec17	

Inv.1,531	1 - FAMILY ROOM: INSTALL CONDUIT PIPE- FOR TELEVISION- MUST SPECIFY LOCATION AND TERMINATION POINT
Line23619	Note:
28Jul17 / 1Dec17	

CONCRETE AND DRAIN

Inv.1,531	1 - BASEMENT: INSTALL ROUGH-IN - 3PC BASEMENT ROUGH-IN
Line23617	Note:
28Jul17 / 1Dec17	

ELECTRICAL

Inv.1,531	1 - LIVING ROOM: INSTALL ROUGH - IN CEILING OUTLET & SWITCH (WITH COVER PLATE) - DOES NOT INCLUDE FIXTURE - MUST SPECIFY LOCATION
Line23616	Note:
28Jul17 / 1Dec17	

Inv.1,531	1 - FAMILY ROOM: INSTALL 110V WALL RECEPTACLE ON DEDICATED CIRCUIT -ABOVE FIREPLACE FOR FUTURE TV
Line23620	Note:
28Jul17 / 1Dec17	

Exterior Colours

Inv.1,531	1 - EXTERIOR COLOUR PACKAGE #2
Line24945	Note:
28Jul17 / 1Dec17	

FRAMING

Inv.1,531	1 - MANDOOR-GARAGE TO HOUSE
Line24946	Note:
28Jul17 / 1Dec17	

MISC.

Inv.1,531	1 - BONUS PACKAGE: \$3480.40(INCLUDING TAXES) WORTH OF UPGRADES FROM GOLD PARK HOMES DÉCOR CENTRE IS BEING APPLIED TOWARD THE STRUCTURAL APPOINTMENT. PURCHASER HAS A REMAINING AMOUNT OF \$1590.60 (INCLUDING TAXES) TO BE USED TOWARD THE COLOUR APPOINTMENT
Line23621	Note:
28Jul17 / 1Dec17	

Inv.1,531	1 - Purchaser has attended a Structural appointment at the Decor Centre & has DECLINED any additional upgrades and accepts and acknowledges that there will be no further structural changes/additions/deletions to be made upon signing on July 28, 2017
Line23622	Note:
28Jul17 / 1Dec17	

Inv.1,531	1 - Purchasers are aware & accepts that ANY changes made to upgrades after signing this Purchasers Extra Form are subject to a minimum administration fee of \$500. PLUS a 10% holdback fee
Line23623	Note:
28Jul17 / 1Dec17	

WINDOWS - BASEMENT

Brampton Encore - 43L - 2 - 28-5 Elev.A DEBUSSY

Inv.1,531	2 - BASEMENT: INSTALL TWO (X2) BASEMENT WINDOWS - UPGRADE EXISTING BASEMENT WINDOW TO 30 INCH X 24 INCH - MAY REQUIRE INSTALLATION OF WINDOW WELL
Line23618	Note: PURCHASER IS AWARE THAT THE SIDE WINDOWS WILL GET WINDOW WELLS
28Jul17 / 1Dec17	


WINDOWS AND DOORS

Inv.1,531	1 - MANDOOR-GARAGE TO HOUSE
Line24947	Note:
28Jul17 / 1Dec17	

Telephone — (T)
 Cable — (C)
 Electrical — (E)

The Debussy SEMI SERIES

Elevation A • 2,283 sq.ft.
 Elevation B • 2,283 sq.ft.
 Elevation C • 2,283 sq.ft.
 Elevation D • 2,283 sq.ft.

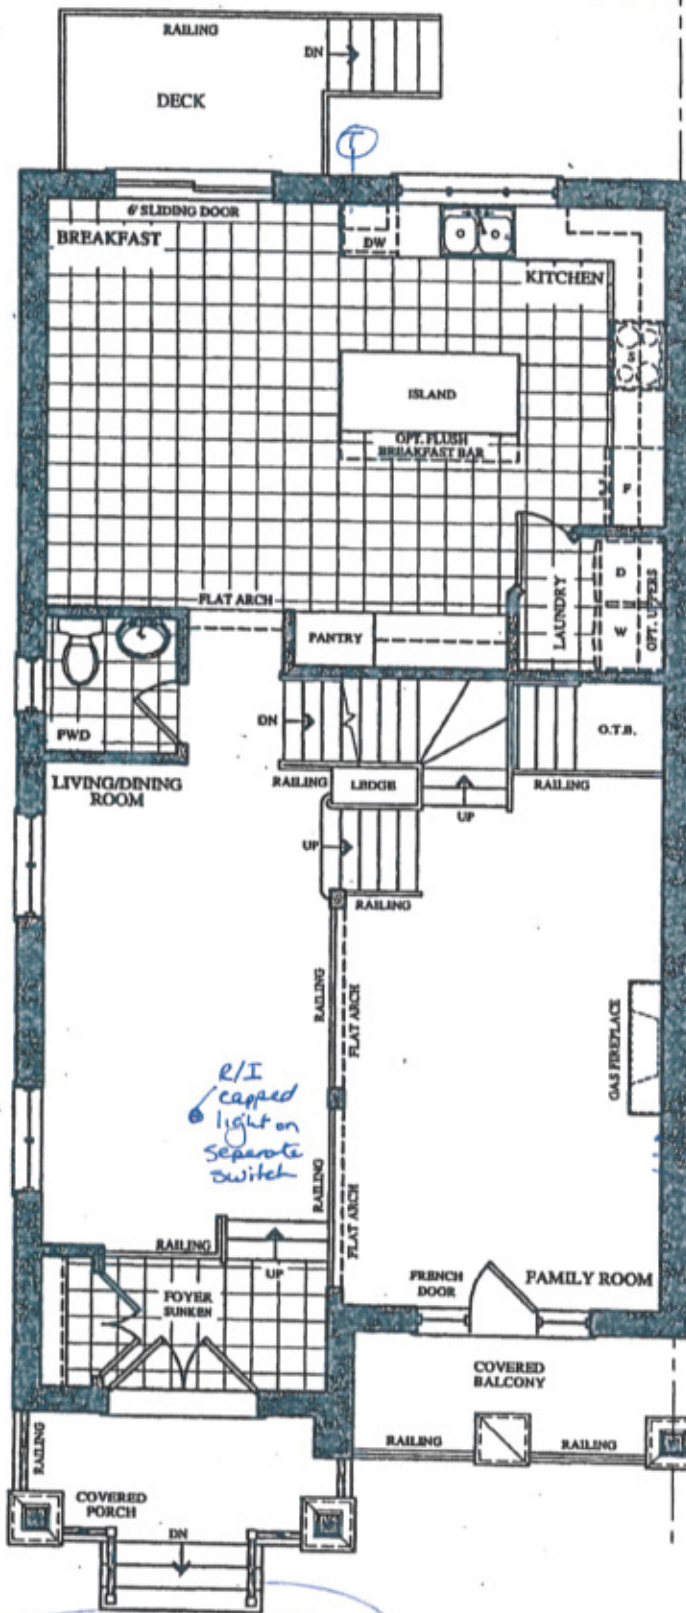


GROUND FLOOR PLAN
ELEV. 'A' & 'B'

Lot 43L
 July 28, 17

AP

MP

AP

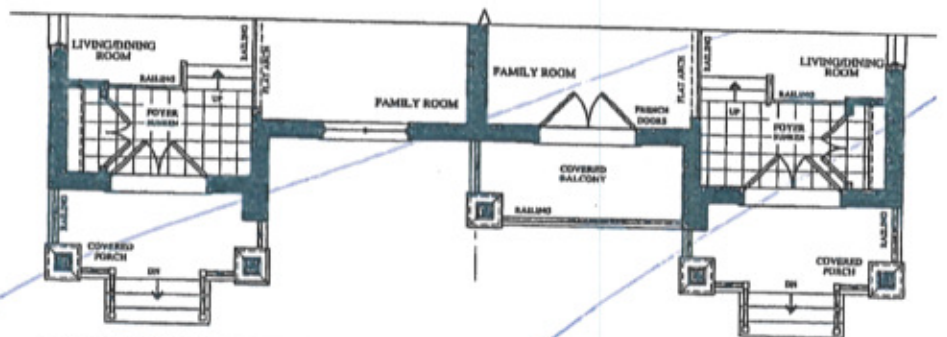


PART. GROUND FLOOR PLAN
ELEV. 'C'

PART. GROUND FLOOR PLAN
ELEV. 'D'

Telephone — (T)
 Cable — (C)

The Debussy SEMI SERIES


Elevation A • 2,283 sq.ft.
 Elevation B • 2,283 sq.ft.
 Elevation C • 2,283 sq.ft.
 Elevation D • 2,283 sq.ft.

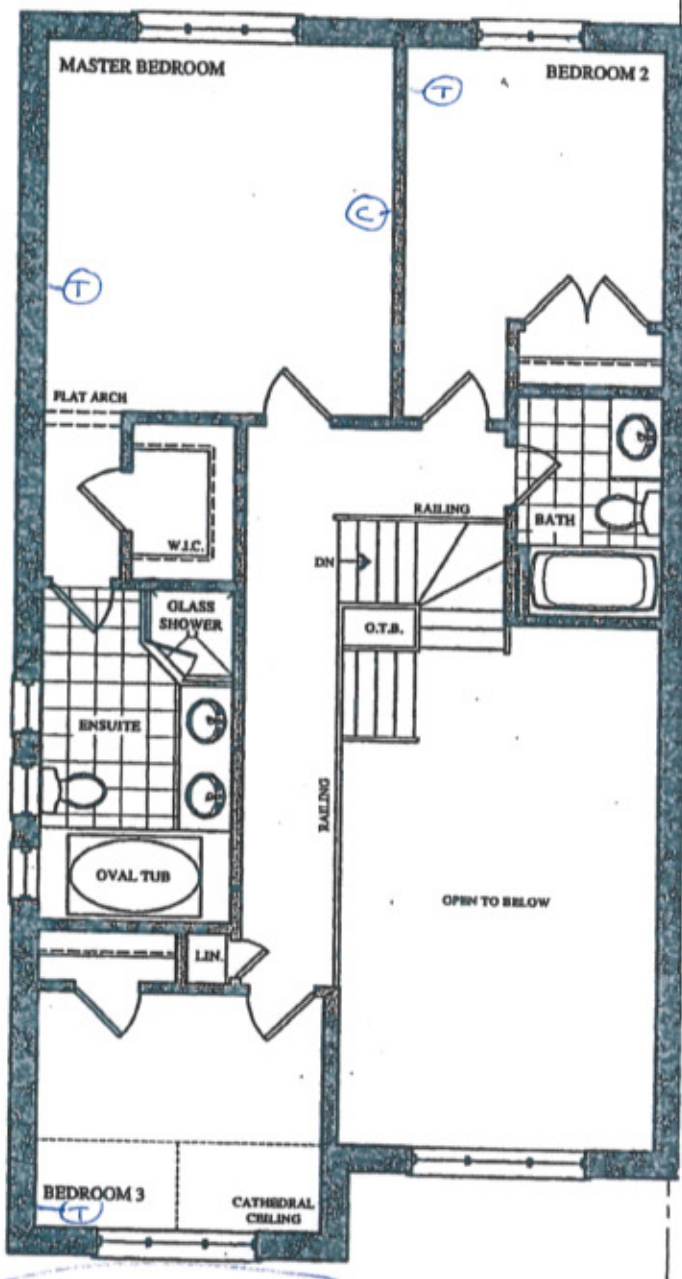

SECOND FLOOR PLAN
 ELEV. 'A' & 'B'

Lot 43L
 July 28, 17

~~NP~~ NP

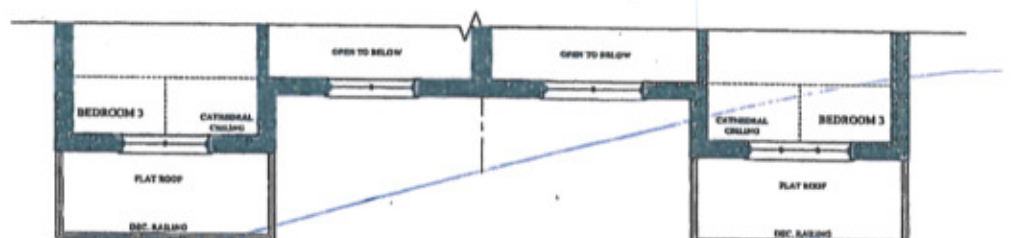


PART. SECOND FLOOR PLAN
 ELEV. 'C'

PART. SECOND FLOOR PLAN
 ELEV. 'D'

BSMNT WINDOWS
2 x 30" x 24"

The Debussy SEMI SERIES

Elevation A • 2,283 sq.ft.
Elevation B • 2,283 sq.ft.
Elevation C • 2,283 sq.ft.
Elevation D • 2,283 sq.ft.

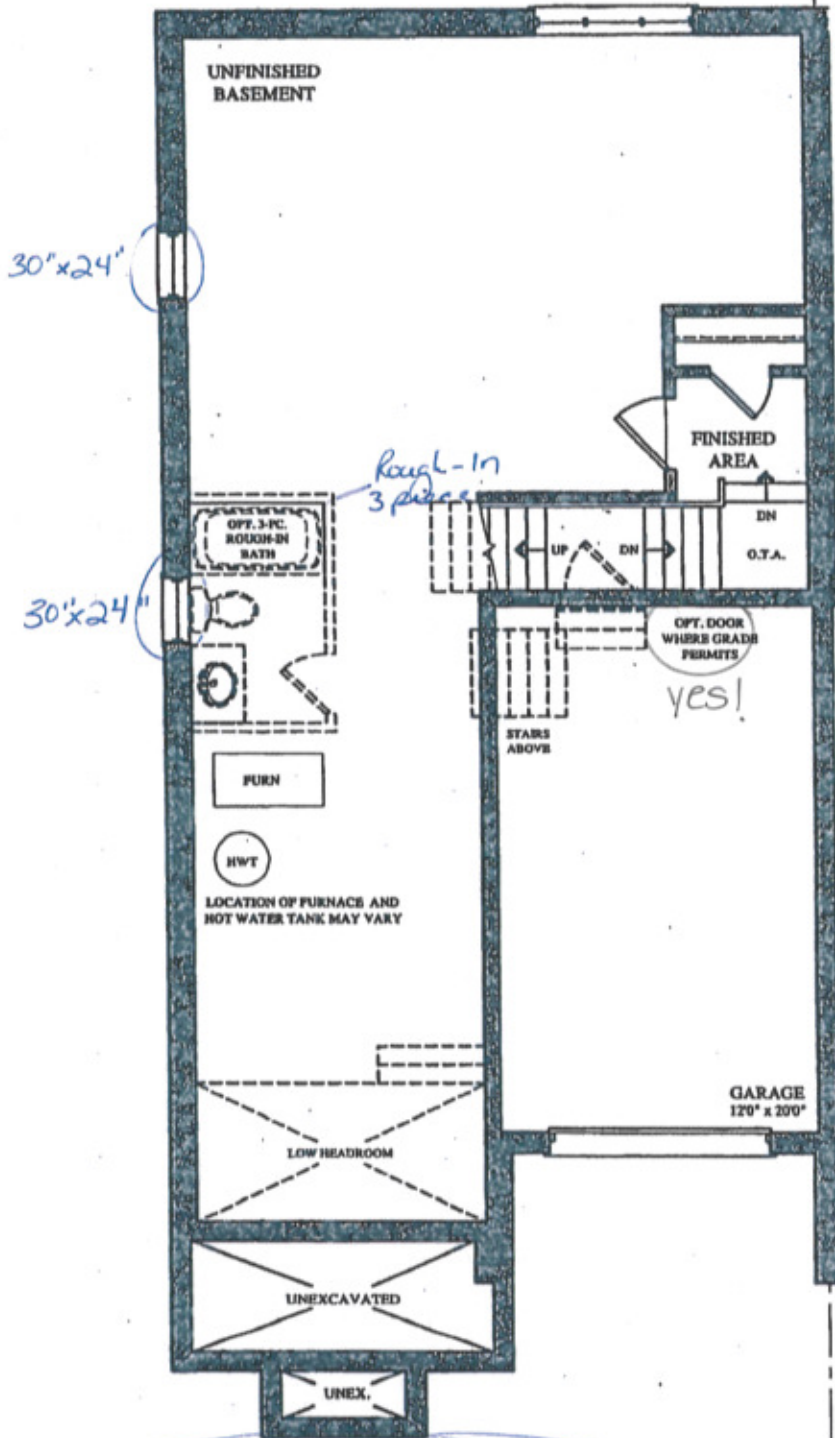

BASEMENT FLOOR PLAN
ELEV. 'A', 'B', 'C' & 'D'

Lot 43L
July 28, 17

