

Brampton Encore - 62 - 2 - 38-3 Elev.B HAYDN

CENTRAL VAC AND WIRING

Inv.1,672	1 - CONDUIT PIPE- FOR TELEVISION- MUST SPECIFY LOCATION AND TERMINATION POINT
Line25036	Note:
8Dec17 / 8Dec17	

CERAMIC

Inv.1,672	1 - UPGRADE TO FREE STANDING TUB - UPG1 ONLY- NOT AVAILABLE ON 41-5 AND 41-6
Line25059	Note:
8Dec17 / 8Dec17	

CONCRETE AND DRAIN

Inv.1,672	1 - ROUGH-IN - 3PC BASEMENT ROUGH-IN
Line25049	Note:
8Dec17 / 8Dec17	

Inv.1,672	1 - COLD CELLAR
Line25053	Note:
8Dec17 / 8Dec17	

DRYWALL

Inv.1,672	1 - SMOOTH CEILINGS - (2-Story Design) 2ND FLOOR
Line25044	Note:
8Dec17 / 8Dec17	

ELECTRICAL

Inv.1,672	1 - 110V WALL RECEPTACLE ON DEDICATED CIRCUIT - FOR MICROWAVE IN ISLAND - MICROWAVE NOT INCLUDED
Line25037	Note:
8Dec17 / 8Dec17	

Inv.1,672	1 - 110V WALL RECEPTACLE ON DEDICATED CIRCUIT - GAS FIRED APPLIANCE - FOR AUX. EQUIPMENT - NOT A STOVE PLUG
Line25038	Note:
8Dec17 / 8Dec17	

Inv.1,672	1 - ADDITIONAL CAPPED FIXTURE ON SAME SWITCH- ABOVE ISLAND FOR FUTURE PENDANT LIGHT
Line25039	Note:
8Dec17 / 8Dec17	

Inv.1,672	1 - ADDITIONAL CAPPED FIXTURE ON SEPERATE SWITCH- ABOVE ISLAND FOR FUTURE PENDANT LIGHT
Line25040	Note:
8Dec17 / 8Dec17	

Inv.1,672	1 - KITCHEN CABINET VALANCE LIGHTS (UNDER CABINETS) - WITH STRIP LIGHTS - DOES NOT INCLUDE (AND REQUIRES) KITCHEN UPGRADE PRICING
Line25041	Note:
8Dec17 / 8Dec17	

Exterior Colours

Inv.1,672	1 - EXTERIOR COLOUR PACKAGE #9
Line25056	Note:
8Dec17 / 8Dec17	

FORMING

Brampton Encore - 62 - 2 - 38-3 Elev.B HAYDN

Inv.1,672	1 - SIDE DOOR- HOME TO EXTERIOR- AS PER PLAN AND GRADE PERMITTING
Line25042	Note:
8Dec17 / 8Dec17	

Inv.1,672	1 - COLD CELLAR
Line25043	Note:
8Dec17 / 8Dec17	

FRAMING

Inv.1,672	4 - FRAME MAIN FLOOR DOORS AT 96" - ADDED WITH THE ADDITION OF TALLER INTERIOR DOORS
Line25047	Note:
8Dec17 / 8Dec17	

Inv.1,672	1 - UPGRADE VENTING FOR STOVE TO 8" PIPE EXTERIOR WALL
Line25054	Note:
8Dec17 / 8Dec17	

Inv.1,672	1 - UPGRADE TO FREE STANDING TUB - UPG1 ONLY- NOT AVAILABLE ON 41-5 AND 41-6
Line25058	Note:
8Dec17 / 8Dec17	

HVAC

Inv.1,672	1 - UPGRADE VENTING FOR STOVE TO 8" PIPE EXTERIOR WALL
Line25045	Note:
8Dec17 / 8Dec17	

Inv.1,672	1 - 110V WALL RECEPTACLE ON DEDICATED CIRCUIT - GAS FIRED APPLIANCE - FOR AUX. EQUIPMENT - NOT A STOVE PLUG
Line25051	Note:
8Dec17 / 8Dec17	

INTERIOR TRIM AND DOORS

Inv.1,672	4 - FRAME MAIN FLOOR DOORS AT 96" - ADDED WITH THE ADDITION OF TALLER INTERIOR DOORS
Line25055	Note:
8Dec17 / 8Dec17	

PLUMBING

Inv.1,672	1 - ROUGH-IN - WATERLINE FOR FIRDGE
Line25048	Note:
8Dec17 / 8Dec17	

Inv.1,672	1 - UPGRADE TO FREE STANDING TUB - UPG1 ONLY- NOT AVAILABLE ON 41-5 AND 41-6
Line25057	Note:
8Dec17 / 8Dec17	

WINDOWS - BASEMENT

Inv.1,672	1 - BASEMENT WINDOWS - UPGRADE EXISTING BASEMENT WINDOW TO 30 INCH X 16 INCH
Line25050	Note:
8Dec17 / 8Dec17	

WINDOWS AND DOORS

Brampton Encore - 62 - 2 - 38-3 Elev.B HAYDN

Inv.1,672	1 - SIDE DOOR- HOME TO EXTERIOR- AS PER PLAN AND GRADE PERMITTING
Line25052	Note:
8Dec17 / 8Dec17	



Lot 62

encore
BRAMPTON

The Haydn

38' SERIES

Elevation A • 2,454 sq.ft. | Elevation B • 2,448 sq.ft.

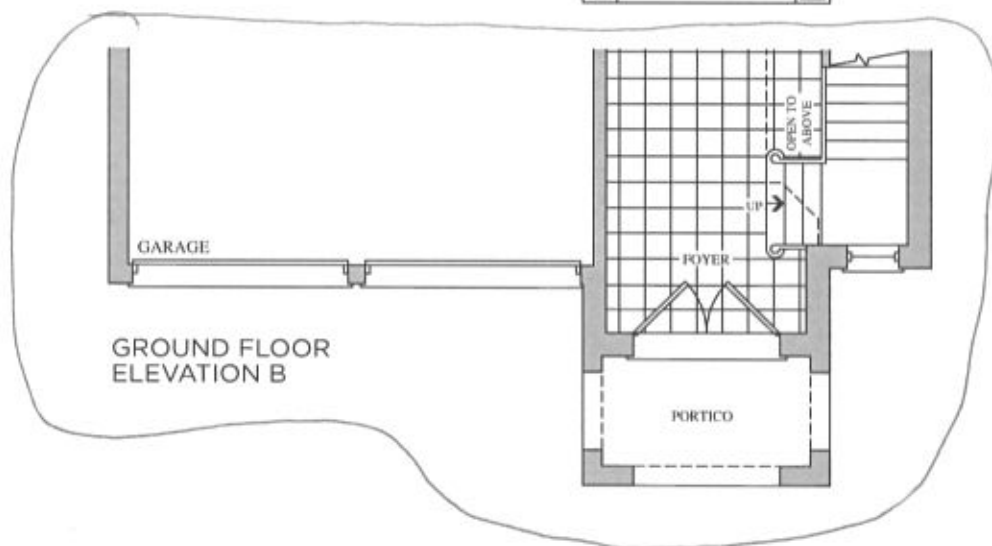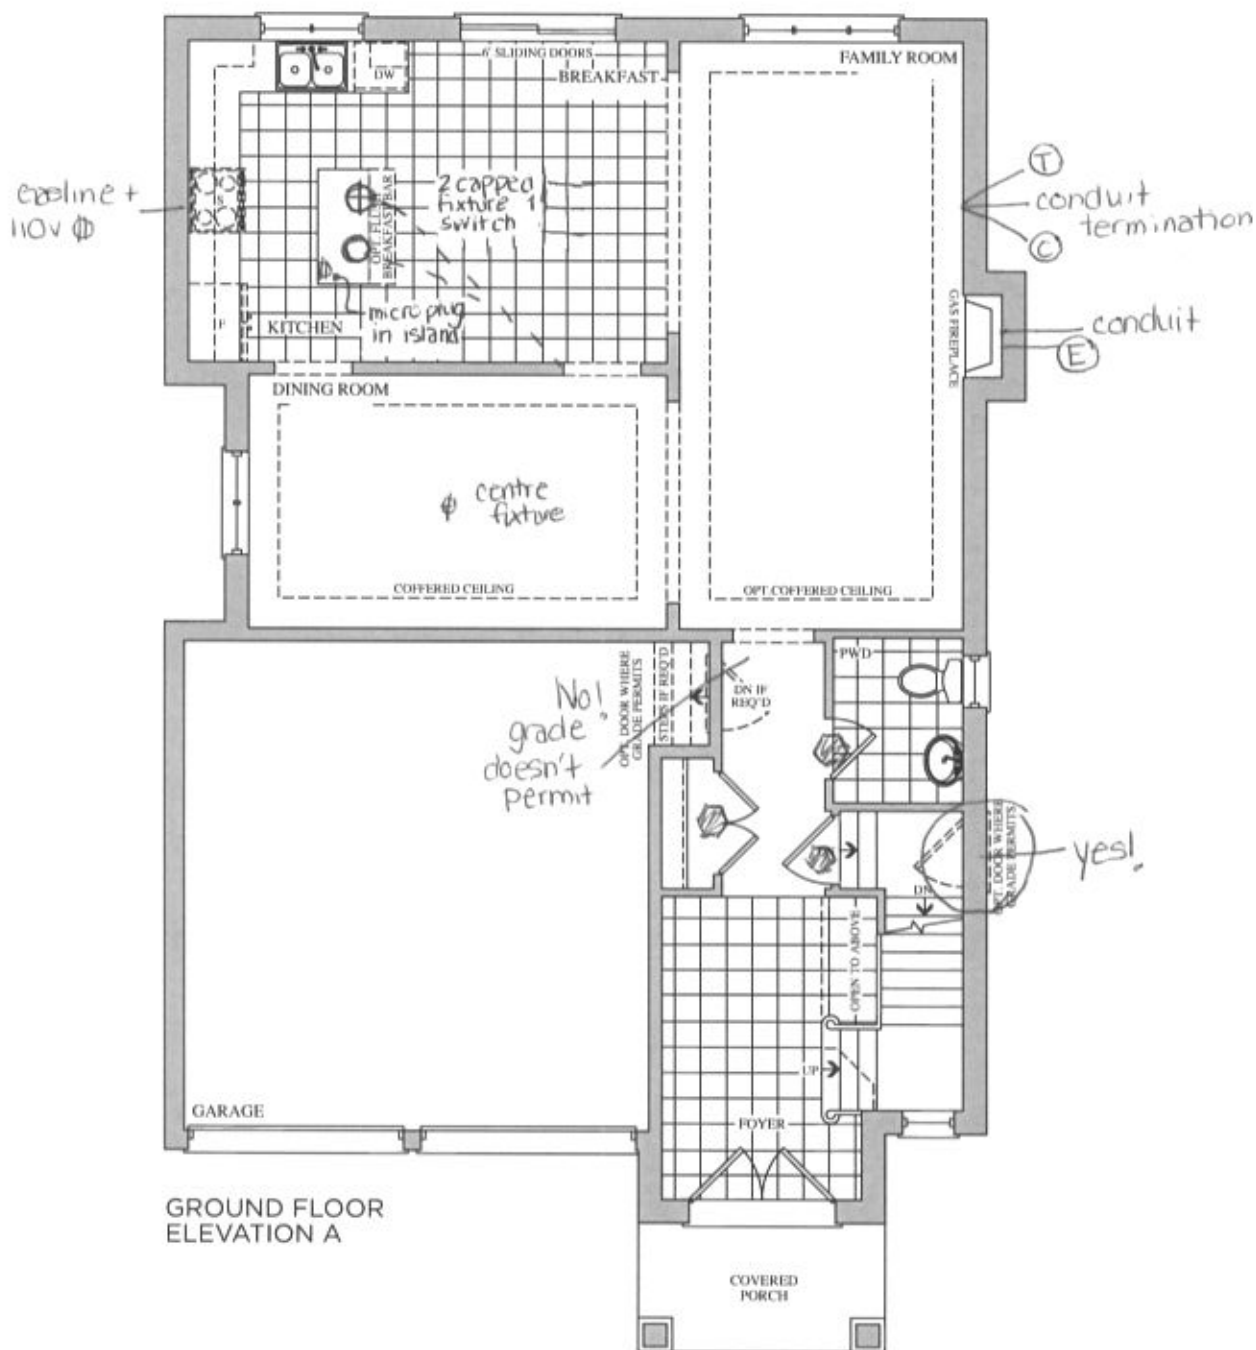


Prices, figures, illustrations, sizes, features and finishes are subject to change without notice. E & O E. Areas and dimensions are approximate and actual usable floor space may vary from the stated area. Layout may be reverse of the unit purchased. E. & O.E.


GOLDpark
HOMES

freestanding tub

Elevation A • 2,454 sq.ft. | Elevation B • 2,448 sq.ft.

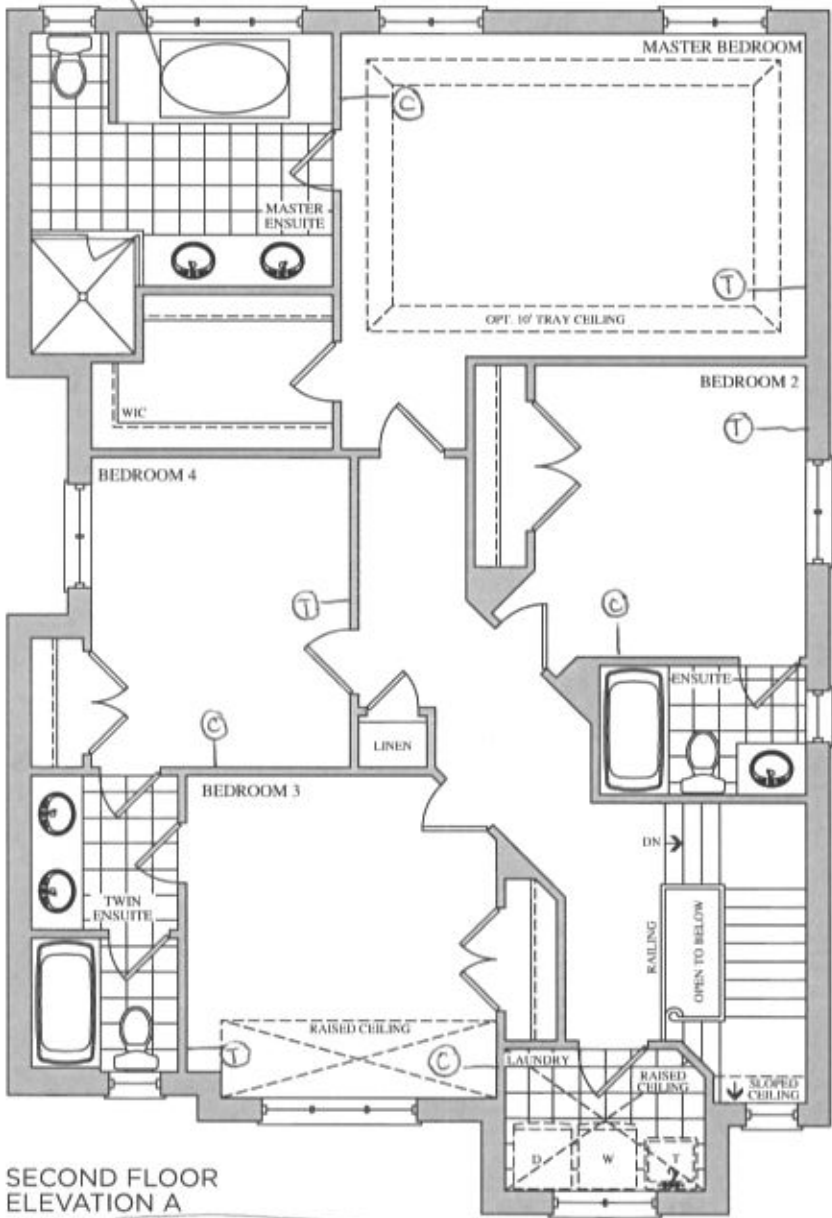

SECOND FLOOR
ELEVATION A

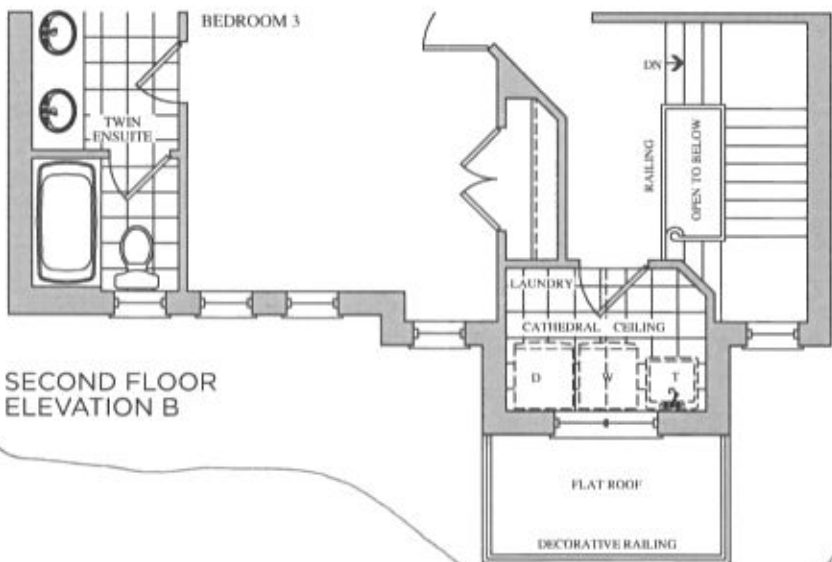

SECOND FLOOR
ELEVATION B

