

Brampton Encore - 31 - 2 - 38-4 Elev.B VIVALDI

CENTRAL VAC AND WIRING

Inv.1,674	1 - CONDUIT PIPE- FOR TELEVISION- MUST SPECIFY LOCATION AND TERMINATION POINT
Line25090	Note:
8Dec17 / 8Dec17	

CERAMIC

Inv.1,674	1 - UPGRADE TO FREE STANDING TUB - UPG1 ONLY- NOT AVAILABLE ON 41-5 AND 41-6
Line25111	Note:
8Dec17 / 8Dec17	

CONCRETE AND DRAIN

Inv.1,674	1 - ROUGH-IN - 3PC BASEMENT ROUGH-IN
Line25104	Note:
8Dec17 / 8Dec17	

Inv.1,674	1 - COLD CELLAR
Line25110	Note:
8Dec17 / 8Dec17	

DRYWALL

Inv.1,674	1 - SMOOTH CEILINGS - (2-Story Design) MAIN FLOOR
Line25100	Note:
8Dec17 / 8Dec17	

ELECTRICAL

Inv.1,674	1 - KITCHEN- 220V WALL RECEPTICAL ON DEDICATED CIRCUIT- FOR 4 WIRE BUILT-IN WALL OVEN - SEE PLAN FOR LOCATION
Line25092	Note:
8Dec17 / 8Dec17	

Inv.1,674	1 - KITCHEN CABINET VALANCE LIGHTS (UNDER CABINETS) - WITH STRIP LIGHTS - DOES NOT INCLUDE (AND REQUIRES) KITCHEN UPGRADE PRICING
Line25093	Note:
8Dec17 / 8Dec17	

Inv.1,674	6 - FAMILY ROOM: SIX (6x) POT LIGHT: 4 INCH HALOGEN POT LIGHT - 440 WH
Line25094	Note:
8Dec17 / 8Dec17	

Inv.1,674	1 - KITCHEN: ROUGH - IN CEILING OUTLET ON SAME SWITCH - DOES NOT INCLUDE FIXTURE - OVER ISLAND FOR FUTURE PENDANT LIGHT
Line25095	Note:
8Dec17 / 8Dec17	

Inv.1,674	1 - KITCHEN: ROUGH - IN CEILING OUTLET & SWITCH (WITH COVER PLATE) - DOES NOT INCLUDE FIXTURE - OVER ISLAND FOR FUTURE PENDANT LIGHT
Line25096	Note:
8Dec17 / 8Dec17	

Inv.1,674	4 - BREAKFAST: FOUR (4X) POT LIGHT: 4 INCH HALOGEN POT LIGHT - 440 WH
Line25108	Note:
8Dec17 / 8Dec17	

Exterior Colours

Brampton Encore - 31 - 2 - 38-4 Elev.B VIVALDI

Inv.1,674	1 - EXTERIOR COLOUR PACKAGE #8
Line25114	Note:
8Dec17 / 8Dec17	

FORMING

Inv.1,674	1 - SIDE DOOR- HOME TO EXTERIOR- AS PER PLAN AND GRADE PERMITTING
Line25097	Note:
8Dec17 / 8Dec17	

Inv.1,674	1 - COLD CELLAR
Line25098	Note:
8Dec17 / 8Dec17	

FRAMING

Inv.1,674	3 - FRAME MAIN FLOOR DOORS AT 96" - ADDED WITH THE ADDITION OF TALLER INTERIOR DOORS
Line25099	Note:
8Dec17 / 8Dec17	

Inv.1,674	1 - OPTIONAL COFFERED CEILING - FAMILY ROOM (PER ROOM AS PER PLAN)
Line25101	Note:
8Dec17 / 8Dec17	

Inv.1,674	1 - UPGRADE TO FREE STANDING TUB - UPG1 ONLY- NOT AVAILABLE ON 41-5 AND 41-6
Line25105	Note:
8Dec17 / 8Dec17	

HVAC

Inv.1,674	1 - GAS LINE ROUGH - 2ND FLOOR- (2-STOREY MODELS) 110V PLUG FOR STOVE
Line25102	Note:
8Dec17 / 8Dec17	

Inv.1,674	1 - UPGRADE VENTING FOR STOVE TO 8" PIPE EXTERIOR WALL
Line25103	Note:
8Dec17 / 8Dec17	

INTERIOR TRIM AND DOORS

Inv.1,674	1 - FRAME MAIN FLOOR DOORS AT 96" - ADDED WITH THE ADDITION OF TALLER INTERIOR DOORS
Line25113	Note:
8Dec17 / 8Dec17	

PLUMBING

Inv.1,674	1 - UPGRADE TO FREE STANDING TUB - UPG1 ONLY- NOT AVAILABLE ON 41-5 AND 41-6
Line25112	Note:
8Dec17 / 8Dec17	

WINDOWS - BASEMENT

Inv.1,674	4 - BASEMENT WINDOWS - UPGRADE EXISTING BASEMENT WINDOW TO 30 INCH X 16 INCH
Line25107	Note:
8Dec17 / 8Dec17	

WINDOWS AND DOORS


Brampton Encore - 31 - 2 - 38-4 Elev.B VIVALDI

Inv.1,674	1 - SIDE DOOR- HOME TO EXTERIOR- AS PER PLAN AND GRADE PERMITTING
Line25109	Note:
8Dec17 / 8Dec17	


encore
BRAMPTON
Lot 31

The
Vivaldi
38' SERIES

Elevation A • 2,518 sq.ft. | Elevation B • 2,518 sq.ft.

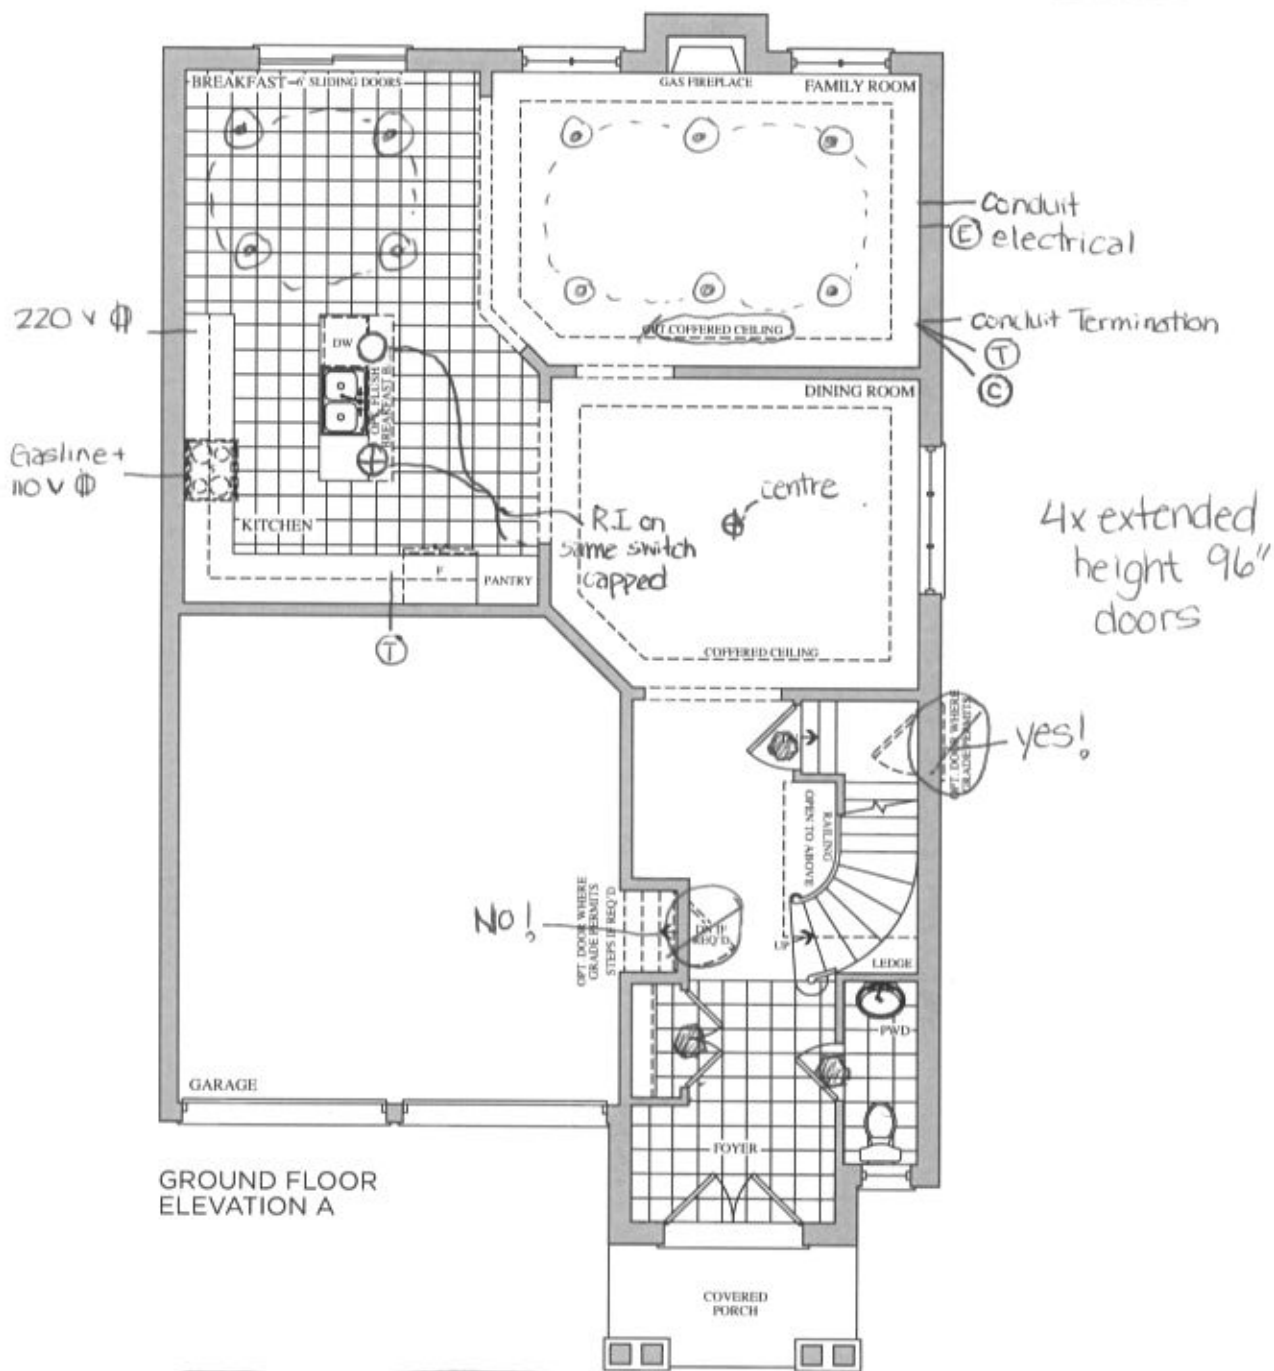

GROUND FLOOR
ELEVATION A

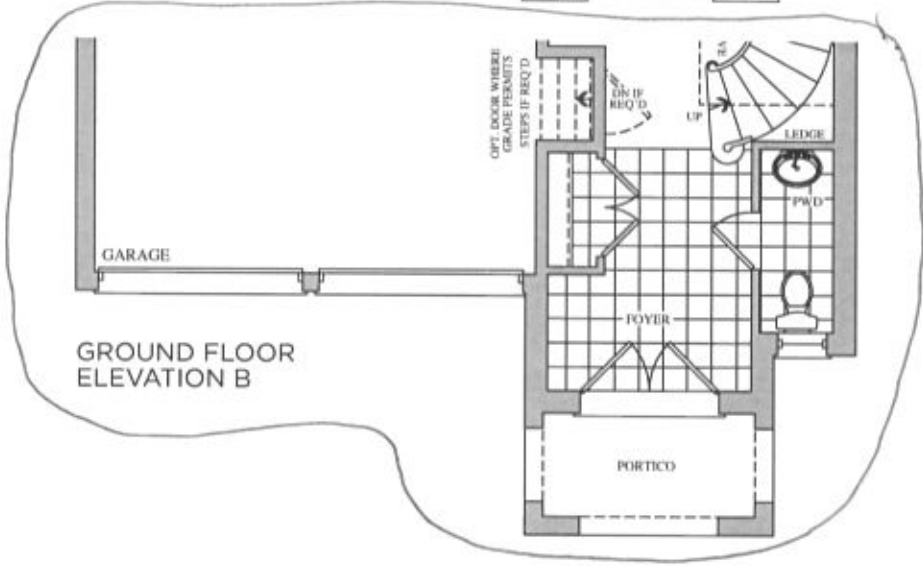



GROUND FLOOR
ELEVATION B

Lot-31

encore
BRAMPTON

The Vivaldi 38' SERIES

Elevation A • 2,518 sq.ft. | Elevation B • 2,518 sq.ft.

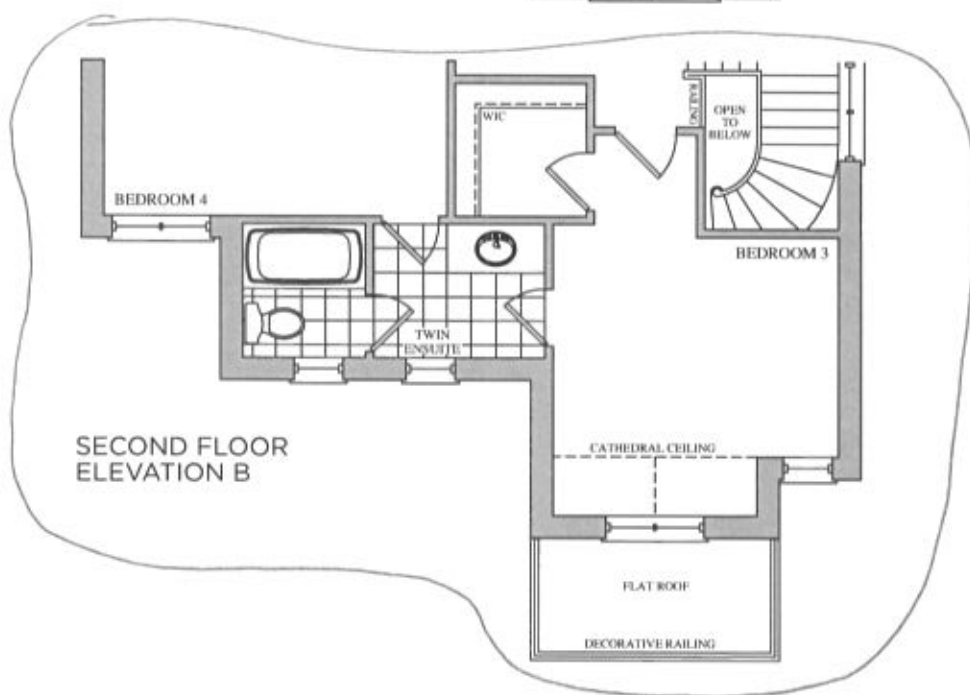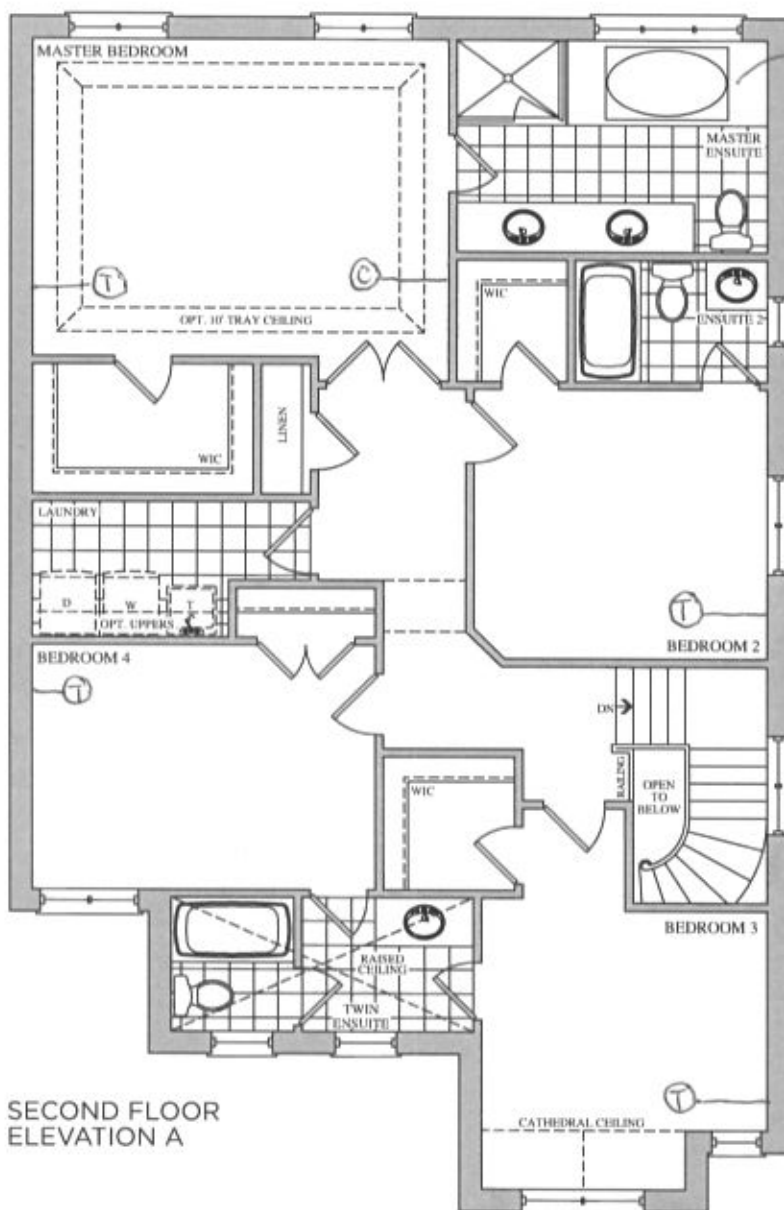

Prices, figures, illustrations, sizes, features and finishes are subject to change without notice. E & O.E. Areas and dimensions are approximate and actual usable floor space may vary from the stated area. Layout may be reverse of the unit purchased. E. & O.E.

GOLDPARK
HOMES

Lot 31

The
Vivaldi
38' SERIES

Elevation A • 2,518 sq.ft. | Elevation B • 2,518 sq.ft.

